

LEGEND

LOT BOUNDARIES

STAGE BOUNDARIES

EXISTING SURFACE CONTOUR MAJOR (1m INTERVAL)

EXISTING SURFACE CONTOUR MINOR (0.5m INTERVAL)

FUTURE STAGE

- NOTE:
1. LEVELS ARE IN TERMS OF MOTURIKI VERTICAL DATUM 1953.

2. ALL CO-ORDINATES ARE IN TERMS OF NZTM.

3. EXISTING SURFACE TOPO IS TAKEN FOR THE PURPOSE OF GEOTECHNICAL CUT FILL AS-BUILT PLANS AND SHOULD NOT BE RELIED ON FOR DETAILED DESIGN.

4. EXISTING CONTOURS SHOWN ARE PRIOR TO STAGES 1 TO 7 EARTHWORKS STARTING. CONTOURS PROVIDED ARE CIRCA SEPTEMBER 2018.

CERTIFICATION

I CERTIFY THAT THESE ASBUILT PLANS ARE AN ACCURATE RECORD OF THE WORKS UNDERTAKEN AND THAT:

- THE COORDINATES (X,Y) ARE IN TERMS OF NZTM ON NZGD(2000), AND ARE WITHIN ±50mm.
- THE LEVELS (Z) ARE IN TERMS OF THE MOTURIKI DATUM 1953 LINZ DATUM, AND ARE WITHIN ±25mm.

SIGNED
LICENSED CADASTRAL SURVEYOR

DATE:
NAME: NATHAN HOGG
ADDRESS: P.O.BOX 28-345, REMUERA, AUCKLAND
CONTACT: (09) 579 5505
EMAIL: Nathan.Hogg@candor3.co.nz

RELEVANT CONSENT NUMBERS:
SUB0340/18.02 & LUC0137/19

ASBUILT

REV DESCRIPTION		BY	APPVD	DATE	PROJECT		CLIENT		PURPOSE		
<div>Candor³ ENGINEERING FOR LIFE</div>					LAKESIDE, TE KAUWHATA EARTHWORKS EXISTING SURFACE STAGE 4 SHEET 1 OF 3		LAKESIDE DEVELOPMENTS 2017 LIMITED		AS-BUILT		
DESIGN JS		APPROVED BY NH		SCALE		PROJECT NO.		DRAWING NO.		REV.	
DRAWN JS		DATE SEP 2020		1:2500 @ A3		1239		AB-2-100		-	
CHECK RS											


LEGEND

- LOT BOUNDARIES
- STAGE BOUNDARIES
- EXISTING SURFACE CONTOUR MAJOR (1m INTERVAL)
- EXISTING SURFACE CONTOUR MINOR (0.5m INTERVAL)

FUTURE STAGE

NOTE:

- LEVELS ARE IN TERMS OF MOTURIKI VERTICAL DATUM 1953.
- ALL CO-ORDINATES ARE IN TERMS OF NZTM.
- EXISTING SURFACE TOPO IS TAKEN FOR THE PURPOSE OF GEOTECHNICAL CUT FILL AS-BUILT PLANS AND SHOULD NOT BE RELIED ON FOR DETAILED DESIGN.
- EXISTING CONTOURS SHOWN ARE PRIOR TO STAGES 1 TO 7 EARTHWORKS STARTING. CONTOURS PROVIDED ARE CIRCA SEPTEMBER 2018.

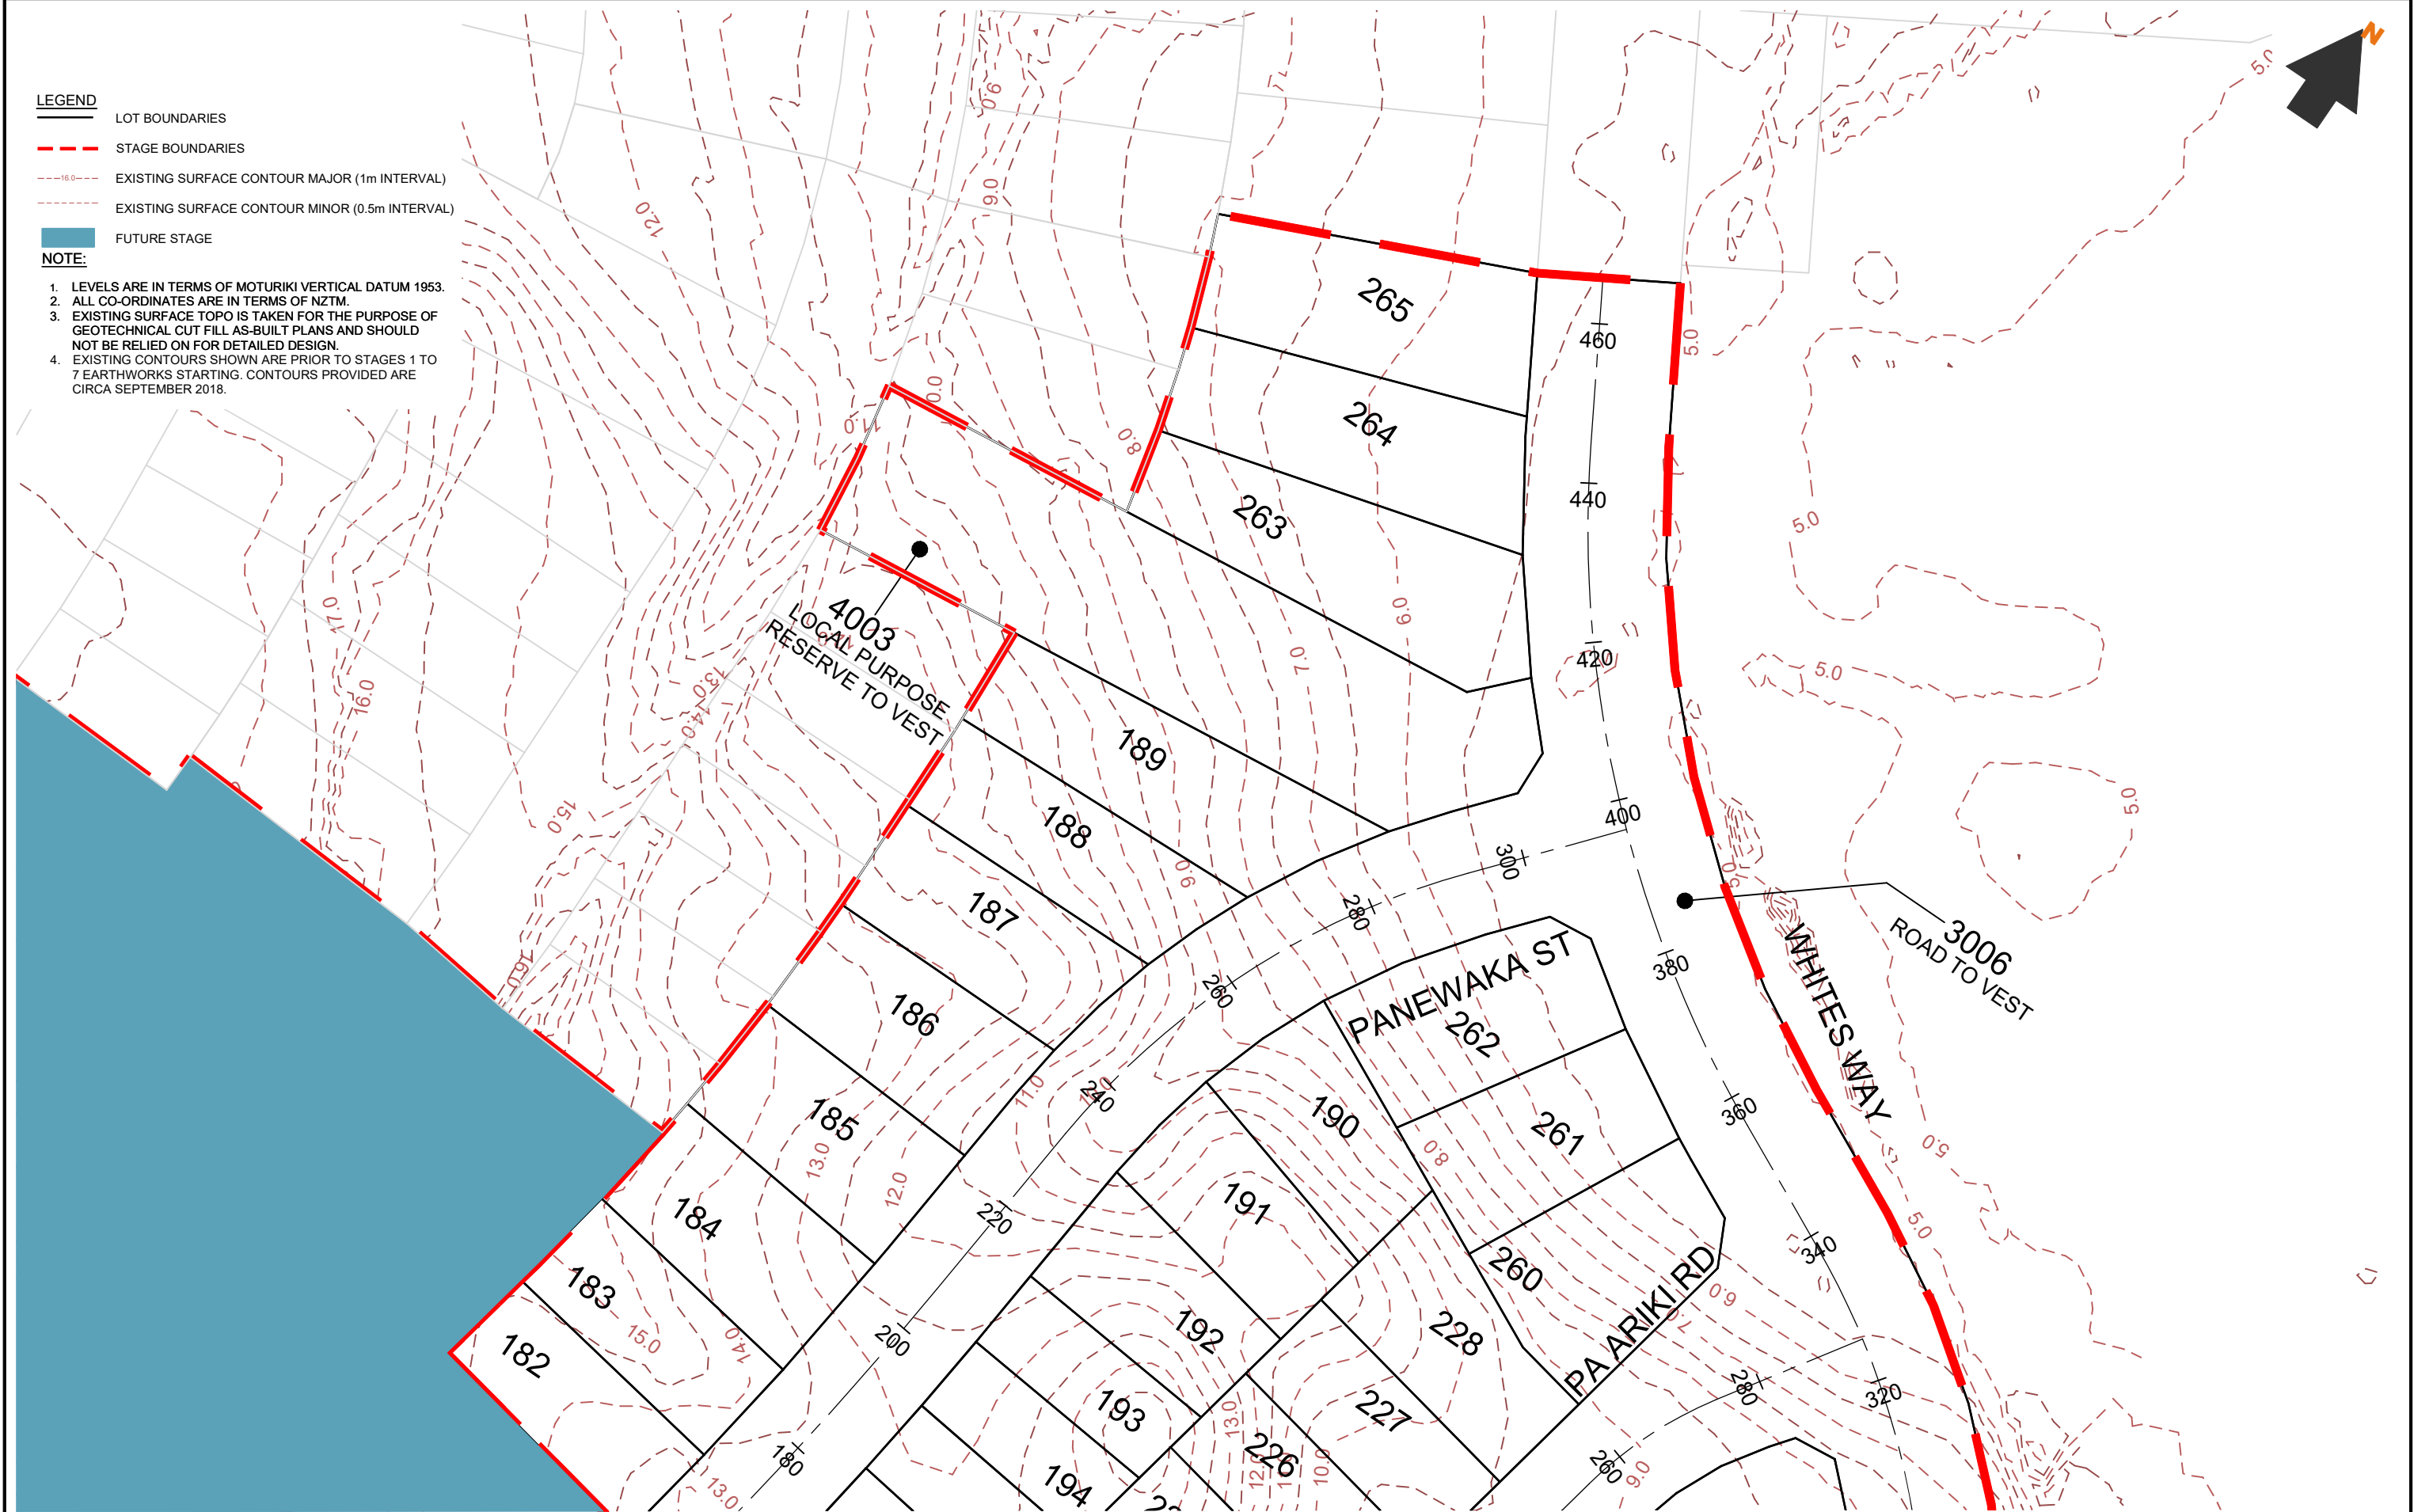

REV DESCRIPTION BY APPVD DATE				PROJECT		CLIENT		PURPOSE		
				LAKESIDE, TE KAUWHATA		LAKESIDE		AS-BUILT		
				EARTHWORKS EXISTING SURFACE STAGE 4		DEVELOPMENTS 2017		DESIGN JS	APPROVED BY NH	SCALE 1:750 @ A3
				SHEET 2 OF 3		LIMITED		DRAWN JS	DATE SEP 2020	
								CHECK RS		
								PROJECT NO.	DRAWING NO.	REV.
								1239	AB-2-101	-



LEGEND

LOT BOUNDARIES

STAGE BOUNDARIES

EXISTING SURFACE CONTOUR MAJOR (1m INTERVAL)

EXISTING SURFACE CONTOUR MINOR (0.5m INTERVAL)


FUTURE STAGE

NOTE:

- LEVELS ARE IN TERMS OF MOTURIKI VERTICAL DATUM 1953.
- ALL CO-ORDINATES ARE IN TERMS OF NZTM.
- EXISTING SURFACE TOPO IS TAKEN FOR THE PURPOSE OF GEOTECHNICAL CUT FILL AS-BUILT PLANS AND SHOULD NOT BE RELIED ON FOR DETAILED DESIGN.
- EXISTING CONTOURS SHOWN ARE PRIOR TO STAGES 1 TO 7 EARTHWORKS STARTING. CONTOURS PROVIDED ARE CIRCA SEPTEMBER 2018.

REV DESCRIPTION		BY	APPVD	DATE	PROJECT		CLIENT		PURPOSE		
					LAKESIDE, TE KAUWHATA		LAKESIDE		AS-BUILT		
					EARTHWORKS EXISTING SURFACE STAGE 4		DEVELOPMENTS 2017		DESIGN JS	APPROVED BY NH	SCALE 1:750 @ A3
					SHEET 3 OF 3		LIMITED		DRAWN JS	DATE SEP 2020	
									CHECK RS		
									PROJECT NO.	DRAWING NO.	REV.
									1239	AB-2-102	-



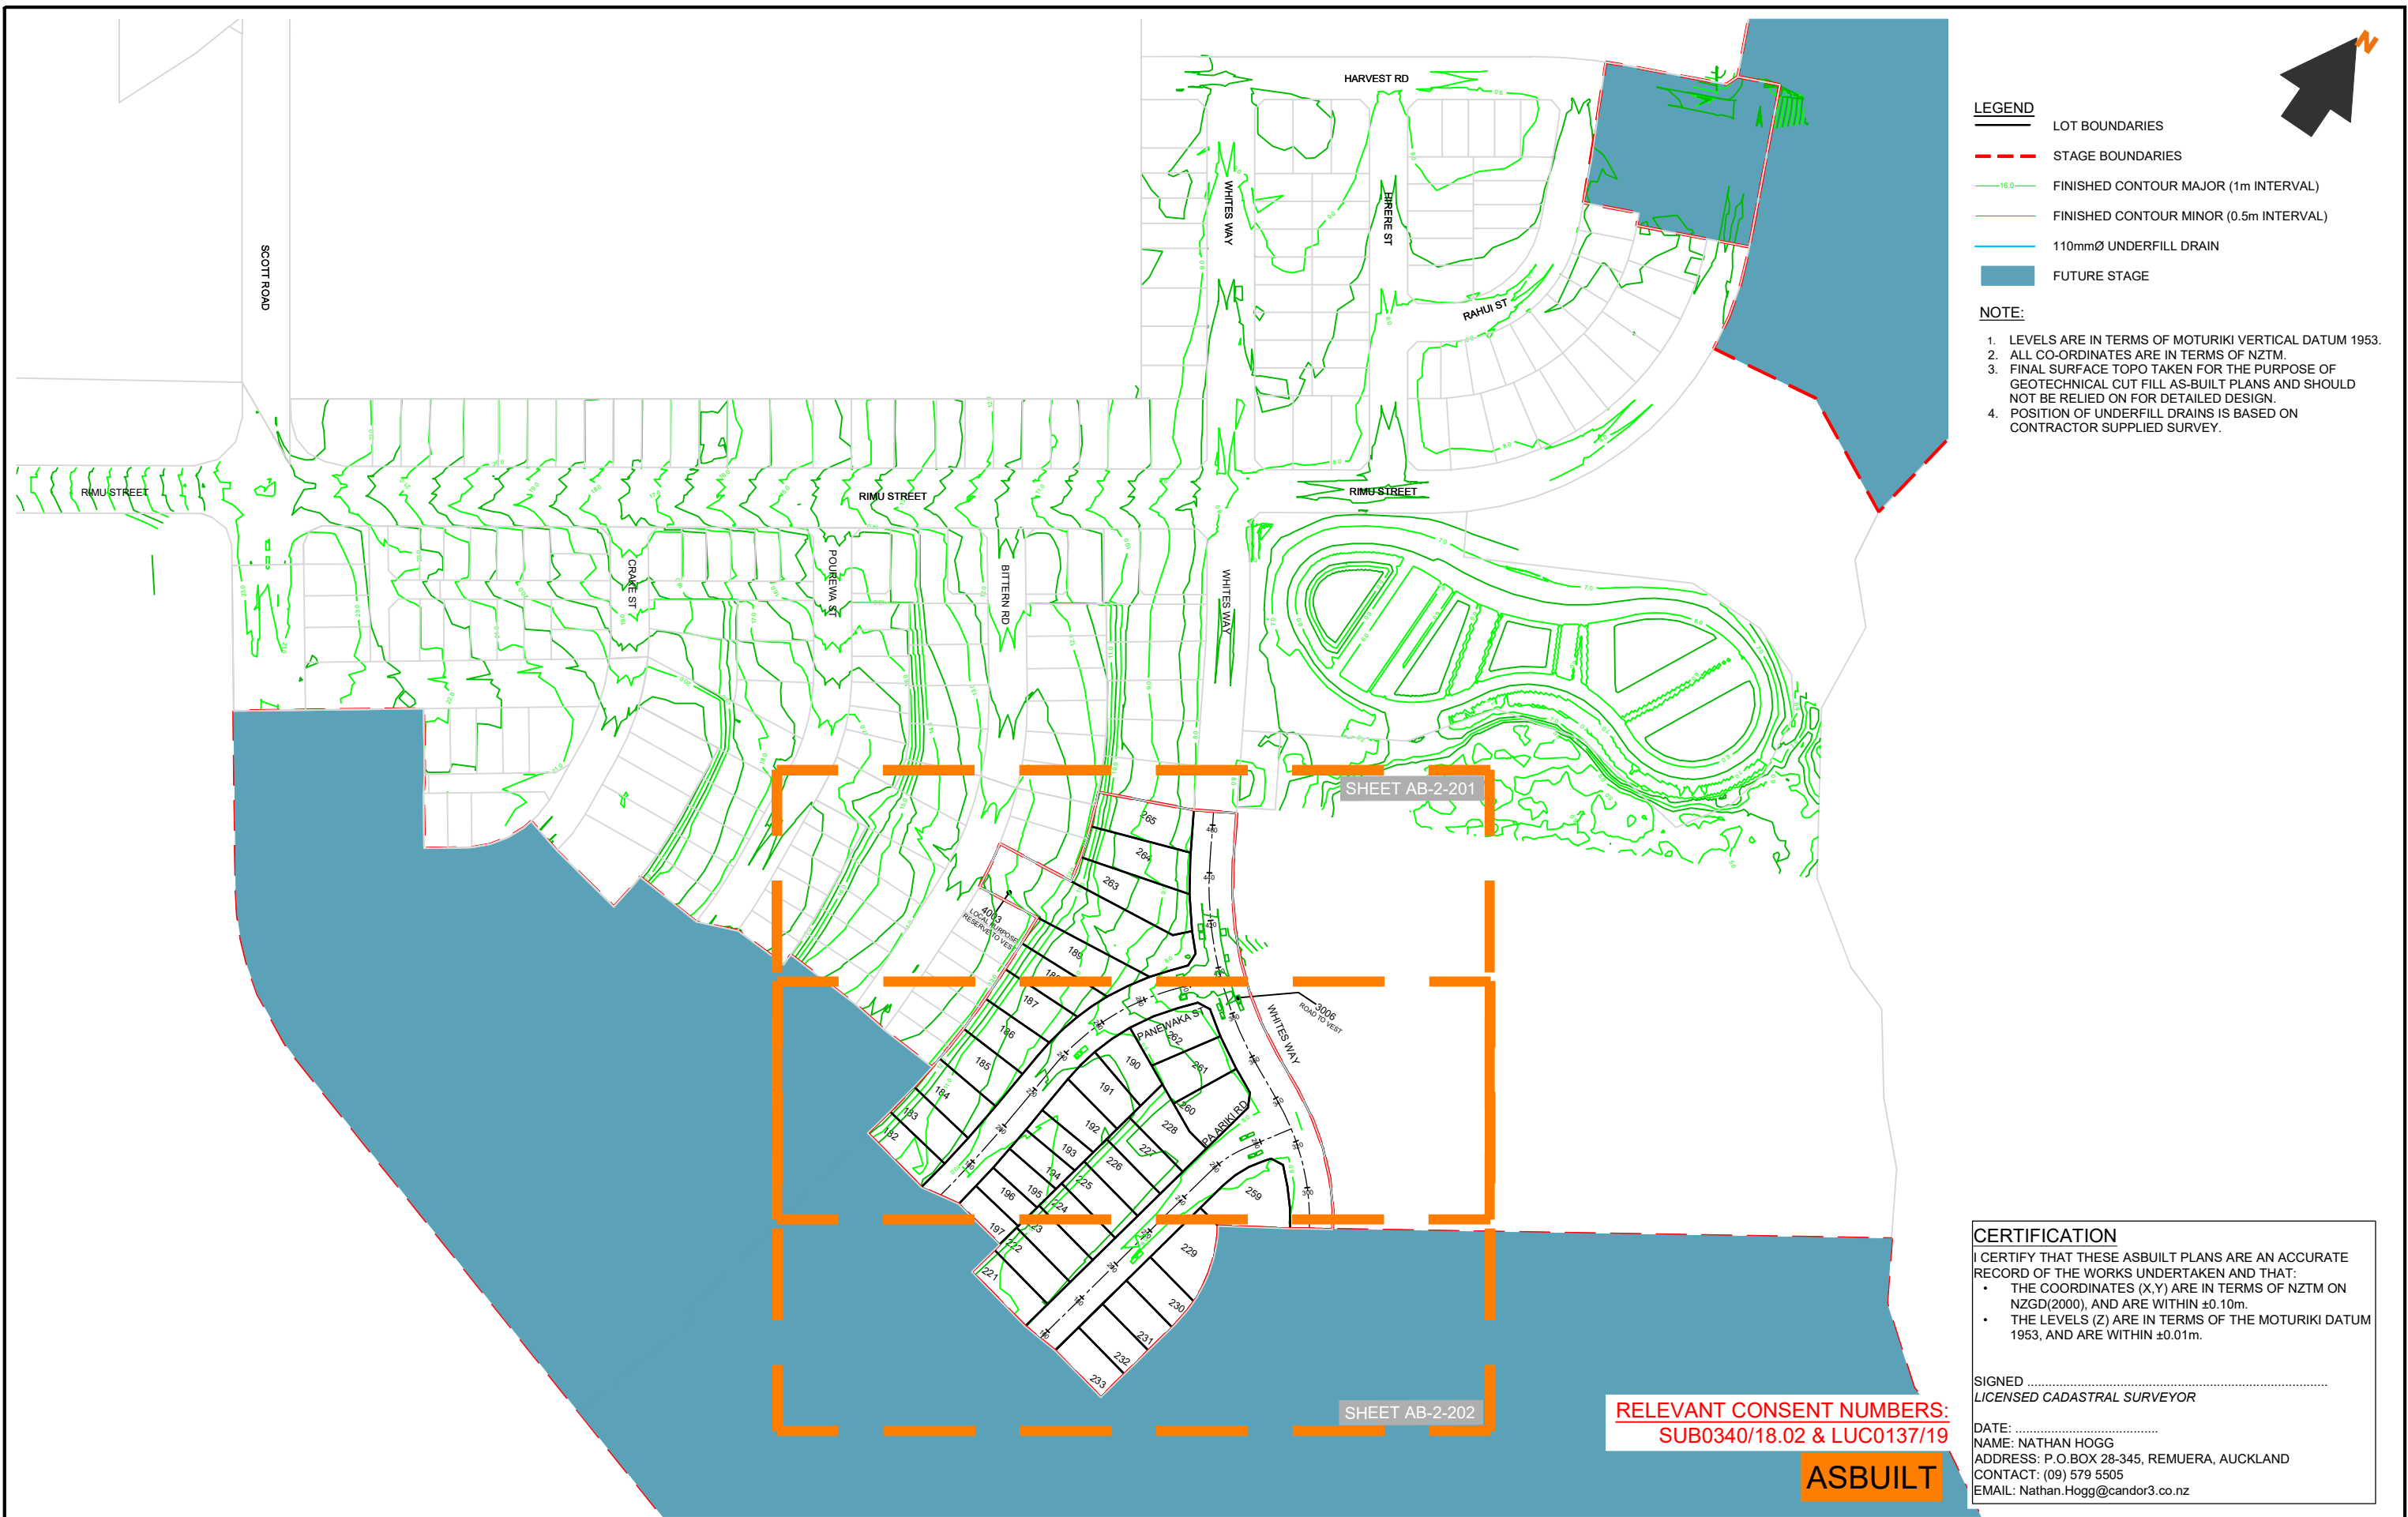

LEGEND

- LOT BOUNDARIES
- STAGE BOUNDARIES
- FINISHED CONTOUR MAJOR (1m INTERVAL)
- FINISHED CONTOUR MINOR (0.5m INTERVAL)
- 110mmØ UNDERFILL DRAIN
- FUTURE STAGE

- NOTE:**
- LEVELS ARE IN TERMS OF MOTURIKI VERTICAL DATUM 1953.
 - ALL CO-ORDINATES ARE IN TERMS OF NZTM.
 - FINAL SURFACE TOPO TAKEN FOR THE PURPOSE OF GEOTECHNICAL CUT FILL AS-BUILT PLANS AND SHOULD NOT BE RELIED ON FOR DETAILED DESIGN.
 - POSITION OF UNDERFILL DRAINS IS BASED ON CONTRACTOR SUPPLIED SURVEY.

SHEET AB-2-201

SHEET AB-2-202

RELEVANT CONSENT NUMBERS:
SUB0340/18.02 & LUC0137/19

ASBUILT

CERTIFICATION

I CERTIFY THAT THESE ASBUILT PLANS ARE AN ACCURATE RECORD OF THE WORKS UNDERTAKEN AND THAT:

- THE COORDINATES (X,Y) ARE IN TERMS OF NZTM ON NZGD(2000), AND ARE WITHIN ±0.10m.
- THE LEVELS (Z) ARE IN TERMS OF THE MOTURIKI DATUM 1953, AND ARE WITHIN ±0.01m.

SIGNED
LICENSED CADASTRAL SURVEYOR

DATE:
NAME: NATHAN HOGG
ADDRESS: P.O.BOX 28-345, REMUERA, AUCKLAND
CONTACT: (09) 579 5505
EMAIL: Nathan.Hogg@candor3.co.nz


REV DESCRIPTION				BY	APPVD	DATE	PROJECT				CLIENT				PURPOSE			
<div>Candor³ ENGINEERING FOR LIFE</div>							LAKESIDE, TE KAUWHATA EARTHWORKS FINISHED SURFACE STAGE 4 SHEET 1 OF 3				LAKESIDE DEVELOPMENTS 2017 LIMITED				AS-BUILT			
DESIGN JS				APPROVED BY NH				SCALE 1:2500 @ A3				PROJECT NO. 1239 DRAWING NO. AB-2-200 REV. -						
CHECK RS				DATE SEP 2020														

LEGEND

- LOT BOUNDARIES
- STAGE BOUNDARIES
- FINISHED CONTOUR MAJOR (1m INTERVAL)
- FINISHED CONTOUR MINOR (0.5m INTERVAL)
- 110mmØ UNDERFILL DRAIN
- FUTURE STAGE

NOTE:

- LEVELS ARE IN TERMS OF MOTURIKI VERTICAL DATUM 1953.
- ALL CO-ORDINATES ARE IN TERMS OF NZTM.
- FINAL SURFACE TOPO TAKEN FOR THE PURPOSE OF GEOTECHNICAL CUT FILL AS-BUILT PLANS AND SHOULD NOT BE RELIED ON FOR DETAILED DESIGN.
- POSITION OF UNDERFILL DRAINS IS BASED ON CONTRACTOR SUPPLIED SURVEY.

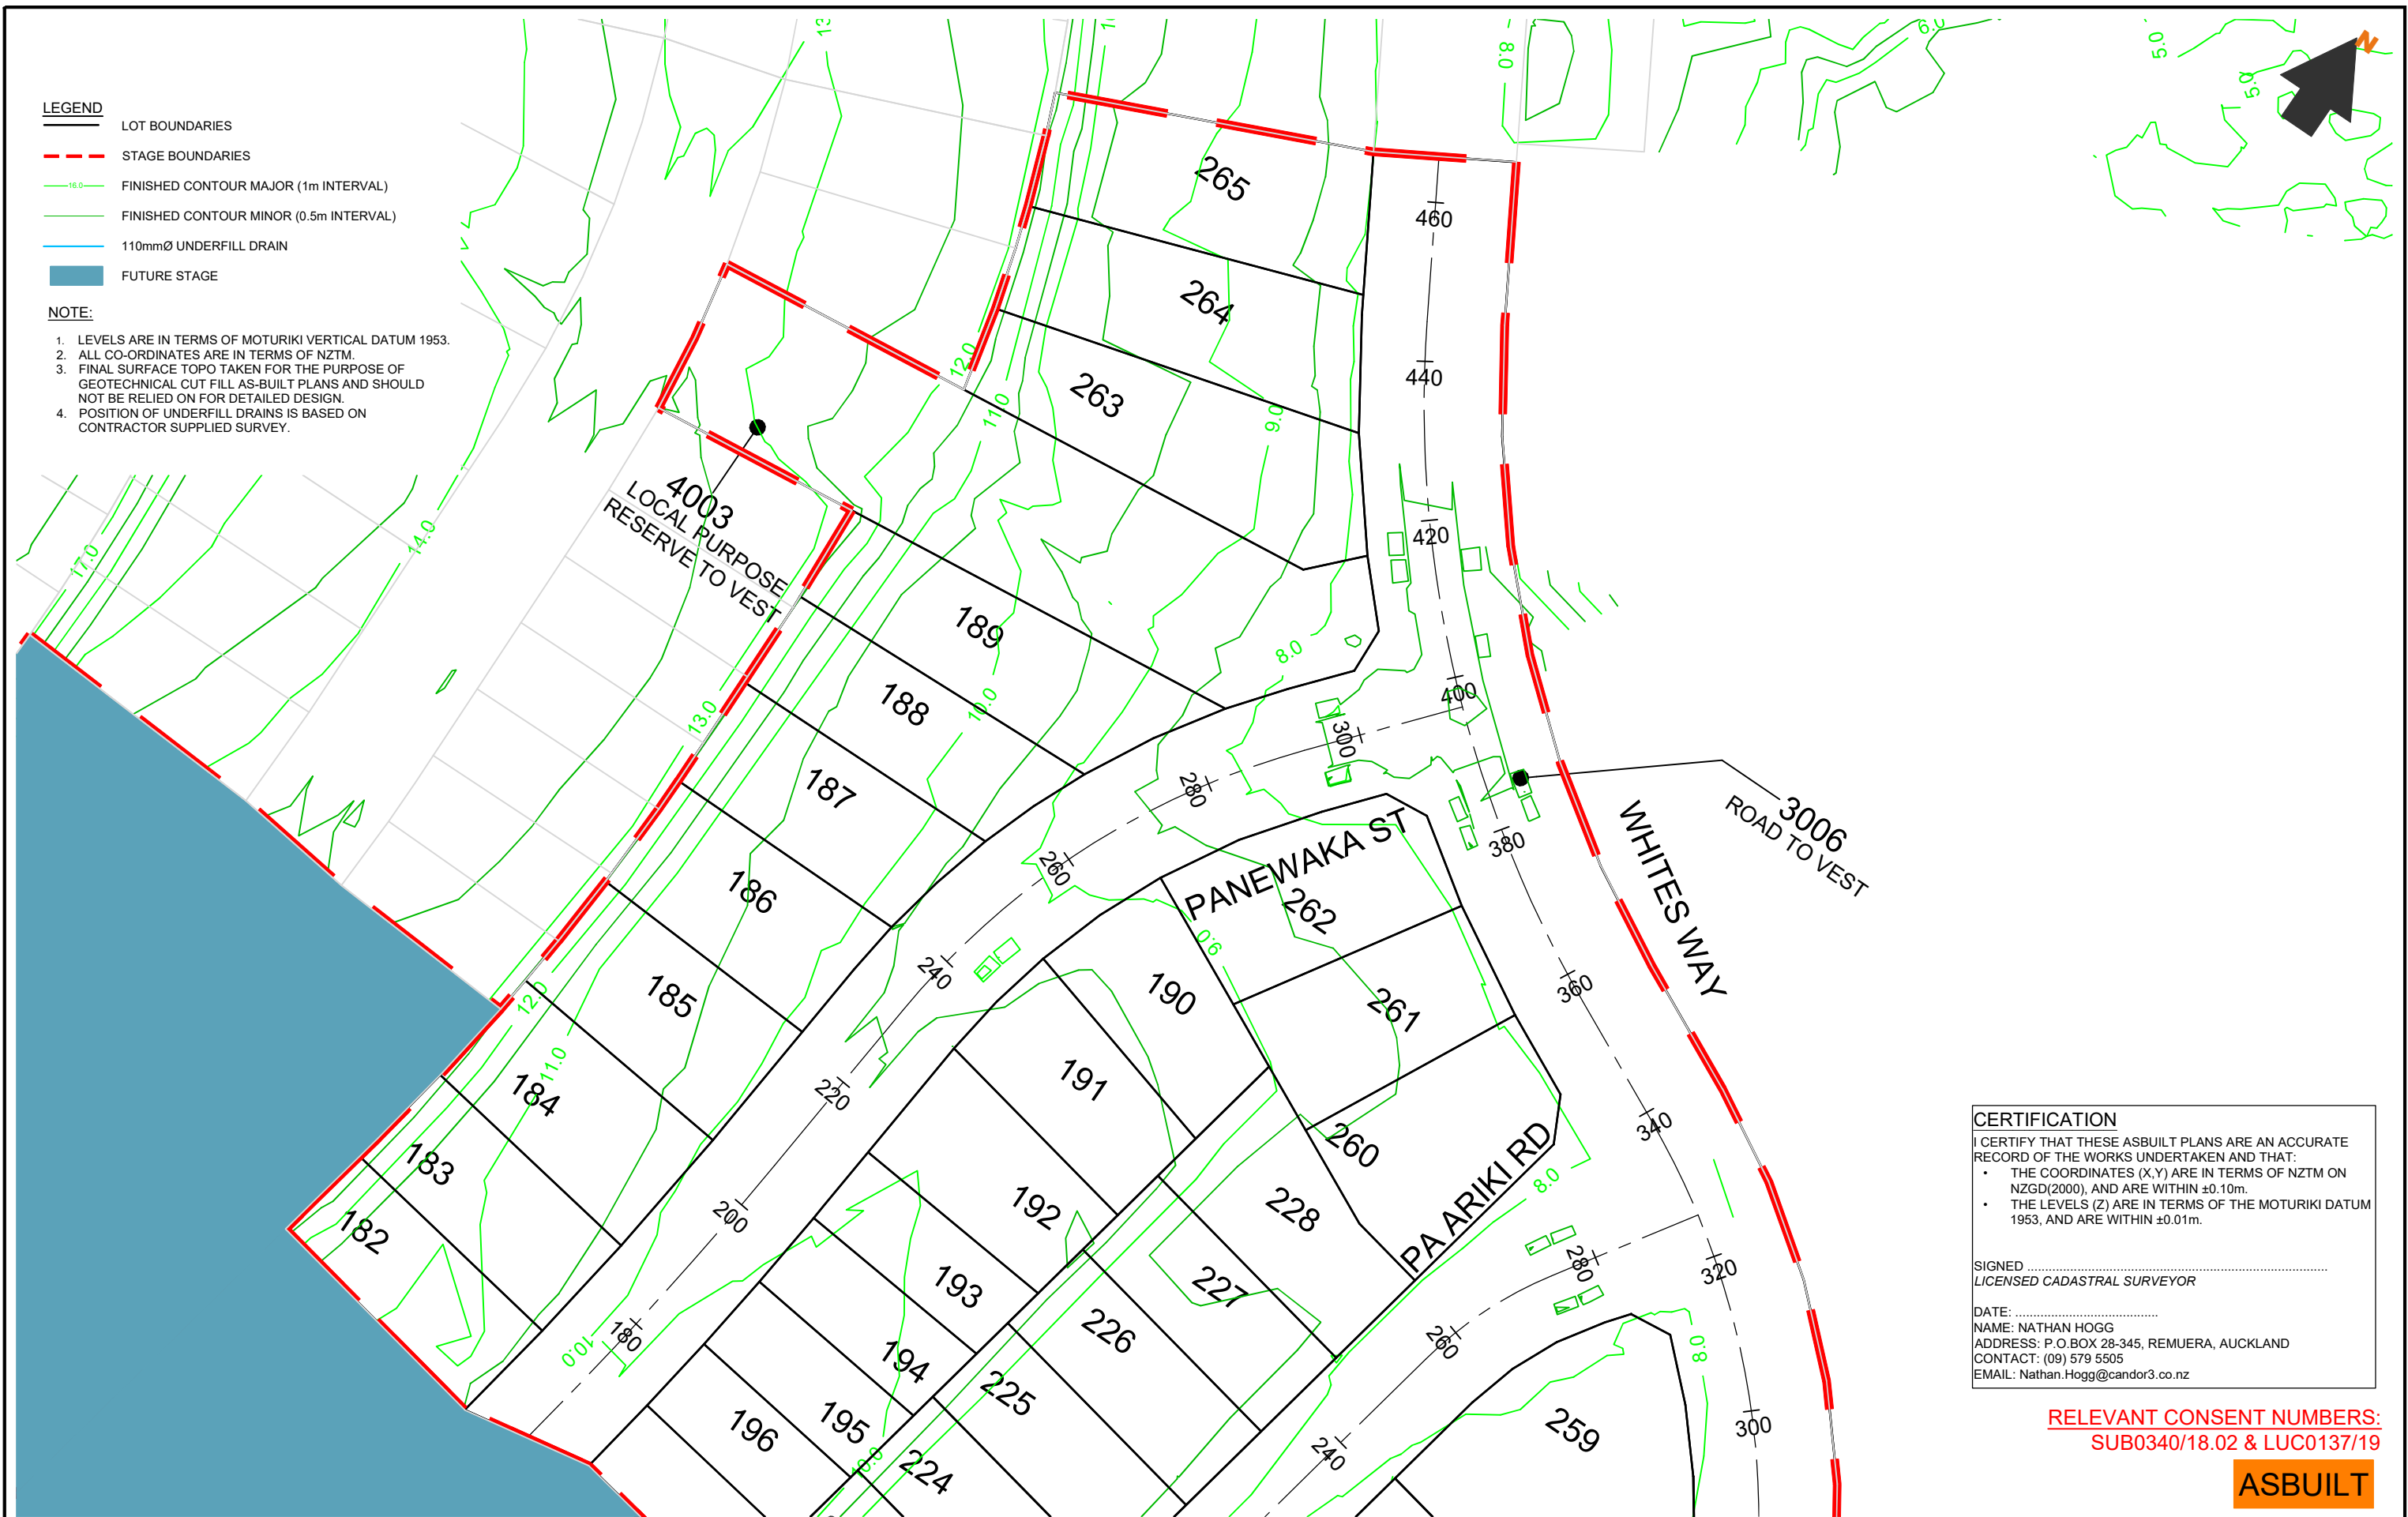


CERTIFICATION
I CERTIFY THAT THESE ASBUILT PLANS ARE AN ACCURATE RECORD OF THE WORKS UNDERTAKEN AND THAT:
• THE COORDINATES (X,Y) ARE IN TERMS OF NZTM ON NZGD(2000), AND ARE WITHIN ±0.10m.
• THE LEVELS (Z) ARE IN TERMS OF THE MOTURIKI DATUM 1953, AND ARE WITHIN ±0.01m.


SIGNED
LICENSED CADASTRAL SURVEYOR

DATE:
NAME: NATHAN HOGG
ADDRESS: P.O.BOX 28-345, REMUERA, AUCKLAND
CONTACT: (09) 579 5505
EMAIL: Nathan.Hogg@candor3.co.nz

RELEVANT CONSENT NUMBERS:
SUB0340/18.02 & LUC0137/19

ASBUILT

REV DESCRIPTION		BY APPVD DATE	 Candor³ ENGINEERING FOR LIFE	PROJECT LAKESIDE, TE KAUWHATA EARTHWORKS FINISHED SURFACE STAGE 4 SHEET 2 OF 3	CLIENT LAKESIDE DEVELOPMENTS 2017 LIMITED	PURPOSE AS-BUILT		
						DESIGN JS DRAWN JS CHECK RS	APPROVED BY NH DATE SEP 2020	SCALE 1:750 @ A3
						PROJECT NO. 1239	DRAWING NO. AB-2-201	REV. -

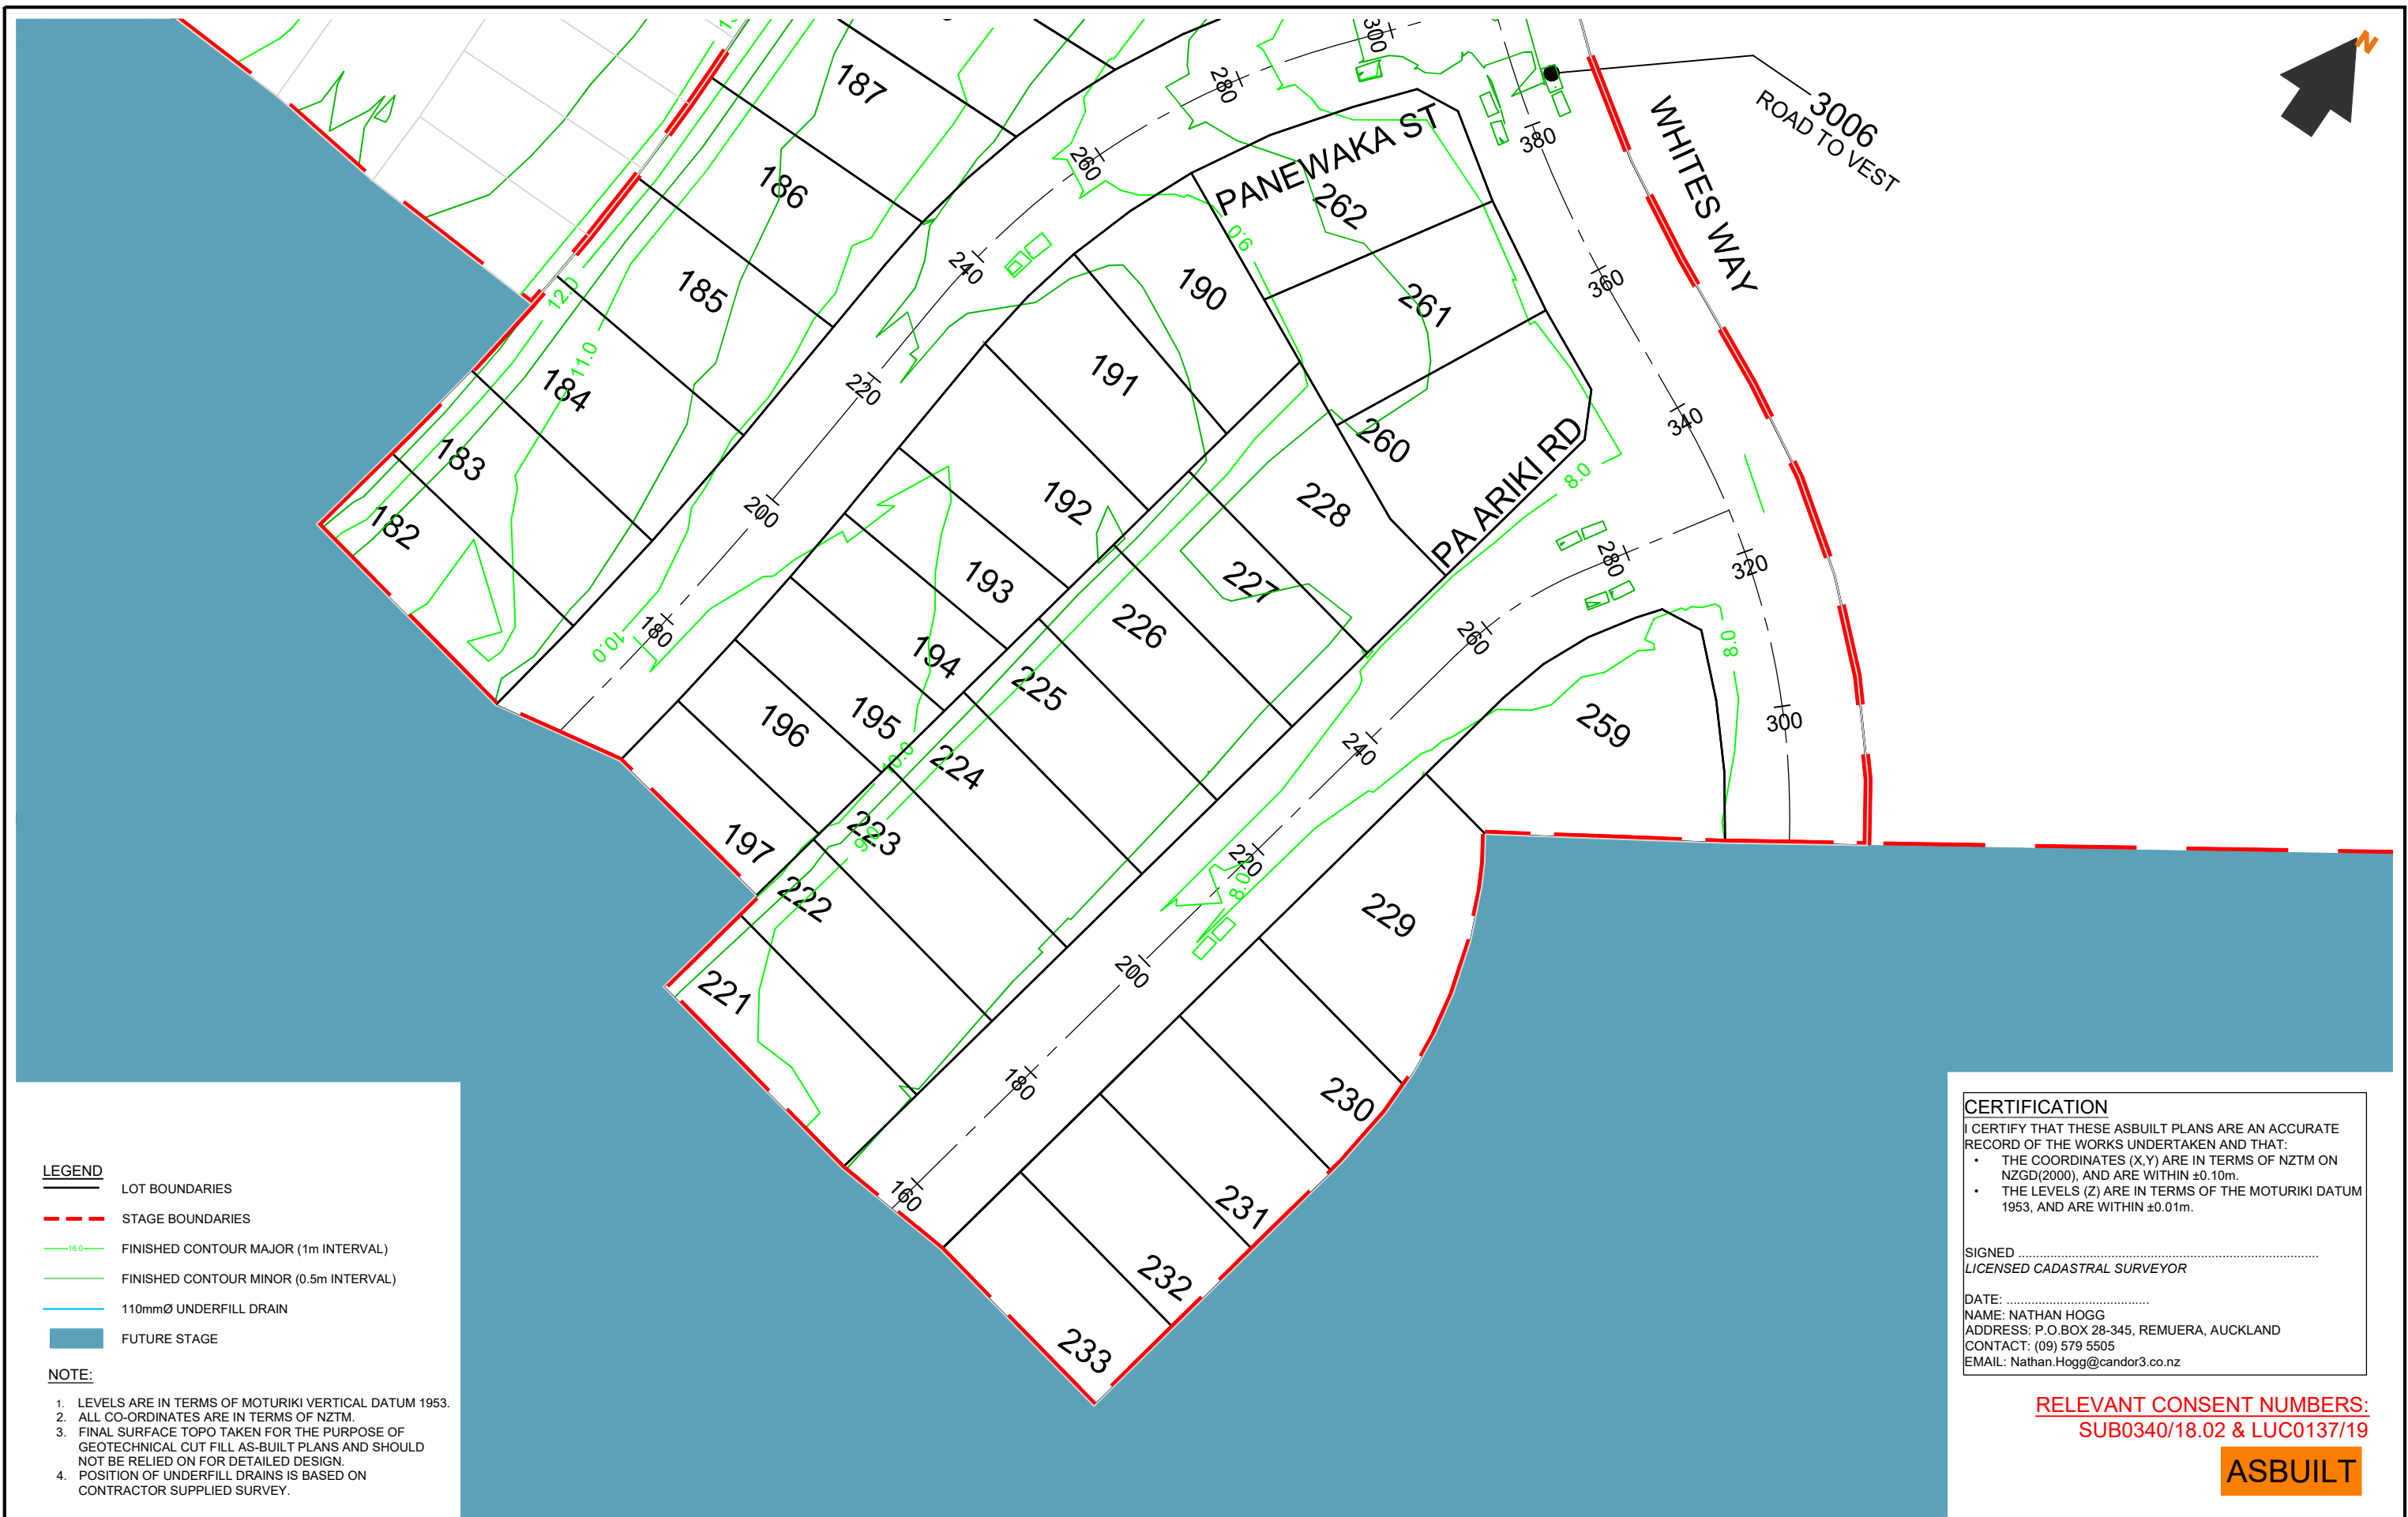

LEGEND

- LOT BOUNDARIES
- STAGE BOUNDARIES
- FINISHED CONTOUR MAJOR (1m INTERVAL)
- FINISHED CONTOUR MINOR (0.5m INTERVAL)
- 110mmØ UNDERFILL DRAIN
- FUTURE STAGE

NOTE:

- LEVELS ARE IN TERMS OF MOTURIKI VERTICAL DATUM 1953.
- ALL CO-ORDINATES ARE IN TERMS OF NZTM.
- FINAL SURFACE TOPO TAKEN FOR THE PURPOSE OF GEOTECHNICAL CUT FILL AS-BUILT PLANS AND SHOULD NOT BE RELIED ON FOR DETAILED DESIGN.
- POSITION OF UNDERFILL DRAINS IS BASED ON CONTRACTOR SUPPLIED SURVEY.

CERTIFICATION

I CERTIFY THAT THESE ASBUILT PLANS ARE AN ACCURATE RECORD OF THE WORKS UNDERTAKEN AND THAT:

- THE COORDINATES (X,Y) ARE IN TERMS OF NZTM ON NZGD(2000), AND ARE WITHIN ±0.10m.
- THE LEVELS (Z) ARE IN TERMS OF THE MOTURIKI DATUM 1953, AND ARE WITHIN ±0.01m.

SIGNED
LICENSED CADASTRAL SURVEYOR


DATE:
NAME: NATHAN HOGG
ADDRESS: P.O.BOX 28-345, REMUERA, AUCKLAND
CONTACT: (09) 579 5505
EMAIL: Nathan.Hogg@candor3.co.nz

RELEVANT CONSENT NUMBERS:
SUB0340/18.02 & LUC0137/19

ASBUILT

REV DESCRIPTION		BY	APPVD	DATE	PROJECT		CLIENT		PURPOSE		
					LAKESIDE, TE KAUWHATA		LAKESIDE		AS-BUILT		
					EARTHWORKS FINISHED SURFACE STAGE 4		DEVELOPMENTS 2017		DESIGN JS	APPROVED BY NH	SCALE 1:750 @ A3
					SHEET 3 OF 3		LIMITED		CHECK RS	DATE SEP 2020	
									PROJECT NO.	DRAWING NO.	REV.
									1239	AB-2-202	-



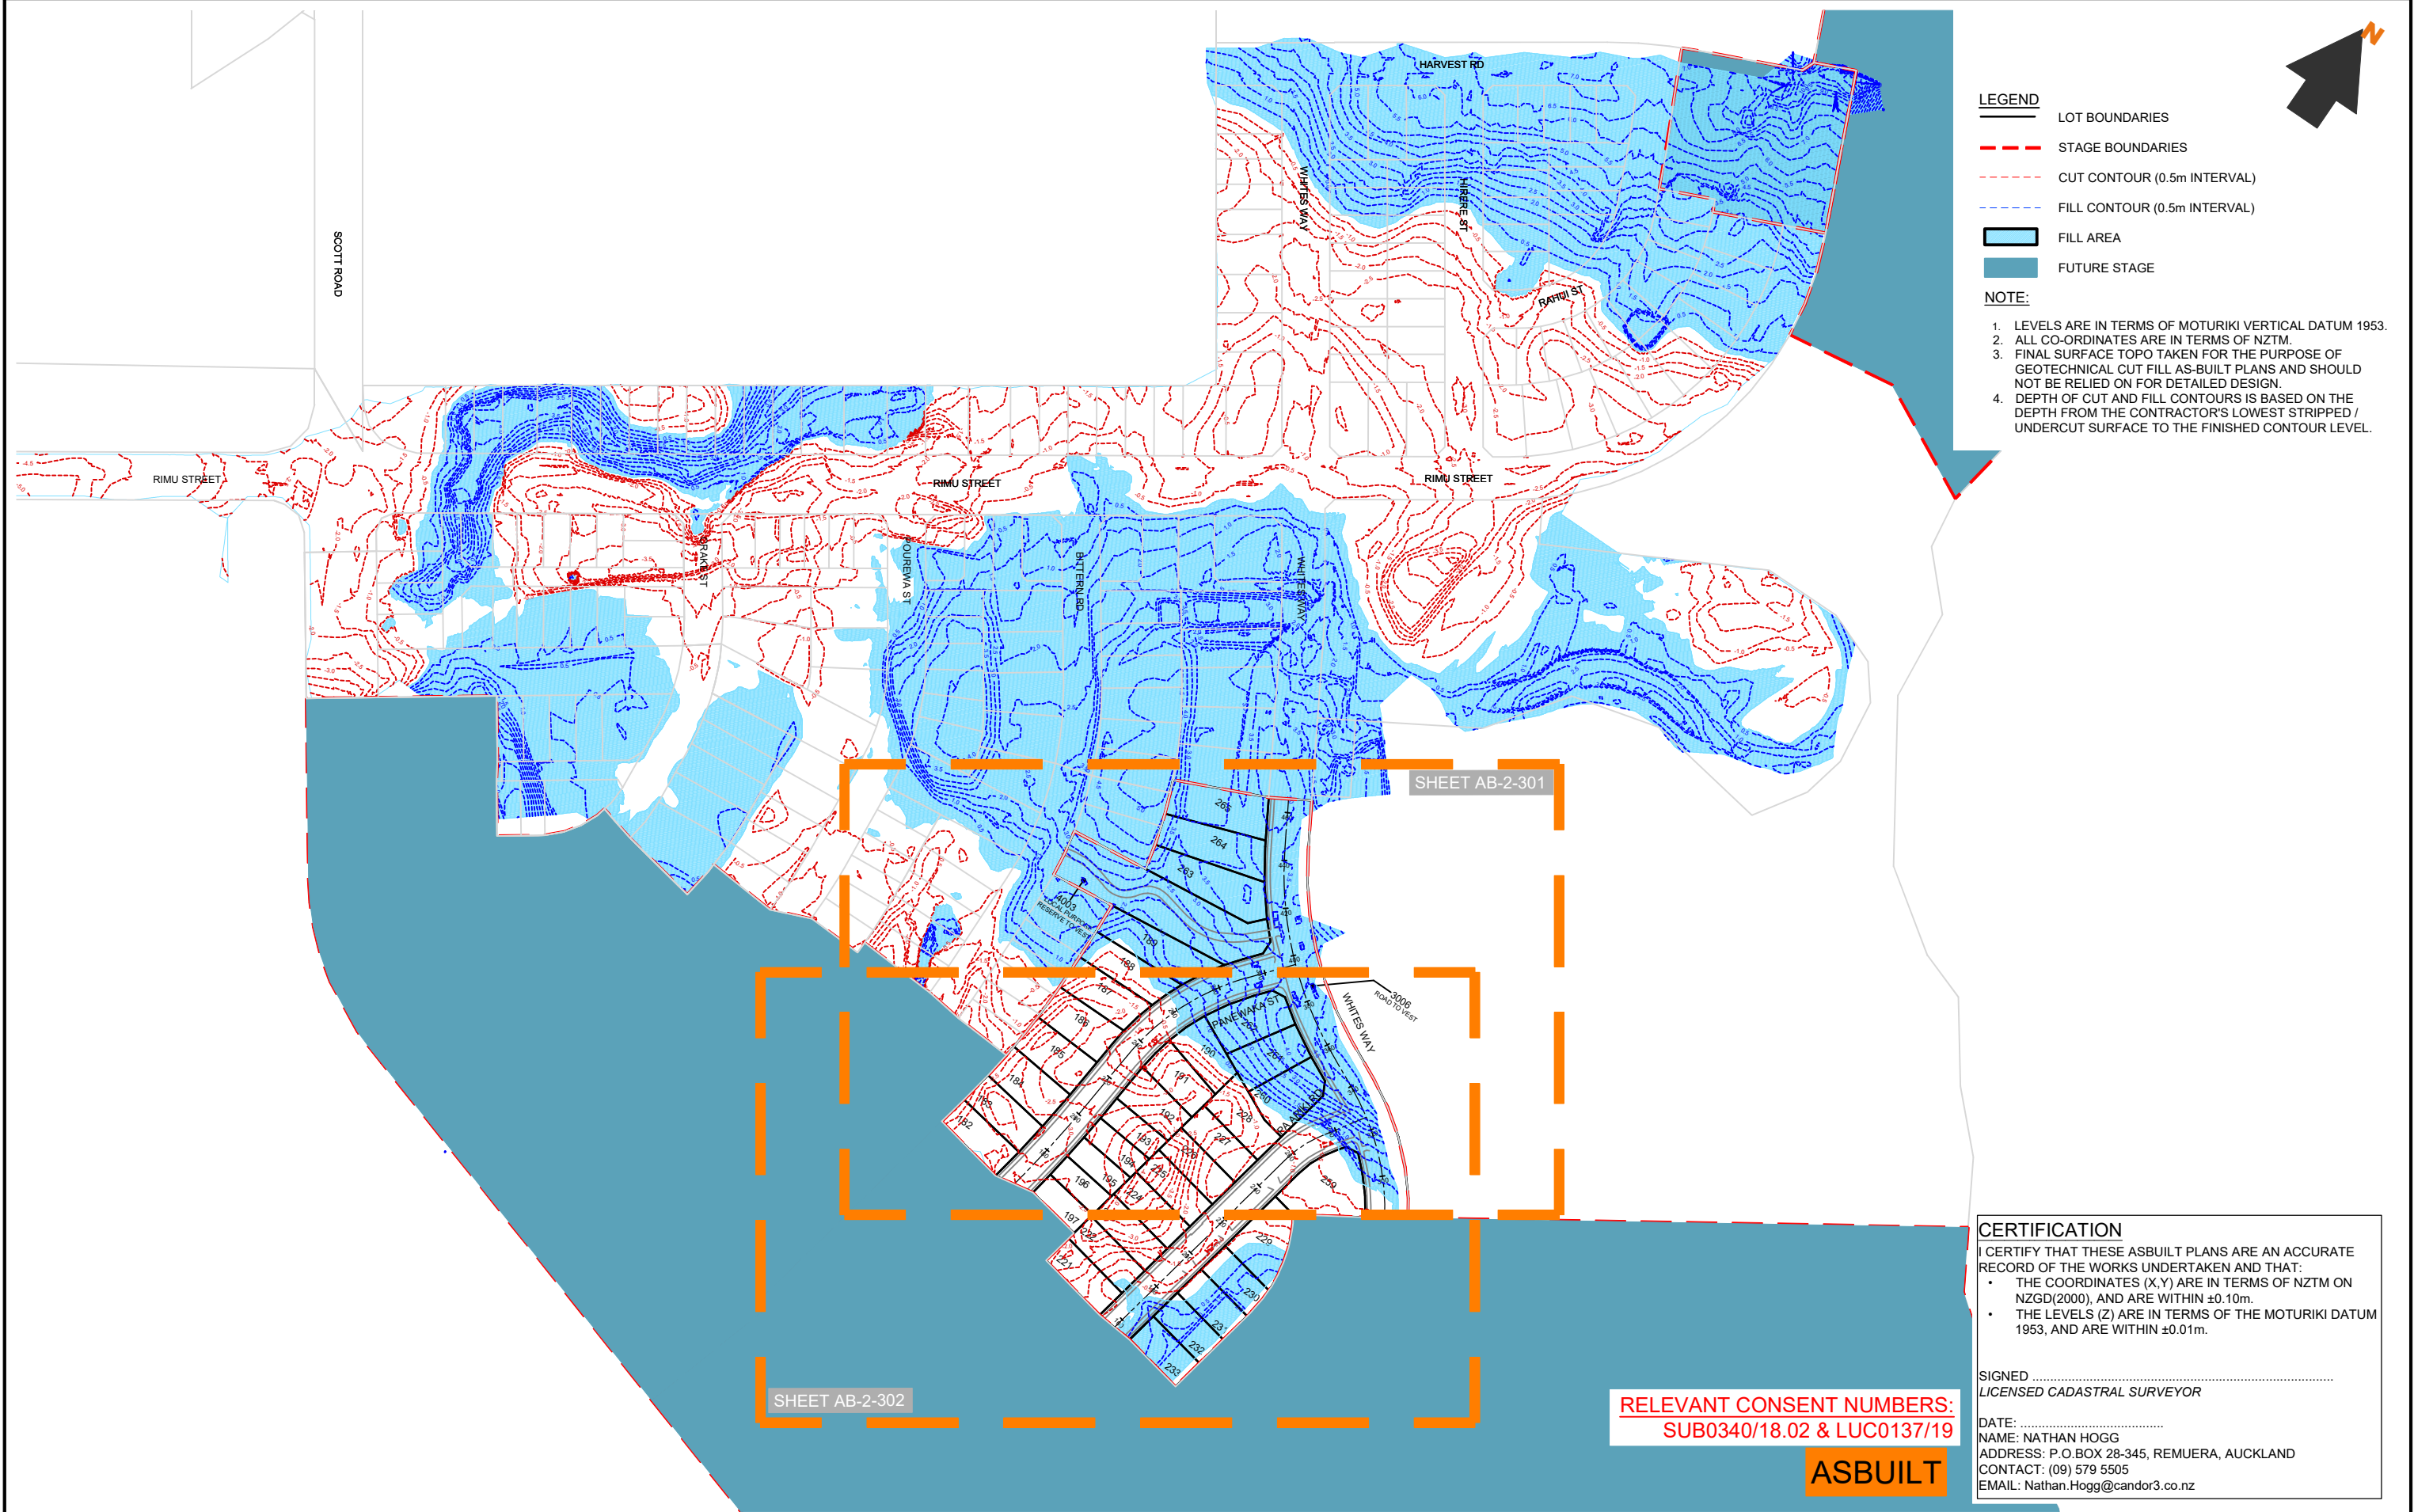

- LEGEND**
- LOT BOUNDARIES
 - STAGE BOUNDARIES
 - CUT CONTOUR (0.5m INTERVAL)
 - FILL CONTOUR (0.5m INTERVAL)
 - FILL AREA
 - FUTURE STAGE
- NOTE:**
- LEVELS ARE IN TERMS OF MOTURIKI VERTICAL DATUM 1953.
 - ALL CO-ORDINATES ARE IN TERMS OF NZTM.
 - FINAL SURFACE TOPO TAKEN FOR THE PURPOSE OF GEOTECHNICAL CUT FILL AS-BUILT PLANS AND SHOULD NOT BE RELIED ON FOR DETAILED DESIGN.
 - DEPTH OF CUT AND FILL CONTOURS IS BASED ON THE DEPTH FROM THE CONTRACTOR'S LOWEST STRIPPED / UNDERCUT SURFACE TO THE FINISHED CONTOUR LEVEL.

CERTIFICATION

I CERTIFY THAT THESE ASBUILT PLANS ARE AN ACCURATE RECORD OF THE WORKS UNDERTAKEN AND THAT:

- THE COORDINATES (X,Y) ARE IN TERMS OF NZTM ON NZGD(2000), AND ARE WITHIN $\pm 0.10\text{m}$.
- THE LEVELS (Z) ARE IN TERMS OF THE MOTURIKI DATUM 1953, AND ARE WITHIN $\pm 0.01\text{m}$.

SIGNED
LICENSED CADASTRAL SURVEYOR

DATE:
NAME: NATHAN HOGG
ADDRESS: P.O. BOX 28-345, REMUERA, AUCKLAND
CONTACT: (09) 579 5505
EMAIL: Nathan.Hogg@candor3.co.nz

RELEVANT CONSENT NUMBERS:
SUB0340/18.02 & LUC0137/19

ASBUILT


REV DESCRIPTION		BY	APPVD	DATE	PROJECT		CLIENT		PURPOSE		
					LAKESIDE, TE KAUPHATA EARTHWORKS DEPTH CONTOURS STAGE 4 SHEET 1 OF 3		LAKESIDE DEVELOPMENTS 2017 LIMITED		AS-BUILT		
DESIGN JS		APPROVED BY NH		SCALE		PROJECT NO.		DRAWING NO.		REV.	
DRAWN JS		DATE SEP 2020		1:2500 @ A3		1239		AB-2-300		-	
CHECK RS											

LEGEND

- LOT BOUNDARIES
- STAGE BOUNDARIES
- CUT CONTOUR (0.5m INTERVAL)
- FILL CONTOUR (0.5m INTERVAL)
- FILL AREA
- FUTURE STAGE

NOTE:

- LEVELS ARE IN TERMS OF MOTURIKI VERTICAL DATUM 1953.
- ALL CO-ORDINATES ARE IN TERMS OF NZTM.
- FINAL SURFACE TOPO TAKEN FOR THE PURPOSE OF GEOTECHNICAL CUT FILL AS-BUILT PLANS AND SHOULD NOT BE RELIED ON FOR DETAILED DESIGN.
- DEPTH OF CUT AND FILL CONTOURS IS BASED ON THE DEPTH FROM THE CONTRACTOR'S LOWEST STRIPPED / UNDERCUT SURFACE TO THE FINISHED CONTOUR LEVEL.

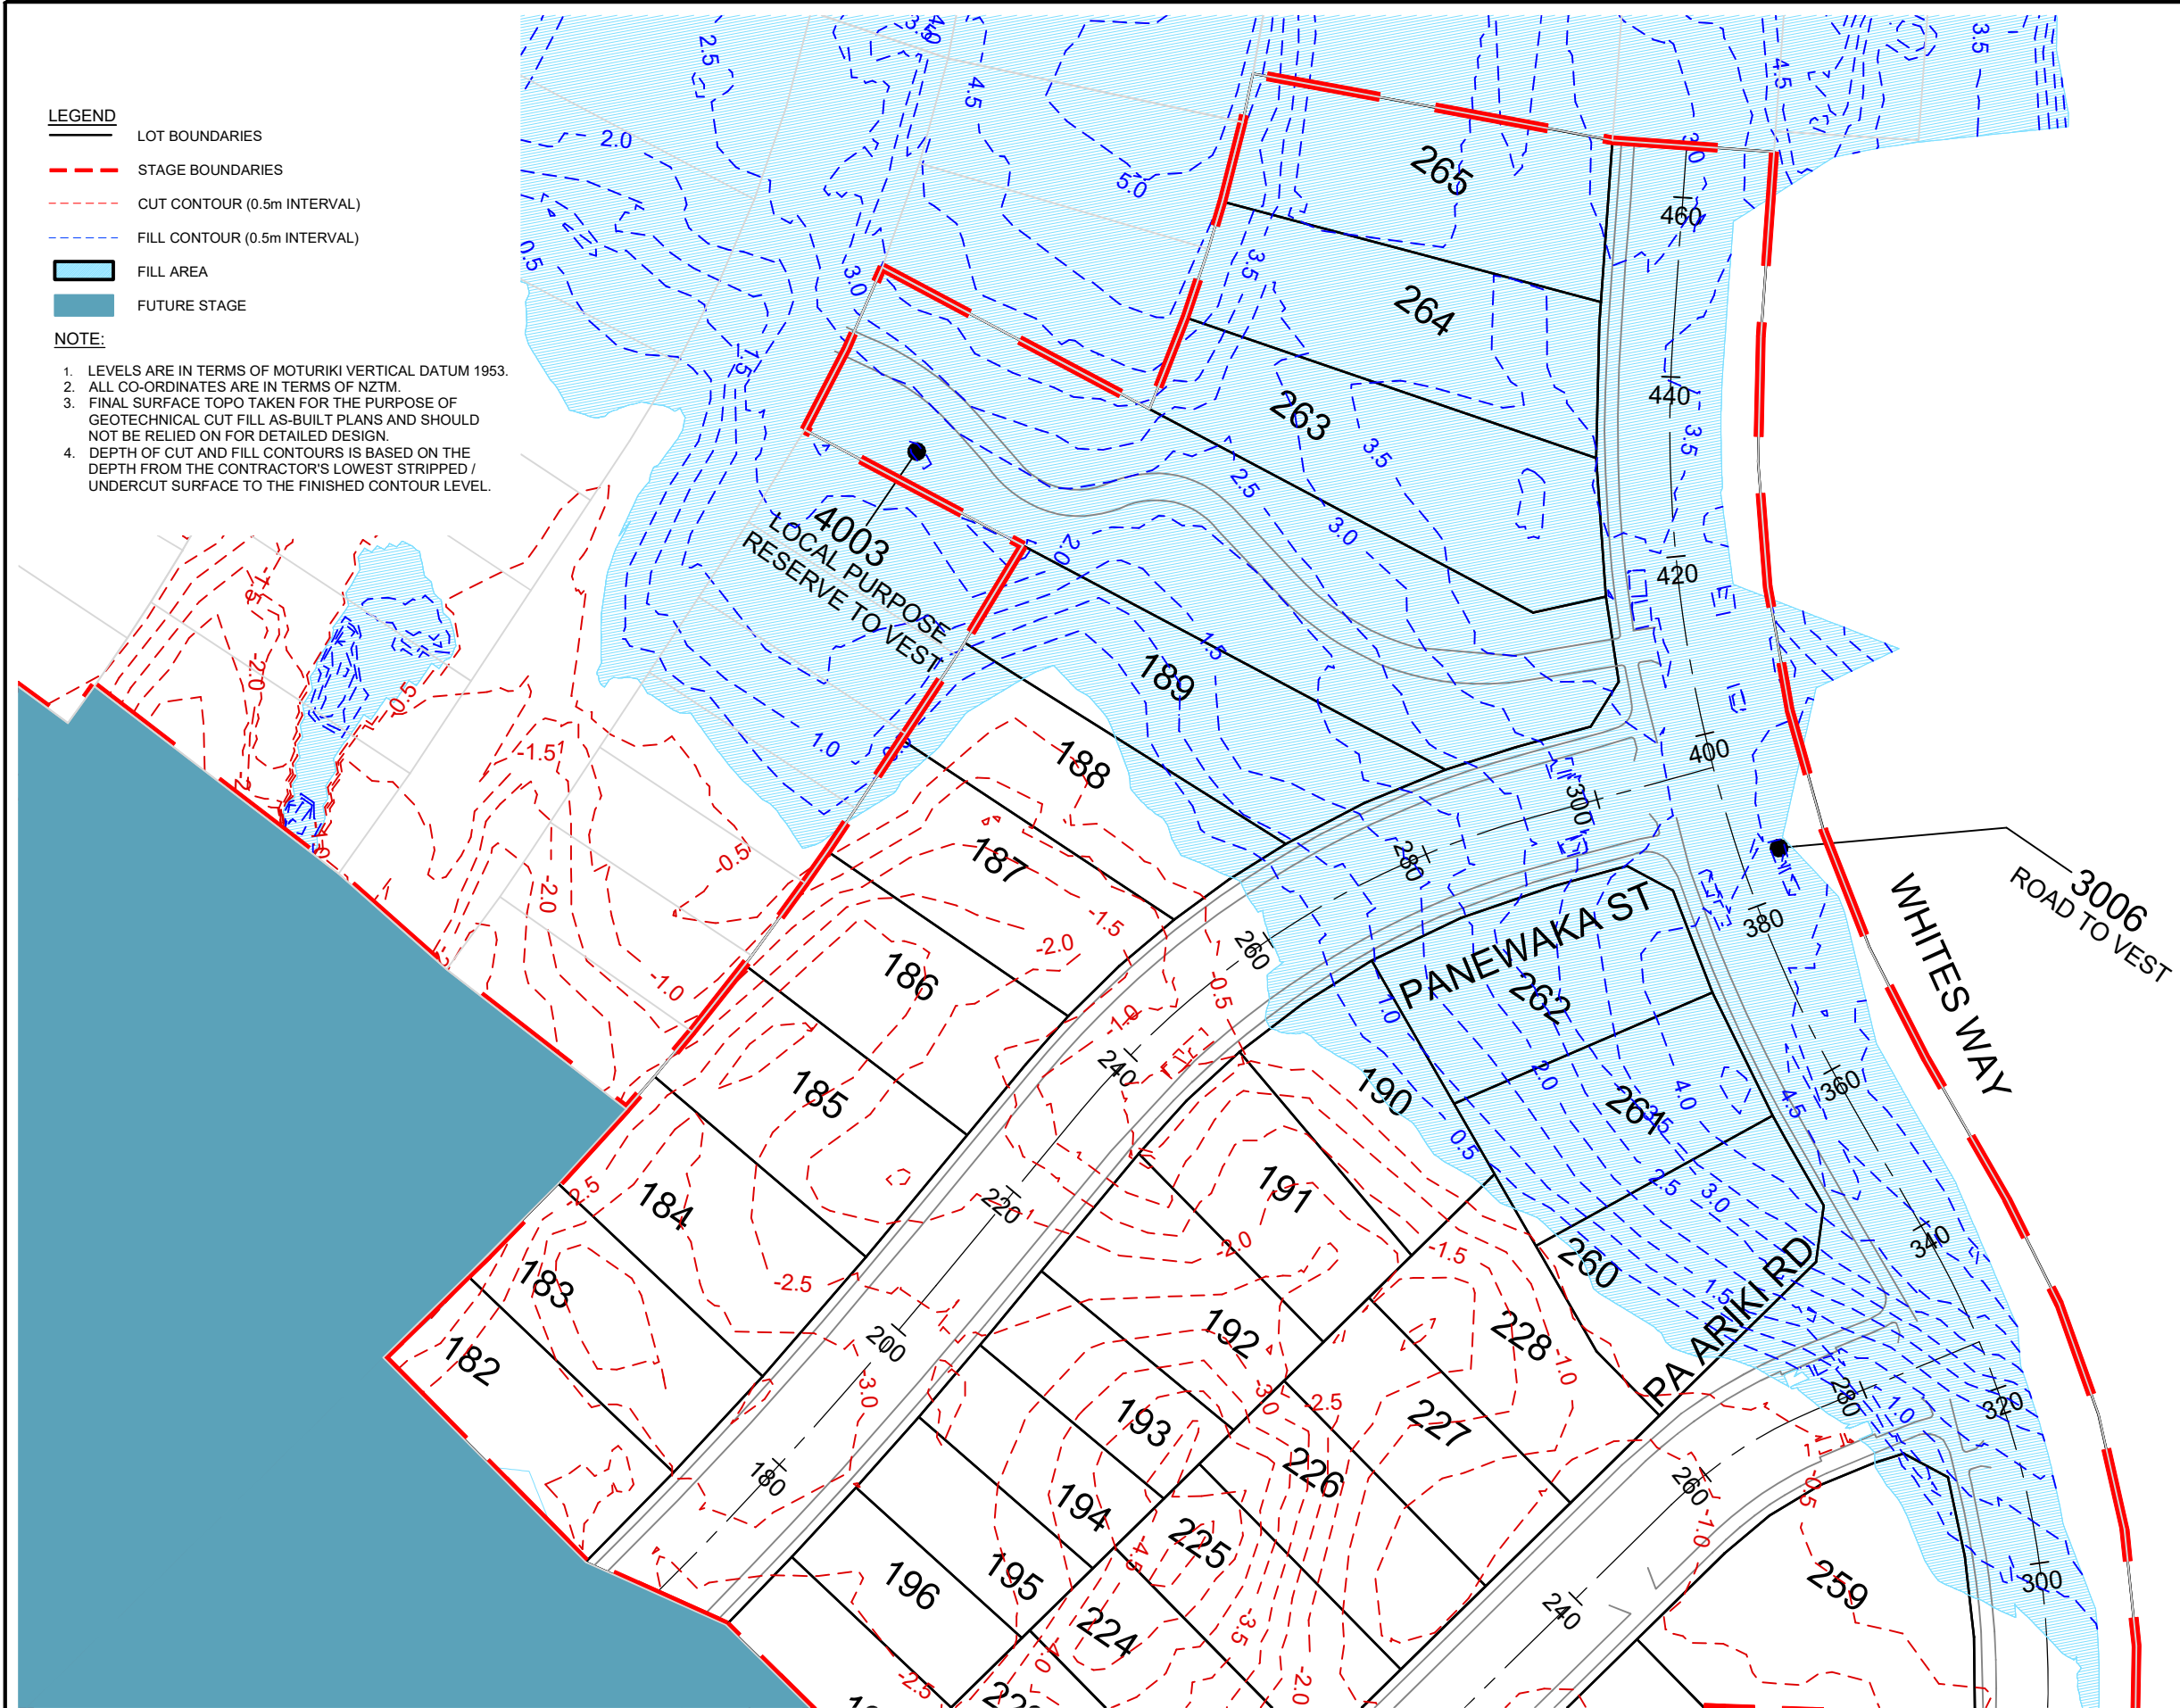

CERTIFICATION

I CERTIFY THAT THESE ASBUILT PLANS ARE AN ACCURATE RECORD OF THE WORKS UNDERTAKEN AND THAT:

- THE COORDINATES (X,Y) ARE IN TERMS OF NZTM ON NZGD(2000), AND ARE WITHIN ±0.10m.
- THE LEVELS (Z) ARE IN TERMS OF THE MOTURIKI DATUM 1953, AND ARE WITHIN ±0.01m.


SIGNED
LICENSED CADASTRAL SURVEYOR

DATE:
NAME: NATHAN HOGG
ADDRESS: P.O.BOX 28-345, REMUERA, AUCKLAND
CONTACT: (09) 579 5505
EMAIL: Nathan.Hogg@candor3.co.nz

RELEVANT CONSENT NUMBERS:
SUB0340/18.02 & LUC0137/19

ASBUILT

REV DESCRIPTION		BY APPVD DATE	PROJECT		CLIENT	PURPOSE	
			LAKESIDE, TE KAUWHATA		LAKESIDE DEVELOPMENTS 2017 LIMITED	AS-BUILT	
			EARTHWORKS DEPTH CONTOURS STAGE 4			DESIGN JS	APPROVED BY NH
			SHEET 2 OF 3			CHECK RS	DATE SEP 2020
						PROJECT NO.	DRAWING NO.
						1239	AB-2-301
							REV.
							-

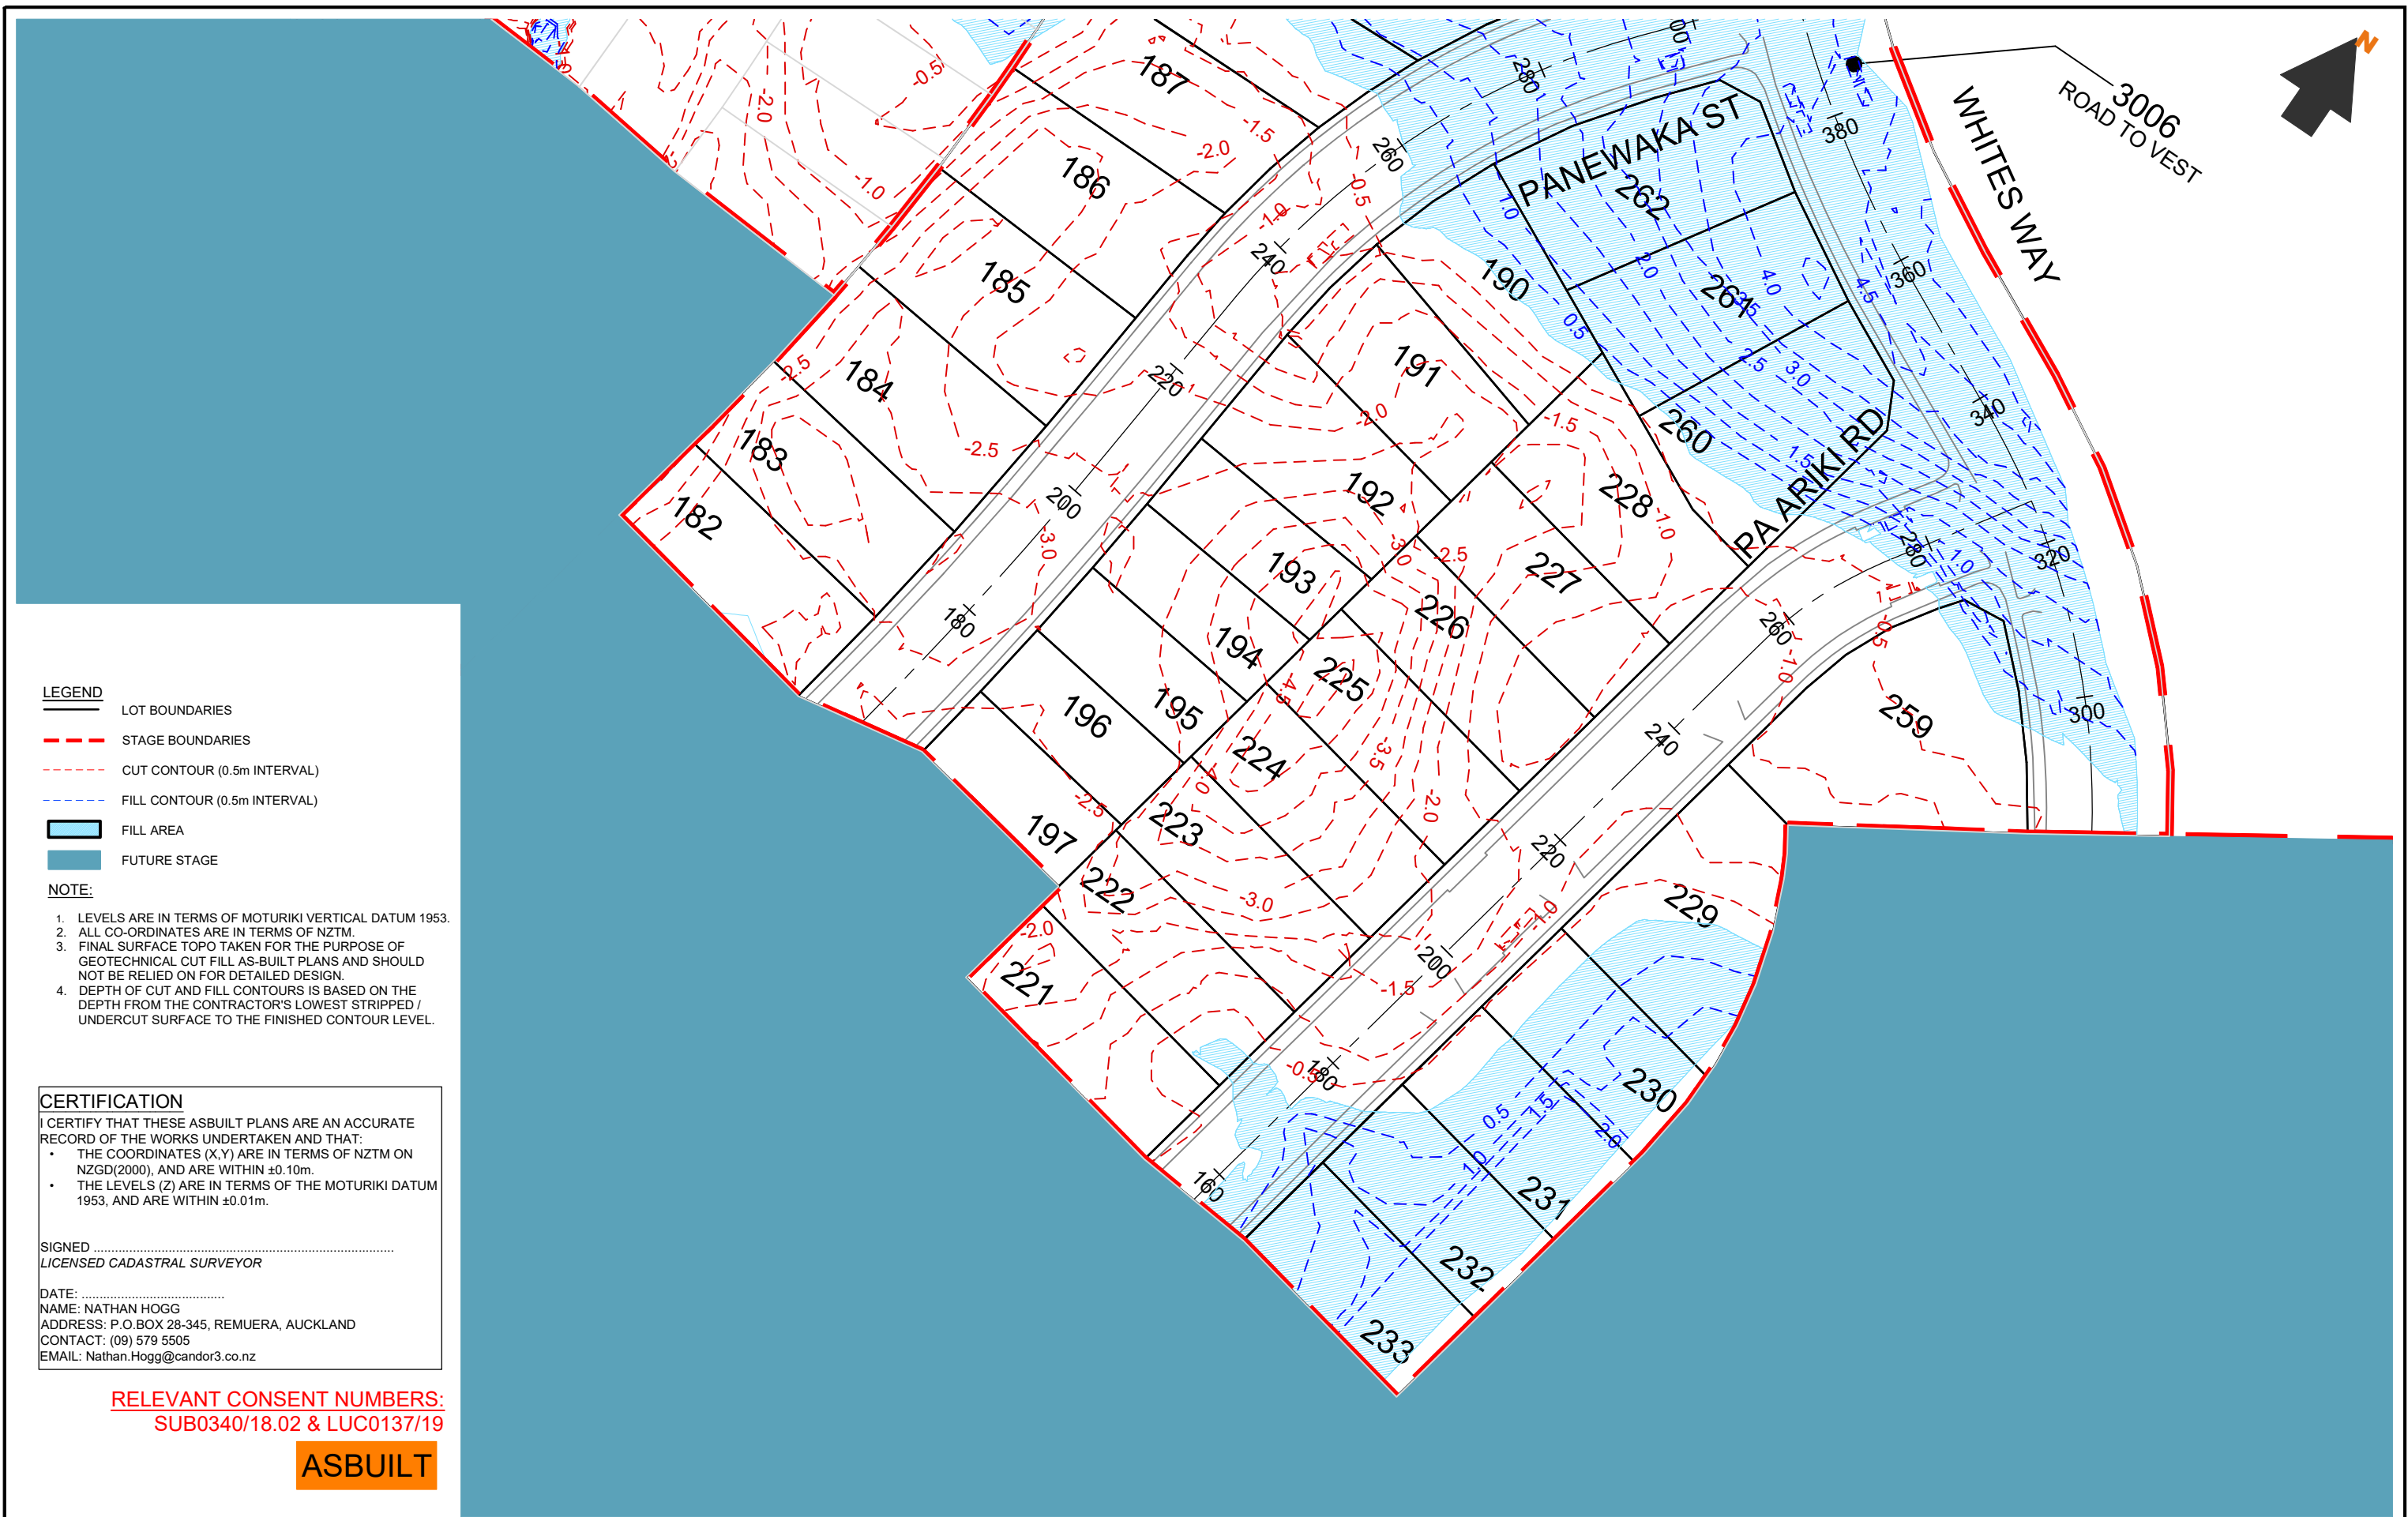

- LEGEND**
- LOT BOUNDARIES
 - STAGE BOUNDARIES
 - CUT CONTOUR (0.5m INTERVAL)
 - FILL CONTOUR (0.5m INTERVAL)
 - FILL AREA
 - FUTURE STAGE

- NOTE:**
- LEVELS ARE IN TERMS OF MOTURIKI VERTICAL DATUM 1953.
 - ALL CO-ORDINATES ARE IN TERMS OF NZTM.
 - FINAL SURFACE TOPO TAKEN FOR THE PURPOSE OF GEOTECHNICAL CUT FILL AS-BUILT PLANS AND SHOULD NOT BE RELIED ON FOR DETAILED DESIGN.
 - DEPTH OF CUT AND FILL CONTOURS IS BASED ON THE DEPTH FROM THE CONTRACTOR'S LOWEST STRIPPED / UNDERCUT SURFACE TO THE FINISHED CONTOUR LEVEL.

CERTIFICATION

I CERTIFY THAT THESE ASBUILT PLANS ARE AN ACCURATE RECORD OF THE WORKS UNDERTAKEN AND THAT:

- THE COORDINATES (X,Y) ARE IN TERMS OF NZTM ON NZGD(2000), AND ARE WITHIN ±0.10m.
- THE LEVELS (Z) ARE IN TERMS OF THE MOTURIKI DATUM 1953, AND ARE WITHIN ±0.01m.

SIGNED
LICENSED CADASTRAL SURVEYOR

DATE:
NAME: NATHAN HOGG
ADDRESS: P.O.BOX 28-345, REMUERA, AUCKLAND
CONTACT: (09) 579 5505
EMAIL: Nathan.Hogg@candor3.co.nz

RELEVANT CONSENT NUMBERS:
SUB0340/18.02 & LUC0137/19

ASBUILT

REV DESCRIPTION		BY	APPVD	DATE	PROJECT		CLIENT		PURPOSE				
<div>Candor³</div> <div>ENGINEERING FOR LIFE</div>					LAKESIDE, TE KAUWHATA EARTHWORKS DEPTH CONTOURS STAGE 4 SHEET 3 OF 3		LAKESIDE DEVELOPMENTS 2017 LIMITED		AS-BUILT				
									DESIGN JS		APPROVED		SCALE
									DRAWN JS		BY NH		1:750 @ A3
									CHECK RS		DATE SEP 2020		
									PROJECT NO.		DRAWING NO.		REV.
									1239		AB-2-302		-