

- LEGEND**
- LOT BOUNDARIES
- STAGE BOUNDARIES
- ROAD CENTRELINE
- EXISTING WATERMAIN
- H

X

 EXISTING FIRE HYDRANT / VALVE
- NEW DN315 PE100 WATERMAIN
- NEW DN250 PE100 WATERMAIN
- NEW DN180 PE100 WATERMAIN
- NEW DN125 PE100 WATERMAIN
- NEW 250mm PVC-O WATERMAIN
- NEW 200mm PVC-O WATERMAIN
- NEW 150mm PVC-O WATERMAIN
- NEW 100mm PVC-O WATERMAIN
- NEW 50mm PVC-O WATERMAIN
- W

W

 NEW 25mm LOT CONNECTION & WATER METER  
(POSITION INDICATIVE ON DRAWING FOR CLARITY)
- FH

 NEW FIRE HYDRANT
- X

X

 NEW SLUICE VALVE / PEET VALVE
- [

 NEW BLANK CAP
- FUTURE STAGE
- S01.###

 RITS - WATER MAIN PIPE ID NUMBER.

**NOTES**

1. ALL WORKS AND MATERIALS COMPLY WITH THE  
WAIKATO LOCAL AUTHORITY SHARED SERVICES  
REGIONAL INFRASTRUCTURE TECHNICAL  
SPECIFICATIONS (RITS) (MAY 2018).

2. WATERMAIN ASBUILT (BELOW GROUND ALIGNMENT)  
WAS COMPLETED BY ROSS REID CONTRACTORS.

**CERTIFICATION**

I CERTIFY THAT THESE ASBUILT PLANS ARE AN ACCURATE  
RECORD OF THE WORKS UNDERTAKEN AND THAT:

• THE COORDINATES (X,Y) ARE IN TERMS OF NZTM ON  
NZGD(2000), AND ARE WITHIN ±0.10m.

• THE LEVELS (Z) ARE IN TERMS OF THE MOTURIKI DATUM  
1953, AND ARE WITHIN ±0.01m.

SIGNED .....  
LICENSED CADASTRAL SURVEYOR

DATE: .....  
NAME: NATHAN HOGG  
ADDRESS: P.O.BOX 28-345, REMUERA, AUCKLAND  
CONTACT: (09) 579 5505  
EMAIL: Nathan.Hogg@candor3.co.nz

RELEVANT CONSENT NUMBERS:  
SUB0340/18.01 & LUC0137/19

ASBUILT

REV DESCRIPTION		BY	APPVD	DATE	PROJECT		CLIENT		PURPOSE		
					LAKESIDE, TE KAUWHATA WATERMAIN LAYOUT STAGE 2 1 OF 3		LAKESIDE DEVELOPMENTS 2017 LIMITED		AS-BUILT		
									DESIGN JS	APPROVED BY NH	SCALE 1:2500 @ A3
									DRAWN JS	DATE MAY 2020	
									CHECK RS		
									PROJECT NO.	DRAWING NO.	REV.
									1239	AB-6-100	-

- LEGEND**
- LOT BOUNDARIES
  - STAGE BOUNDARIES
  - ROAD CENTRELINE
  - EXISTING WATERMAIN
  - EXISTING FIRE HYDRANT / VALVE
  - NEW DN315 PE100 WATERMAIN
  - NEW DN250 PE100 WATERMAIN
  - NEW DN180 PE100 WATERMAIN
  - NEW DN125 PE100 WATERMAIN
  - NEW 250mm PVC-O WATERMAIN
  - NEW 200mm PVC-O WATERMAIN
  - NEW 150mm PVC-O WATERMAIN
  - NEW 100mm PVC-O WATERMAIN
  - NEW 50mm PVC-O WATERMAIN
  - NEW 25mm LOT CONNECTION & WATER METER (POSITION INDICATIVE ON DRAWING FOR CLARITY)
  - NEW FIRE HYDRANT
  - NEW SLUICE VALVE / PEET VALVE
  - NEW BLANK CAP
  - FUTURE STAGE
  - RITS - WATER MAIN PIPE ID NUMBER.

- NOTES**
- ALL WORKS AND MATERIALS COMPLY WITH THE WAIKATO LOCAL AUTHORITY SHARED SERVICES REGIONAL INFRASTRUCTURE TECHNICAL SPECIFICATIONS (RITS) (MAY 2018).
  - WATERMAIN ASBUILT (BELOW GROUND ALIGNMENT) WAS COMPLETED BY ROSS REID CONTRACTORS.

**CERTIFICATION**

I CERTIFY THAT THESE ASBUILT PLANS ARE AN ACCURATE RECORD OF THE WORKS UNDERTAKEN AND THAT:


- THE COORDINATES (X,Y) ARE IN TERMS OF NZTM ON NZGD(2000), AND ARE WITHIN ±0.10m.
- THE LEVELS (Z) ARE IN TERMS OF THE MOTURIKI DATUM 1953, AND ARE WITHIN ±0.01m.

SIGNED .....  
LICENSED CADASTRAL SURVEYOR


DATE: .....  
NAME: NATHAN HOGG  
ADDRESS: P.O.BOX 28-345, REMUERA, AUCKLAND  
CONTACT: (09) 579 5505  
EMAIL: Nathan.Hogg@candor3.co.nz

**RELEVANT CONSENT NUMBERS:**  
SUB0340/18.01 & LUC0137/19

**ASBUILT**

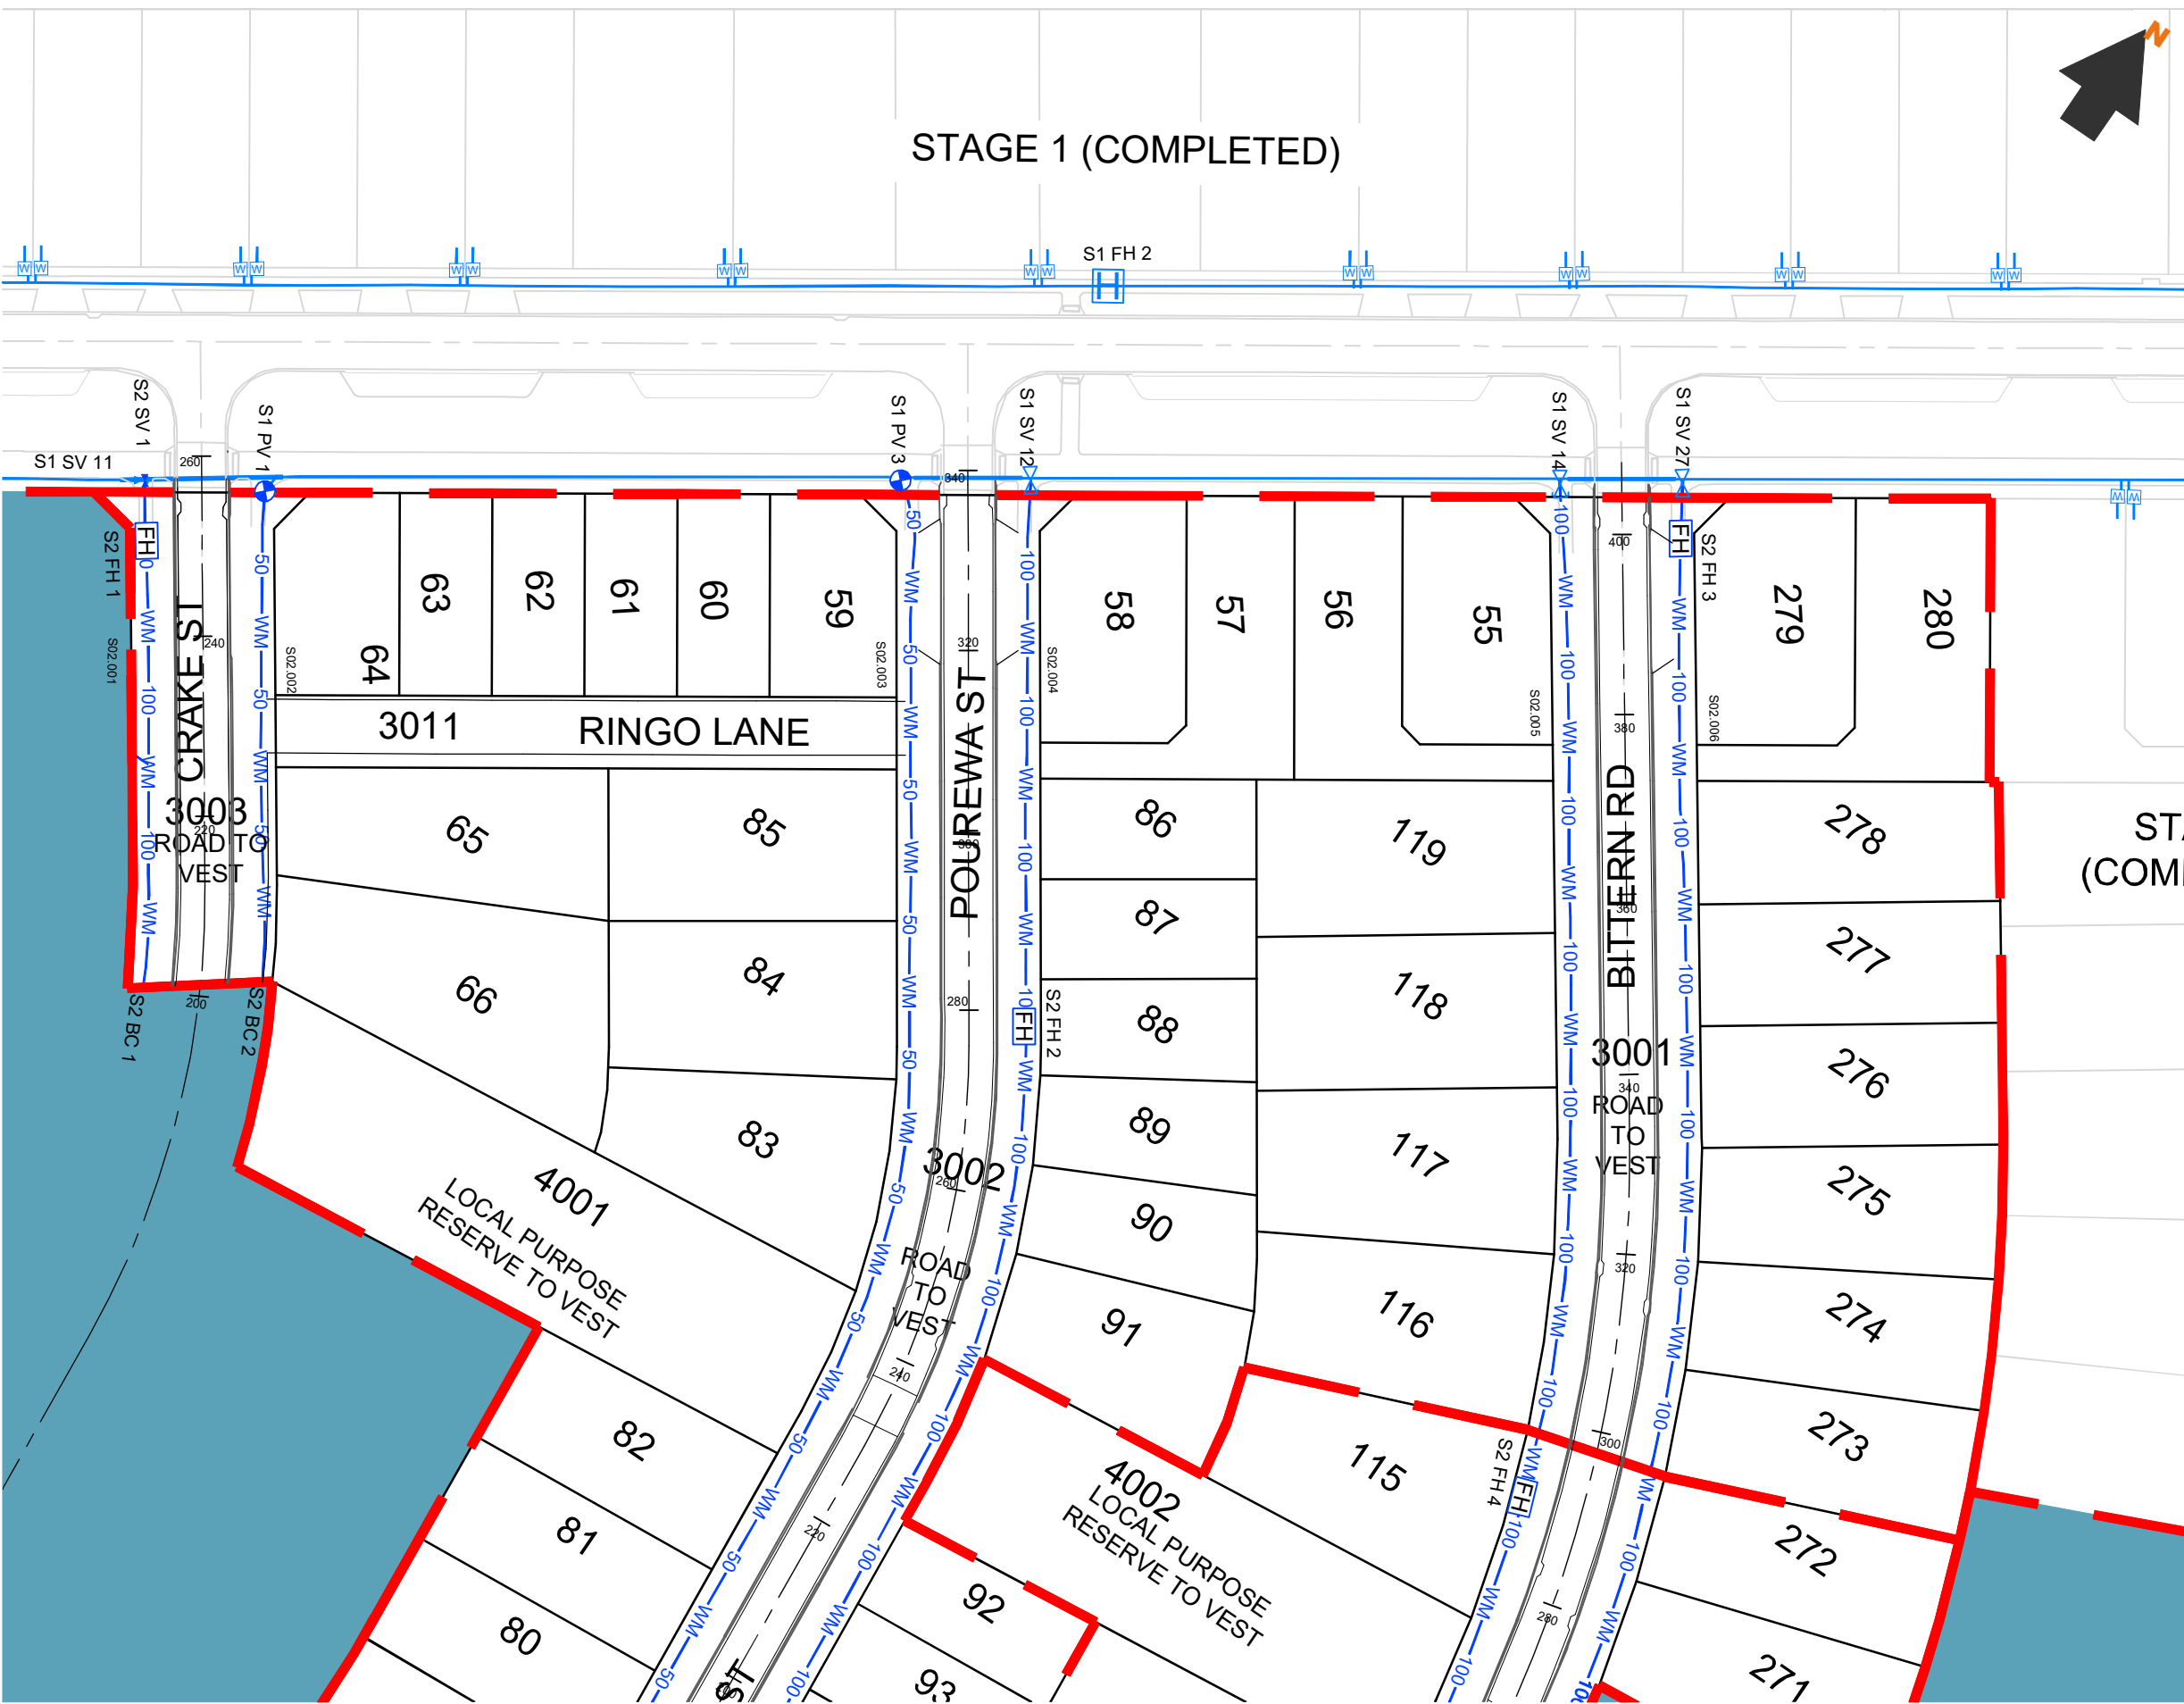

REV	DESCRIPTION	BY	APPVD	DATE	PROJECT	CLIENT	PURPOSE
					LAKESIDE, TE KAUPHATA WATERMAIN LAYOUT STAGE 2 2 OF 3	LAKESIDE DEVELOPMENTS 2017 LIMITED	AS-BUILT
							DESIGN JS DRAWN JS CHECK RS
							APPROVED BY NH DATE MAY 2020
							SCALE 1:750 @ A3
							PROJECT NO. 1239
							DRAWING NO. AB-6-101
							REV. -

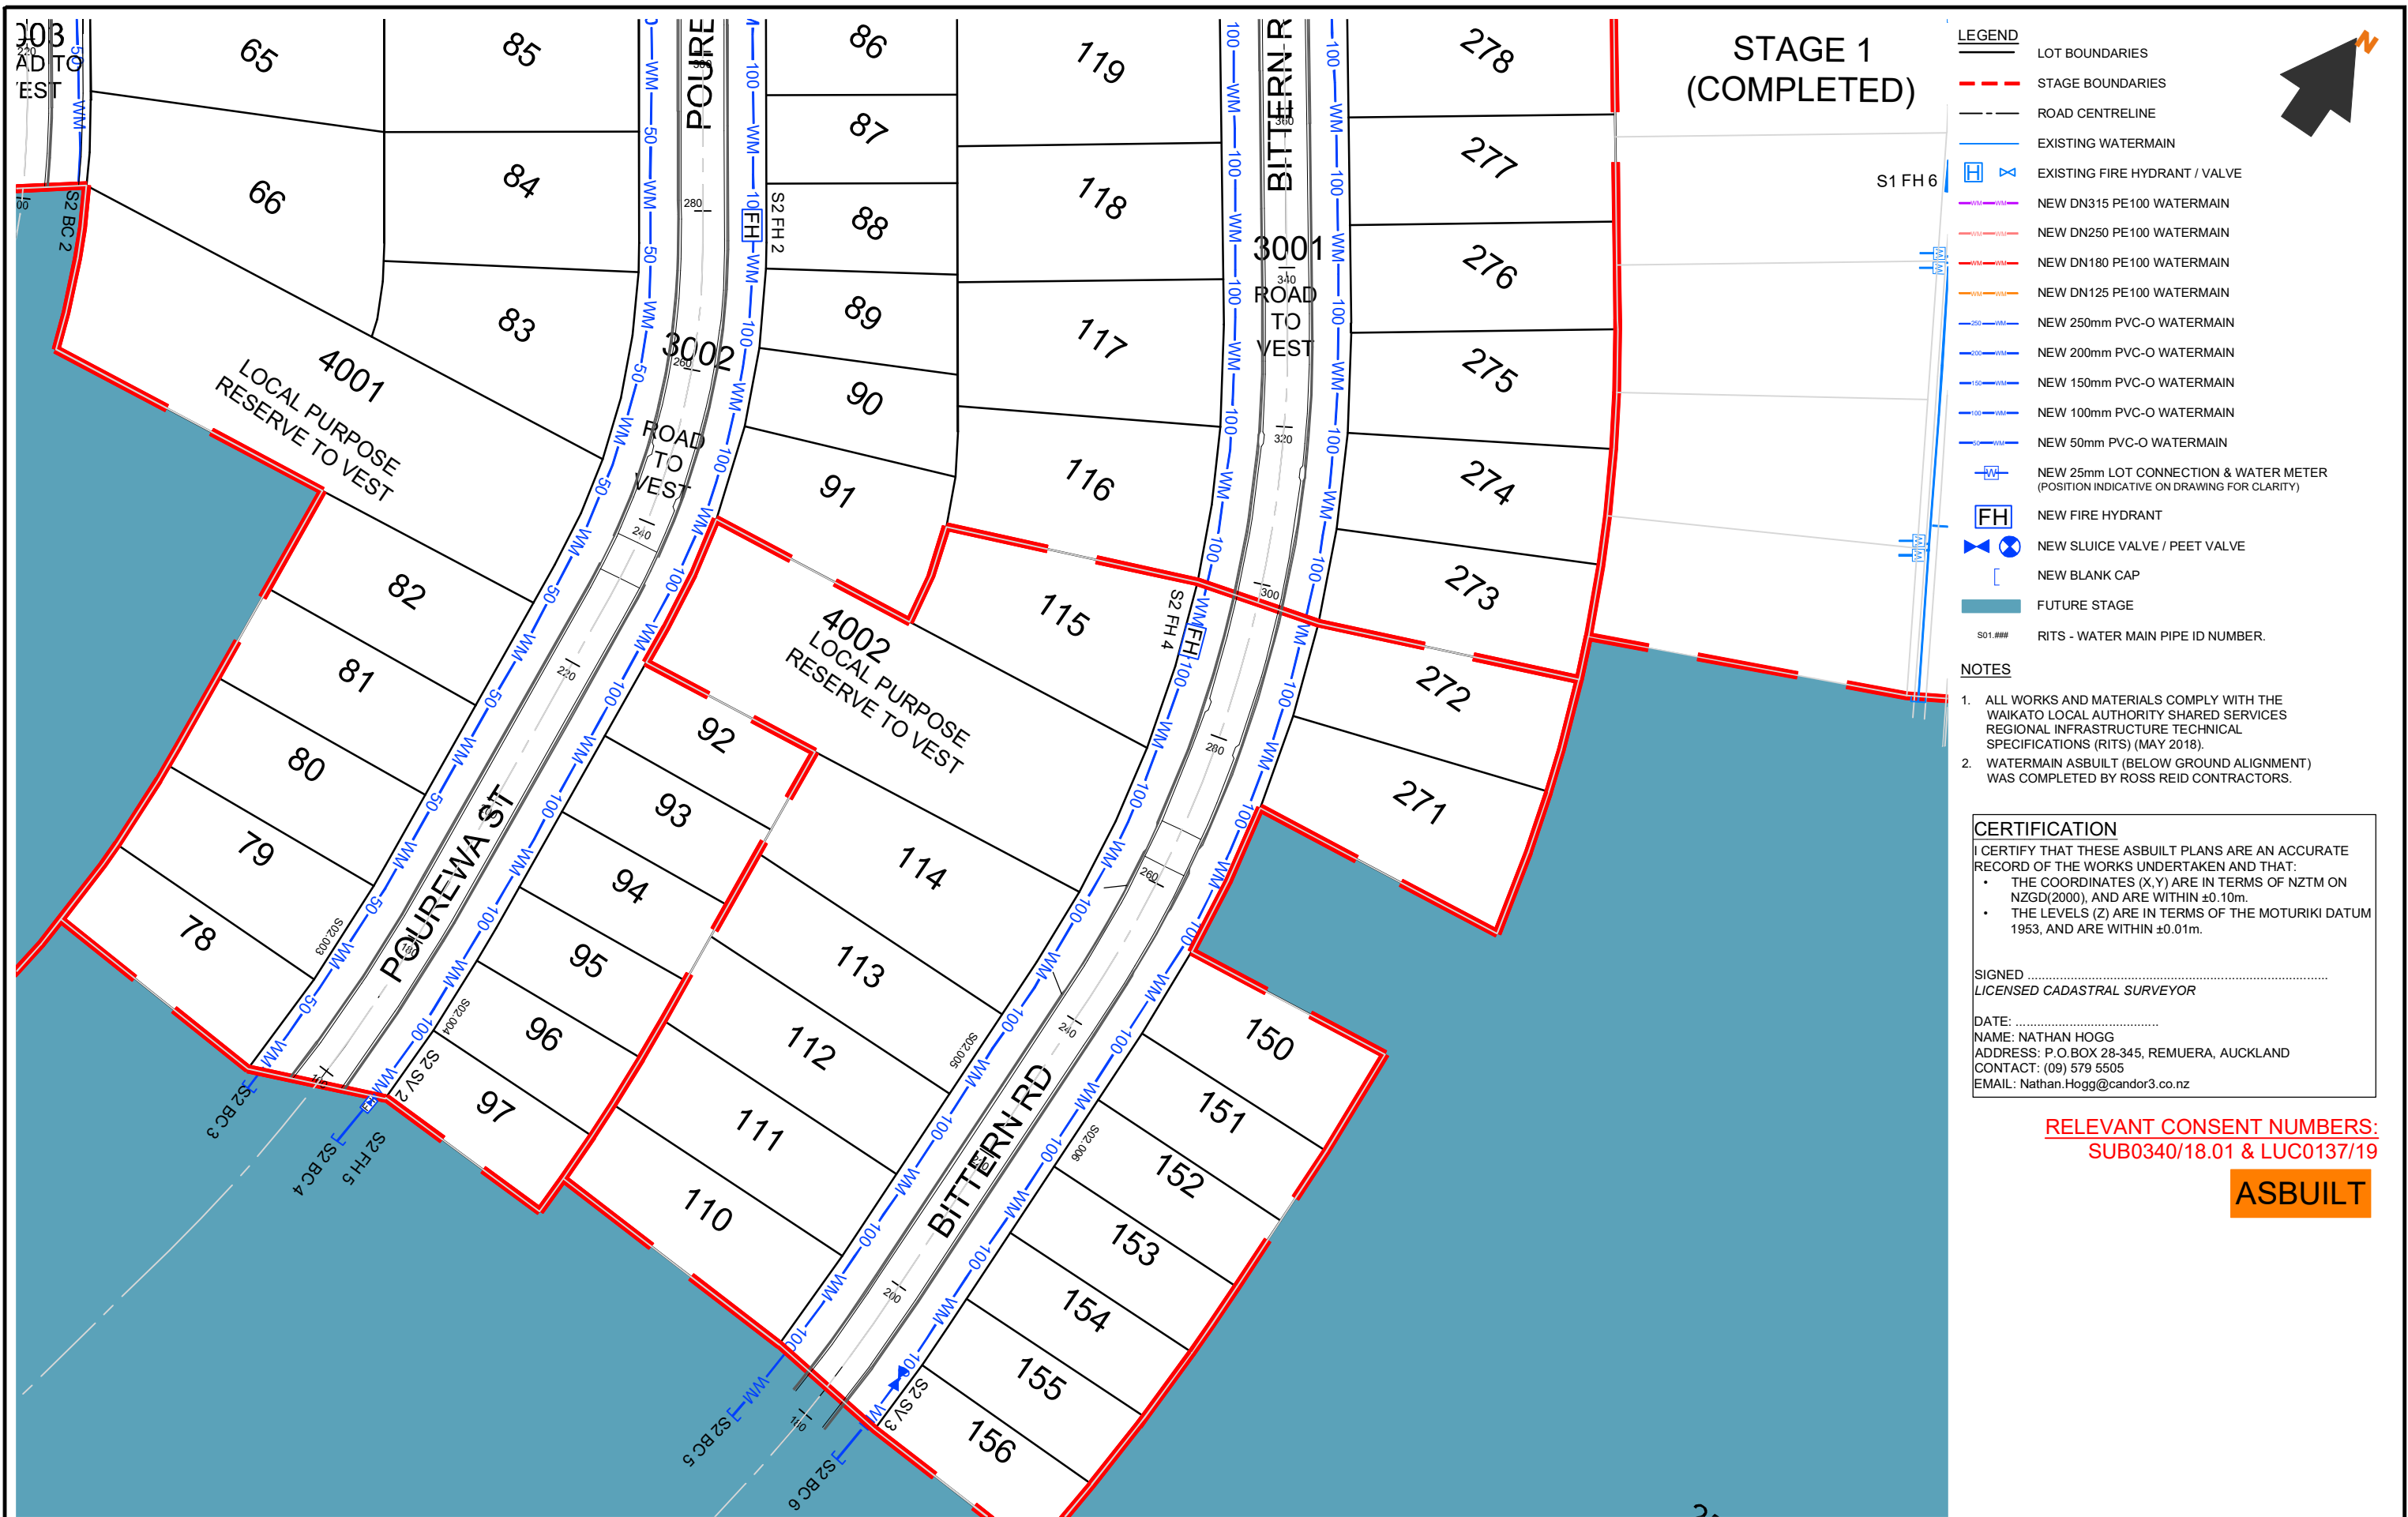

REV DESCRIPTION		BY	APPVD	DATE	PROJECT		CLIENT		PURPOSE		
					LAKESIDE, TE KAUPHATA		LAKESIDE DEVELOPMENTS 2017 LIMITED		AS-BUILT		
					WATERMAIN LAYOUT STAGE 2				DESIGN JS	APPROVED BY NH	SCALE 1:750 @ A3
					3 OF 3				DRAWN JS	DATE MAY 2020	
									PROJECT NO.	DRAWING NO.	REV.
									1239	AB-6-102	-

Stage 2, Water Reticulation As-Built Data:				
Device ID	NORTHING	EASTING	RL	Description
S2 FH 1	5857080.32	1790228.66	20.00	FIRE HYDRANT
S2 FH 2	5857088.65	1790339.84	16.41	FIRE HYDRANT
S2 FH 3	5857173.97	1790371.17	11.60	FIRE HYDRANT
S2 FH 4	5857075.23	1790414.84	13.11	FIRE HYDRANT
S2 FH 5	5856969.82	1790360.03	17.68	FIRE HYDRANT
S2 SV 1	5857085.77	1790224.82	12.22	SLUICE VALVE
S2 SV 2	5856970.53	1790360.12	17.82	SLUICE VALVE
S2 SV 3	5856977.51	1790434.63	13.62	SLUICE VALVE

RELEVANT CONSENT NUMBERS:  
SUB0340/18.01 & LUC0137/19

ASBUILT

CERTIFICATION

I CERTIFY THAT THESE ASBUILT PLANS ARE AN ACCURATE RECORD OF THE WORKS UNDERTAKEN AND THAT:

- THE COORDINATES (X,Y) ARE IN TERMS OF NZTM ON NZGD(2000), AND ARE WITHIN ±0.10m.
- THE LEVELS (Z) ARE IN TERMS OF THE MOTURIKI DATUM 1953, AND ARE WITHIN ±0.01m.

SIGNED .....

LICENSED CADASTRAL SURVEYOR

DATE: .....

NAME: NATHAN HOGG

ADDRESS: P.O.BOX 28-345, REMUERA, AUCKLAND

CONTACT: (09) 579 5505

EMAIL: Nathan.Hogg@candor3.co.nz

Stage 2, Water Reticulation As-Built Data (INTER STAGE BLANK CAPS):				
Device ID	NORTHING	EASTING	RL	Description
S2 BC 1	5857038.90	1790255.34	-	Blank Cap
S2 BC 2	5857046.84	1790265.98	-	Blank Cap
S2 BC 3	5856963.20	1790346.26	-	Blank Cap
S2 BC 4	5856963.76	1790359.28	-	Blank Cap
S2 BC 5	5856962.07	1790419.76	-	Blank Cap
S2 BC 6	5856964.75	1790433.74	-	Blank Cap
			-	