




REV DESCRIPTION		BY	APPVD	DATE	<div>Candor³</div> <div>ENGINEERING FOR LIFE</div>	PROJECT LAKESIDE, TE KAUWHATA EARTHWORKS EXISTING SURFACE STAGE 5 SHEET 2 OF 6	CLIENT LAKESIDE DEVELOPMENTS 2017 LIMITED	PURPOSE AS-BUILT		
DESIGN JS		DRAWN JS	CHECK AP	APPROVED BY NH				SCALE 1:750 @ A3		
				DATE DEC 2020						
				PROJECT NO.				DRAWING NO.	REV.	
				1239				AB-2-101	-	

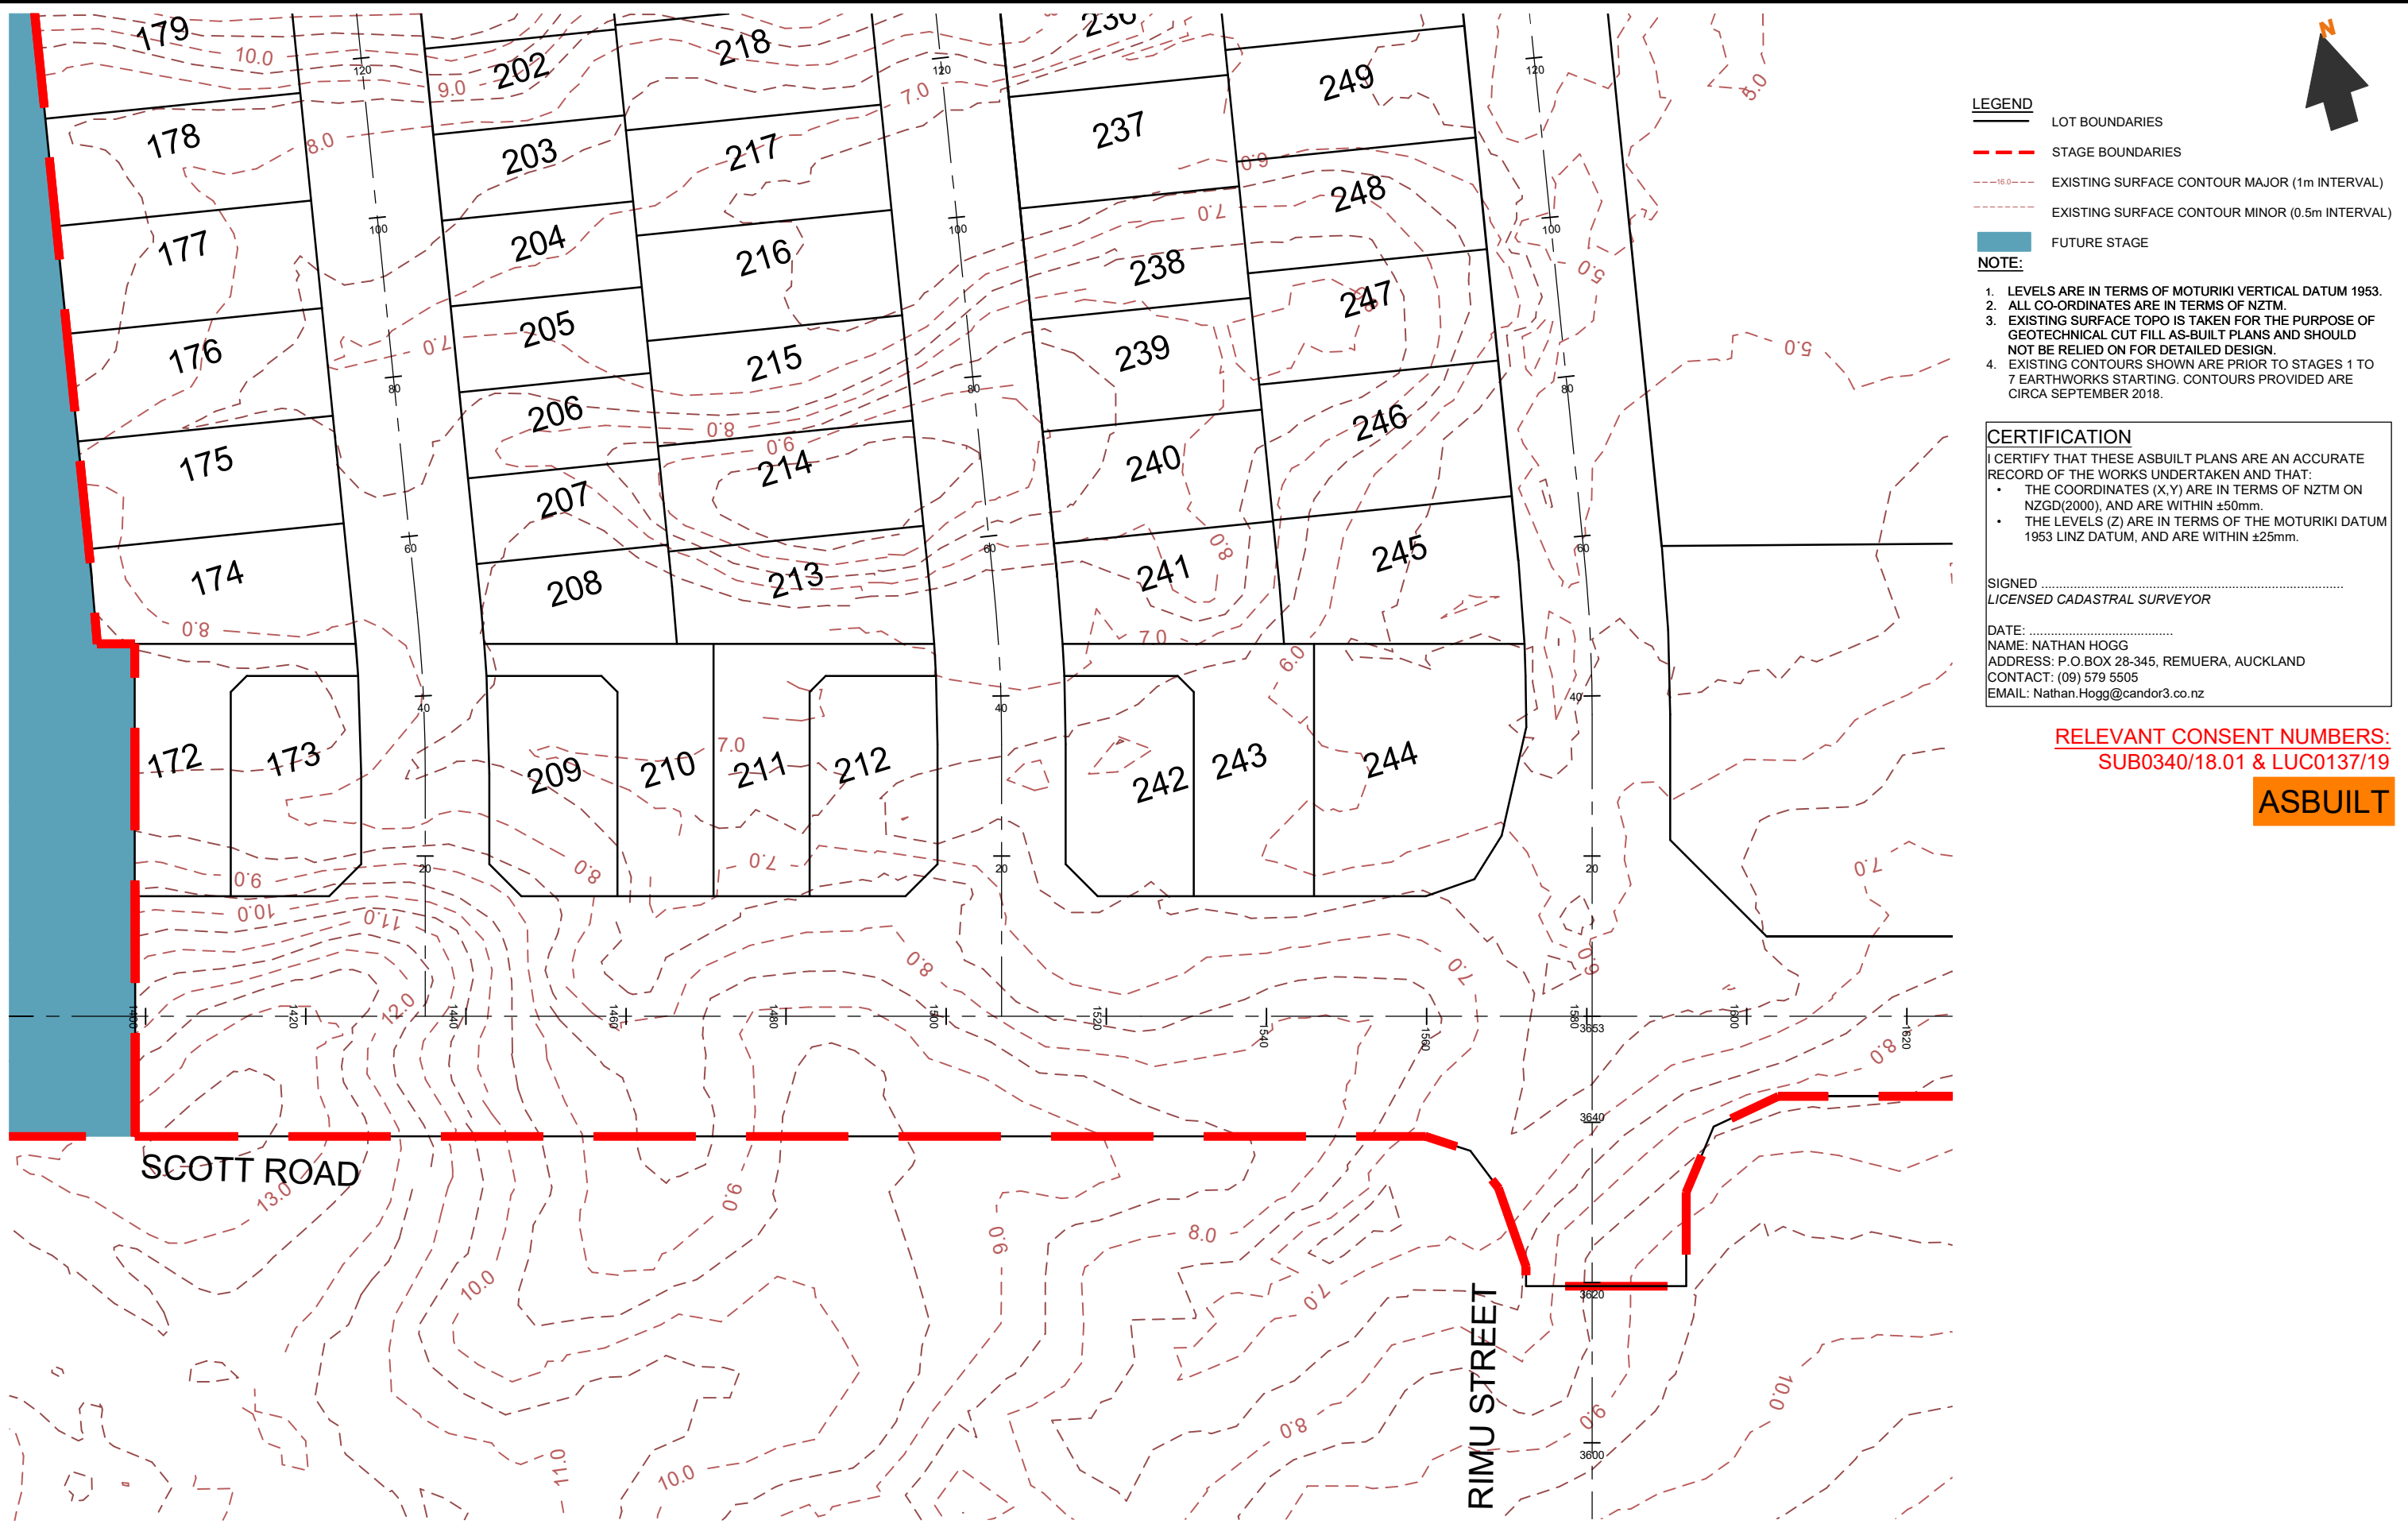

REV DESCRIPTION		BY	APPVD	DATE	PROJECT		CLIENT		PURPOSE		
					LAKESIDE, TE KAUWHATA		LAKESIDE DEVELOPMENTS 2017 LIMITED		AS-BUILT		
					EARTHWORKS EXISTING SURFACE STAGE 5				DESIGN JS	APPROVED BY NH	SCALE 1:750 @ A3
					SHEET 3 OF 6				CHECK AP	DATE DEC 2020	
									PROJECT NO.	DRAWING NO.	REV.
									1239	AB-2-102	-

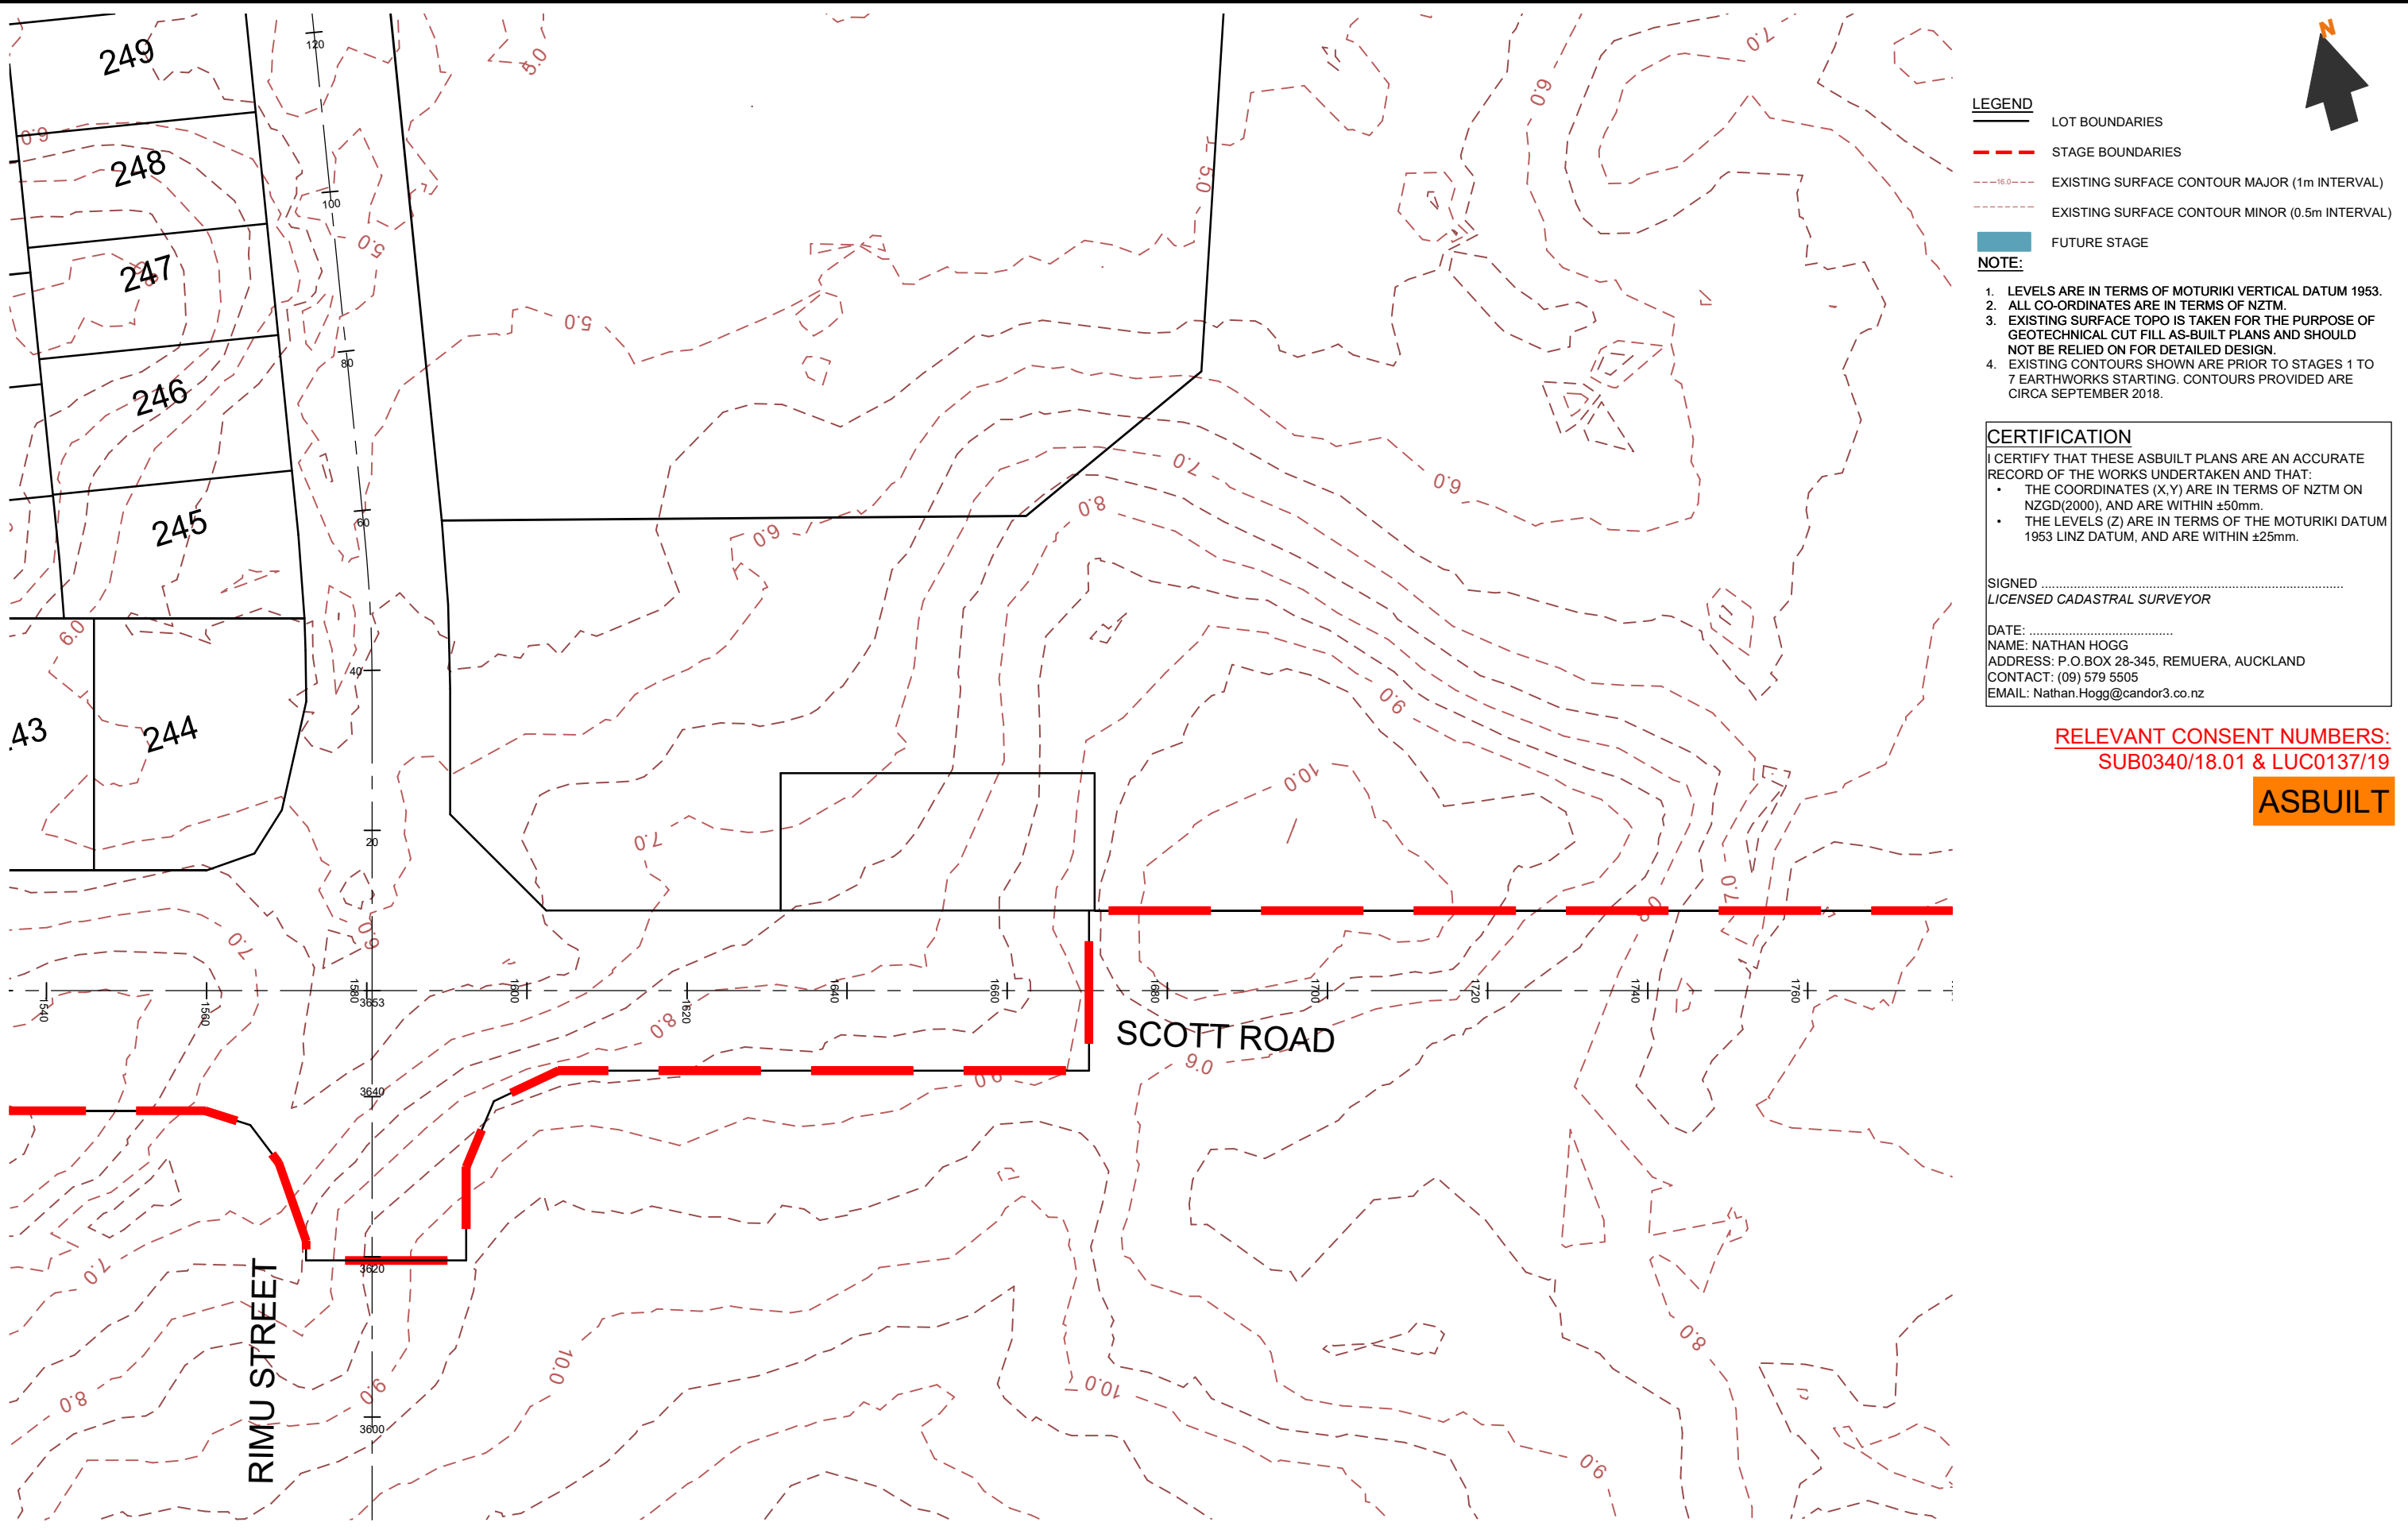

REV DESCRIPTION		BY	APPVD	DATE	<div>Candor³</div> <div>ENGINEERING FOR LIFE</div>	PROJECT LAKESIDE, TE KAUWHATA EARTHWORKS EXISTING SURFACE STAGE 5 SHEET 4 OF 6	CLIENT LAKESIDE DEVELOPMENTS 2017 LIMITED	PURPOSE AS-BUILT		
DESIGN	JS	APPROVED BY NH DATE DEC 2020		SCALE 1:750 @ A3						
DRAWN	JS									
CHECK	AP									
PROJECT NO.					DRAWING NO.		REV.			
1239					AB-2-103		-			

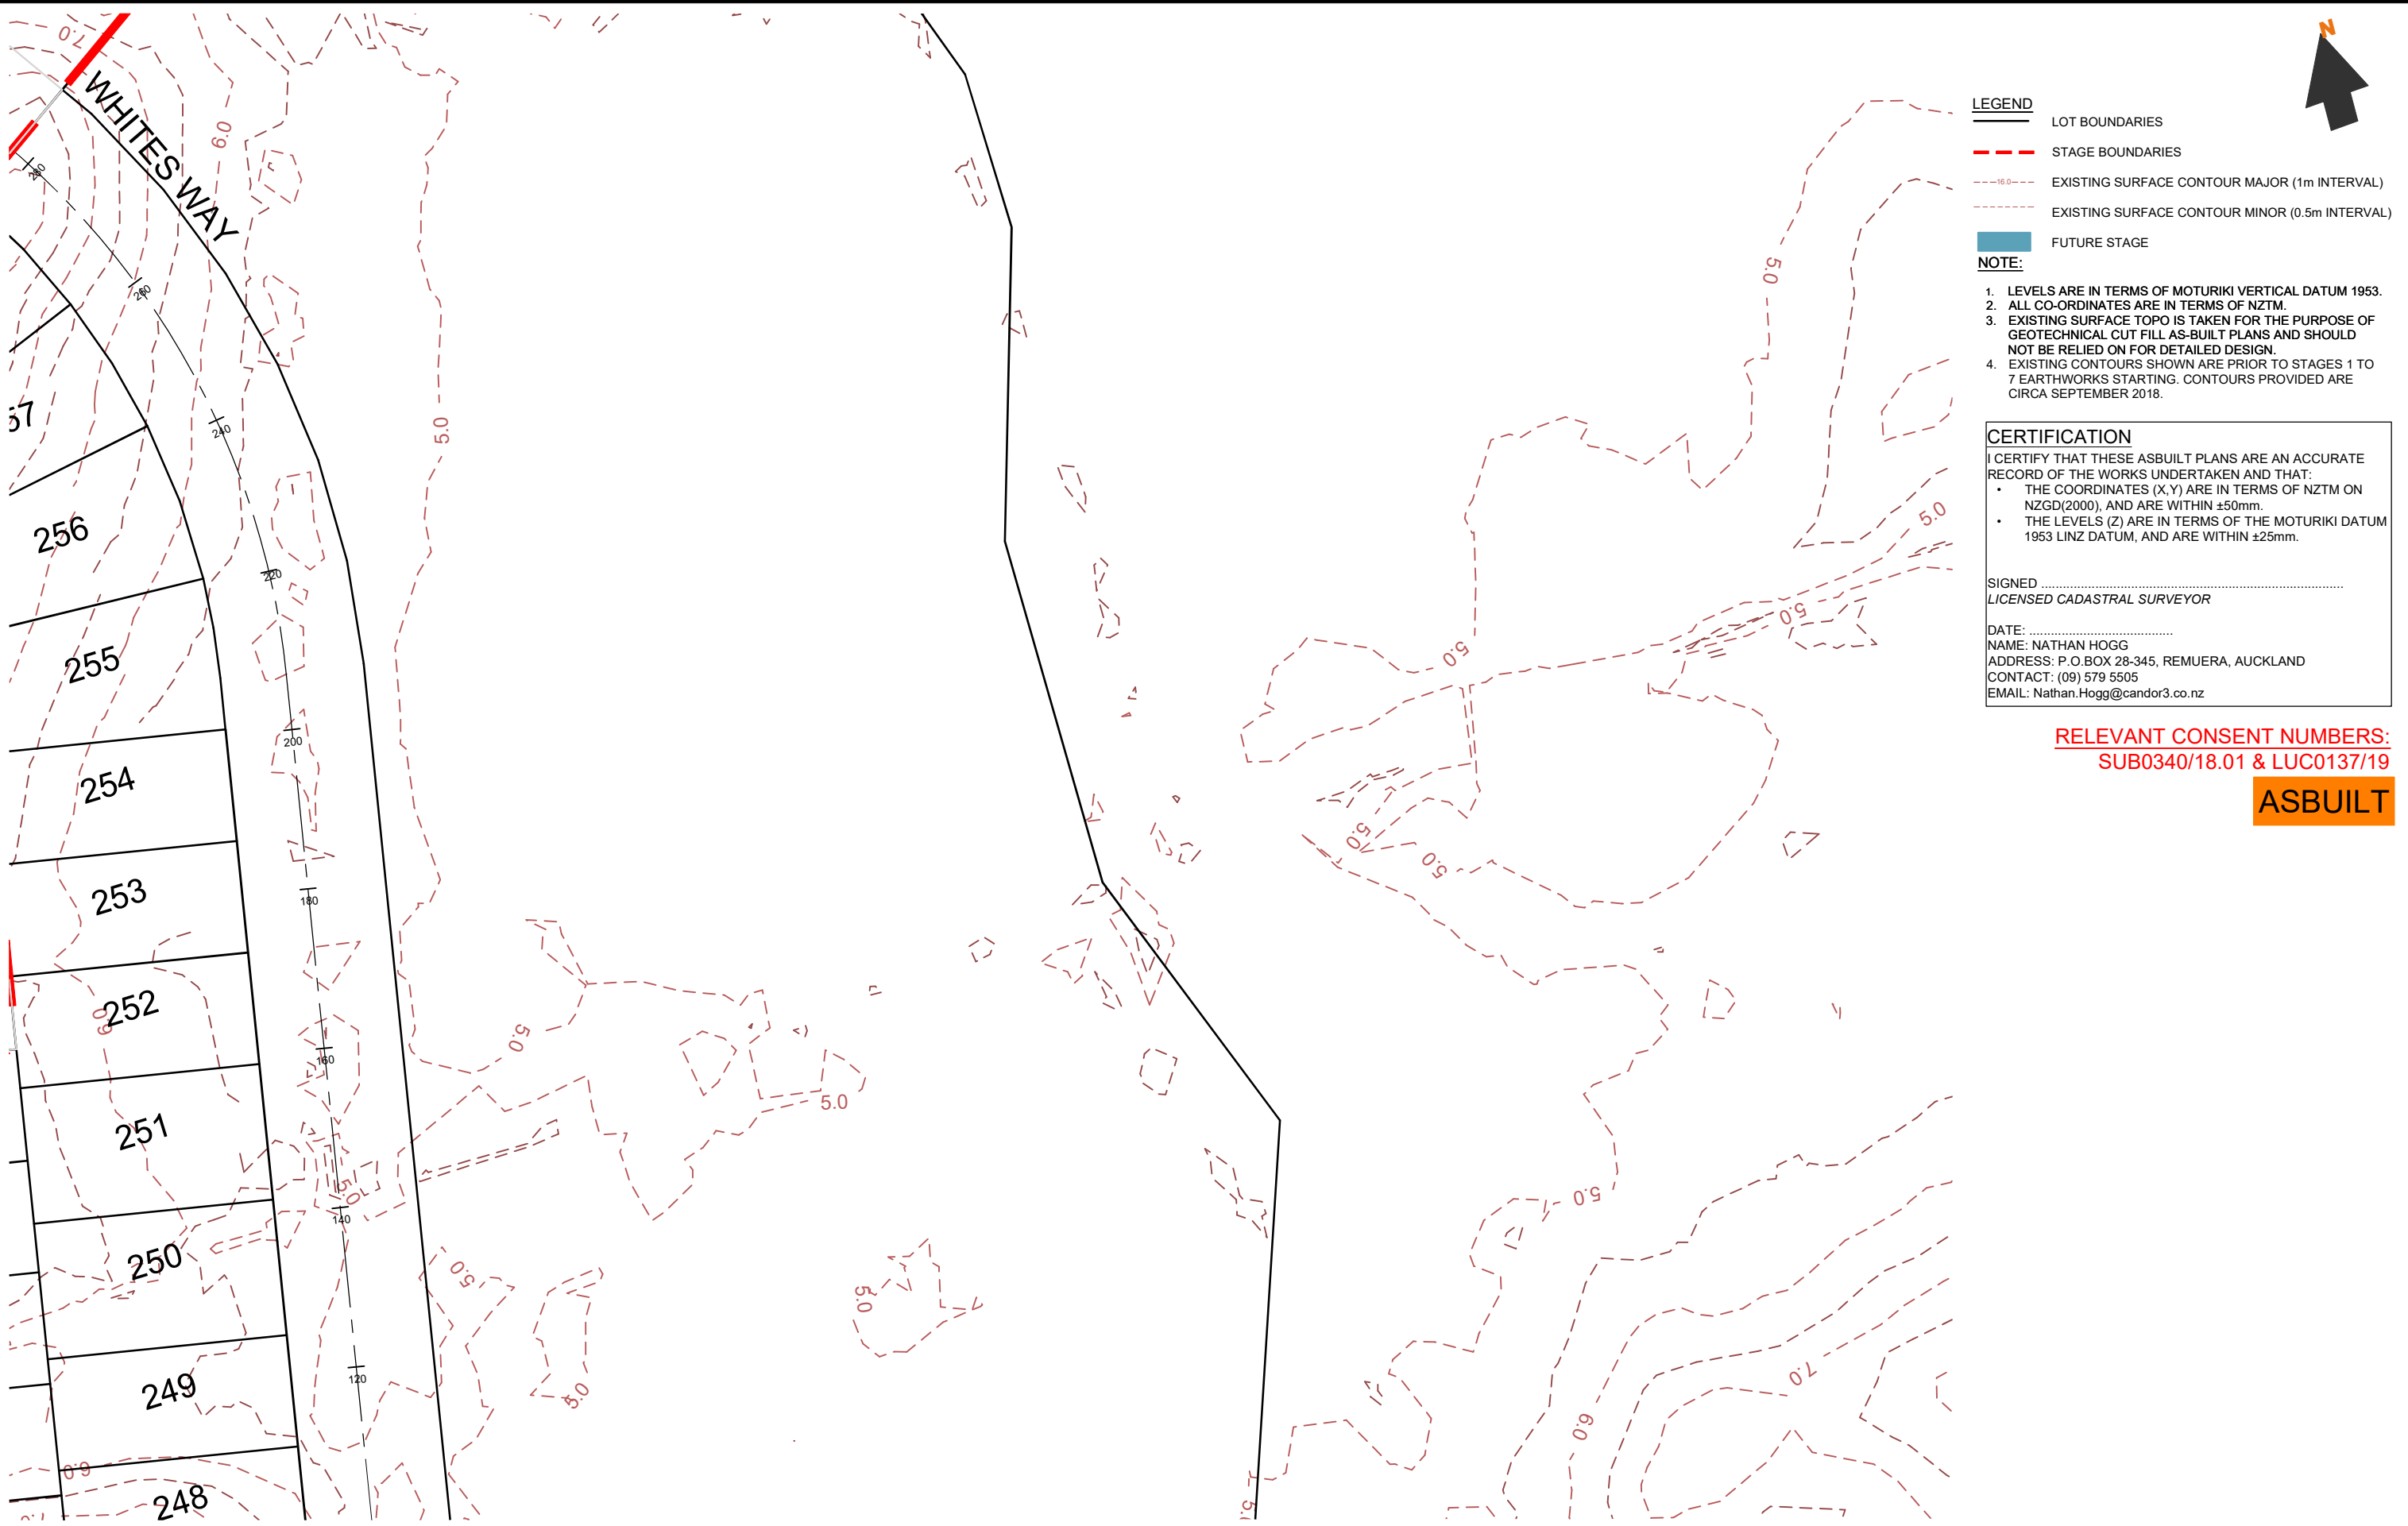

LEGEND

LOT BOUNDARIES

STAGE BOUNDARIES

EXISTING SURFACE CONTOUR MAJOR (1m INTERVAL)

EXISTING SURFACE CONTOUR MINOR (0.5m INTERVAL)

FUTURE STAGE

NOTE:

- LEVELS ARE IN TERMS OF MOTURIKI VERTICAL DATUM 1953.
- ALL CO-ORDINATES ARE IN TERMS OF NZTM.
- EXISTING SURFACE TOPO IS TAKEN FOR THE PURPOSE OF GEOTECHNICAL CUT FILL AS-BUILT PLANS AND SHOULD NOT BE RELIED ON FOR DETAILED DESIGN.
- EXISTING CONTOURS SHOWN ARE PRIOR TO STAGES 1 TO 7 EARTHWORKS STARTING. CONTOURS PROVIDED ARE CIRCA SEPTEMBER 2018.

CERTIFICATION

I CERTIFY THAT THESE ASBUILT PLANS ARE AN ACCURATE RECORD OF THE WORKS UNDERTAKEN AND THAT:

- THE COORDINATES (X,Y) ARE IN TERMS OF NZTM ON NZGD(2000), AND ARE WITHIN ±50mm.
- THE LEVELS (Z) ARE IN TERMS OF THE MOTURIKI DATUM 1953 LINZ DATUM, AND ARE WITHIN ±25mm.

SIGNED
LICENSED CADASTRAL SURVEYOR

DATE:
NAME: NATHAN HOGG
ADDRESS: P.O.BOX 28-345, REMUERA, AUCKLAND
CONTACT: (09) 579 5505
EMAIL: Nathan.Hogg@candor3.co.nz

RELEVANT CONSENT NUMBERS:
SUB0340/18.01 & LUC0137/19

ASBUILT

REV DESCRIPTION		BY	APPVD	DATE	PROJECT		CLIENT		PURPOSE		
					LAKESIDE, TE KAUWHATA		LAKESIDE		AS-BUILT		
					EARTHWORKS EXISTING SURFACE STAGE 5		DEVELOPMENTS 2017		DESIGN JS	APPROVED BY NH	SCALE 1:750 @ A3
					SHEET 5 OF 6		LIMITED		DRAWN JS	DATE DEC 2020	
									CHECK AP		
									PROJECT NO.	DRAWING NO.	REV.
									1239	AB-2-104	-



LEGEND

- LOT BOUNDARIES
- STAGE BOUNDARIES
- EXISTING SURFACE CONTOUR MAJOR (1m INTERVAL)
- EXISTING SURFACE CONTOUR MINOR (0.5m INTERVAL)
- FUTURE STAGE

NOTE:

- LEVELS ARE IN TERMS OF MOTURIKI VERTICAL DATUM 1953.
- ALL CO-ORDINATES ARE IN TERMS OF NZTM.
- EXISTING SURFACE TOPO IS TAKEN FOR THE PURPOSE OF GEOTECHNICAL CUT FILL AS-BUILT PLANS AND SHOULD NOT BE RELIED ON FOR DETAILED DESIGN.
- EXISTING CONTOURS SHOWN ARE PRIOR TO STAGES 1 TO 7 EARTHWORKS STARTING. CONTOURS PROVIDED ARE CIRCA SEPTEMBER 2018.

CERTIFICATION

I CERTIFY THAT THESE ASBUILT PLANS ARE AN ACCURATE RECORD OF THE WORKS UNDERTAKEN AND THAT:


- THE COORDINATES (X,Y) ARE IN TERMS OF NZTM ON NZGD(2000), AND ARE WITHIN ±50mm.
- THE LEVELS (Z) ARE IN TERMS OF THE MOTURIKI DATUM 1953 LINZ DATUM, AND ARE WITHIN ±25mm.


SIGNED
 LICENSED CADASTRAL SURVEYOR

DATE:
 NAME: NATHAN HOGG
 ADDRESS: P.O BOX 28-345, REMUERA, AUCKLAND
 CONTACT: (09) 579 5505
 EMAIL: Nathan.Hogg@candor3.co.nz

RELEVANT CONSENT NUMBERS:
 SUB0340/18.01 & LUC0137/19

ASBUILT

REV	DESCRIPTION	BY	APPVD	DATE	PROJECT	CLIENT	PURPOSE
<div>  </div>					LAKESIDE, TE KAUWHATA EARTHWORKS EXISTING SURFACE STAGE 5 SHEET 6 OF 6	LAKESIDE DEVELOPMENTS 2017 LIMITED	AS-BUILT
DESIGN JS		APPROVED BY NH		SCALE 1:750 @ A3			
DRAWN JS		CHECK AP		DATE DEC 2020			
PROJECT NO.		DRAWING NO.		REV.			
1239		AB-2-105		-			

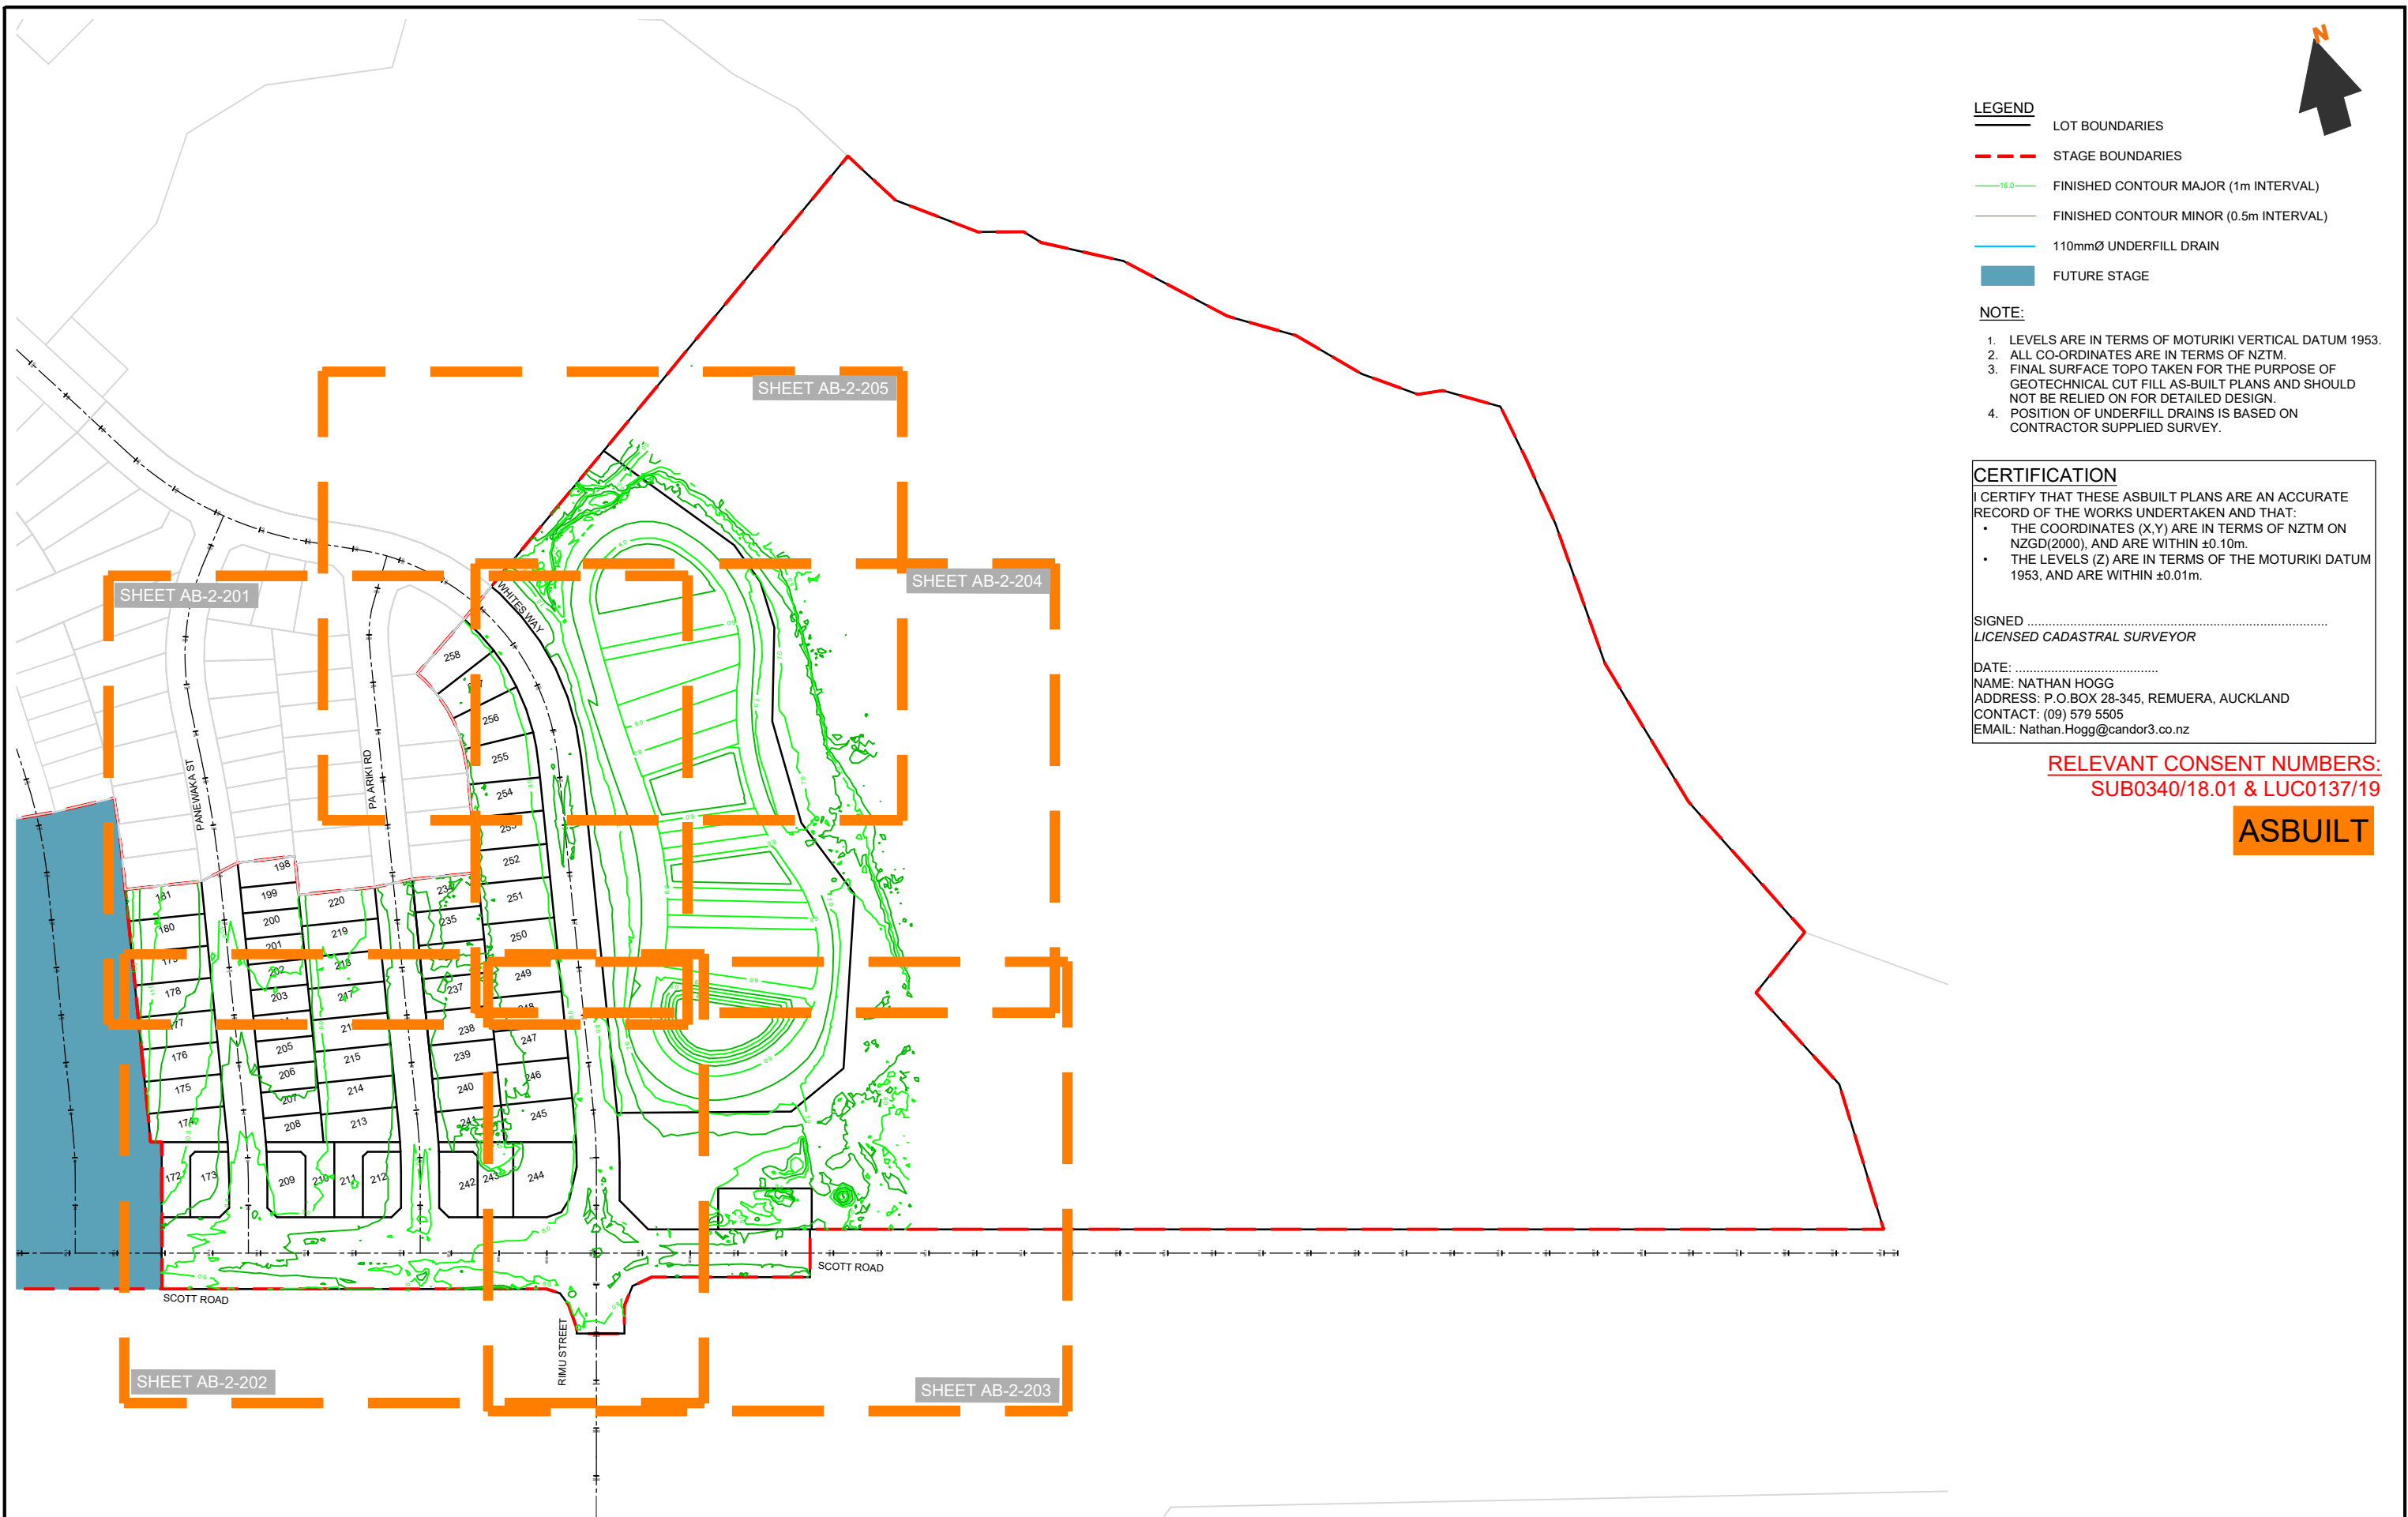

LEGEND

LOT BOUNDARIES

STAGE BOUNDARIES

FINISHED CONTOUR MAJOR (1m INTERVAL)

FINISHED CONTOUR MINOR (0.5m INTERVAL)

110mmØ UNDERFILL DRAIN

FUTURE STAGE

- NOTE:
1. LEVELS ARE IN TERMS OF MOTURIKI VERTICAL DATUM 1953.

2. ALL CO-ORDINATES ARE IN TERMS OF NZTM.

3. FINAL SURFACE TOPO TAKEN FOR THE PURPOSE OF GEOTECHNICAL CUT FILL AS-BUILT PLANS AND SHOULD NOT BE RELIED ON FOR DETAILED DESIGN.

4. POSITION OF UNDERFILL DRAINS IS BASED ON CONTRACTOR SUPPLIED SURVEY.

CERTIFICATION

I CERTIFY THAT THESE ASBUILT PLANS ARE AN ACCURATE RECORD OF THE WORKS UNDERTAKEN AND THAT:

- THE COORDINATES (X,Y) ARE IN TERMS OF NZTM ON NZGD(2000), AND ARE WITHIN ±0.10m.
- THE LEVELS (Z) ARE IN TERMS OF THE MOTURIKI DATUM 1953, AND ARE WITHIN ±0.01m.


SIGNED
LICENSED CADASTRAL SURVEYOR

DATE:
NAME: NATHAN HOGG
ADDRESS: P.O.BOX 28-345, REMUERA, AUCKLAND
CONTACT: (09) 579 5505
EMAIL: Nathan.Hogg@candor3.co.nz

RELEVANT CONSENT NUMBERS:
SUB0340/18.01 & LUC0137/19

ASBUILT

REV DESCRIPTIONBY APPVD DATE			PROJECT		CLIENT		PURPOSE		
			LAKESIDE, TE KAUWHATA		LAKESIDE		AS-BUILT		
			EARTHWORKS FINISHED SURFACE STAGE 5		DEVELOPMENTS 2017		DESIGN JS	APPROVED BY NH	SCALE 1:2500 @ A3
			SHEET 1 OF 6		LIMITED		CHECK AP	DATE DEC 2020	
							PROJECT NO.	DRAWING NO.	REV.
							1239	AB-2-200	-

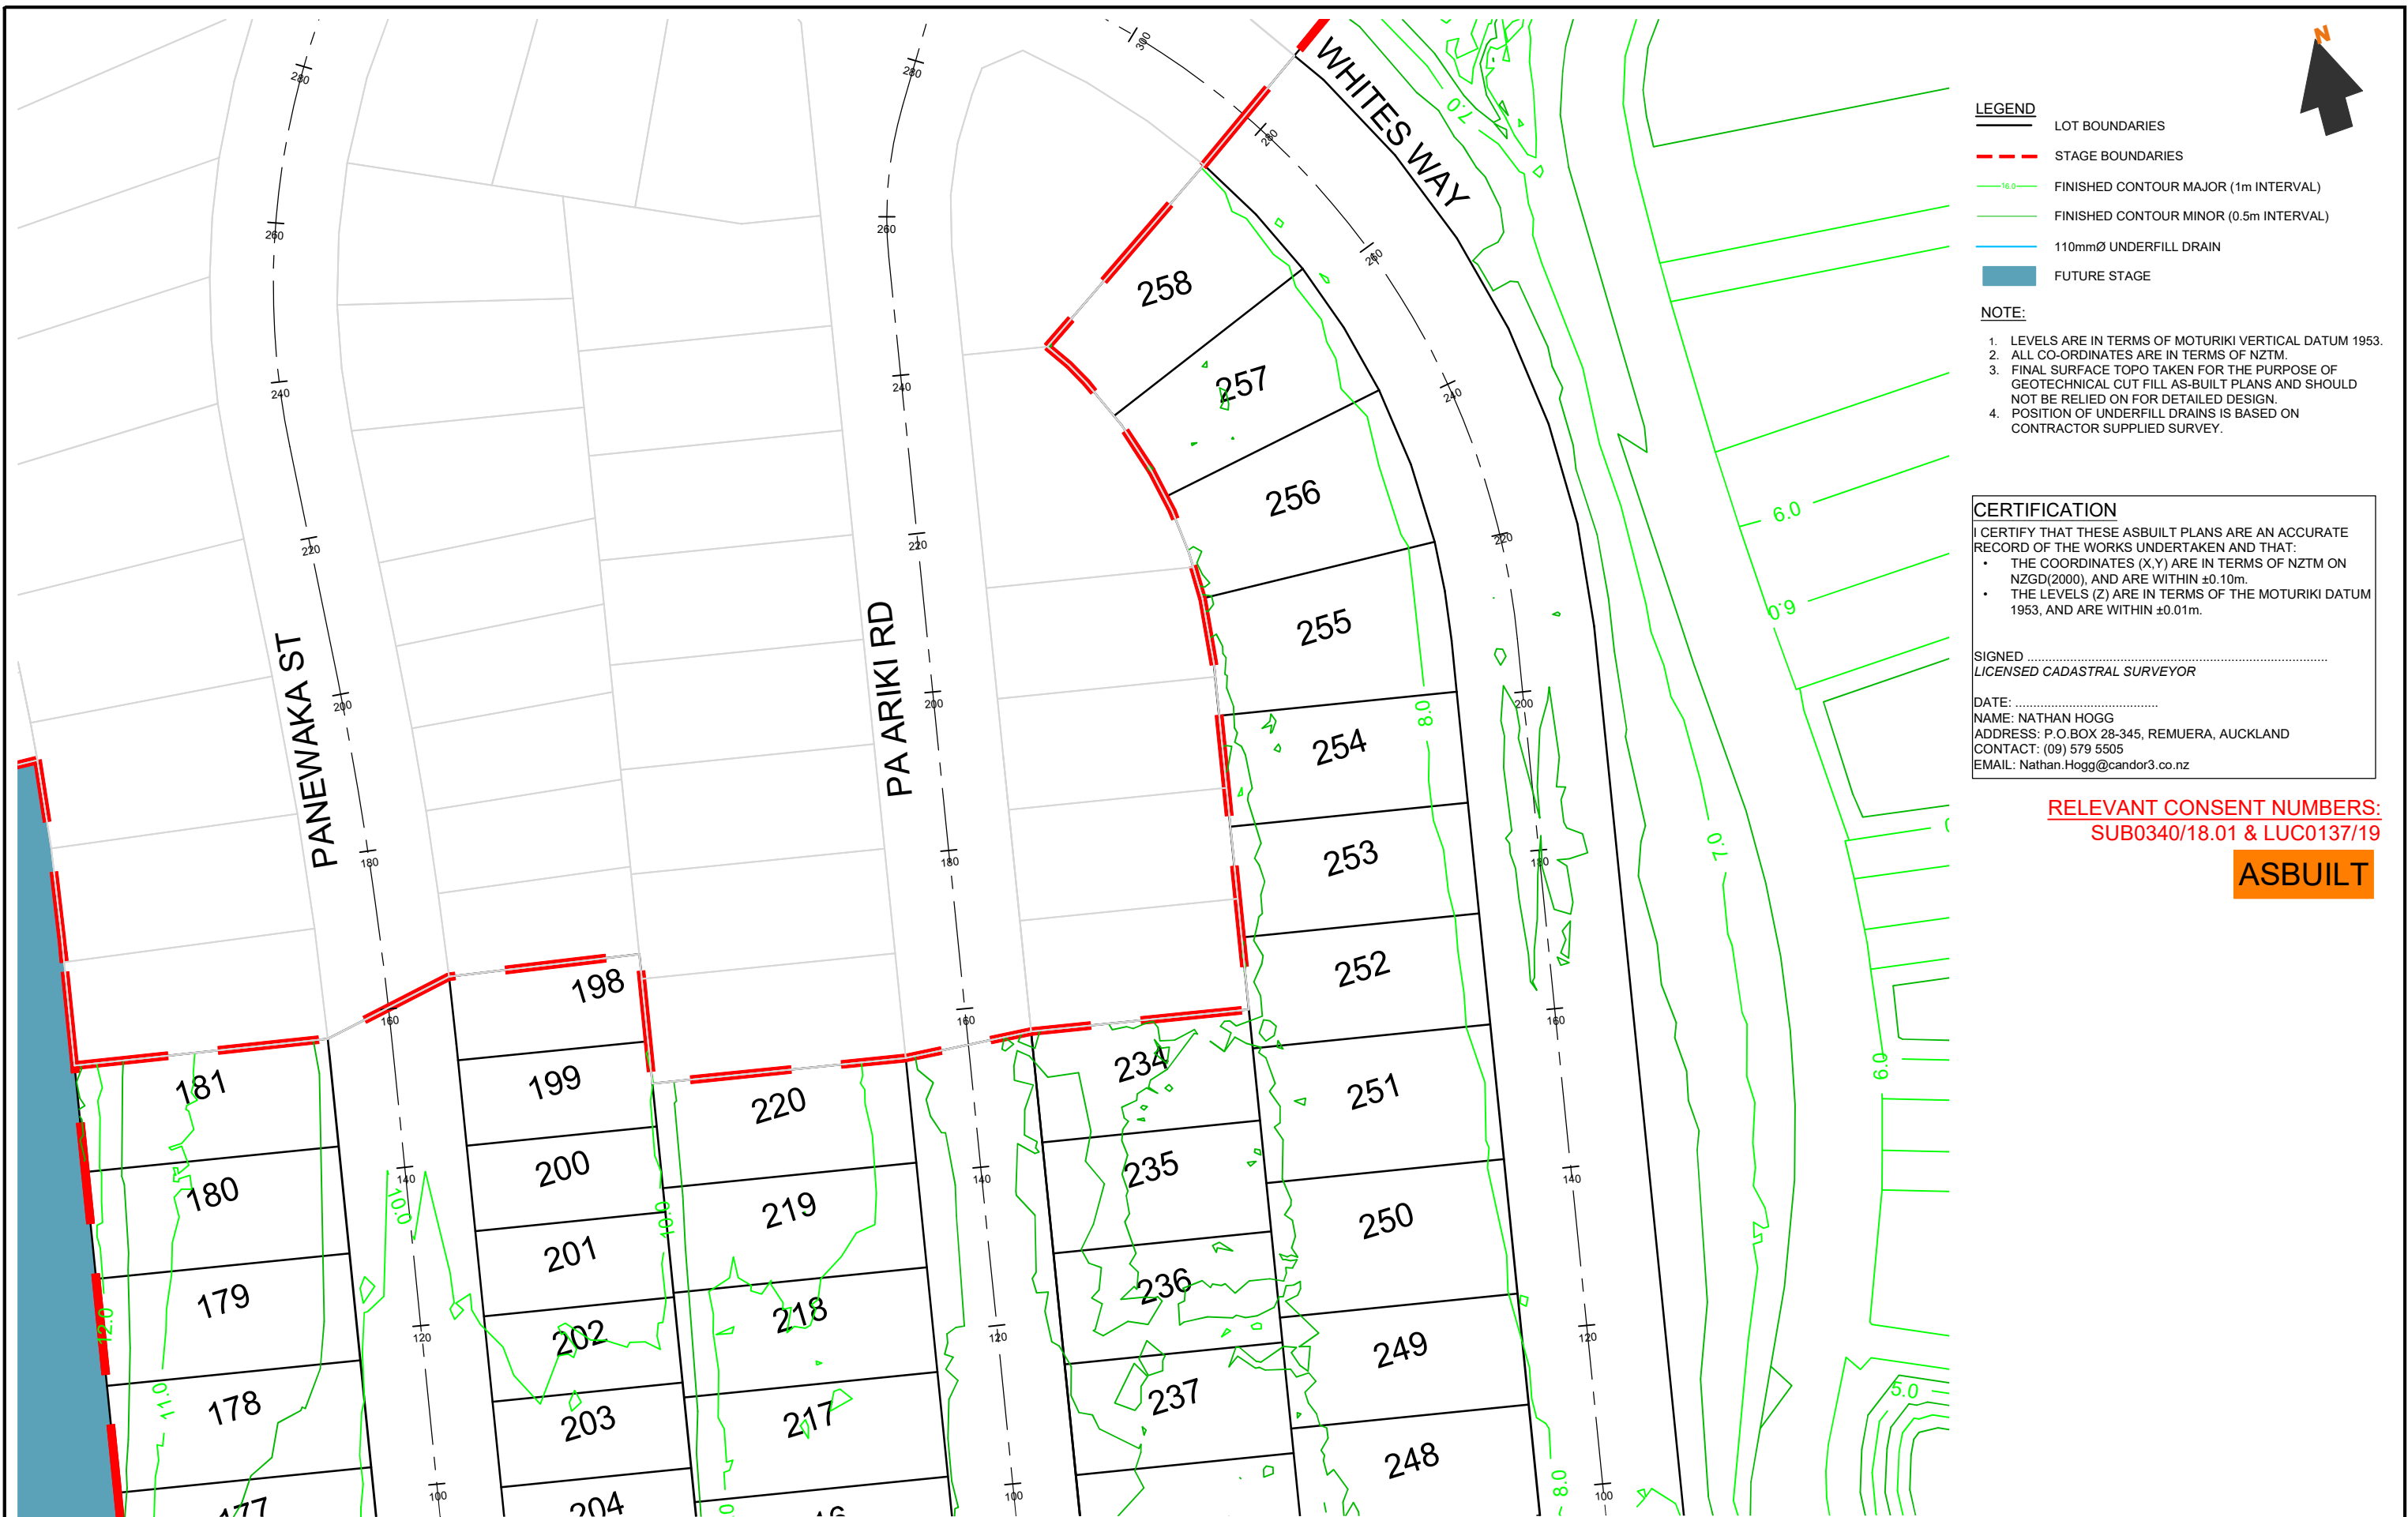

LEGEND

LOT BOUNDARIES

STAGE BOUNDARIES

FINISHED CONTOUR MAJOR (1m INTERVAL)

FINISHED CONTOUR MINOR (0.5m INTERVAL)

110mmØ UNDERFILL DRAIN

FUTURE STAGE

- NOTE:
1. LEVELS ARE IN TERMS OF MOTURIKI VERTICAL DATUM 1953.

2. ALL CO-ORDINATES ARE IN TERMS OF NZTM.

3. FINAL SURFACE TOPO TAKEN FOR THE PURPOSE OF GEOTECHNICAL CUT FILL AS-BUILT PLANS AND SHOULD NOT BE RELIED ON FOR DETAILED DESIGN.

4. POSITION OF UNDERFILL DRAINS IS BASED ON CONTRACTOR SUPPLIED SURVEY.

CERTIFICATION

I CERTIFY THAT THESE ASBUILT PLANS ARE AN ACCURATE RECORD OF THE WORKS UNDERTAKEN AND THAT:

- THE COORDINATES (X,Y) ARE IN TERMS OF NZTM ON NZGD(2000), AND ARE WITHIN ±0.10m.
- THE LEVELS (Z) ARE IN TERMS OF THE MOTURIKI DATUM 1953, AND ARE WITHIN ±0.01m.

SIGNED
LICENSED CADASTRAL SURVEYOR

DATE:
NAME: NATHAN HOGG
ADDRESS: P.O.BOX 28-345, REMUERA, AUCKLAND
CONTACT: (09) 579 5505
EMAIL: Nathan.Hogg@candor3.co.nz

RELEVANT CONSENT NUMBERS:
SUB0340/18.01 & LUC0137/19

ASBUILT

REV DESCRIPTION		BY	APPVD	DATE	PROJECT		CLIENT		PURPOSE		
					LAKESIDE, TE KAUWHATA		LAKESIDE		AS-BUILT		
					EARTHWORKS FINISHED SURFACE STAGE 5		DEVELOPMENTS 2017		DESIGN JS	APPROVED BY NH	SCALE 1:750 @ A3
					SHEET 2 OF 6		LIMITED		CHECK AP	DATE DEC 2020	
									PROJECT NO.	DRAWING NO.	REV.
									1239	AB-2-201	-



LEGEND

LOT BOUNDARIES

STAGE BOUNDARIES

FINISHED CONTOUR MAJOR (1m INTERVAL)

FINISHED CONTOUR MINOR (0.5m INTERVAL)

110mmØ UNDERFILL DRAIN

FUTURE STAGE

- NOTE:
1. LEVELS ARE IN TERMS OF MOTURIKI VERTICAL DATUM 1953.

2. ALL CO-ORDINATES ARE IN TERMS OF NZTM.

3. FINAL SURFACE TOPO TAKEN FOR THE PURPOSE OF GEOTECHNICAL CUT FILL AS-BUILT PLANS AND SHOULD NOT BE RELIED ON FOR DETAILED DESIGN.

4. POSITION OF UNDERFILL DRAINS IS BASED ON CONTRACTOR SUPPLIED SURVEY.

CERTIFICATION

I CERTIFY THAT THESE ASBUILT PLANS ARE AN ACCURATE RECORD OF THE WORKS UNDERTAKEN AND THAT:

THE COORDINATES (X,Y) ARE IN TERMS OF NZTM ON NZGD(2000), AND ARE WITHIN ±0.10m.

THE LEVELS (Z) ARE IN TERMS OF THE MOTURIKI DATUM 1953, AND ARE WITHIN ±0.01m.

SIGNED

LICENSED CADASTRAL SURVEYOR

DATE:

NAME: NATHAN HOGG

ADDRESS: P.O.BOX 28-345, REMUERA, AUCKLAND


CONTACT: (09) 579 5505

EMAIL: Nathan.Hogg@candor3.co.nz


RELEVANT CONSENT NUMBERS:
SUB0340/18.01 & LUC0137/19

ASBUILT

REV DESCRIPTION		BY	APPVD	DATE	<div>Candor³</div> <div>ENGINEERING FOR LIFE</div>	PROJECT LAKESIDE, TE KAUWHATA EARTHWORKS FINISHED SURFACE STAGE 5 SHEET 3 OF 6	CLIENT LAKESIDE DEVELOPMENTS 2017 LIMITED	PURPOSE AS-BUILT		
DESIGN JS								APPROVED BY NH	SCALE 1:750 @ A3	
DRAWN JS								DATE DEC 2020		
CHECK AP										
PROJECT NO.			DRAWING NO.			REV.				
1239			AB-2-202			-				

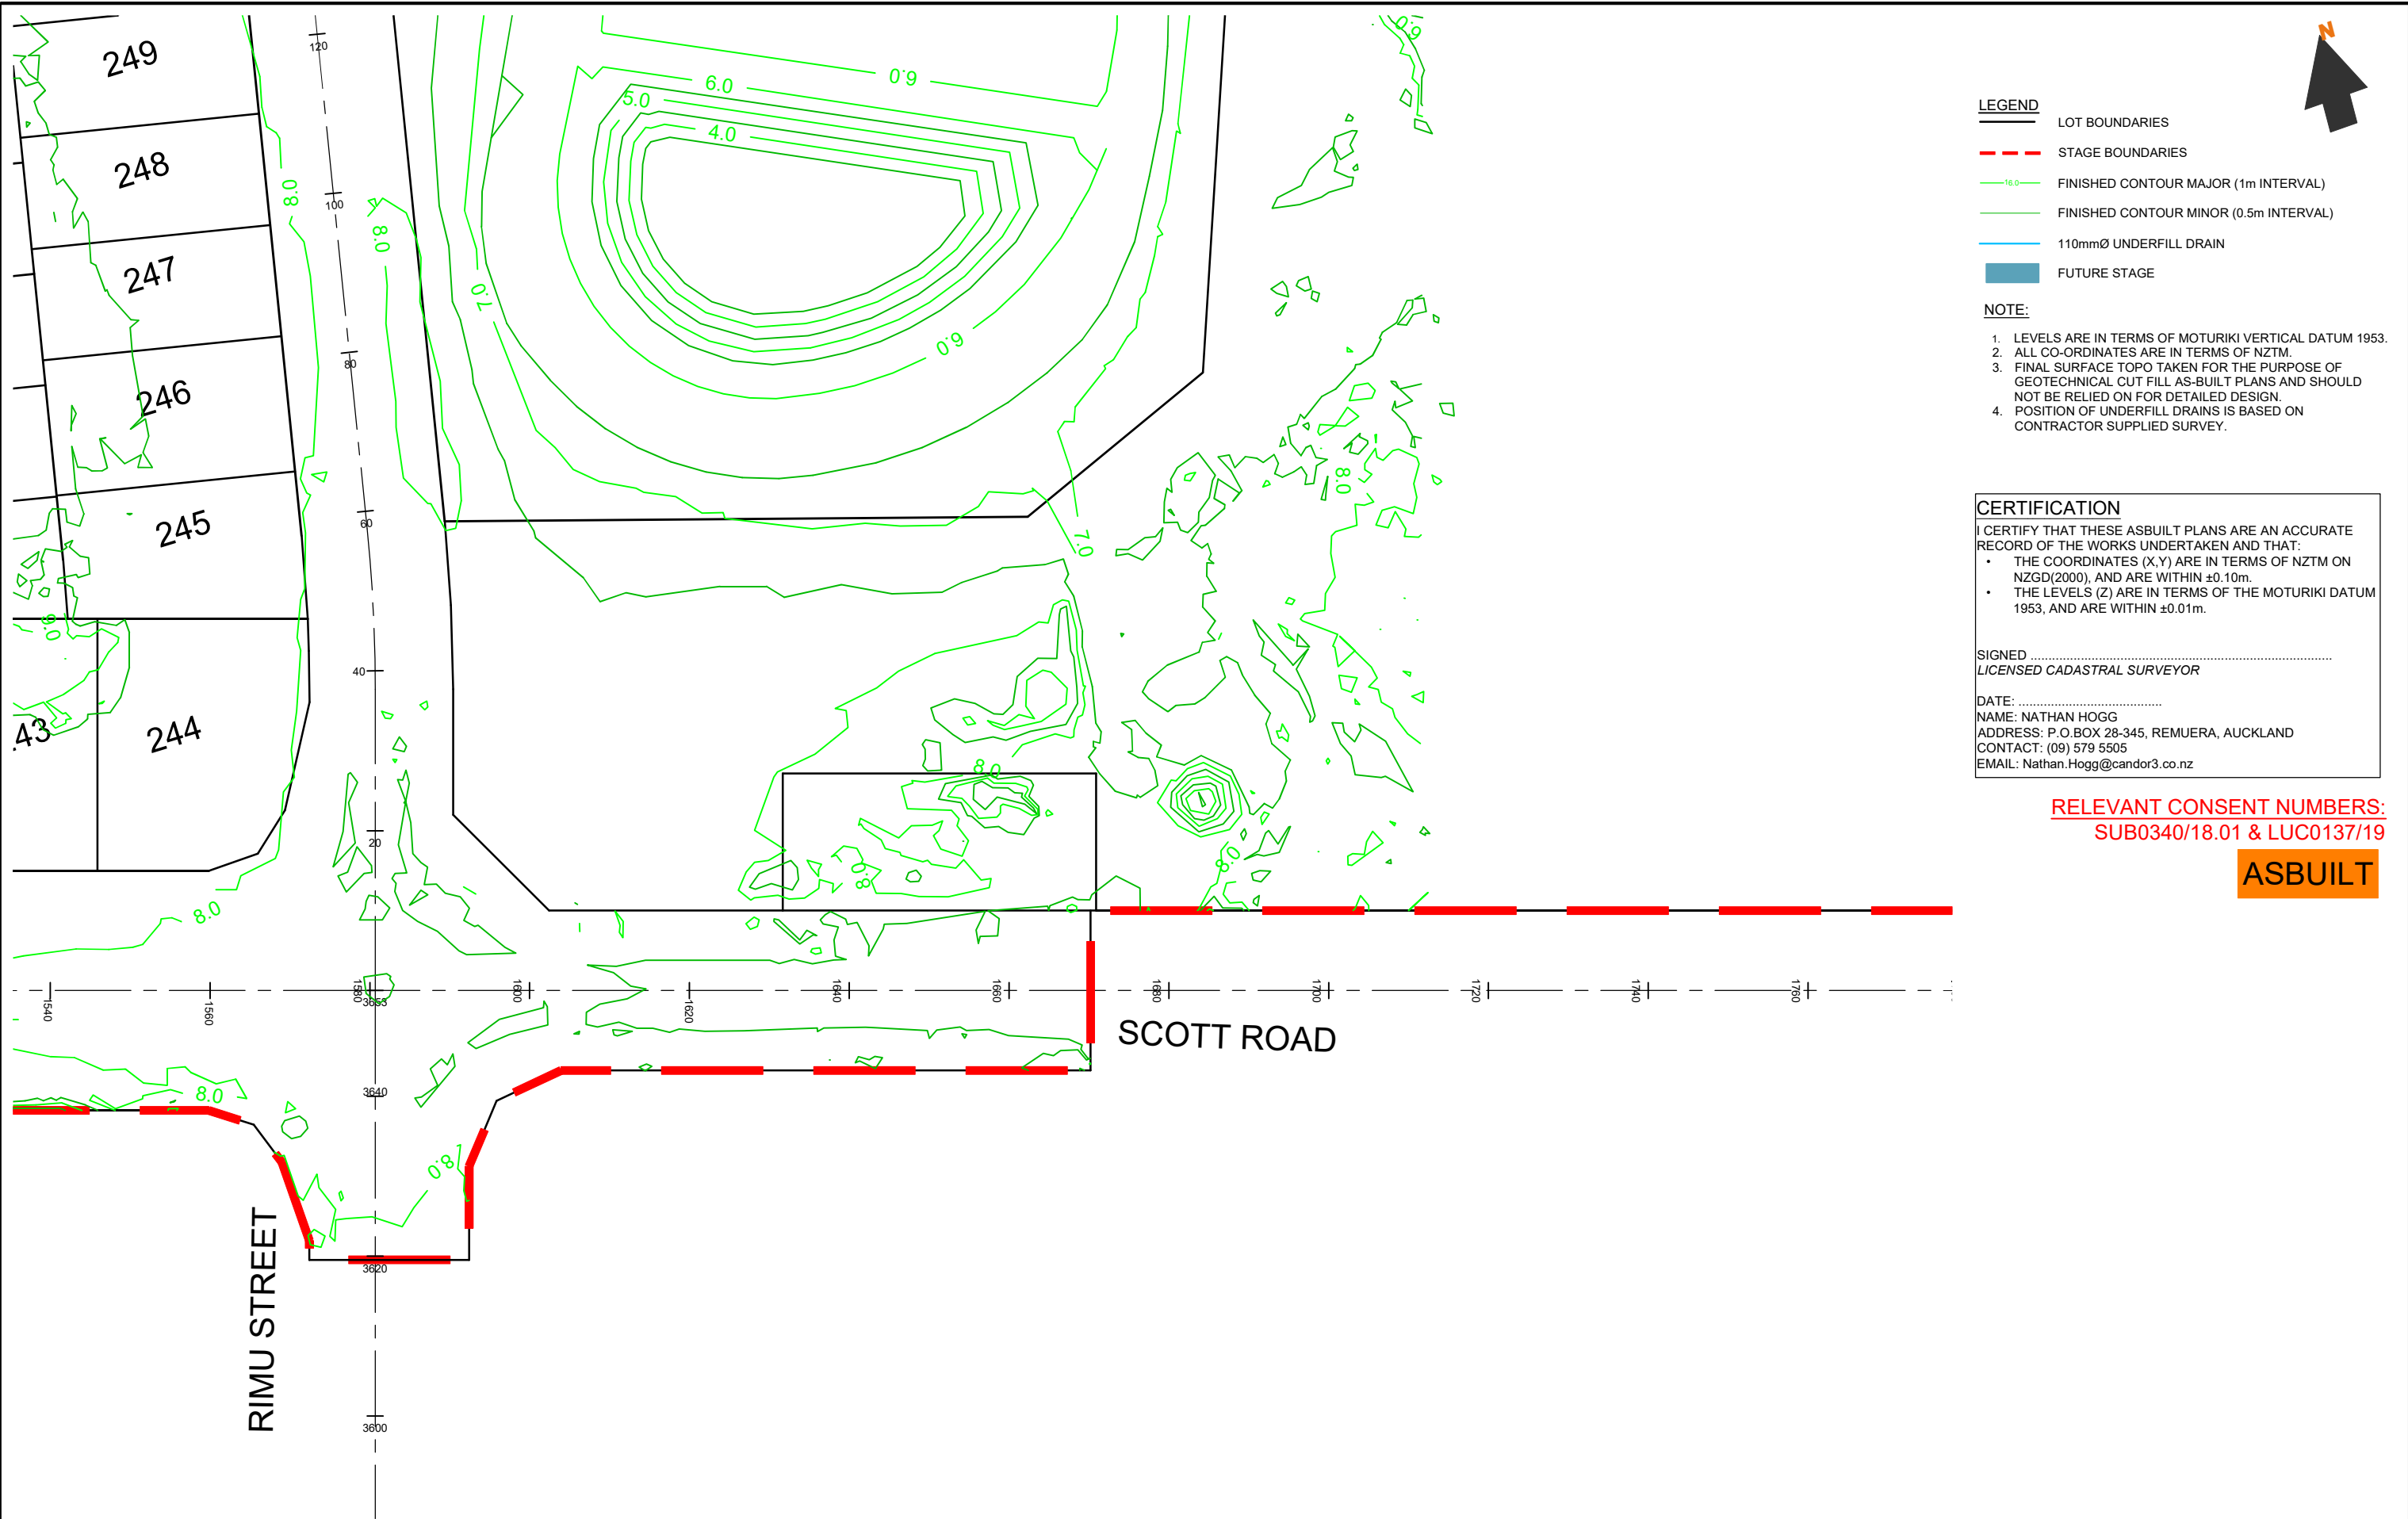

REV DESCRIPTION	BY	APPVD	DATE	<div>Candor³ ENGINEERING FOR LIFE</div>	PROJECT	LAKESIDE, TE KAUWHATA EARTHWORKS FINISHED SURFACE STAGE 5 SHEET 4 OF 6	CLIENT	LAKESIDE DEVELOPMENTS 2017 LIMITED	PURPOSE		
									AS-BUILT		
									DESIGN JS DRAWN JS CHECK AP	APPROVED BY NH DATE DEC 2020	SCALE 1:750 @ A3
									PROJECT NO.	DRAWING NO.	REV.
									1239	AB-2-203	-

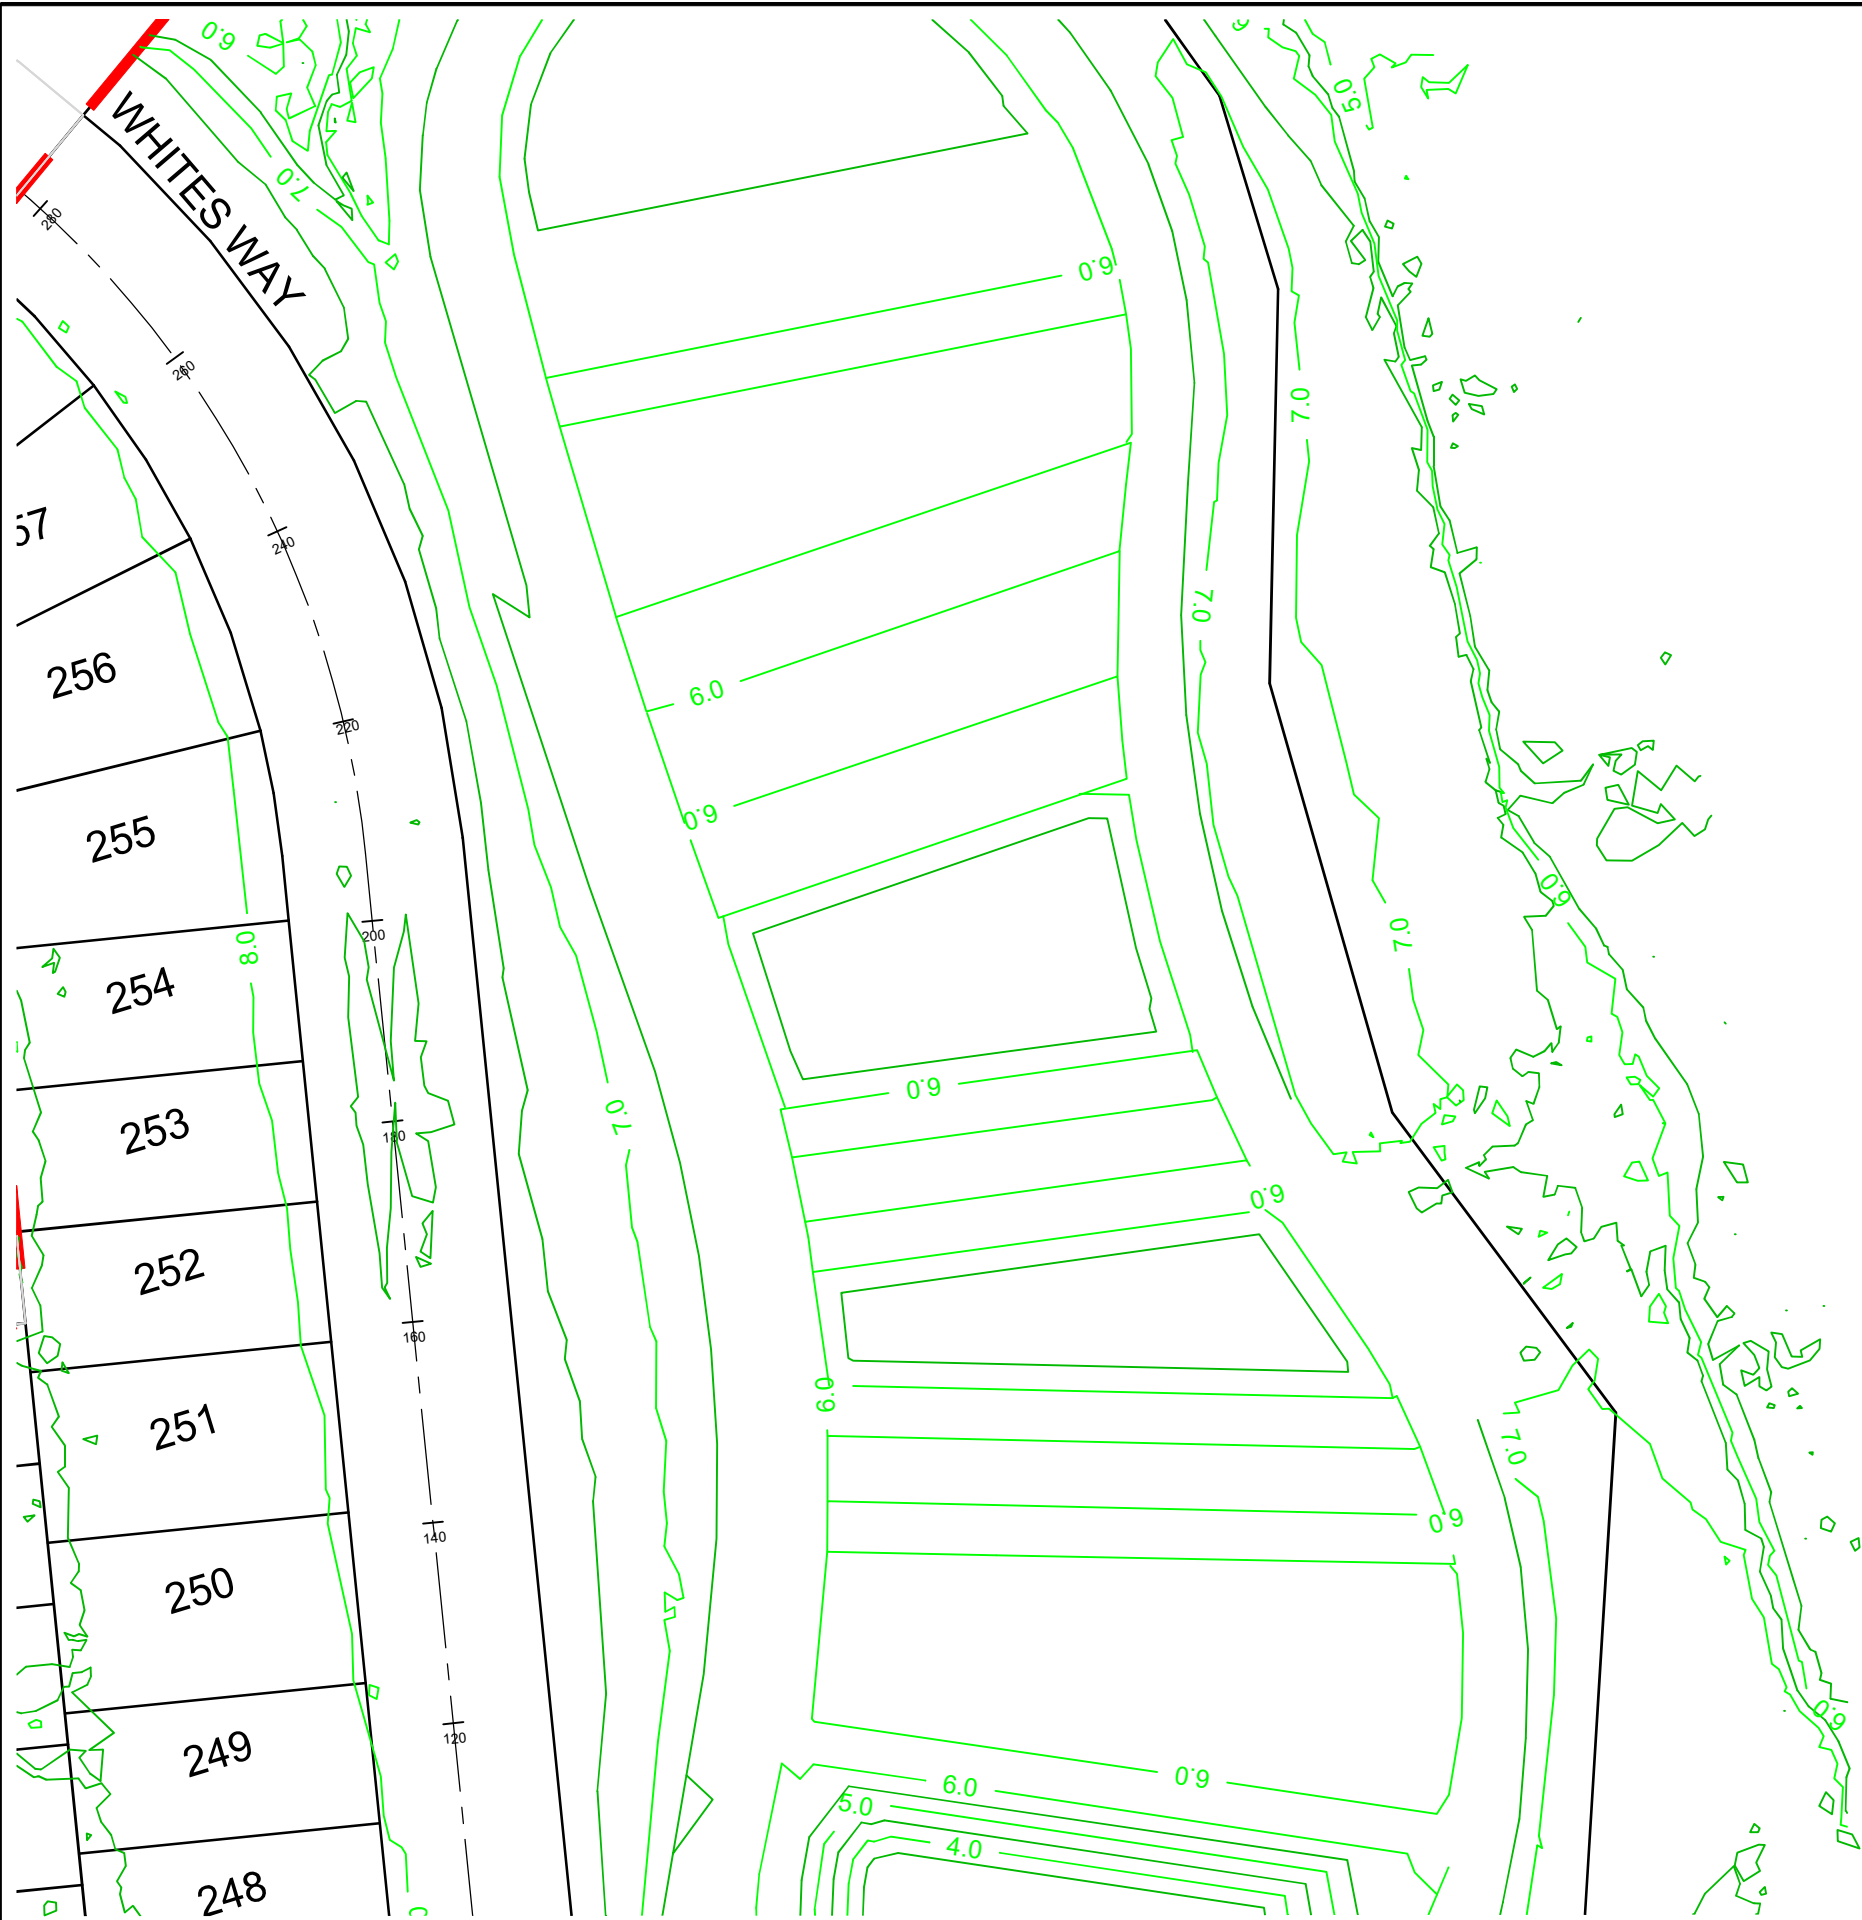

LEGEND

- LOT BOUNDARIES
- STAGE BOUNDARIES
- FINISHED CONTOUR MAJOR (1m INTERVAL)
- FINISHED CONTOUR MINOR (0.5m INTERVAL)
- 110mmØ UNDERFILL DRAIN
- FUTURE STAGE

- NOTE:**
- LEVELS ARE IN TERMS OF MOTURIKI VERTICAL DATUM 1953.
 - ALL CO-ORDINATES ARE IN TERMS OF NZTM.
 - FINAL SURFACE TOPO TAKEN FOR THE PURPOSE OF GEOTECHNICAL CUT FILL AS-BUILT PLANS AND SHOULD NOT BE RELIED ON FOR DETAILED DESIGN.
 - POSITION OF UNDERFILL DRAINS IS BASED ON CONTRACTOR SUPPLIED SURVEY.

CERTIFICATION

I CERTIFY THAT THESE ASBUILT PLANS ARE AN ACCURATE RECORD OF THE WORKS UNDERTAKEN AND THAT:

- THE COORDINATES (X,Y) ARE IN TERMS OF NZTM ON NZGD(2000), AND ARE WITHIN ±0.10m.
- THE LEVELS (Z) ARE IN TERMS OF THE MOTURIKI DATUM 1953, AND ARE WITHIN ±0.01m.


SIGNED
LICENSED CADASTRAL SURVEYOR

DATE:
NAME: NATHAN HOGG
ADDRESS: P.O.BOX 28-345, REMUERA, AUCKLAND
CONTACT: (09) 579 5505
EMAIL: Nathan.Hogg@candor3.co.nz

RELEVANT CONSENT NUMBERS:
SUB0340/18.01 & LUC0137/19

ASBUILT

REV DESCRIPTION		BY	APPVD	DATE	PROJECT		CLIENT		PURPOSE						
<div>Candor³</div> <div>ENGINEERING FOR LIFE</div>					LAKESIDE, TE KAUWHATA EARTHWORKS FINISHED SURFACE STAGE 5 SHEET 5 OF 6		LAKESIDE DEVELOPMENTS 2017 LIMITED		AS-BUILT						
									DESIGN JS		APPROVED NH		SCALE		
									DRAWN JS		BY NH		1:750 @ A3		
									CHECK AP		DATE DEC 2020				
									PROJECT NO.			DRAWING NO.		REV.	
									1239			AB-2-204		-	

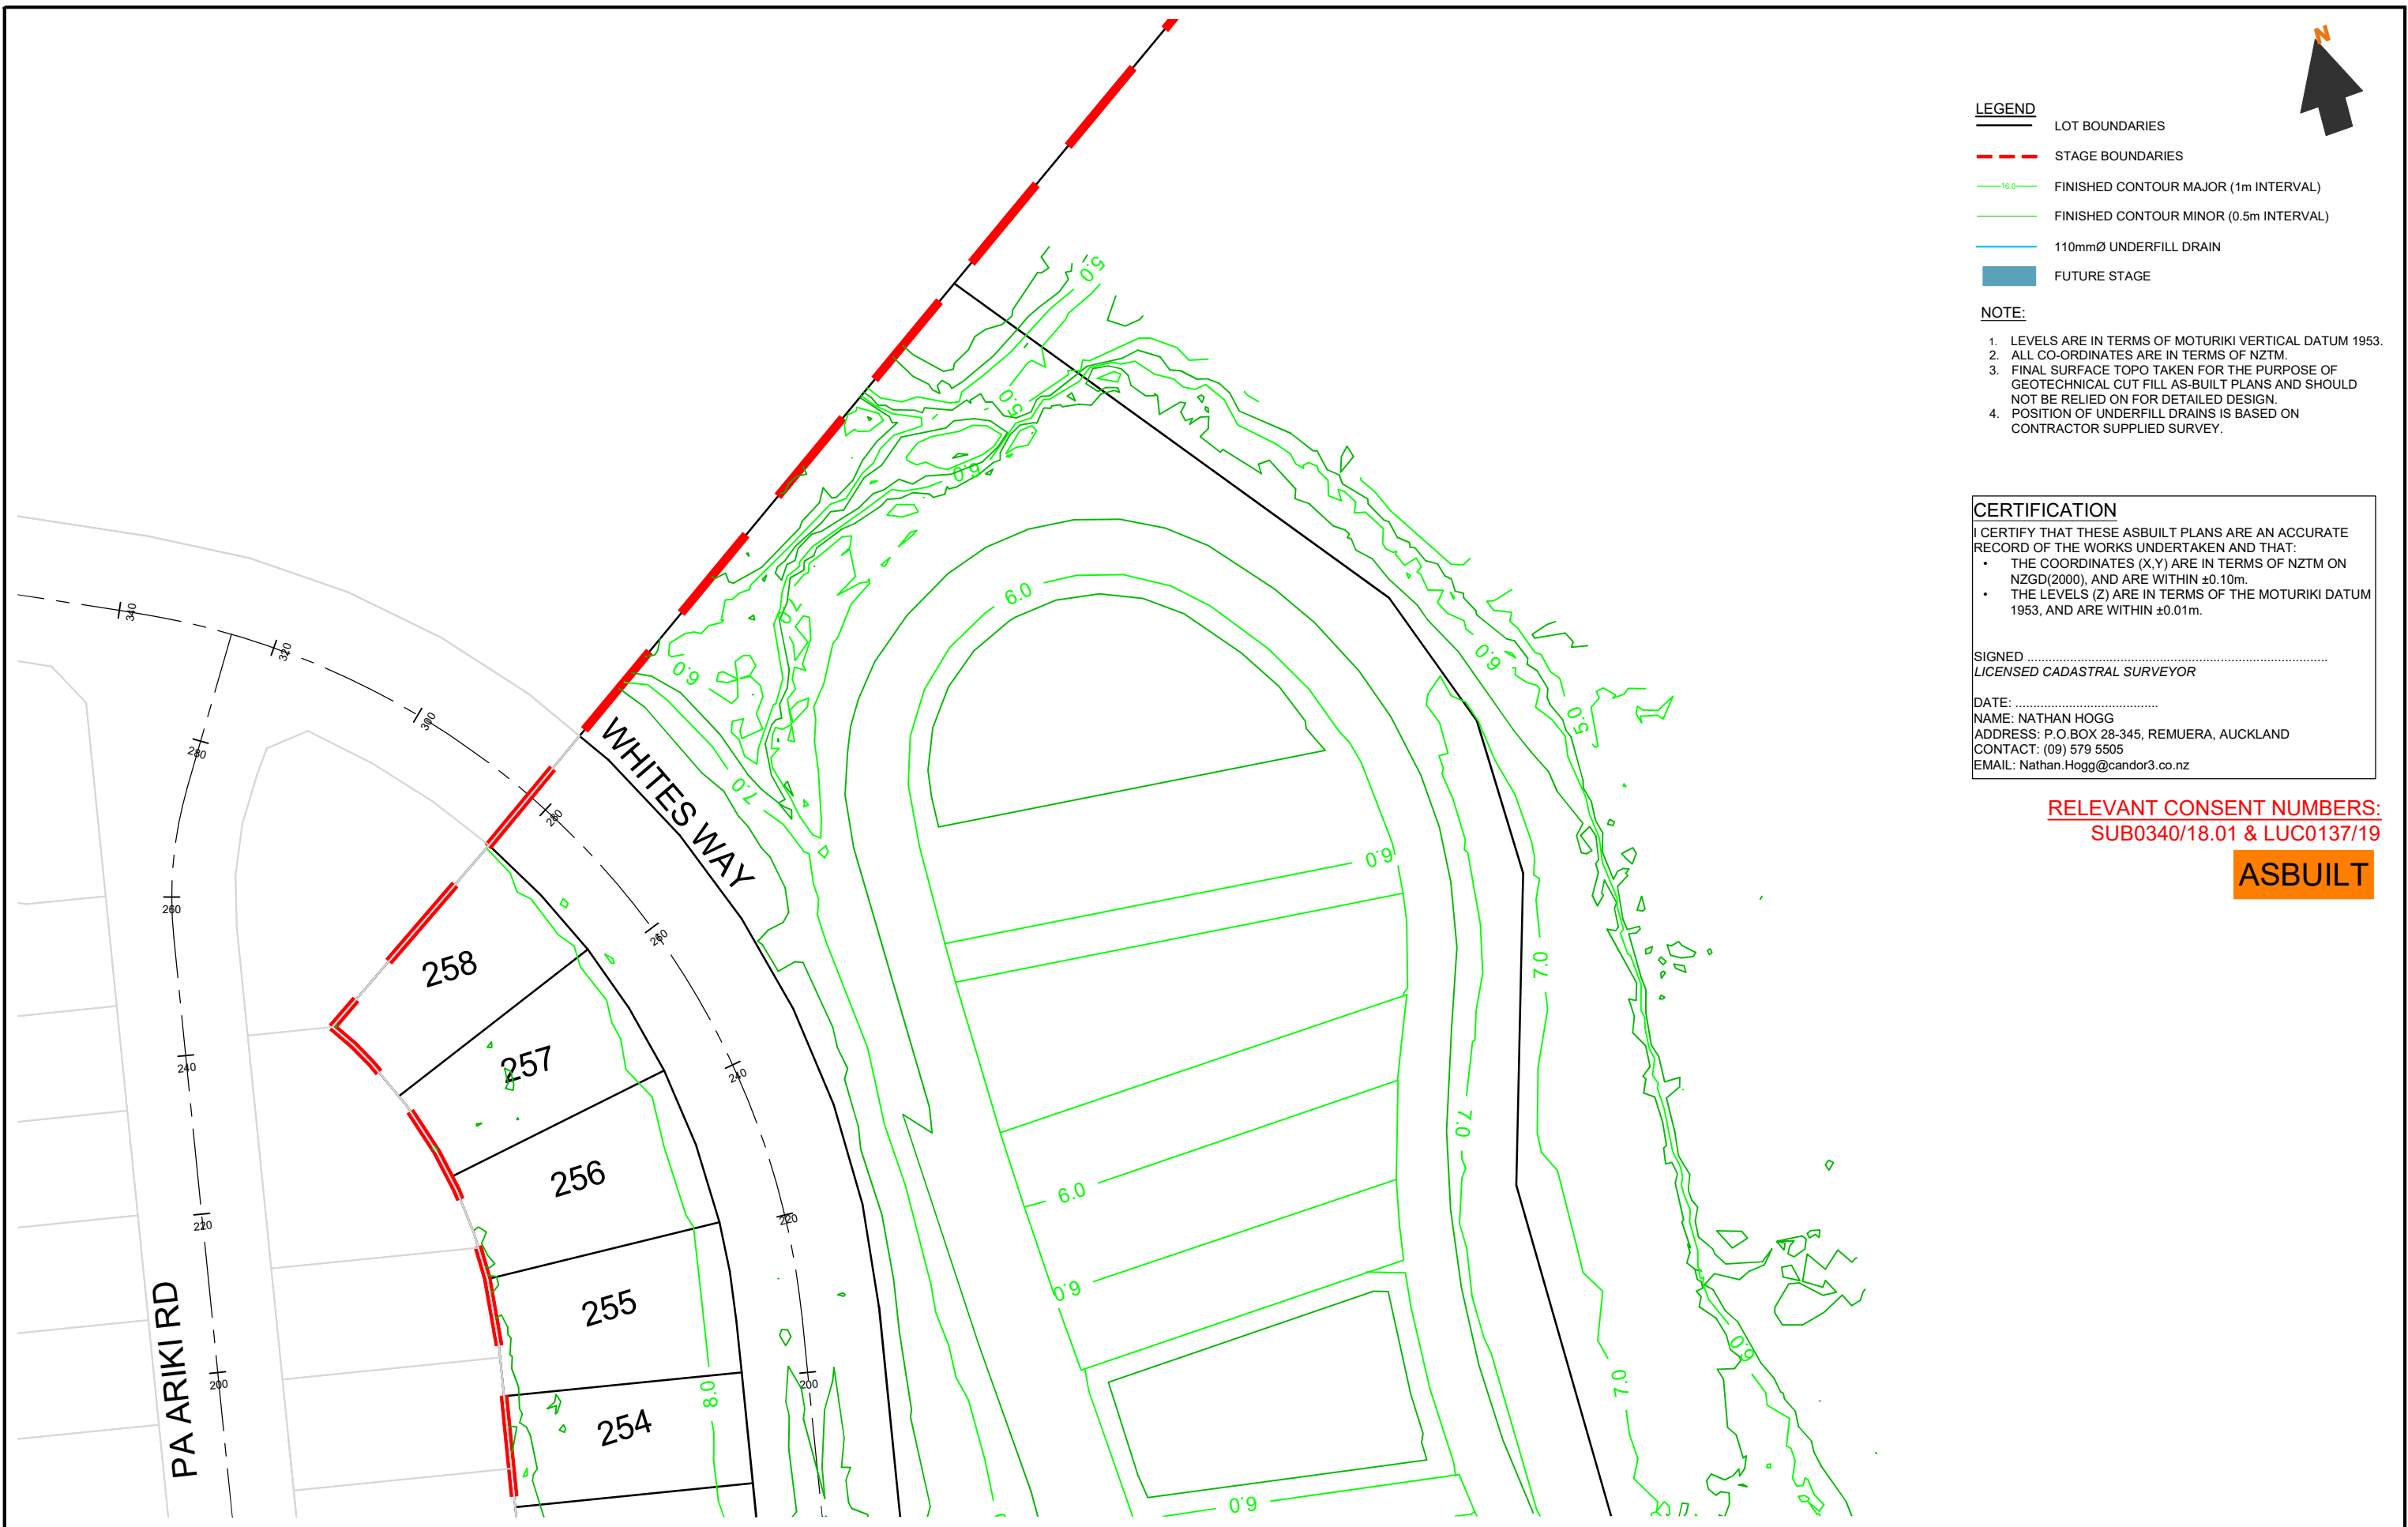

LEGEND

LOT BOUNDARIES

STAGE BOUNDARIES

FINISHED CONTOUR MAJOR (1m INTERVAL)

FINISHED CONTOUR MINOR (0.5m INTERVAL)

110mmØ UNDERFILL DRAIN

FUTURE STAGE

- NOTE:
1. LEVELS ARE IN TERMS OF MOTURIKI VERTICAL DATUM 1953.

2. ALL CO-ORDINATES ARE IN TERMS OF NZTM.

3. FINAL SURFACE TOPO TAKEN FOR THE PURPOSE OF GEOTECHNICAL CUT FILL AS-BUILT PLANS AND SHOULD NOT BE RELIED ON FOR DETAILED DESIGN.

4. POSITION OF UNDERFILL DRAINS IS BASED ON CONTRACTOR SUPPLIED SURVEY.

CERTIFICATION

I CERTIFY THAT THESE ASBUILT PLANS ARE AN ACCURATE RECORD OF THE WORKS UNDERTAKEN AND THAT:

- THE COORDINATES (X,Y) ARE IN TERMS OF NZTM ON NZGD(2000), AND ARE WITHIN ±0.10m.
- THE LEVELS (Z) ARE IN TERMS OF THE MOTURIKI DATUM 1953, AND ARE WITHIN ±0.01m.


SIGNED
LICENSED CADASTRAL SURVEYOR

DATE:
NAME: NATHAN HOGG
ADDRESS: P.O.BOX 28-345, REMUERA, AUCKLAND
CONTACT: (09) 579 5505
EMAIL: Nathan.Hogg@candor3.co.nz

RELEVANT CONSENT NUMBERS:
SUB0340/18.01 & LUC0137/19

ASBUILT

REV DESCRIPTIONBY APPVD DATE			PROJECT		CLIENT		PURPOSE		
			LAKESIDE, TE KAUWHATA		LAKESIDE		AS-BUILT		
			EARTHWORKS FINISHED SURFACE STAGE 5		DEVELOPMENTS 2017		DESIGN JS	APPROVED BY NH	SCALE 1:750 @ A3
			SHEET 6 OF 6		LIMITED		CHECK AP	DATE DEC 2020	
							PROJECT NO.	DRAWING NO.	REV.
							1239	AB-2-205	-

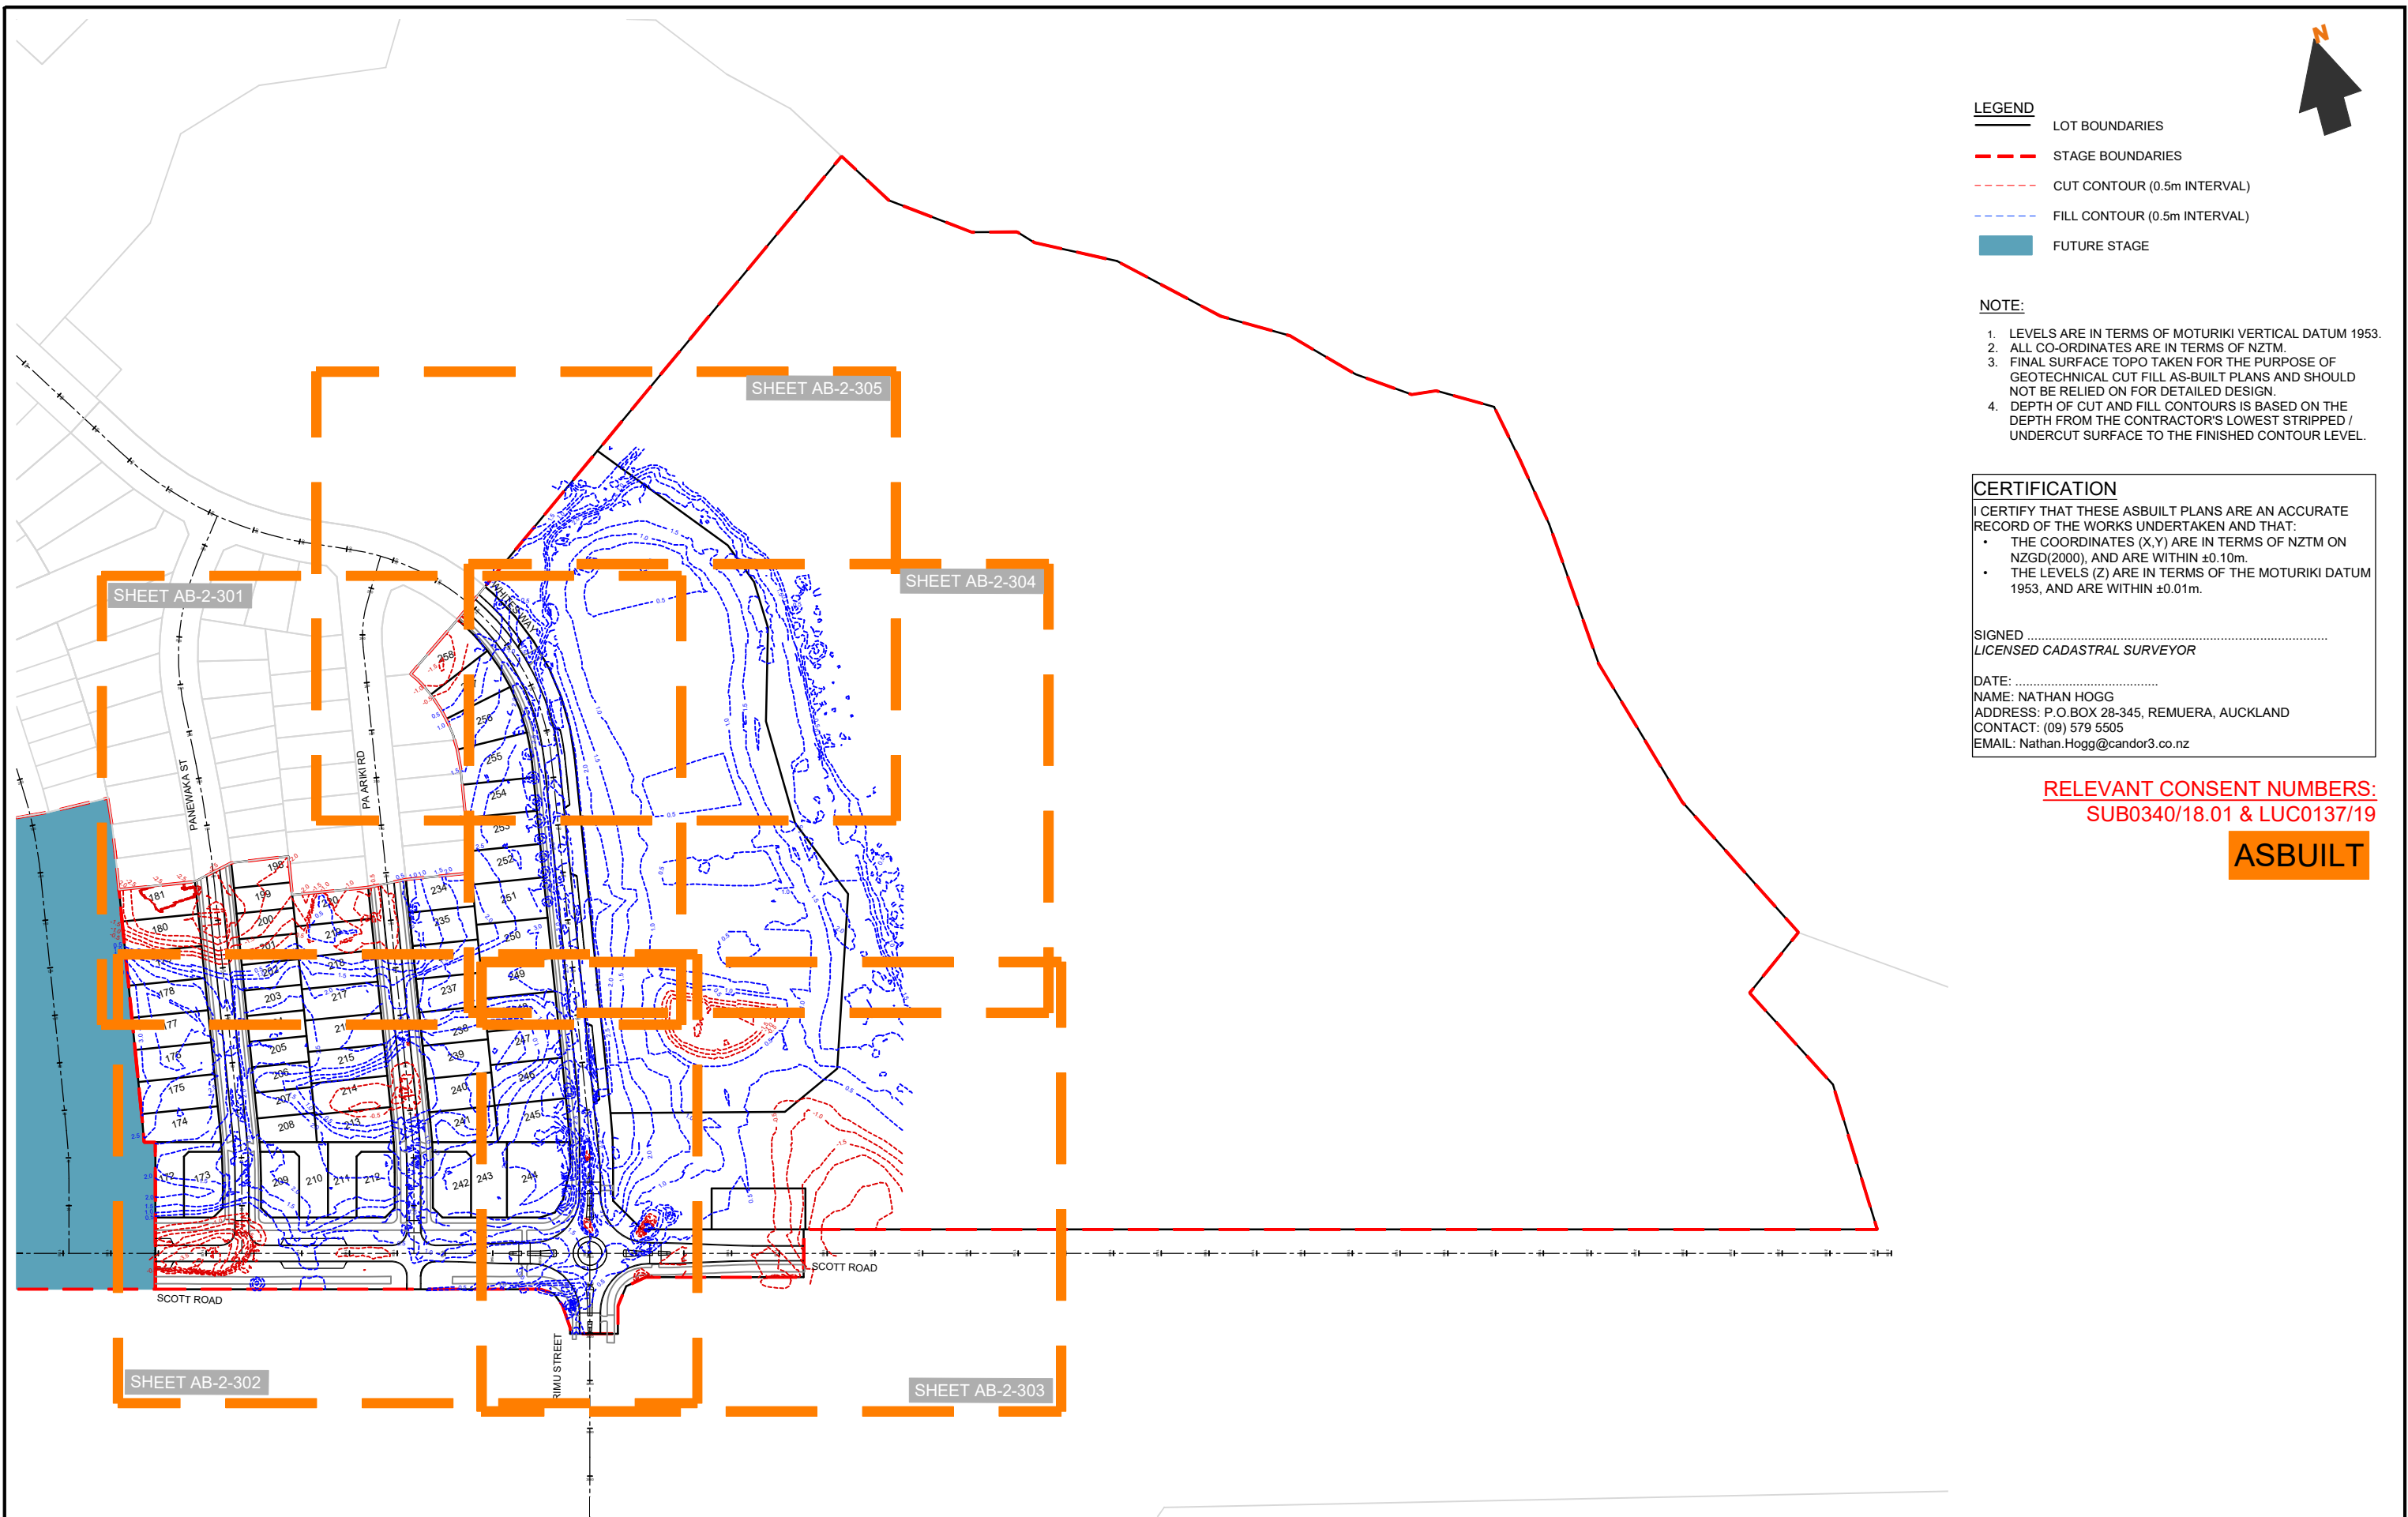

LEGEND

LOT BOUNDARIES

STAGE BOUNDARIES

CUT CONTOUR (0.5m INTERVAL)

FILL CONTOUR (0.5m INTERVAL)

FUTURE STAGE

- NOTE:
1. LEVELS ARE IN TERMS OF MOTURIKI VERTICAL DATUM 1953.

2. ALL CO-ORDINATES ARE IN TERMS OF NZTM.

3. FINAL SURFACE TOPO TAKEN FOR THE PURPOSE OF GEOTECHNICAL CUT FILL AS-BUILT PLANS AND SHOULD NOT BE RELIED ON FOR DETAILED DESIGN.

4. DEPTH OF CUT AND FILL CONTOURS IS BASED ON THE DEPTH FROM THE CONTRACTOR'S LOWEST STRIPPED / UNDERCUT SURFACE TO THE FINISHED CONTOUR LEVEL.

CERTIFICATION

I CERTIFY THAT THESE ASBUILT PLANS ARE AN ACCURATE RECORD OF THE WORKS UNDERTAKEN AND THAT:

- THE COORDINATES (X,Y) ARE IN TERMS OF NZTM ON NZGD(2000), AND ARE WITHIN ±0.10m.
- THE LEVELS (Z) ARE IN TERMS OF THE MOTURIKI DATUM 1953, AND ARE WITHIN ±0.01m.


SIGNED
LICENSED CADASTRAL SURVEYOR

DATE:
NAME: NATHAN HOGG
ADDRESS: P.O.BOX 28-345, REMUERA, AUCKLAND
CONTACT: (09) 579 5505
EMAIL: Nathan.Hogg@candor3.co.nz

RELEVANT CONSENT NUMBERS:
SUB0340/18.01 & LUC0137/19

ASBUILT

REV DESCRIPTION BY APPVD DATE			PROJECT		CLIENT		PURPOSE		
			LAKESIDE, TE KAUWHATA		LAKESIDE		AS-BUILT		
			EARTHWORKS DEPTH CONTOURS STAGE 5		DEVELOPMENTS 2017		DESIGN JS	APPROVED NH	SCALE
			SHEET 1 OF 6		LIMITED		DRAWN JS	BY NH	1:2500 @ A3
							CHECK AP	DATE DEC 2020	
							PROJECT NO.	DRAWING NO.	REV.
							1239	AB-2-300	-

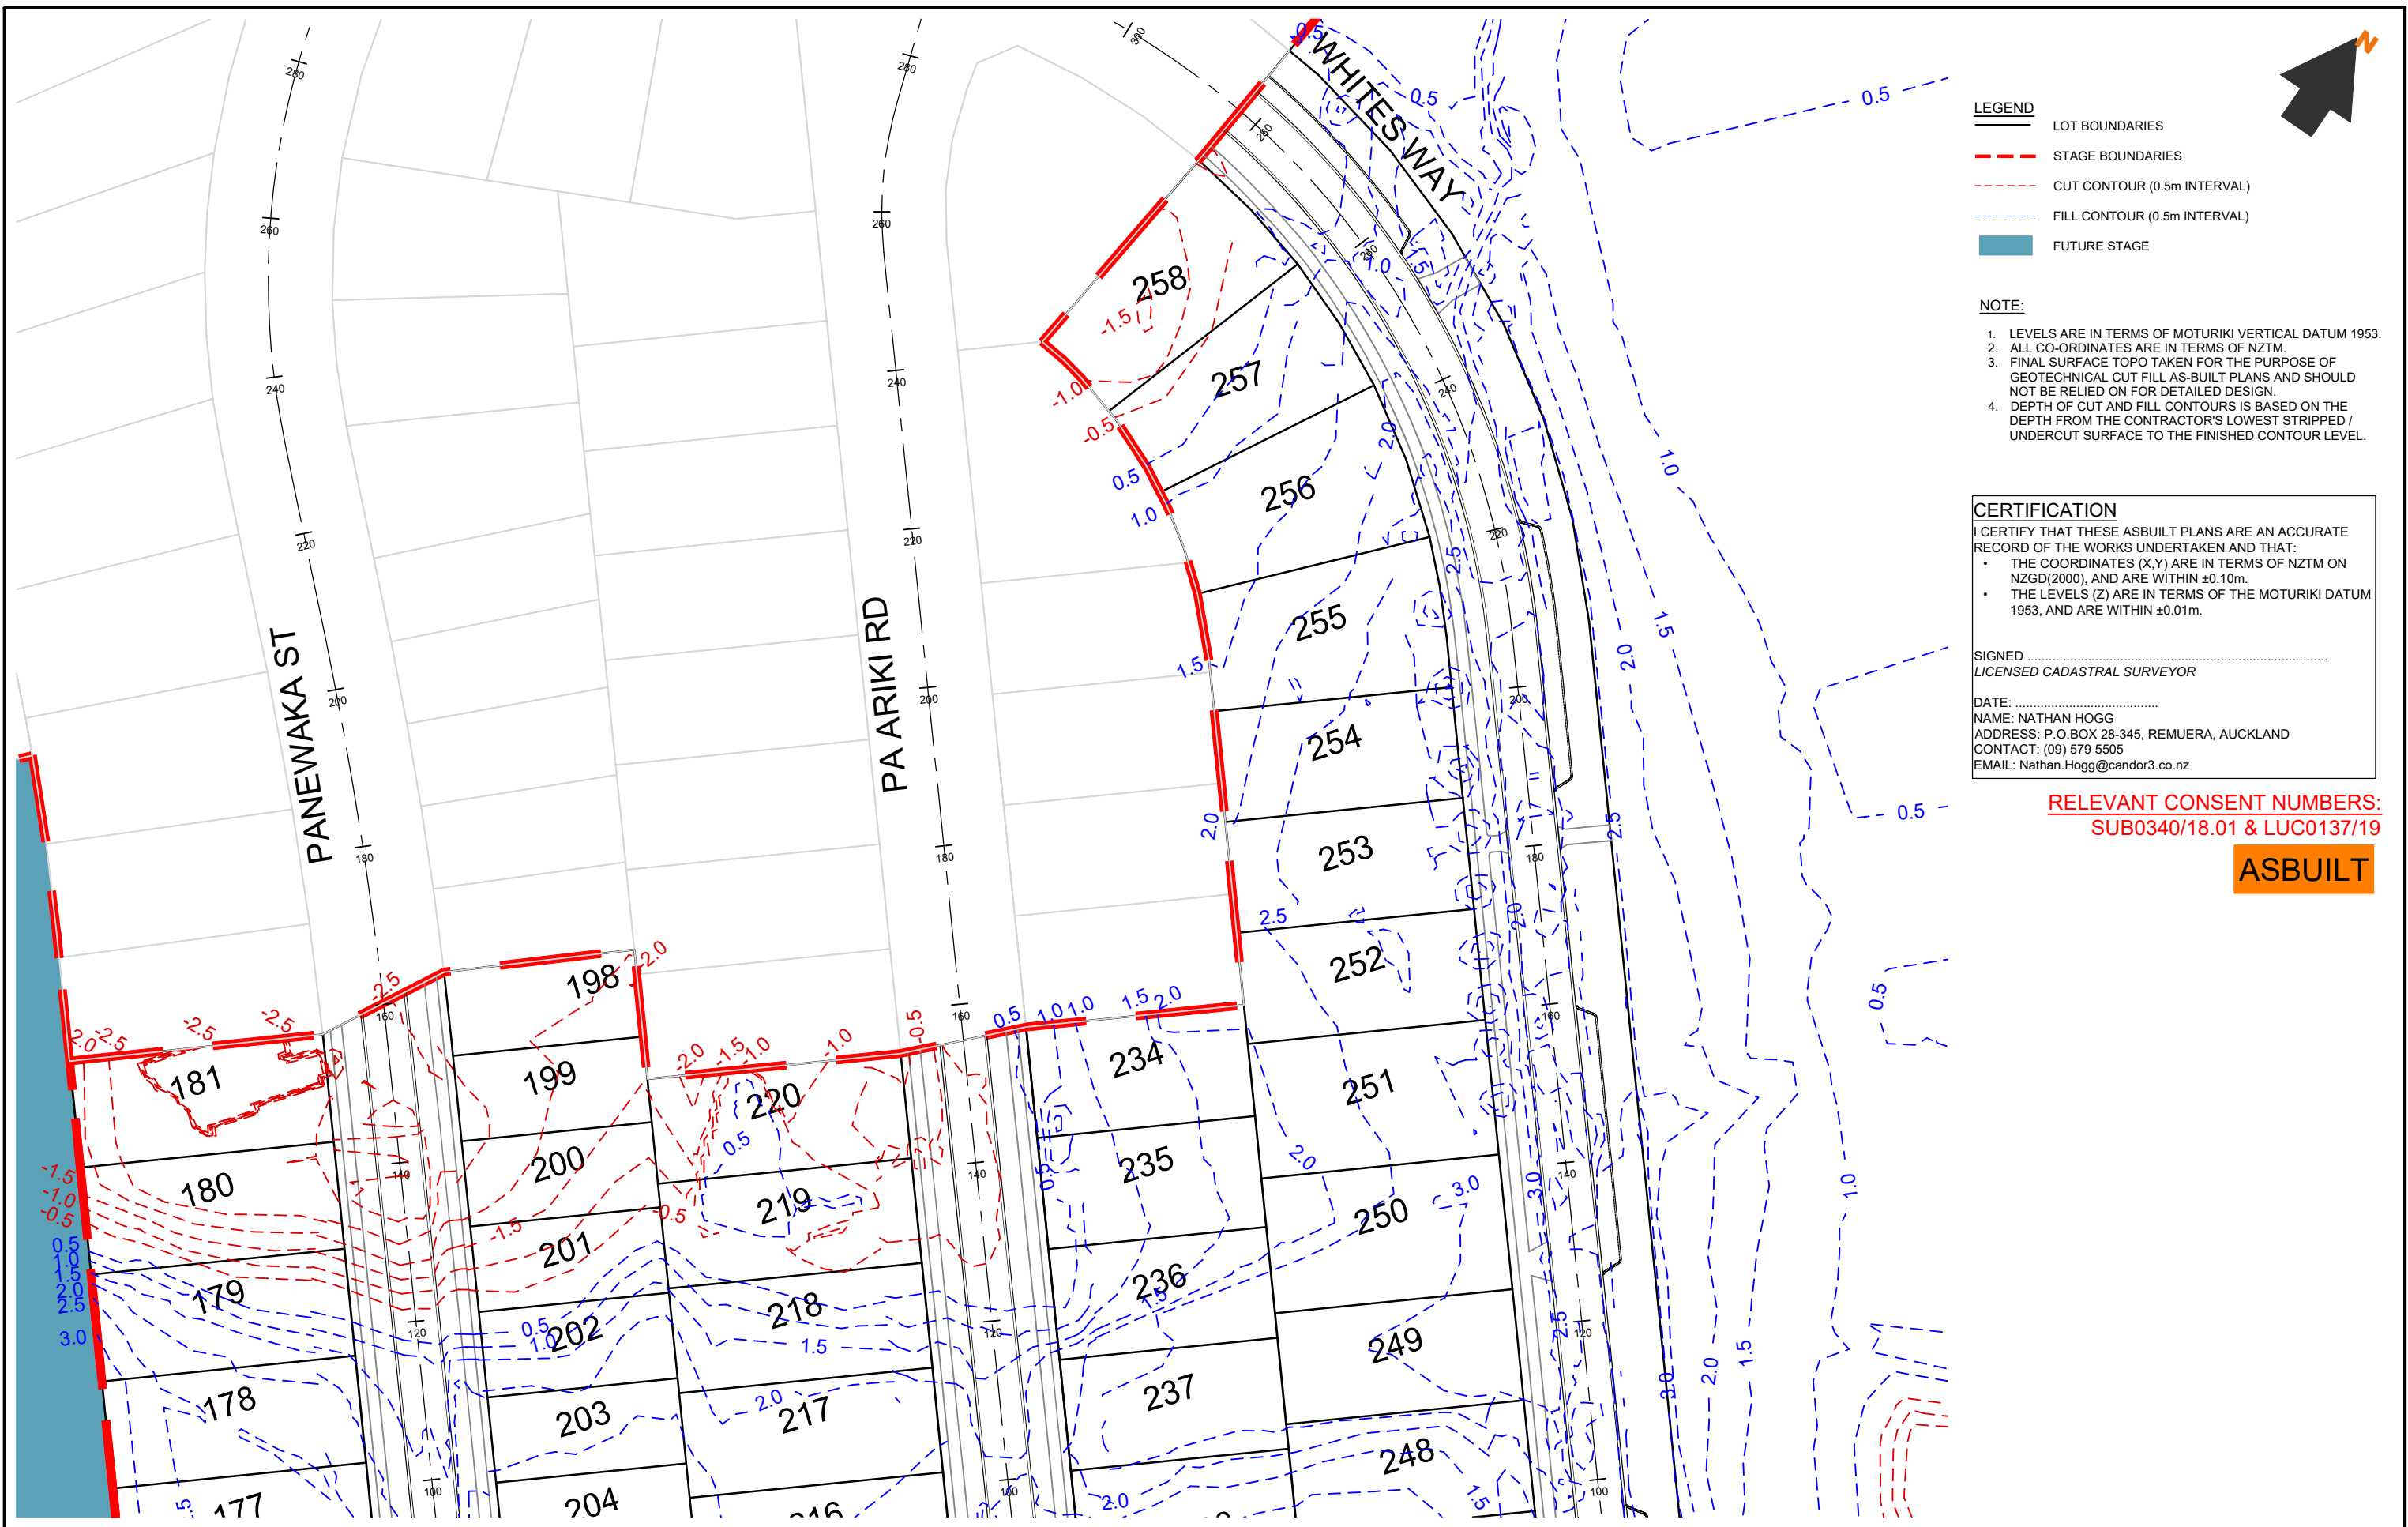

LEGEND

LOT BOUNDARIES

STAGE BOUNDARIES

CUT CONTOUR (0.5m INTERVAL)

FILL CONTOUR (0.5m INTERVAL)

FUTURE STAGE

- NOTE:
1.

LEVELS ARE IN TERMS OF MOTURIKI VERTICAL DATUM 1953.
2.

ALL CO-ORDINATES ARE IN TERMS OF NZTM.
3.

FINAL SURFACE TOPO TAKEN FOR THE PURPOSE OF GEOTECHNICAL CUT FILL AS-BUILT PLANS AND SHOULD NOT BE RELIED ON FOR DETAILED DESIGN.
4.

DEPTH OF CUT AND FILL CONTOURS IS BASED ON THE DEPTH FROM THE CONTRACTOR'S LOWEST STRIPPED / UNDERCUT SURFACE TO THE FINISHED CONTOUR LEVEL.

CERTIFICATION

I CERTIFY THAT THESE ASBUILT PLANS ARE AN ACCURATE RECORD OF THE WORKS UNDERTAKEN AND THAT:

•

THE COORDINATES (X,Y) ARE IN TERMS OF NZTM ON NZGD(2000), AND ARE WITHIN ±0.10m.

•

THE LEVELS (Z) ARE IN TERMS OF THE MOTURIKI DATUM 1953, AND ARE WITHIN ±0.01m.

SIGNED

LICENSED CADASTRAL SURVEYOR

DATE:

NAME: NATHAN HOGG

ADDRESS: P.O.BOX 28-345, REMUERA, AUCKLAND

CONTACT: (09) 579 5505


EMAIL: Nathan.Hogg@candor3.co.nz

RELEVANT CONSENT NUMBERS:

SUB0340/18.01 & LUC0137/19

ASBUILT

REV DESCRIPTION		BY	APPVD	DATE	PROJECT		CLIENT		PURPOSE		
					LAKESIDE, TE KAUWHATA		LAKESIDE		AS-BUILT		
					EARTHWORKS DEPTH CONTOURS STAGE 5		DEVELOPMENTS 2017		DESIGN JS	APPROVED BY NH	SCALE 1:750 @ A3
					SHEET 2 OF 6		LIMITED		CHECK AP	DATE DEC 2020	
									PROJECT NO.	DRAWING NO.	REV.
									1239	AB-2-301	-

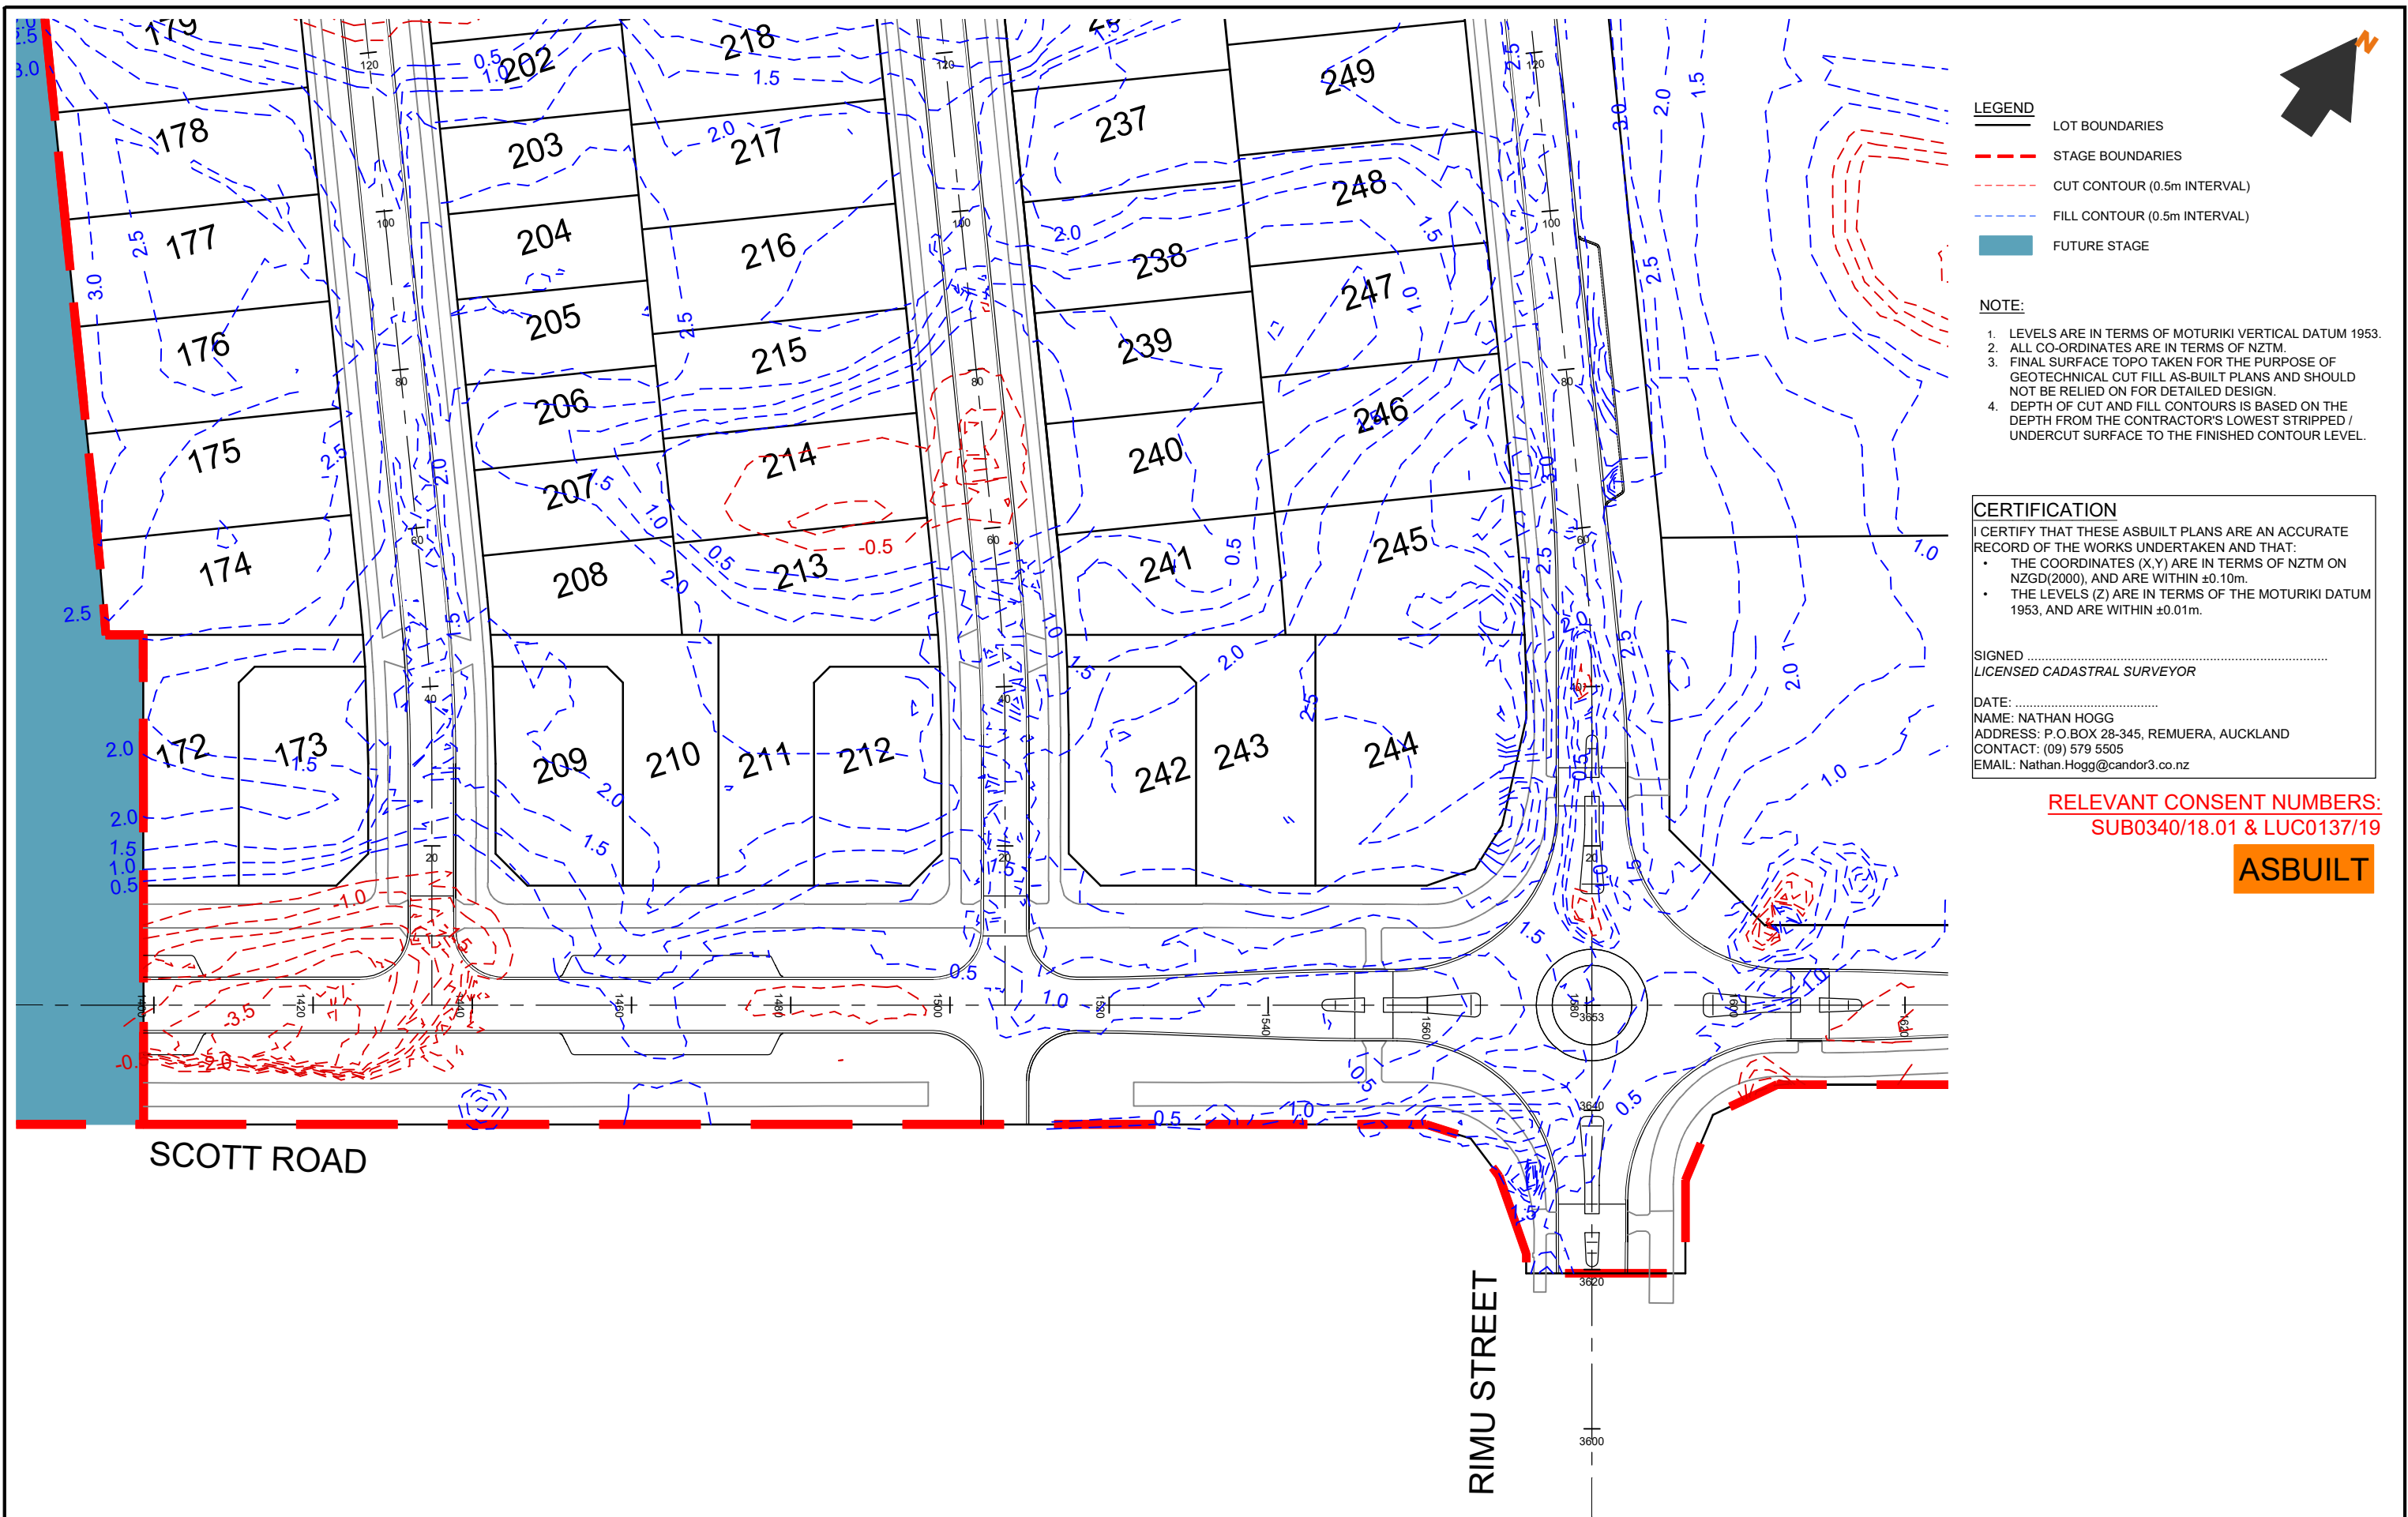

LEGEND

- LOT BOUNDARIES
- STAGE BOUNDARIES
- CUT CONTOUR (0.5m INTERVAL)
- FILL CONTOUR (0.5m INTERVAL)
- FUTURE STAGE

NOTE:

- LEVELS ARE IN TERMS OF MOTURIKI VERTICAL DATUM 1953.
- ALL CO-ORDINATES ARE IN TERMS OF NZTM.
- FINAL SURFACE TOPO TAKEN FOR THE PURPOSE OF GEOTECHNICAL CUT FILL AS-BUILT PLANS AND SHOULD NOT BE RELIED ON FOR DETAILED DESIGN.
- DEPTH OF CUT AND FILL CONTOURS IS BASED ON THE DEPTH FROM THE CONTRACTOR'S LOWEST STRIPPED / UNDERCUT SURFACE TO THE FINISHED CONTOUR LEVEL.

CERTIFICATION

I CERTIFY THAT THESE ASBUILT PLANS ARE AN ACCURATE RECORD OF THE WORKS UNDERTAKEN AND THAT:

- THE COORDINATES (X,Y) ARE IN TERMS OF NZTM ON NZGD(2000), AND ARE WITHIN ±0.10m.
- THE LEVELS (Z) ARE IN TERMS OF THE MOTURIKI DATUM 1953, AND ARE WITHIN ±0.01m.


SIGNED
LICENSED CADASTRAL SURVEYOR

DATE:
NAME: NATHAN HOGG
ADDRESS: P.O.BOX 28-345, REMUERA, AUCKLAND
CONTACT: (09) 579 5505
EMAIL: Nathan.Hogg@candor3.co.nz

RELEVANT CONSENT NUMBERS:
SUB0340/18.01 & LUC0137/19

ASBUILT

REV DESCRIPTION		BY APPVD DATE	<div>Candor³</div> <div>ENGINEERING FOR LIFE</div>	PROJECT LAKESIDE, TE KAUWHATA EARTHWORKS DEPTH CONTOURS STAGE 5 SHEET 3 OF 6	CLIENT LAKESIDE DEVELOPMENTS 2017 LIMITED	PURPOSE AS-BUILT		
						DESIGN JS DRAWN JS CHECK AP	APPROVED BY NH DATE DEC 2020	SCALE 1:750 @ A3
						PROJECT NO. 1239 DRAWING NO. AB-2-302 REV. -		

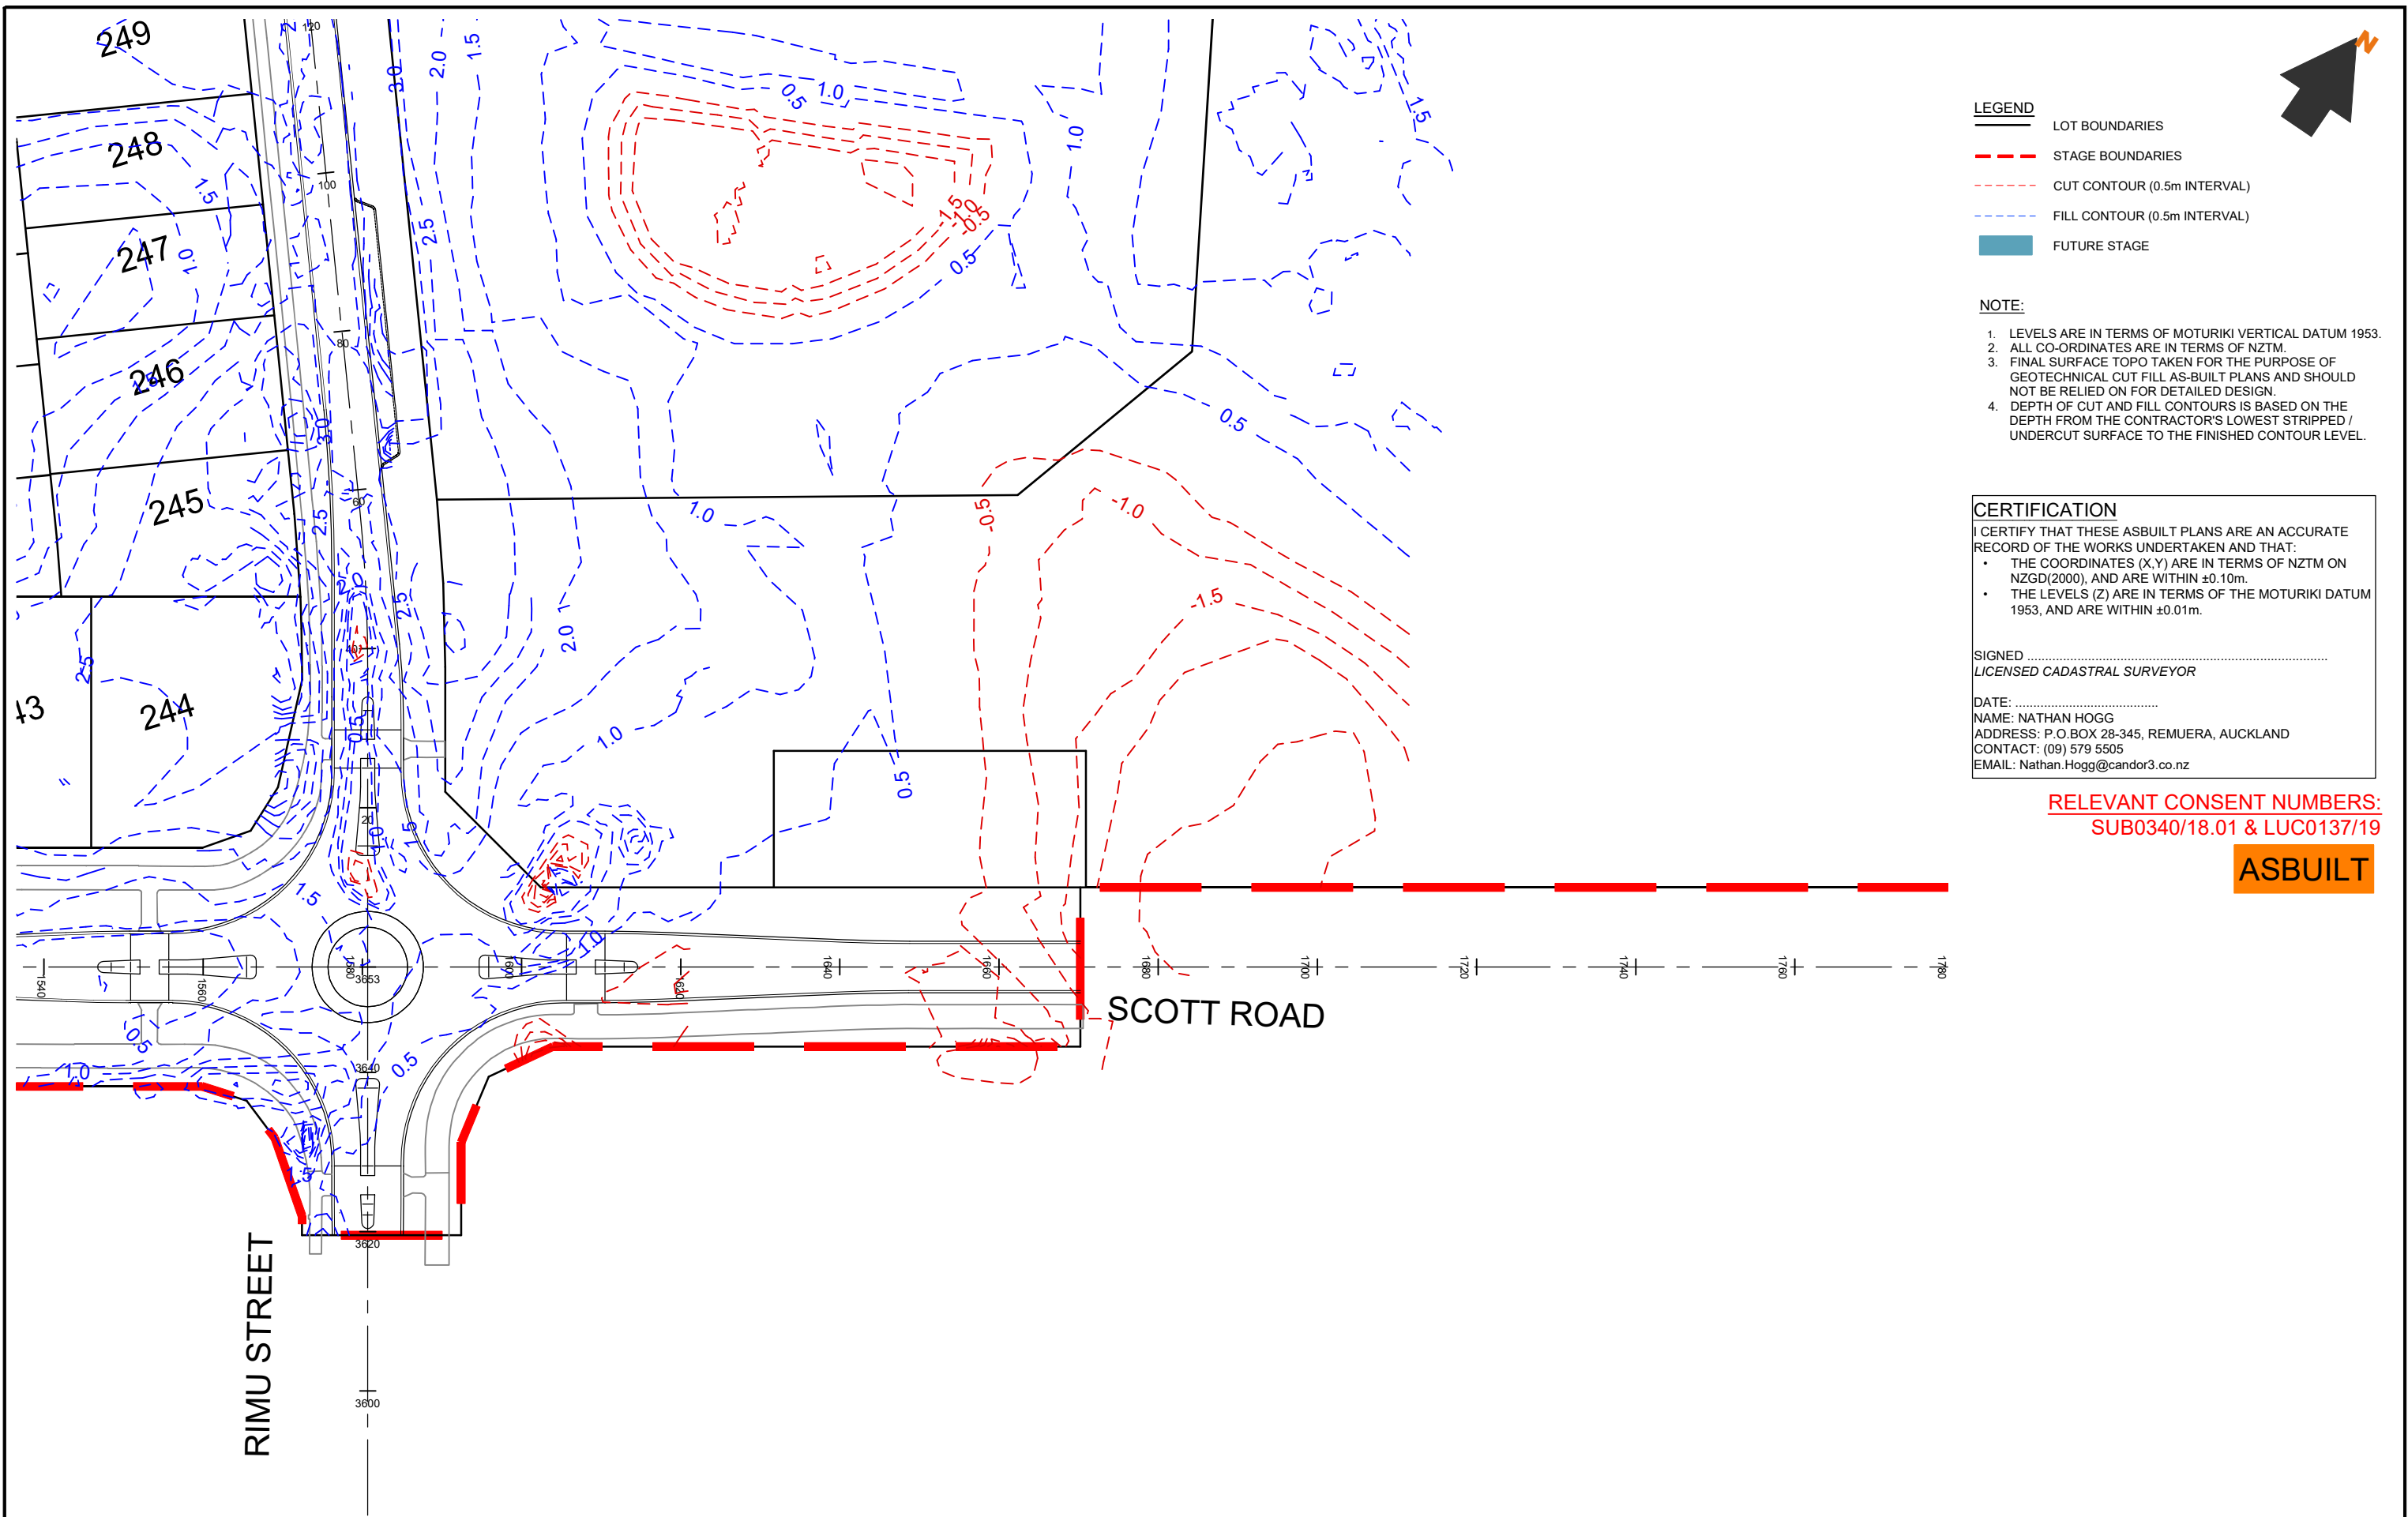

LEGEND

- LOT BOUNDARIES
- STAGE BOUNDARIES
- CUT CONTOUR (0.5m INTERVAL)
- FILL CONTOUR (0.5m INTERVAL)
- FUTURE STAGE

NOTE:

- LEVELS ARE IN TERMS OF MOTURIKI VERTICAL DATUM 1953.
- ALL CO-ORDINATES ARE IN TERMS OF NZTM.
- FINAL SURFACE TOPO TAKEN FOR THE PURPOSE OF GEOTECHNICAL CUT FILL AS-BUILT PLANS AND SHOULD NOT BE RELIED ON FOR DETAILED DESIGN.
- DEPTH OF CUT AND FILL CONTOURS IS BASED ON THE DEPTH FROM THE CONTRACTOR'S LOWEST STRIPPED / UNDERCUT SURFACE TO THE FINISHED CONTOUR LEVEL.

CERTIFICATION

I CERTIFY THAT THESE ASBUILT PLANS ARE AN ACCURATE RECORD OF THE WORKS UNDERTAKEN AND THAT:

- THE COORDINATES (X,Y) ARE IN TERMS OF NZTM ON NZGD(2000), AND ARE WITHIN ±0.10m.
- THE LEVELS (Z) ARE IN TERMS OF THE MOTURIKI DATUM 1953, AND ARE WITHIN ±0.01m.


SIGNED
LICENSED CADASTRAL SURVEYOR

DATE:
NAME: NATHAN HOGG
ADDRESS: P.O.BOX 28-345, REMUERA, AUCKLAND
CONTACT: (09) 579 5505
EMAIL: Nathan.Hogg@candor3.co.nz

RELEVANT CONSENT NUMBERS:
SUB0340/18.01 & LUC0137/19

ASBUILT

REV DESCRIPTION		BY	APPVD	DATE	<div>Candor³</div> ENGINEERING FOR LIFE	PROJECT LAKESIDE, TE KAUWHATA EARTHWORKS DEPTH CONTOURS STAGE 5 SHEET 4 OF 6	CLIENT LAKESIDE DEVELOPMENTS 2017 LIMITED	PURPOSE AS-BUILT		
DESIGN	JS							DESIGN	JS	APPROVED BY NH DATE DEC 2020
DRAWN	JS							CHECK	AP	
								PROJECT NO.	DRAWING NO.	REV.
								1239	AB-2-303	-

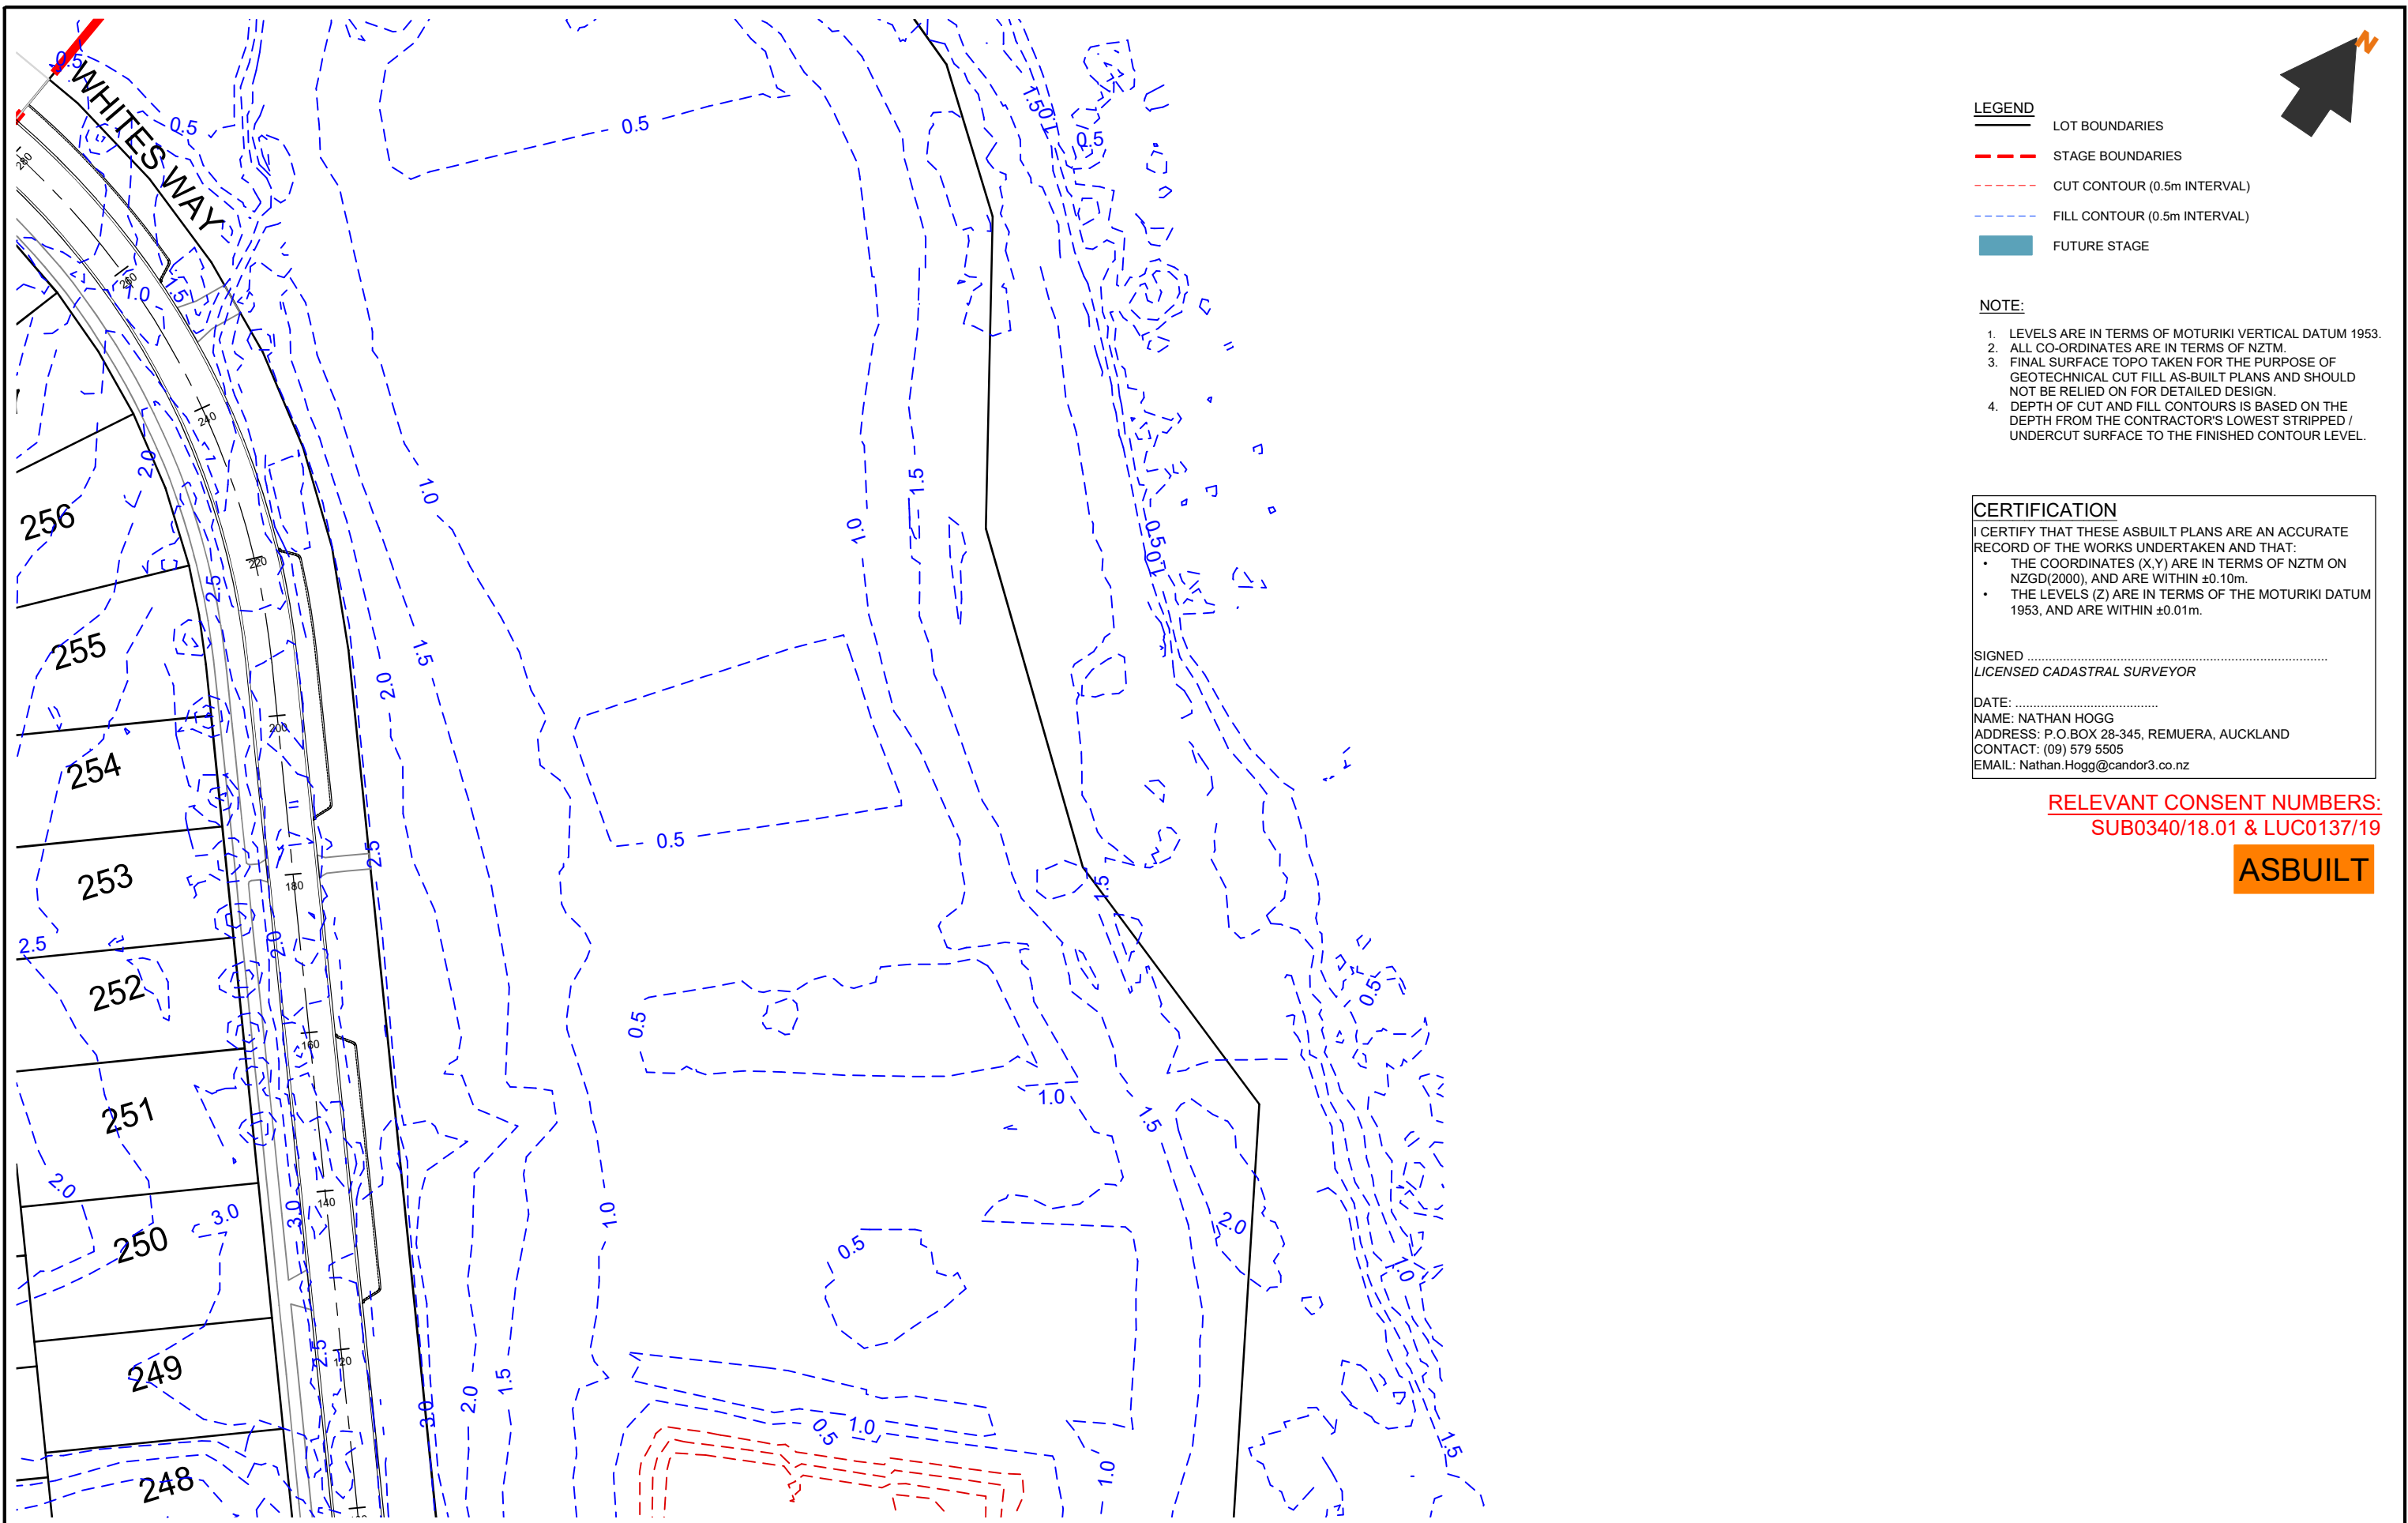

LEGEND

LOT BOUNDARIES

STAGE BOUNDARIES

CUT CONTOUR (0.5m INTERVAL)

FILL CONTOUR (0.5m INTERVAL)

FUTURE STAGE

- NOTE:
1. LEVELS ARE IN TERMS OF MOTURIKI VERTICAL DATUM 1953.

2. ALL CO-ORDINATES ARE IN TERMS OF NZTM.

3. FINAL SURFACE TOPO TAKEN FOR THE PURPOSE OF GEOTECHNICAL CUT FILL AS-BUILT PLANS AND SHOULD NOT BE RELIED ON FOR DETAILED DESIGN.

4. DEPTH OF CUT AND FILL CONTOURS IS BASED ON THE DEPTH FROM THE CONTRACTOR'S LOWEST STRIPPED / UNDERCUT SURFACE TO THE FINISHED CONTOUR LEVEL.

CERTIFICATION

I CERTIFY THAT THESE ASBUILT PLANS ARE AN ACCURATE RECORD OF THE WORKS UNDERTAKEN AND THAT:

- THE COORDINATES (X,Y) ARE IN TERMS OF NZTM ON NZGD(2000), AND ARE WITHIN ±0.10m.
- THE LEVELS (Z) ARE IN TERMS OF THE MOTURIKI DATUM 1953, AND ARE WITHIN ±0.01m.

SIGNED
LICENSED CADASTRAL SURVEYOR

DATE:
NAME: NATHAN HOGG
ADDRESS: P.O.BOX 28-345, REMUERA, AUCKLAND
CONTACT: (09) 579 5505
EMAIL: Nathan.Hogg@candor3.co.nz

RELEVANT CONSENT NUMBERS:
SUB0340/18.01 & LUC0137/19

ASBUILT

REV DESCRIPTION		BY	APPVD	DATE	PROJECT		CLIENT		PURPOSE		
					LAKESIDE, TE KAUWHATA		LAKESIDE		AS-BUILT		
					EARTHWORKS DEPTH CONTOURS STAGE 5		DEVELOPMENTS 2017		DESIGN JS	APPROVED BY NH	SCALE 1:750 @ A3
					SHEET 5 OF 6		LIMITED		CHECK AP	DATE DEC 2020	
									PROJECT NO.	DRAWING NO.	REV.
									1239	AB-2-304	-

