

LEGEND

- LOT BOUNDARIES
- STAGE BOUNDARIES
- EXISTING SURFACE CONTOUR MAJOR (1m INTERVAL)
- EXISTING SURFACE CONTOUR MINOR (0.5m INTERVAL)
- FUTURE STAGE

NOTE:

- LEVELS ARE IN TERMS OF MOTURIKI VERTICAL DATUM 1953.
- ALL CO-ORDINATES ARE IN TERMS OF NZTM.
- EXISTING SURFACE TOPO IS TAKEN FOR THE PURPOSE OF GEOTECHNICAL CUT FILL AS-BUILT PLANS AND SHOULD NOT BE RELIED ON FOR DETAILED DESIGN.
- EXISTING CONTOURS SHOWN ARE PRIOR TO STAGES 1 TO 7 EARTHWORKS STARTING. CONTOURS PROVIDED ARE CIRCA SEPTEMBER 2018.

CERTIFICATION

I CERTIFY THAT THESE ASBUILT PLANS ARE AN ACCURATE RECORD OF THE WORKS UNDERTAKEN AND THAT:

- THE COORDINATES (X,Y) ARE IN TERMS OF NZTM ON NZGD(2000), AND ARE WITHIN ±50mm.
- THE LEVELS (Z) ARE IN TERMS OF THE MOTURIKI DATUM 1953 LINZ DATUM, AND ARE WITHIN ±25mm.


SIGNED
LICENSED CADASTRAL SURVEYOR

DATE:
NAME: NATHAN HOGG
ADDRESS: P.O.BOX 28-345, REMUERA, AUCKLAND
CONTACT: (09) 579 5505
EMAIL: Nathan.Hogg@candor3.co.nz

RELEVANT CONSENT NUMBERS:
SUB0340/18.01 & LUC0137/19

ASBUILT

REV DESCRIPTION		BY	APPVD	DATE	PROJECT		CLIENT		PURPOSE		
					LAKESIDE, TE KAUWHATA		LAKESIDE		AS-BUILT		
					EARTHWORKS EXISTING SURFACE STAGE 3		DEVELOPMENTS 2017		DESIGN JS	APPROVED BY NH	SCALE 1:2500 @ A3
					SHEET 1 OF 2		LIMITED		CHECK RS	DATE MAY 2020	
									PROJECT NO.	DRAWING NO.	REV.
									1239	AB-2-100	-

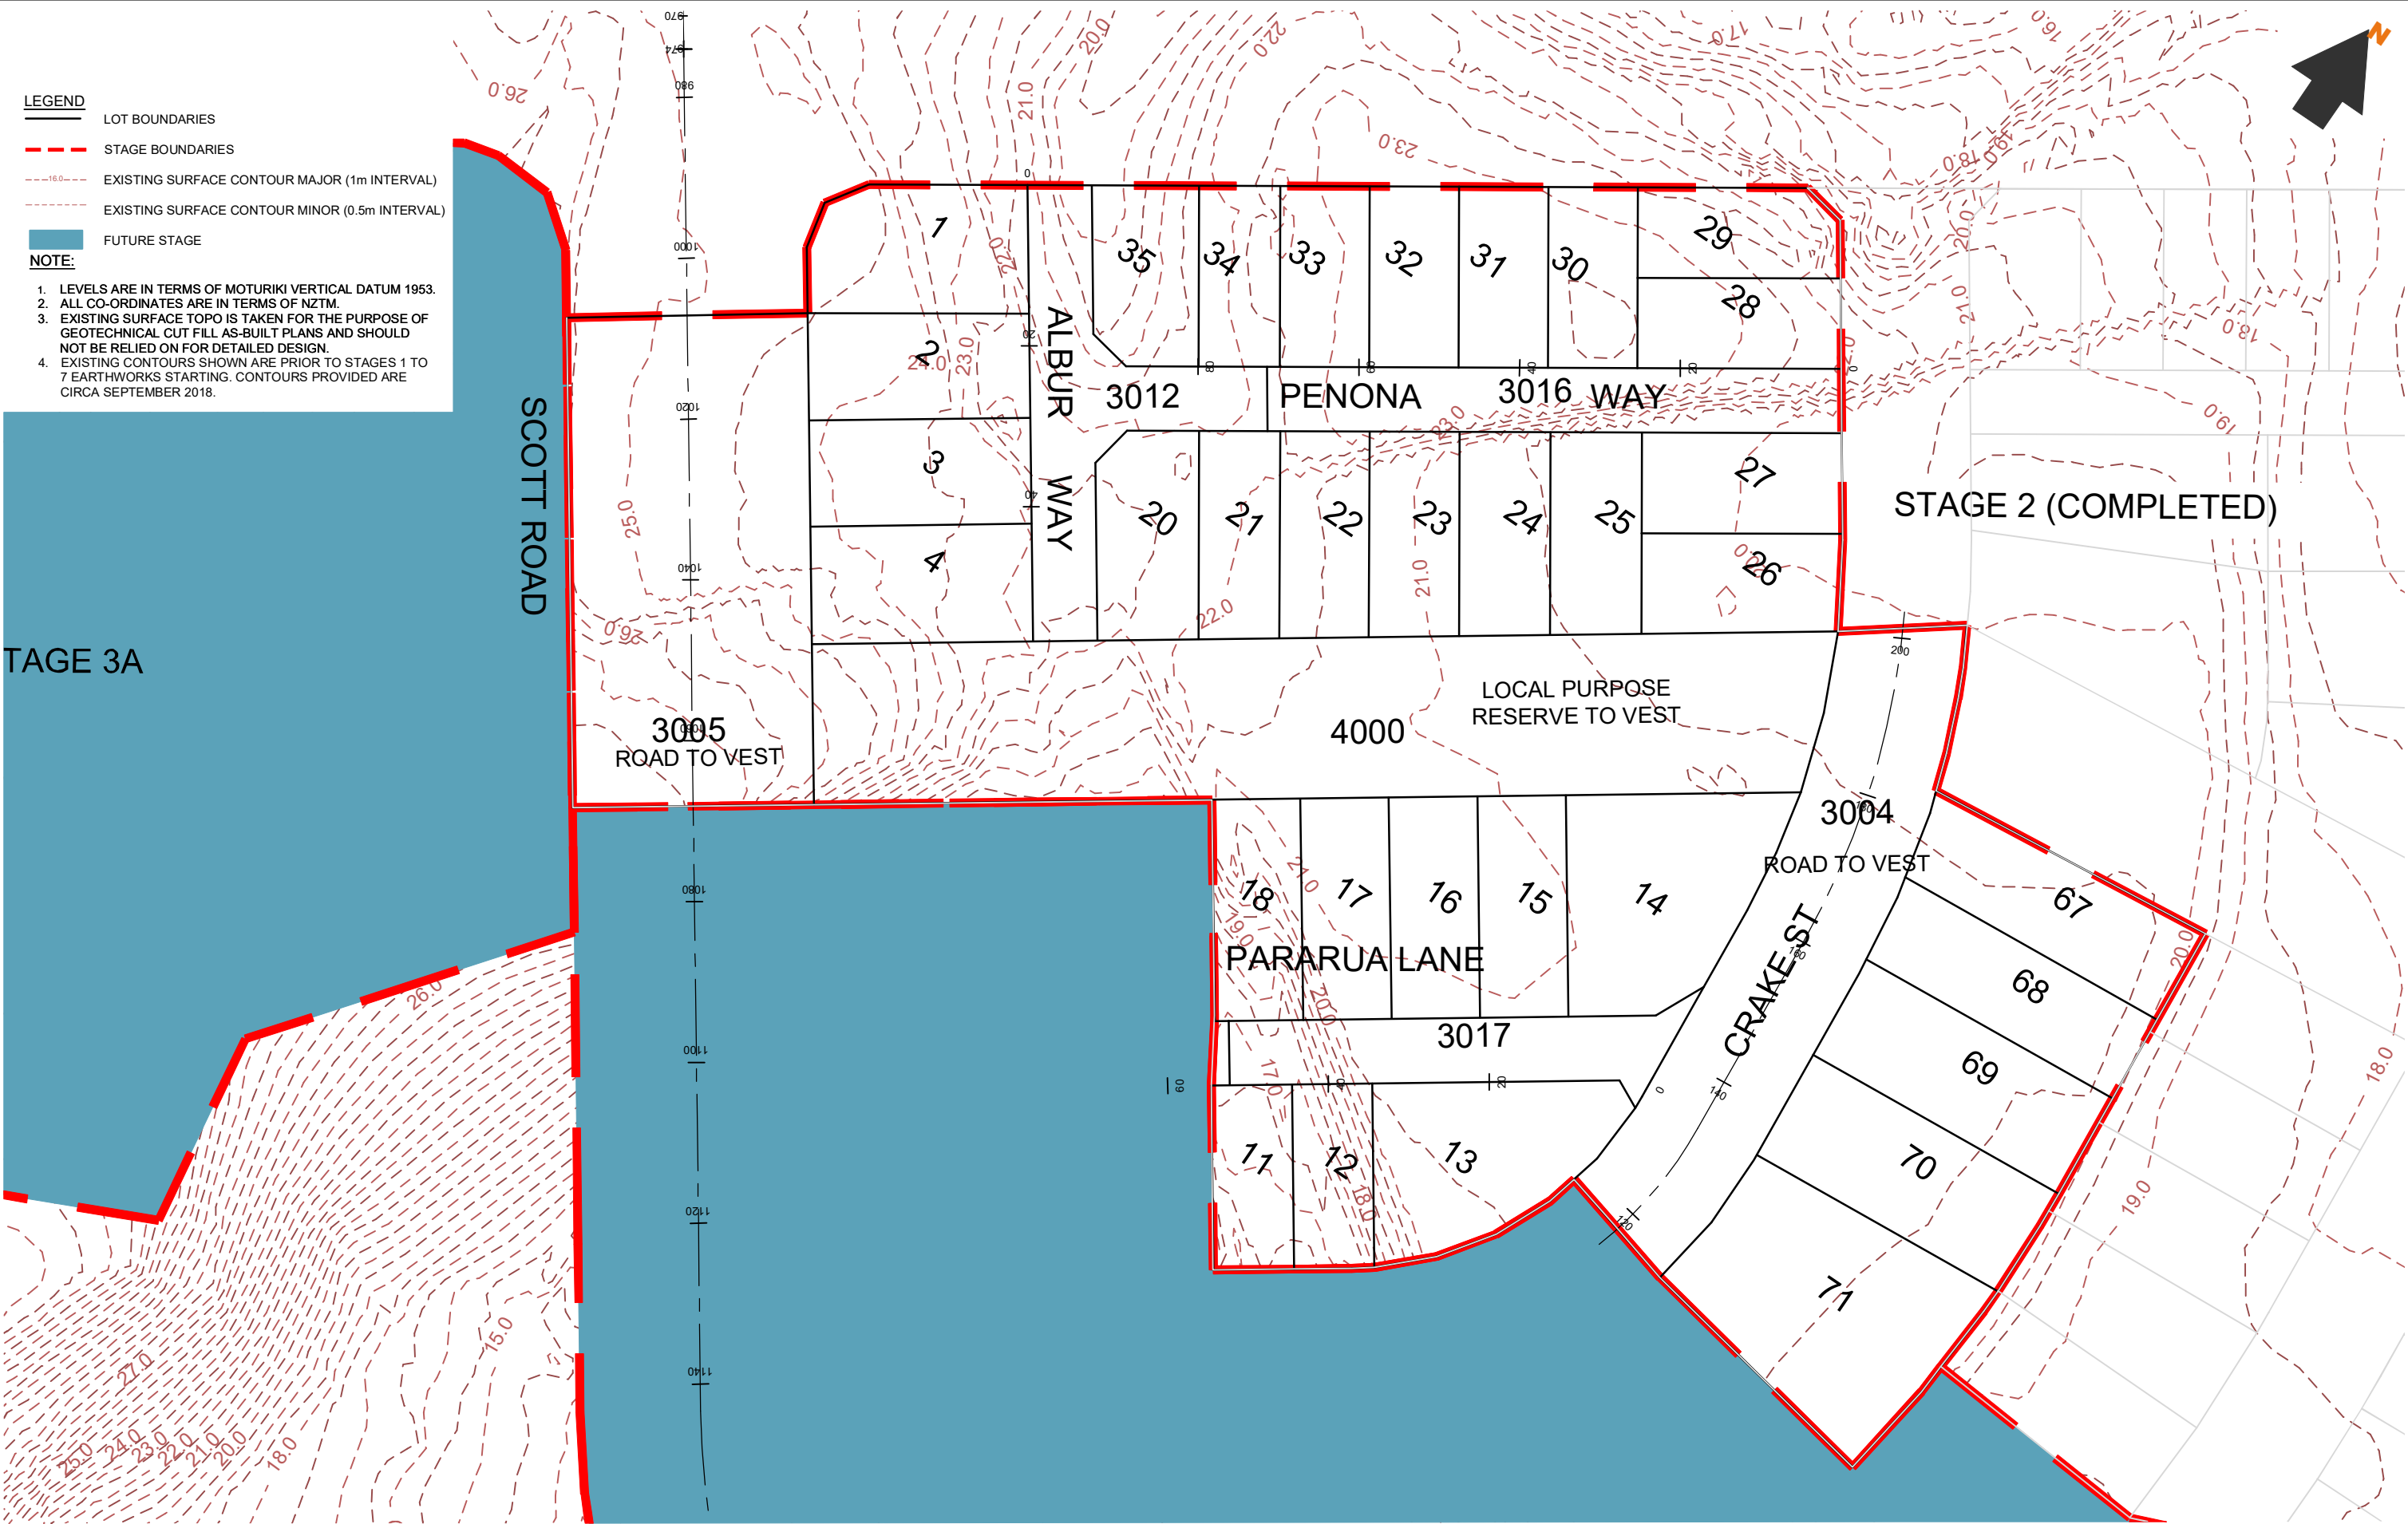

LEGEND


- LOT BOUNDARIES
- STAGE BOUNDARIES
- EXISTING SURFACE CONTOUR MAJOR (1m INTERVAL)
- EXISTING SURFACE CONTOUR MINOR (0.5m INTERVAL)
- FUTURE STAGE

NOTE:

- LEVELS ARE IN TERMS OF MOTURIKI VERTICAL DATUM 1953.
- ALL CO-ORDINATES ARE IN TERMS OF NZTM.
- EXISTING SURFACE TOPO IS TAKEN FOR THE PURPOSE OF GEOTECHNICAL CUT FILL AS-BUILT PLANS AND SHOULD NOT BE RELIED ON FOR DETAILED DESIGN.
- EXISTING CONTOURS SHOWN ARE PRIOR TO STAGES 1 TO 7 EARTHWORKS STARTING. CONTOURS PROVIDED ARE CIRCA SEPTEMBER 2018.

REV DESCRIPTION		BY APPVD DATE	PROJECT		CLIENT	PURPOSE		
			LAKESIDE, TE KAUWHATA		LAKESIDE DEVELOPMENTS 2017 LIMITED	AS-BUILT		
			EARTHWORKS EXISTING SURFACE STAGE 3			DESIGN JS	APPROVED BY NH	SCALE 1:750 @ A3
			SHEET 2 OF 2			CHECK RS	DATE MAY 2020	
						PROJECT NO.	DRAWING NO.	REV.
						1239	AB-2-101	-



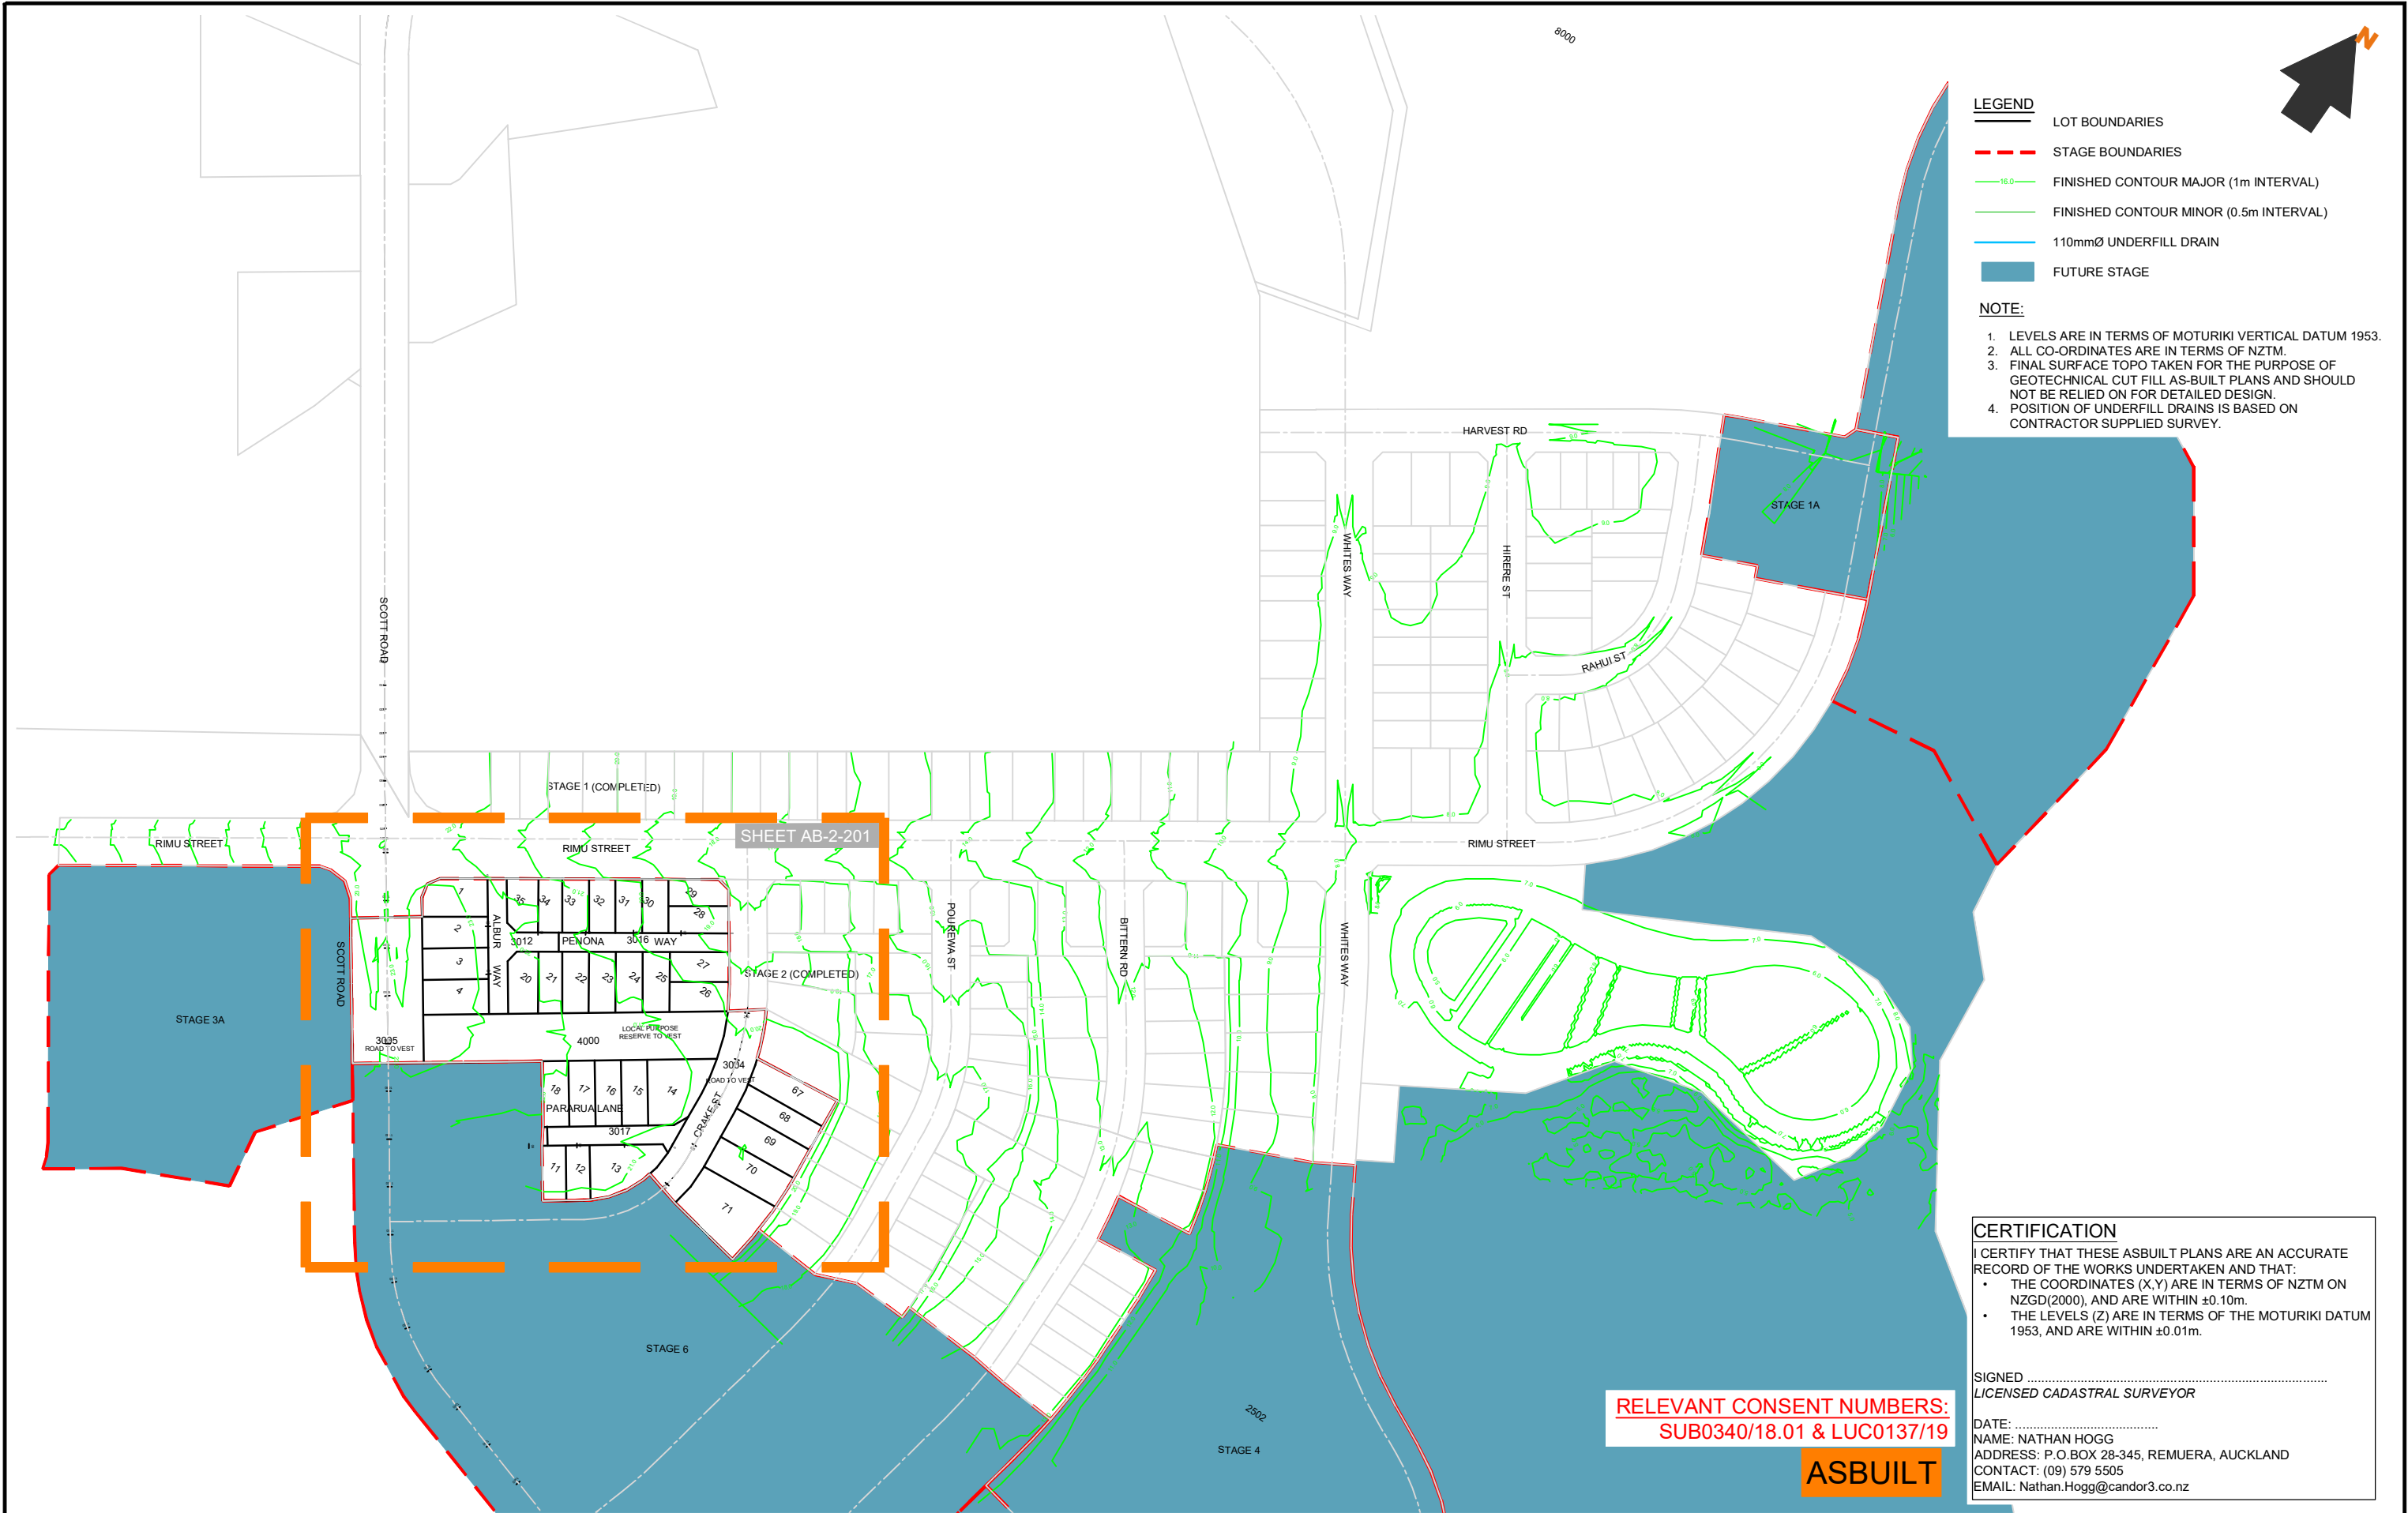

- LEGEND**
- LOT BOUNDARIES
 - STAGE BOUNDARIES
 - FINISHED CONTOUR MAJOR (1m INTERVAL)
 - FINISHED CONTOUR MINOR (0.5m INTERVAL)
 - 110mmØ UNDERFILL DRAIN
 - FUTURE STAGE

- NOTE:**
- LEVELS ARE IN TERMS OF MOTURIKI VERTICAL DATUM 1953.
 - ALL CO-ORDINATES ARE IN TERMS OF NZTM.
 - FINAL SURFACE TOPO TAKEN FOR THE PURPOSE OF GEOTECHNICAL CUT FILL AS-BUILT PLANS AND SHOULD NOT BE RELIED ON FOR DETAILED DESIGN.
 - POSITION OF UNDERFILL DRAINS IS BASED ON CONTRACTOR SUPPLIED SURVEY.

CERTIFICATION

I CERTIFY THAT THESE ASBUILT PLANS ARE AN ACCURATE RECORD OF THE WORKS UNDERTAKEN AND THAT:

- THE COORDINATES (X,Y) ARE IN TERMS OF NZTM ON NZGD(2000), AND ARE WITHIN ±0.10m.
- THE LEVELS (Z) ARE IN TERMS OF THE MOTURIKI DATUM 1953, AND ARE WITHIN ±0.01m.

SIGNED
LICENSED CADASTRAL SURVEYOR

DATE:
NAME: NATHAN HOGG
ADDRESS: P.O.BOX 28-345, REMUERA, AUCKLAND
CONTACT: (09) 579 5505
EMAIL: Nathan.Hogg@candor3.co.nz

RELEVANT CONSENT NUMBERS:
SUB0340/18.01 & LUC0137/19

ASBUILT

REV DESCRIPTION		BY	APPVD	DATE	PROJECT		CLIENT		PURPOSE		
					LAKESIDE, TE KAUWHATA		LAKESIDE		AS-BUILT		
					EARTHWORKS FINISHED SURFACE STAGE 2		DEVELOPMENTS 2017		DESIGN JS	APPROVED BY NH	SCALE 1:2500 @ A3
					SHEET 1 OF 2		LIMITED		CHECK RS	DATE MAY 2020	
									PROJECT NO.	DRAWING NO.	REV.
									1239	AB-2-200	-

LEGEND

- LOT BOUNDARIES
- STAGE BOUNDARIES
- FINISHED CONTOUR MAJOR (1m INTERVAL)
- FINISHED CONTOUR MINOR (0.5m INTERVAL)
- 110mmØ UNDERFILL DRAIN
- FUTURE STAGE

NOTE:

- LEVELS ARE IN TERMS OF MOTURIKI VERTICAL DATUM 1953.
- ALL CO-ORDINATES ARE IN TERMS OF NZTM.
- FINAL SURFACE TOPO TAKEN FOR THE PURPOSE OF GEOTECHNICAL CUT FILL AS-BUILT PLANS AND SHOULD NOT BE RELIED ON FOR DETAILED DESIGN.
- POSITION OF UNDERFILL DRAINS IS BASED ON CONTRACTOR SUPPLIED SURVEY.

CERTIFICATION

I CERTIFY THAT THESE ASBUILT PLANS ARE AN ACCURATE RECORD OF THE WORKS UNDERTAKEN AND THAT:


- THE COORDINATES (X,Y) ARE IN TERMS OF NZTM ON NZGD(2000), AND ARE WITHIN ±0.10m.
- THE LEVELS (Z) ARE IN TERMS OF THE MOTURIKI DATUM 1953, AND ARE WITHIN ±0.01m.

SIGNED
LICENSED CADASTRAL SURVEYOR


DATE:
NAME: NATHAN HOGG
ADDRESS: P.O.BOX 28-345, REMUERA, AUCKLAND
CONTACT: (09) 579 5505
EMAIL: Nathan.Hogg@candor3.co.nz

RELEVANT CONSENT NUMBERS:
SUB0340/18.01 & LUC0137/19

ASBUILT

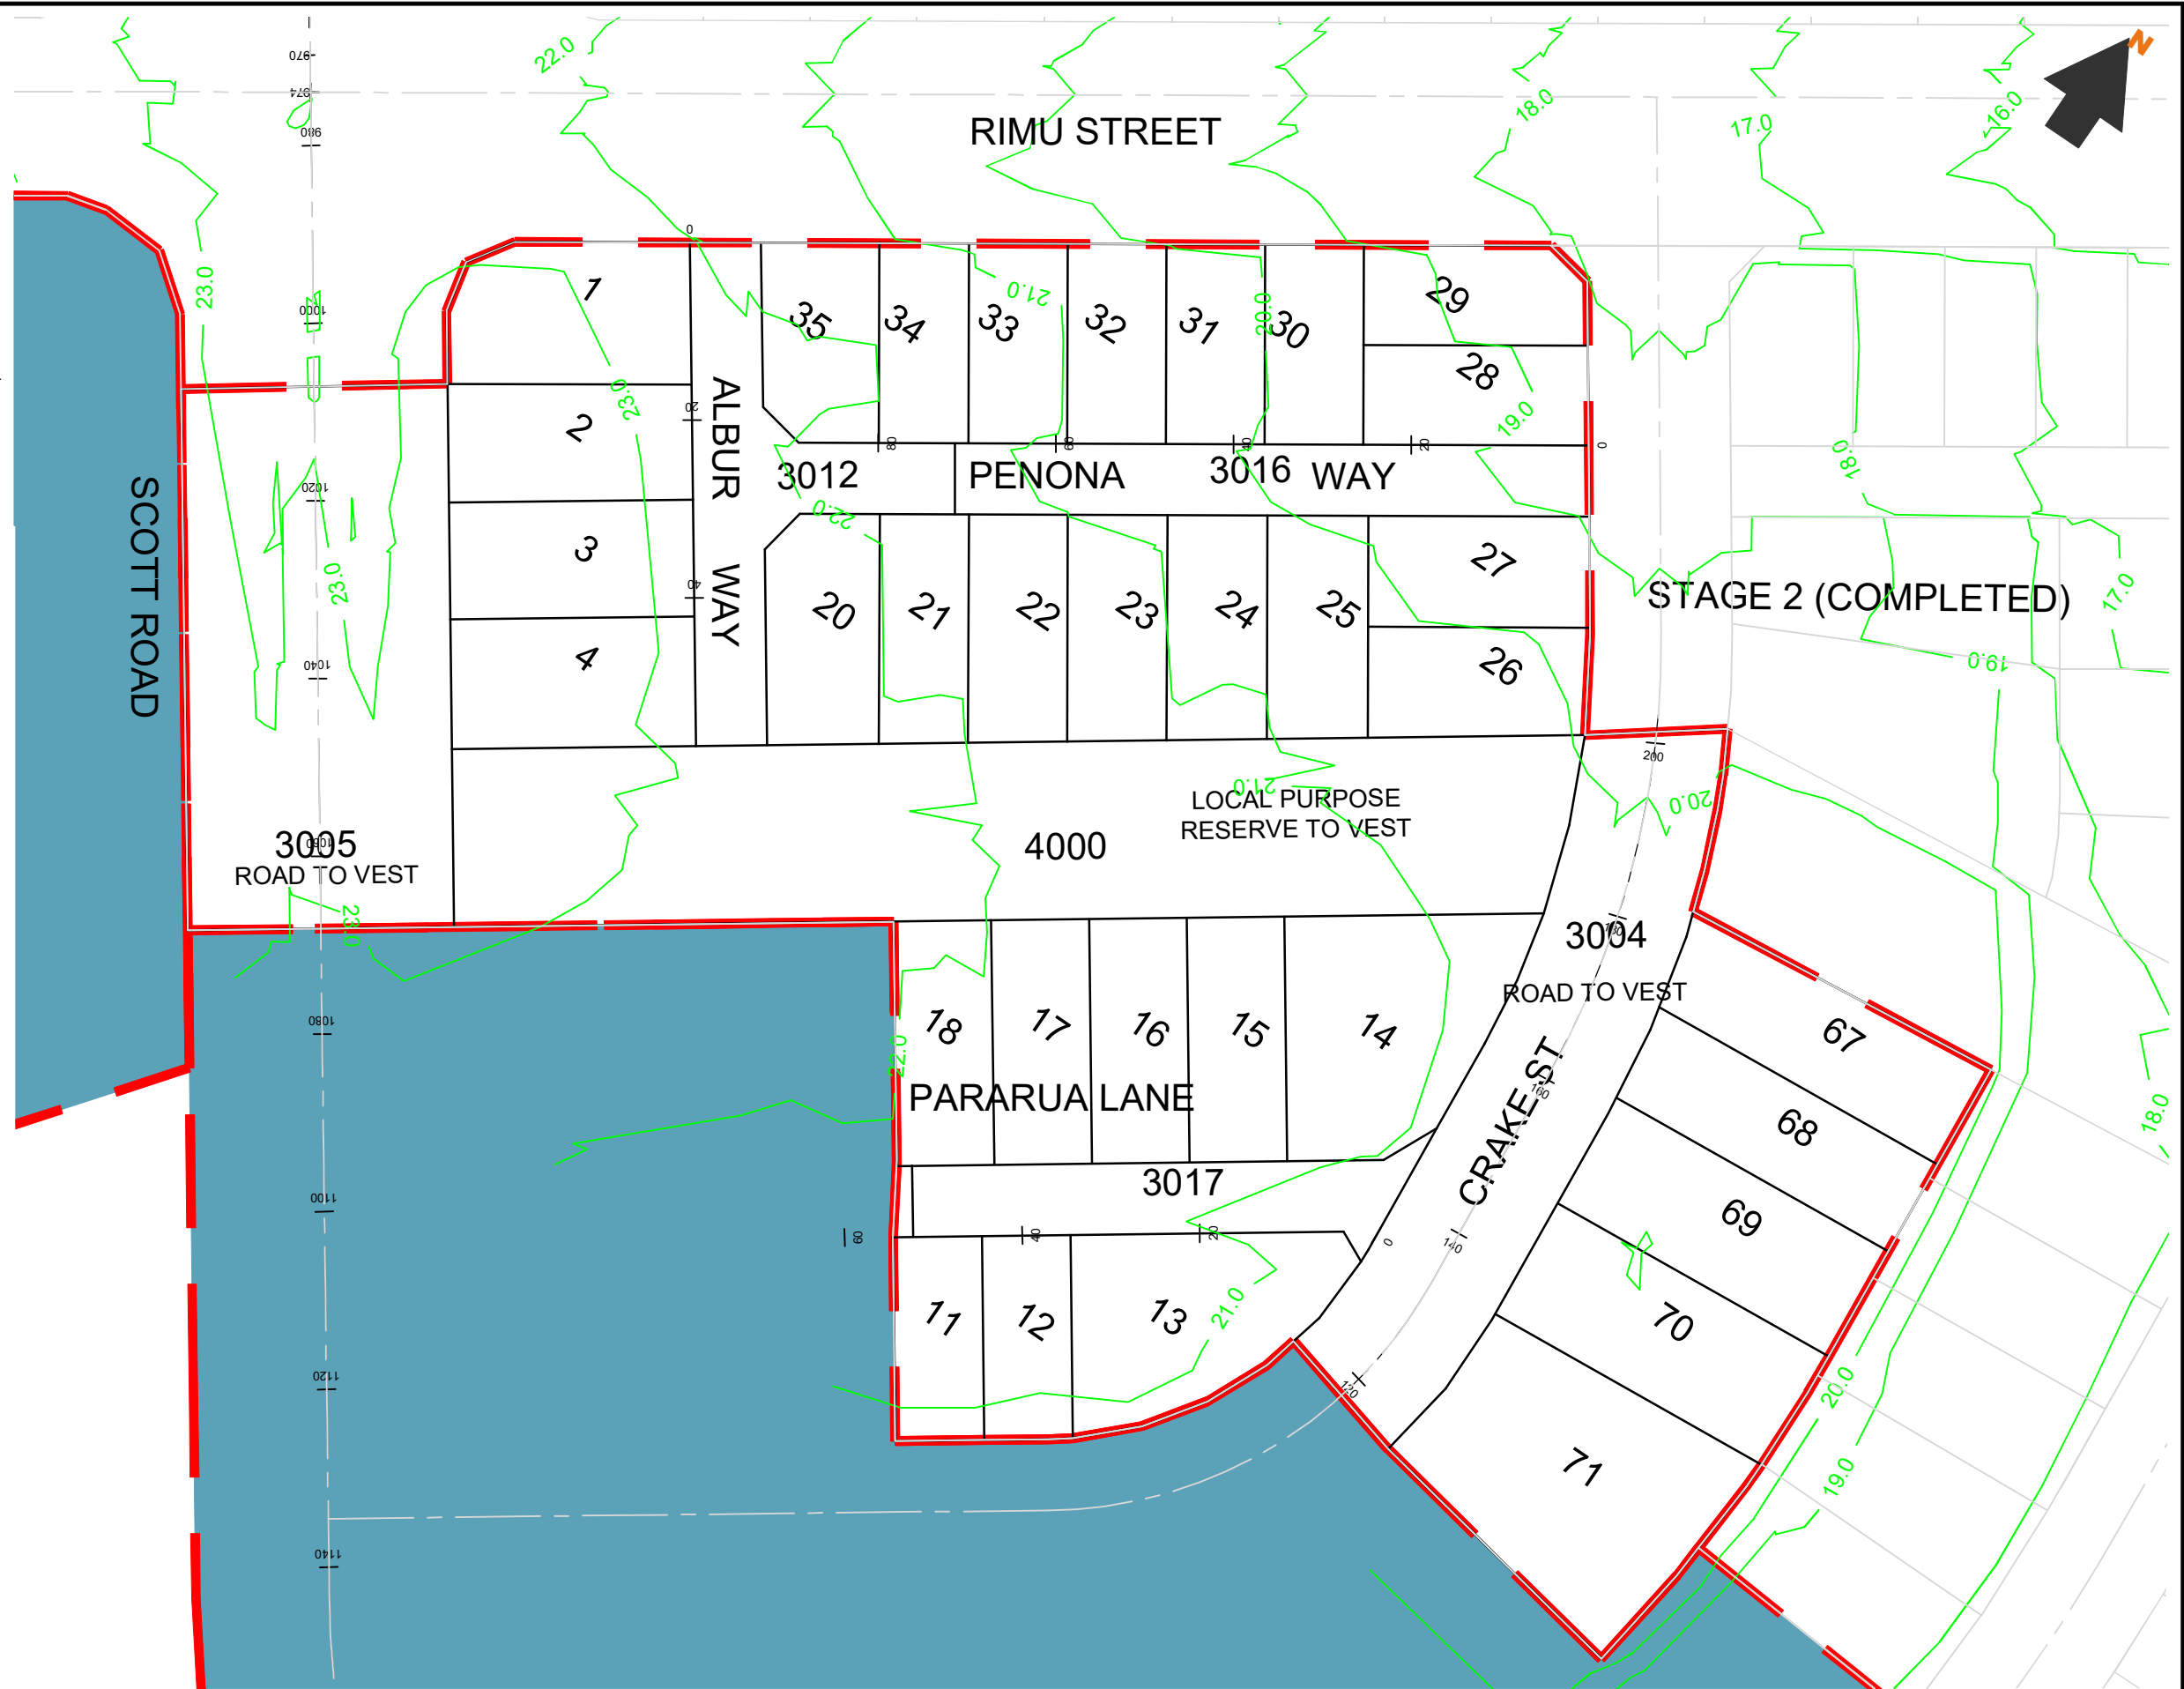

REV DESCRIPTION		BY	APPVD	DATE	<div>Candor³</div> <div>ENGINEERING FOR LIFE</div>	PROJECT	LAKESIDE, TE KAUWHATA EARTHWORKS FINISHED SURFACE STAGE 2 SHEET 2 OF 2	CLIENT	LAKESIDE DEVELOPMENTS 2017 LIMITED	PURPOSE AS-BUILT			
											DESIGN JS DRAWN JS CHECK RS	APPROVED BY NH DATE MAY 2020	SCALE 1:750 @ A3
											PROJECT NO.	DRAWING NO.	REV.
											1239	AB-2-201	-

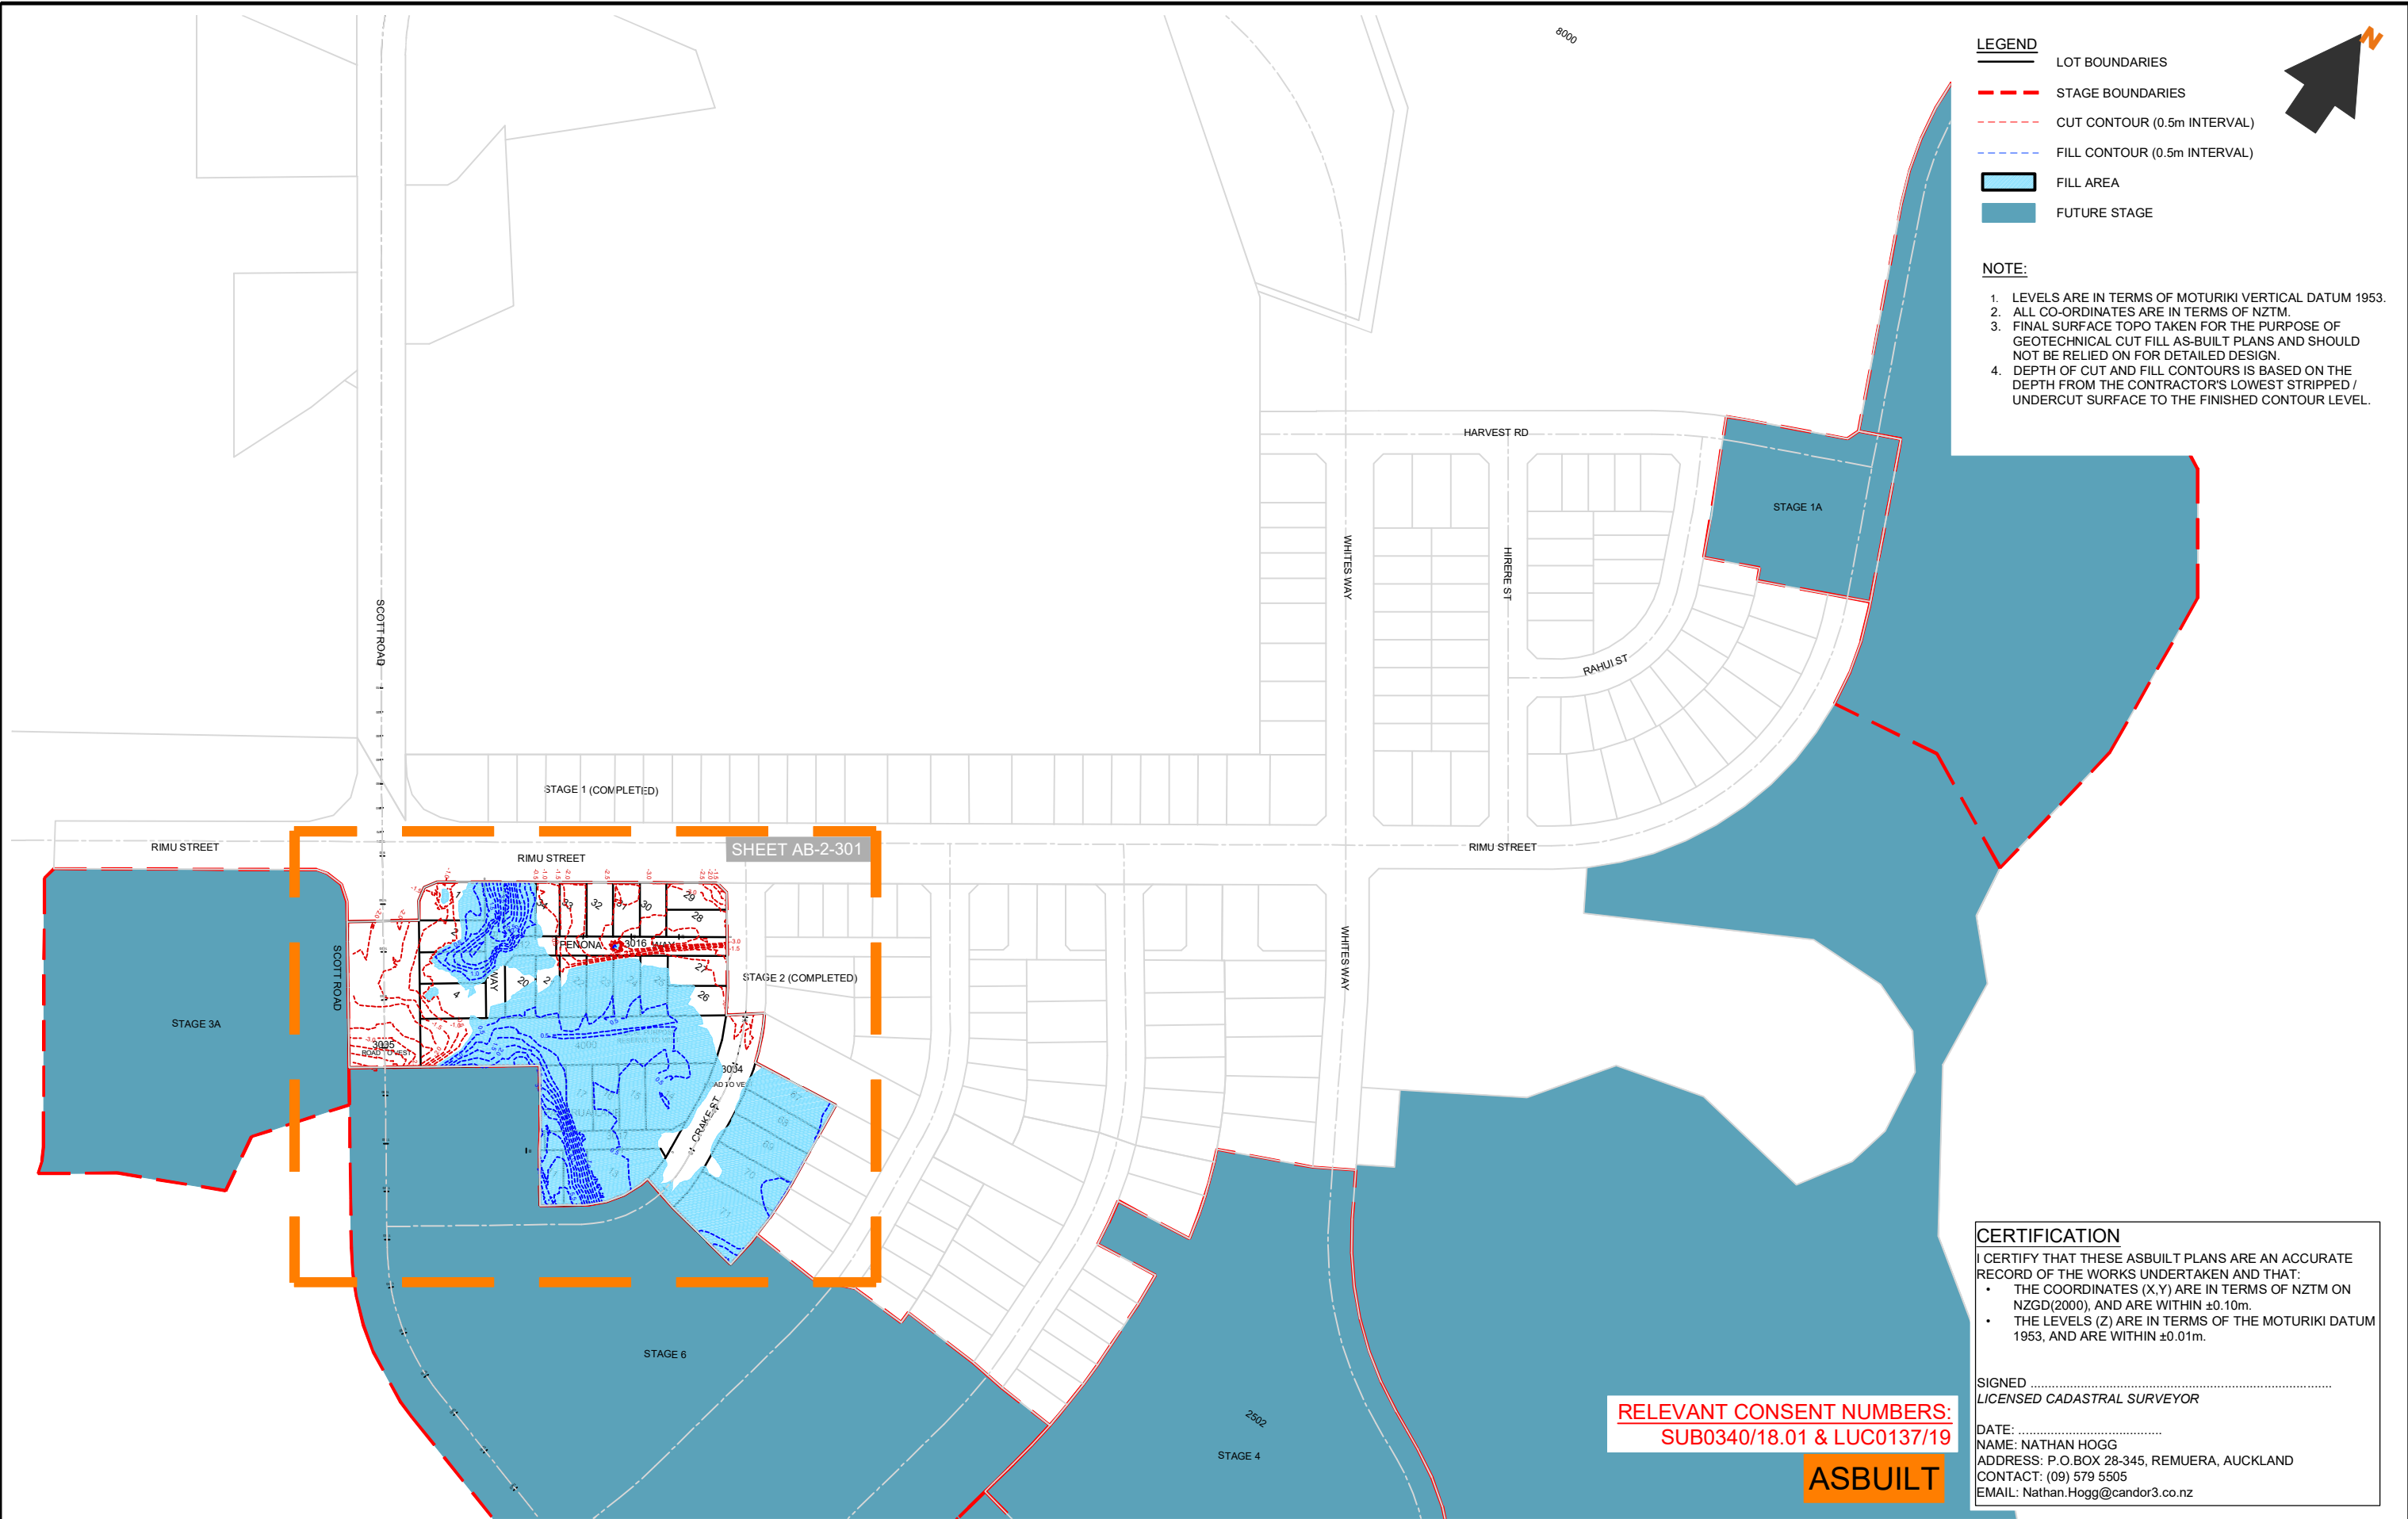

LEGEND

LOT BOUNDARIES

STAGE BOUNDARIES

CUT CONTOUR (0.5m INTERVAL)

FILL CONTOUR (0.5m INTERVAL)

FILL AREA

FUTURE STAGE

- NOTE:
1. LEVELS ARE IN TERMS OF MOTURIKI VERTICAL DATUM 1953.

2. ALL CO-ORDINATES ARE IN TERMS OF NZTM.

3. FINAL SURFACE TOPO TAKEN FOR THE PURPOSE OF GEOTECHNICAL CUT FILL AS-BUILT PLANS AND SHOULD NOT BE RELIED ON FOR DETAILED DESIGN.

4. DEPTH OF CUT AND FILL CONTOURS IS BASED ON THE DEPTH FROM THE CONTRACTOR'S LOWEST STRIPPED / UNDERCUT SURFACE TO THE FINISHED CONTOUR LEVEL.

CERTIFICATION

I CERTIFY THAT THESE ASBUILT PLANS ARE AN ACCURATE RECORD OF THE WORKS UNDERTAKEN AND THAT:

- THE COORDINATES (X,Y) ARE IN TERMS OF NZTM ON NZGD(2000), AND ARE WITHIN ±0.10m.
- THE LEVELS (Z) ARE IN TERMS OF THE MOTURIKI DATUM 1953, AND ARE WITHIN ±0.01m.

SIGNED
LICENSED CADASTRAL SURVEYOR

DATE:
NAME: NATHAN HOGG
ADDRESS: P.O.BOX 28-345, REMUERA, AUCKLAND
CONTACT: (09) 579 5505
EMAIL: Nathan.Hogg@candor3.co.nz

RELEVANT CONSENT NUMBERS:
SUB0340/18.01 & LUC0137/19

ASBUILT

REV DESCRIPTION		BY	APPVD	DATE	PROJECT		CLIENT		PURPOSE		
					LAKESIDE, TE KAUWHATA		LAKESIDE		AS-BUILT		
					EARTHWORKS DEPTH CONTOURS STAGE 3		DEVELOPMENTS 2017		DESIGN JS	APPROVED BY JFG	SCALE 1:2500 @ A3
					SHEET 1 OF 2		LIMITED		CHECK JFG	DATE MAY 2020	
									PROJECT NO.	DRAWING NO.	REV.
									1239	AB-2-300	-

- LEGEND**
- LOT BOUNDARIES
 - STAGE BOUNDARIES
 - CUT CONTOUR (0.5m INTERVAL)
 - FILL CONTOUR (0.5m INTERVAL)
 - FILL AREA
 - FUTURE STAGE

- NOTE:**
- LEVELS ARE IN TERMS OF MOTURIKI VERTICAL DATUM 1953.
 - ALL CO-ORDINATES ARE IN TERMS OF NZTM.
 - FINAL SURFACE TOPO TAKEN FOR THE PURPOSE OF GEOTECHNICAL CUT FILL AS-BUILT PLANS AND SHOULD NOT BE RELIED ON FOR DETAILED DESIGN.
 - DEPTH OF CUT AND FILL CONTOURS IS BASED ON THE DEPTH FROM THE CONTRACTOR'S LOWEST STRIPPED / UNDERCUT SURFACE TO THE FINISHED CONTOUR LEVEL.

CERTIFICATION

I CERTIFY THAT THESE ASBUILT PLANS ARE AN ACCURATE RECORD OF THE WORKS UNDERTAKEN AND THAT:


- THE COORDINATES (X,Y) ARE IN TERMS OF NZTM ON NZGD(2000), AND ARE WITHIN ±0.10m.
- THE LEVELS (Z) ARE IN TERMS OF THE MOTURIKI DATUM 1953, AND ARE WITHIN ±0.01m.

SIGNED
LICENSED CADASTRAL SURVEYOR

DATE:
NAME: NATHAN HOGG
ADDRESS: P.O.BOX 28-345, REMUERA, AUCKLAND
CONTACT: (09) 579 5505
EMAIL: Nathan.Hogg@candor3.co.nz

RELEVANT CONSENT NUMBERS:
SUB0340/18.01 & LUC0137/19

ASBUILT

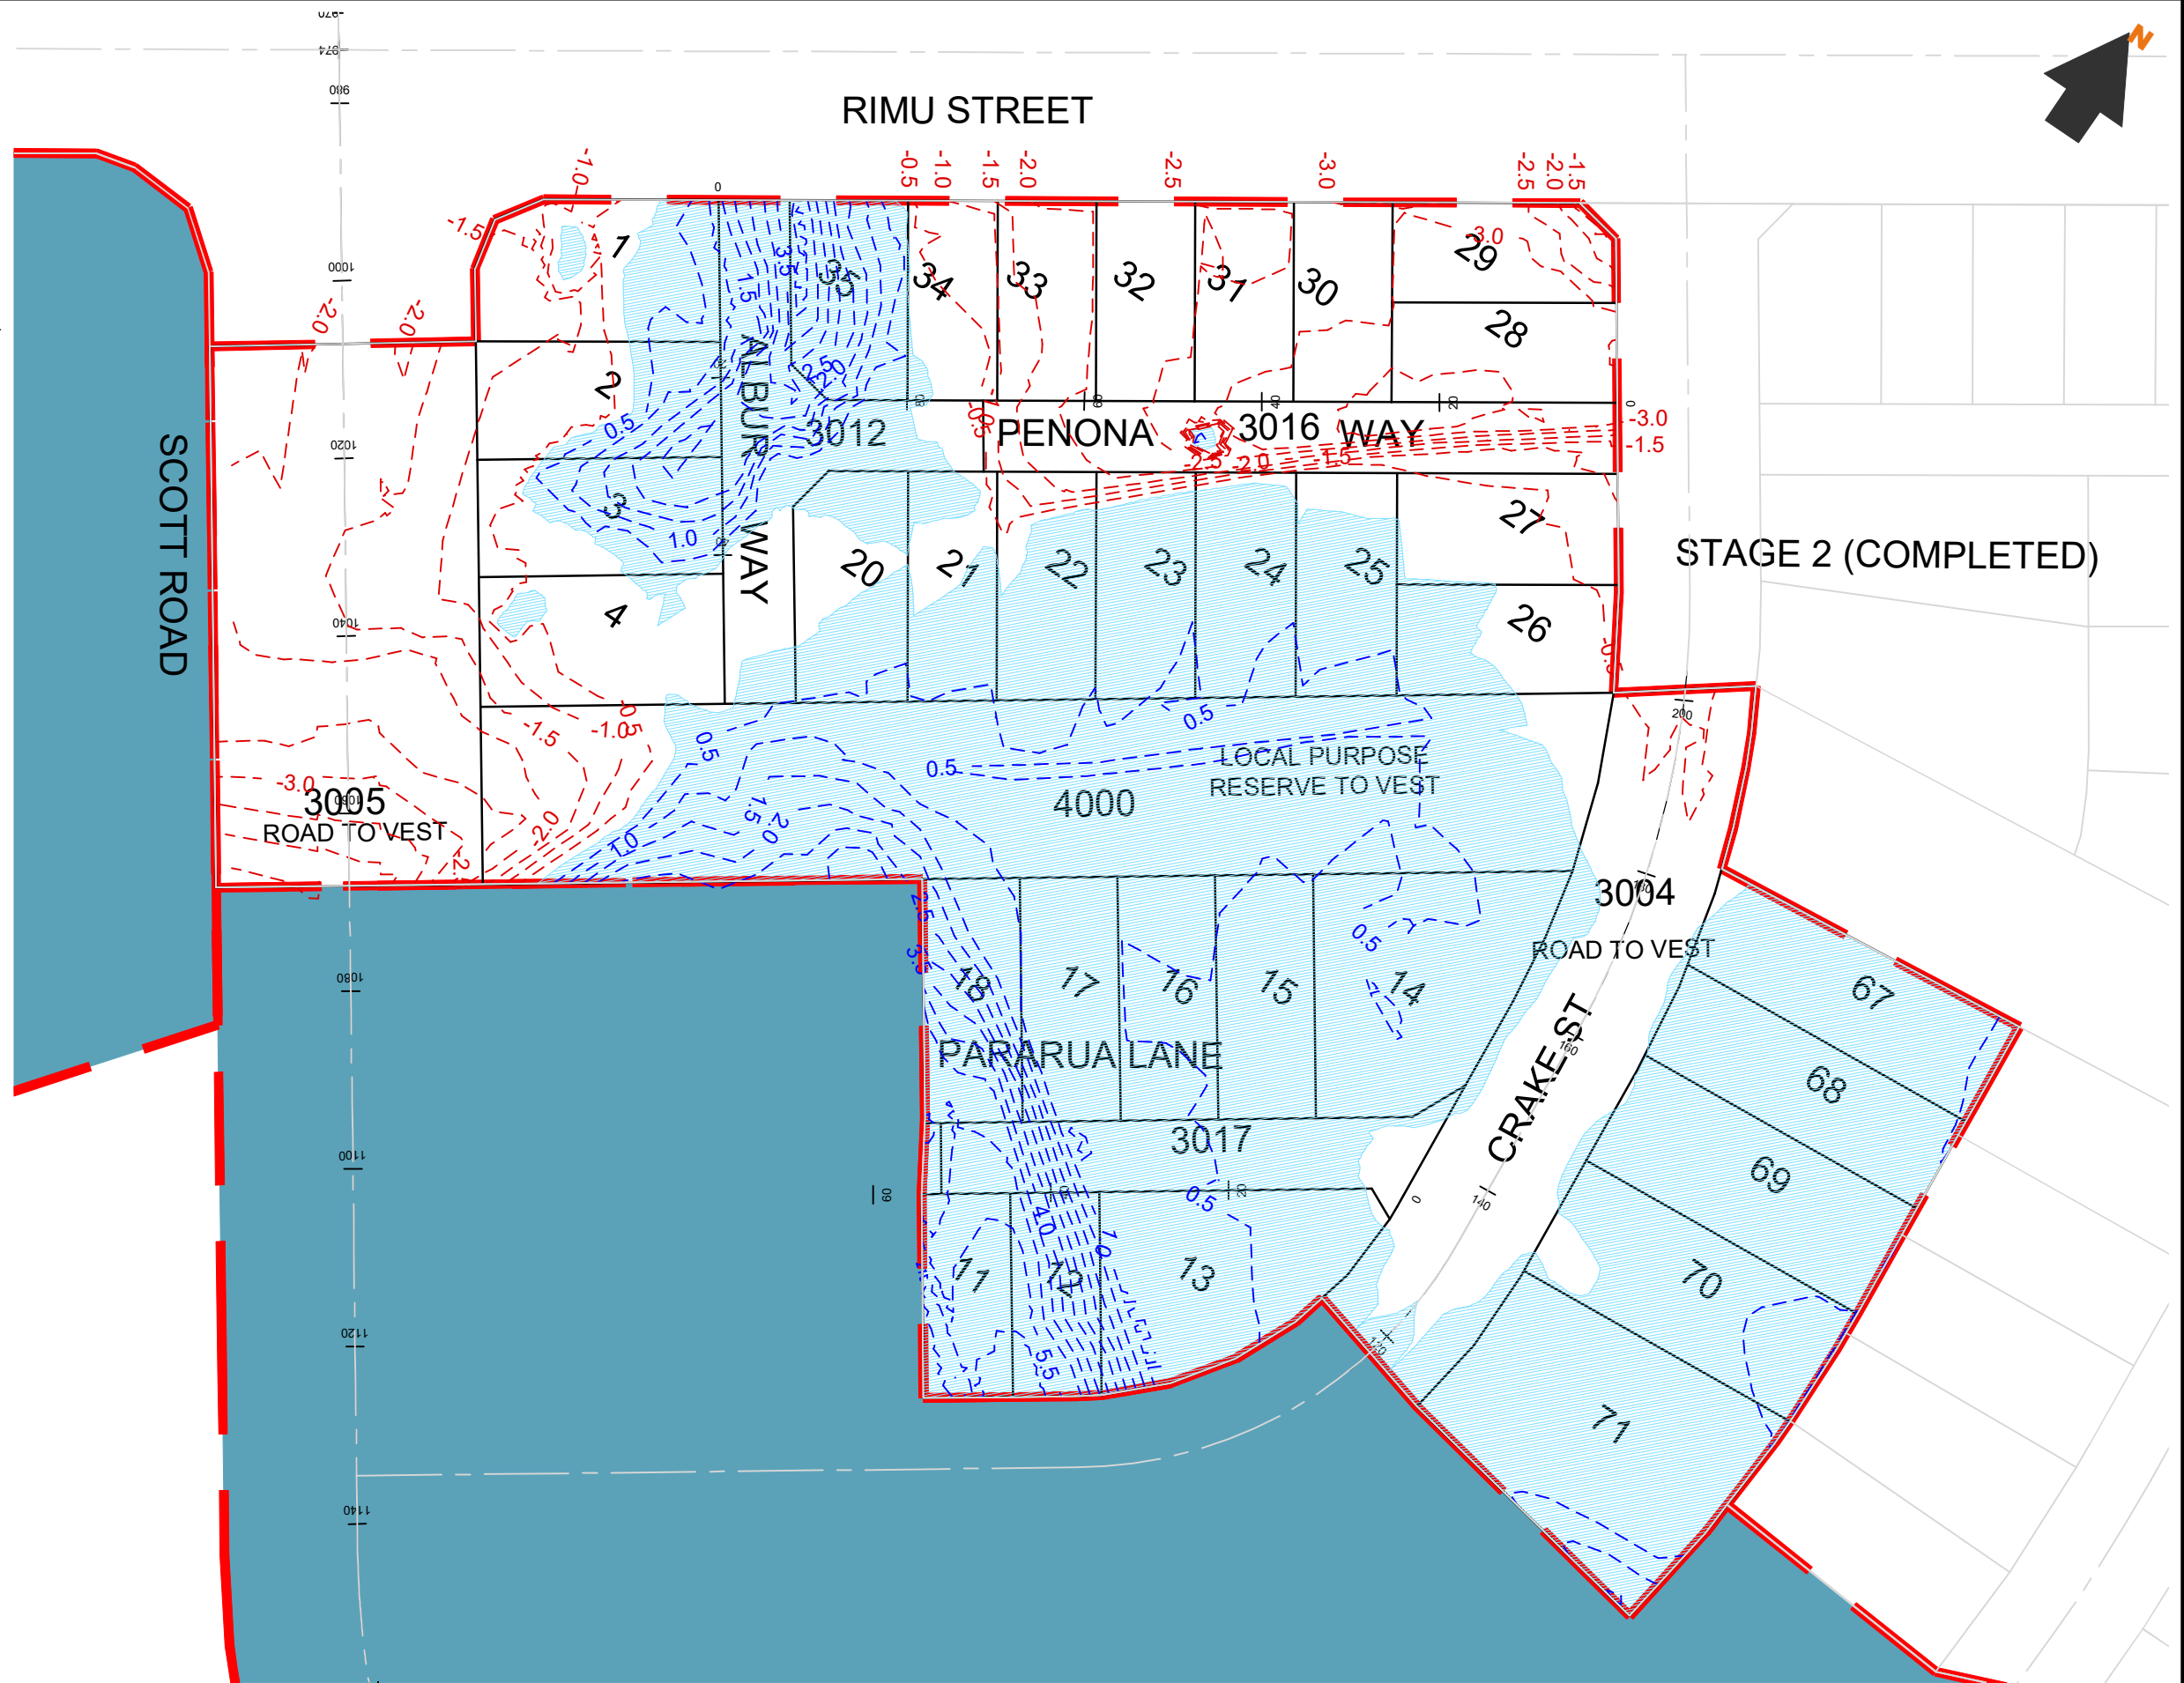

REV DESCRIPTION		BY	APPVD	DATE	PROJECT		CLIENT		PURPOSE			
<div>Candor³</div> <div>ENGINEERING FOR LIFE</div>					LAKESIDE, TE KAUWHATA EARTHWORKS DEPTH CONTOURS STAGE 3 SHEET 2 OF 2		LAKESIDE DEVELOPMENTS 2017 LIMITED		AS-BUILT			
									DESIGN DRAWN CHECK	JS JS JFG	APPROVED BY JFG DATE MAY 2020	SCALE 1:750 @ A3
									PROJECT NO. 1239		DRAWING NO. AB-2-301	