

LEGEND

- LOT BOUNDARIES
- STAGE BOUNDARIES
- ROAD CENTRELINE
- NEW WASTEWATER PIPE
- NEW WASTEWATER LOT CONNECTION (11.8m @ CH63.37)
- EXISTING WASTEWATER PIPE
- ABANDONED WASTEWATER PIPE
- WASTEWATER MANHOLE EXISTING / NEW / ABANDONED
- FUTURE STAGE

- NOTES**
- ALL WORKS AND MATERIALS COMPLY WITH THE WAIKATO LOCAL AUTHORITY SHARED SERVICES REGIONAL INFRASTRUCTURE TECHNICAL SPECIFICATIONS (RITS) (MAY 2018).
 - MANHOLES ARE 1050mm Ø CONCRETE MANHOLES UNLESS OTHERWISE NOTED.
 - PIPE CROSSINGS UNDER ROADS AND ACCESSWAYS HAVE BEEN HARDFILL BACKFILLED.
 - LEVELS ARE IN TERMS OF THE MOTURIKI DATUM 1953.
 - ALL CO-ORDINATES ARE IN TERMS OF NZTM.
 - ALL WASTEWATER (SS) PIPES ARE 150mm Ø u-PVC SN16, UNLESS STATED OTHERWISE.

CERTIFICATION

I CERTIFY THAT THESE ASBUILT PLANS ARE AN ACCURATE RECORD OF THE WORKS UNDERTAKEN AND THAT:

- THE COORDINATES (X,Y) ARE IN TERMS OF NZTM ON NZGD(2000), AND ARE WITHIN ±0.10m.
- THE LEVELS (Z) ARE IN TERMS OF THE MOTURIKI DATUM 1953, AND ARE WITHIN ±0.01m.

SIGNED
LICENSED CADASTRAL SURVEYOR


DATE:
NAME: NATHAN HOGG
ADDRESS: P.O.BOX 28-345, REMUERA, AUCKLAND
CONTACT: (09) 579 5505
EMAIL: Nathan.Hogg@candor3.co.nz

RELEVANT CONSENT NUMBERS:
SUB0340/18.01 & LUC0137/19

ASBUILT

<div>REV DESCRIPTION</div>					<div>BY APPVD DATE</div>		<div>Candor³</div> <div>ENGINEERING FOR LIFE</div>		<div>PROJECT</div> <div>LAKESIDE, TE KAUPHATA WASTEWATER LAYOUT STAGE 5 1 OF 6</div>		<div>CLIENT</div> <div>LAKESIDE DEVELOPMENTS 2017 LIMITED</div>		<div>PURPOSE</div> <div>AS-BUILT</div>		
<div>DESIGN JS</div> <div>DRAWN JS</div> <div>CHECK AP</div>					<div>APPROVED</div> <div>BY NH</div> <div>DATE DEC 2020</div>		<div>SCALE</div> <div>1:2500 @ A3</div>								
<div>PROJECT NO.</div> <div>1239</div>					<div>DRAWING NO.</div> <div>AB-5-100</div>					<div>REV.</div> <div>-</div>					



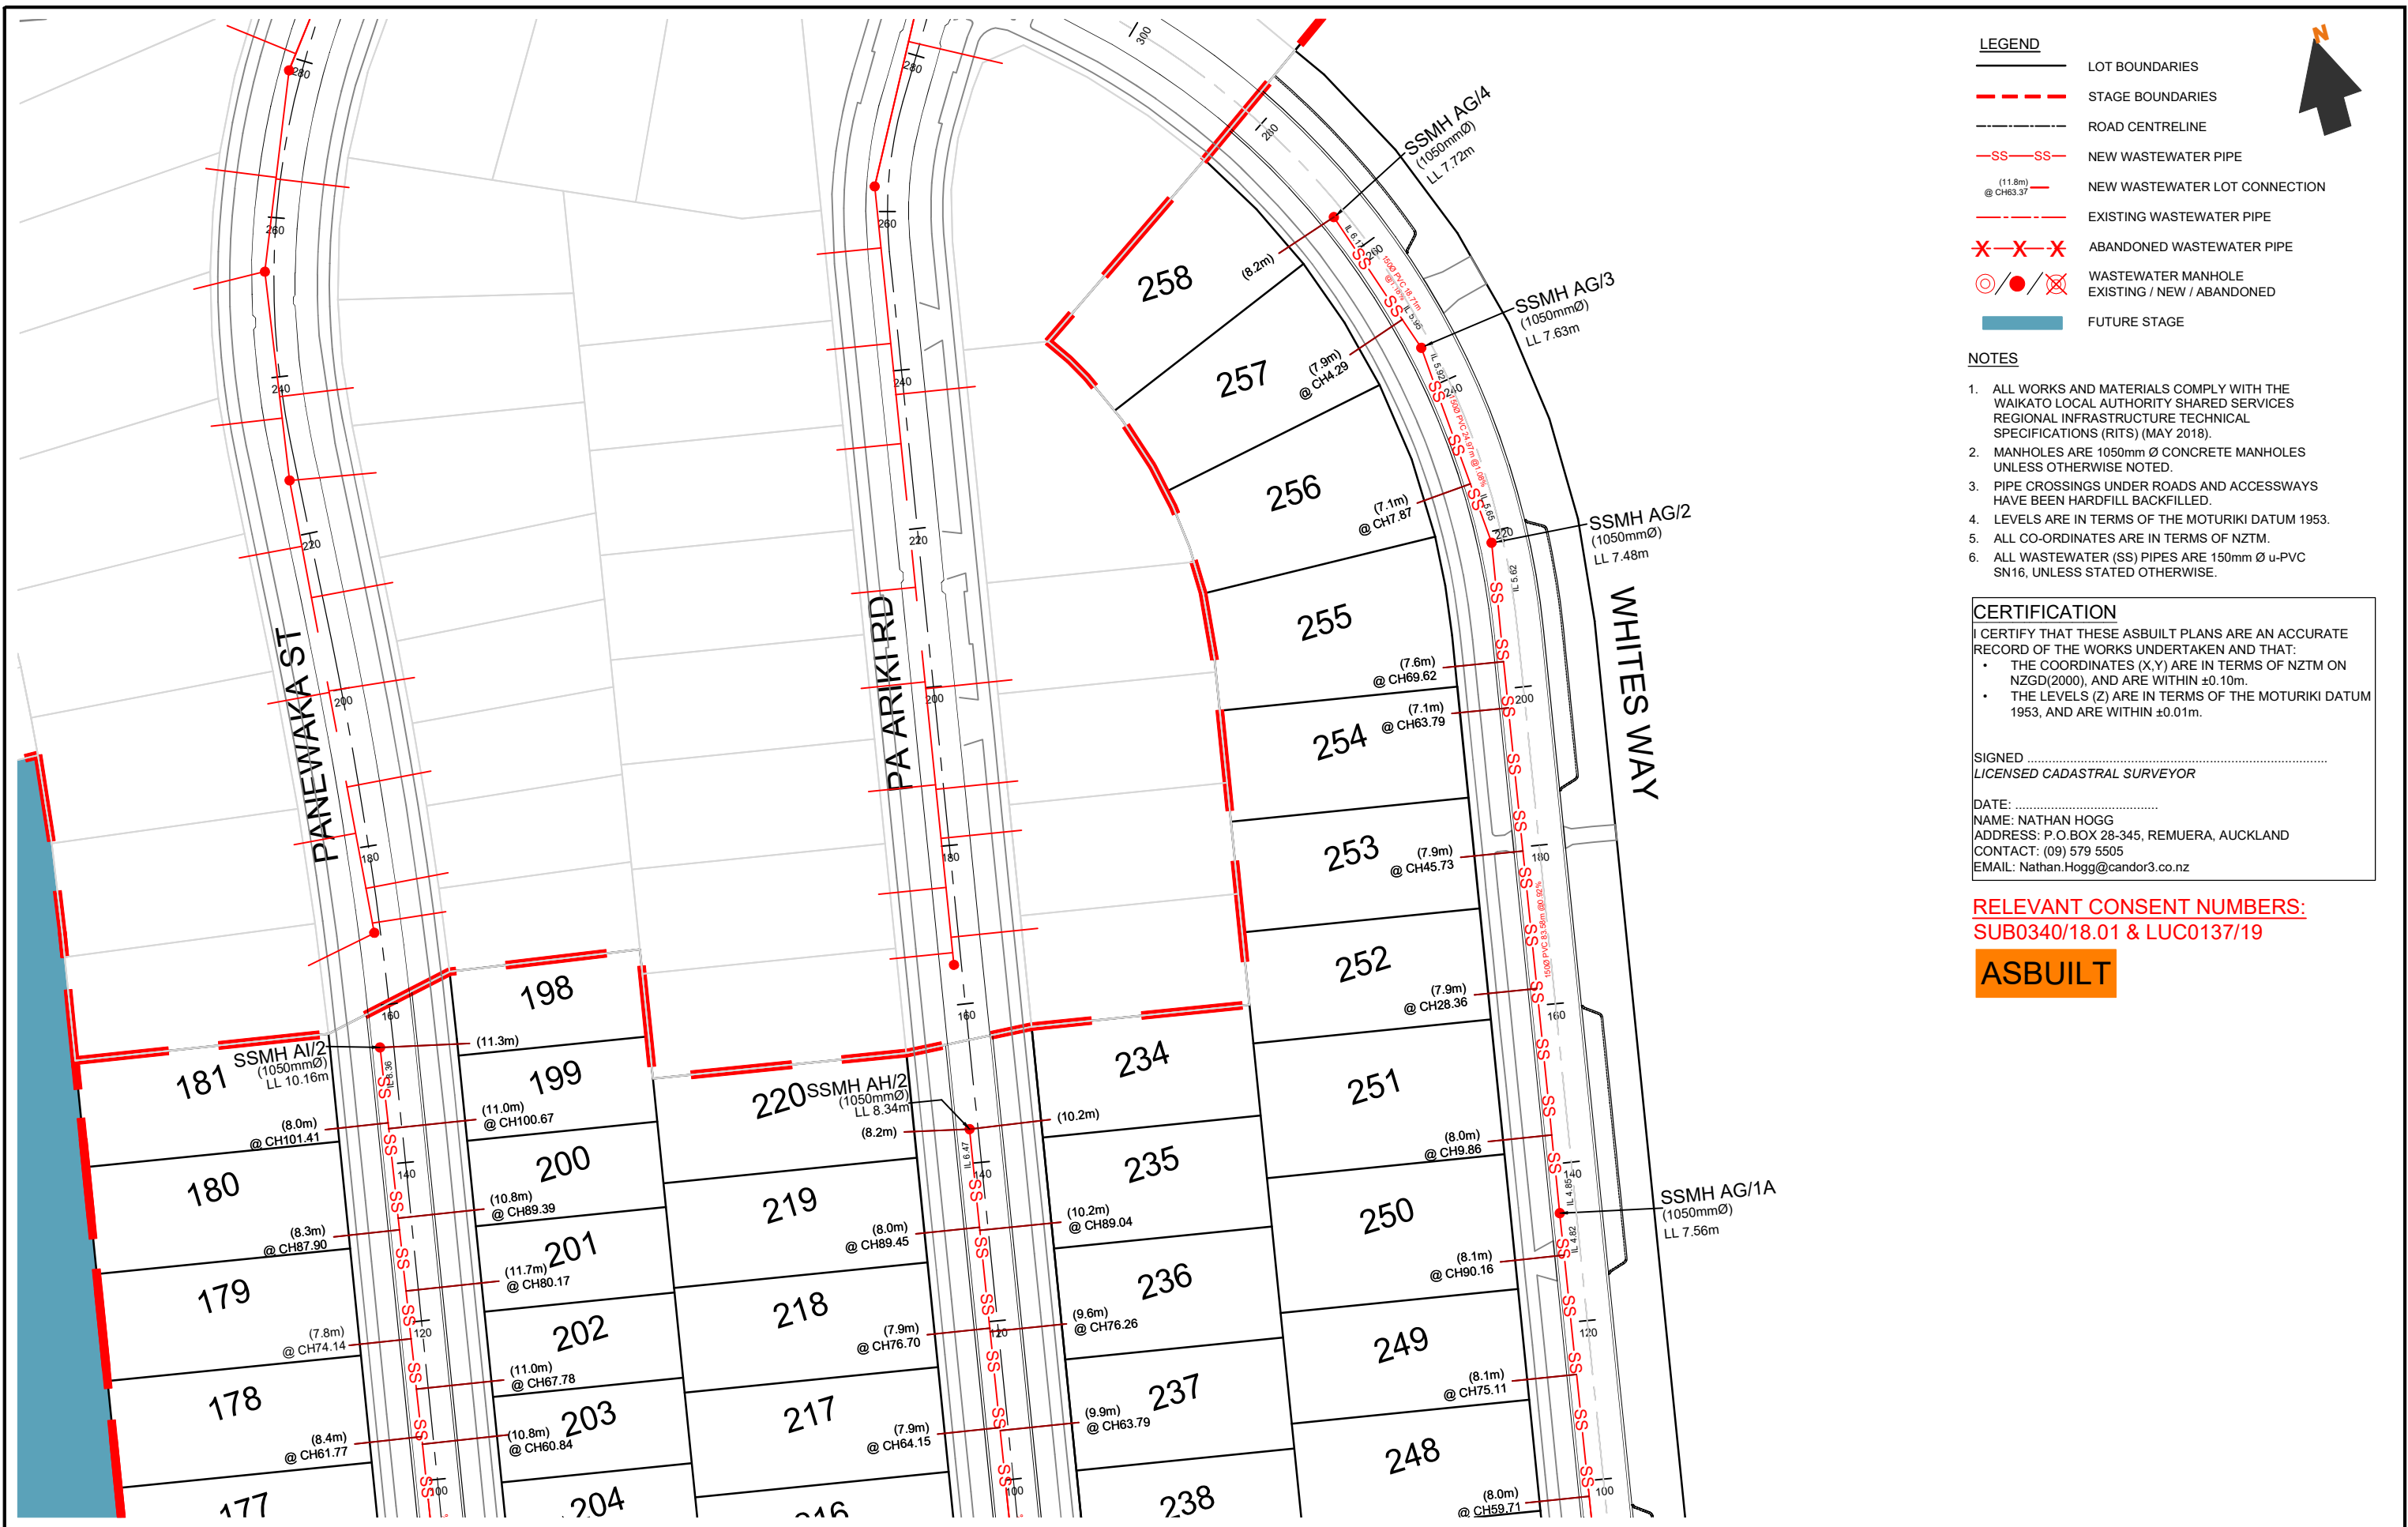

LEGEND

LOT BOUNDARIES

STAGE BOUNDARIES

ROAD CENTRELINE

SSSS

NEW WASTEWATER PIPE

(11.8m)
@ CH53.37

NEW WASTEWATER LOT CONNECTION

EXISTING WASTEWATER PIPE

XXX

ABANDONED WASTEWATER PIPE

●/●/●

WASTEWATER MANHOLE
EXISTING / NEW / ABANDONED

FUTURE STAGE



- NOTES**
1. ALL WORKS AND MATERIALS COMPLY WITH THE WAIKATO LOCAL AUTHORITY SHARED SERVICES REGIONAL INFRASTRUCTURE TECHNICAL SPECIFICATIONS (RITS) (MAY 2018).

2. MANHOLES ARE 1050mm Ø CONCRETE MANHOLES UNLESS OTHERWISE NOTED.

3. PIPE CROSSINGS UNDER ROADS AND ACCESSWAYS HAVE BEEN HARDFILL BACKFILLED.

4. LEVELS ARE IN TERMS OF THE MOTURIKI DATUM 1953.

5. ALL CO-ORDINATES ARE IN TERMS OF NZTM.

6. ALL WASTEWATER (SS) PIPES ARE 150mm Ø u-PVC SN16, UNLESS STATED OTHERWISE.

CERTIFICATION

I CERTIFY THAT THESE ASBUILT PLANS ARE AN ACCURATE RECORD OF THE WORKS UNDERTAKEN AND THAT:

- THE COORDINATES (X,Y) ARE IN TERMS OF NZTM ON NZGD(2000), AND ARE WITHIN ±0.10m.
- THE LEVELS (Z) ARE IN TERMS OF THE MOTURIKI DATUM 1953, AND ARE WITHIN ±0.01m.

SIGNED

LICENSED CADASTRAL SURVEYOR

DATE:

NAME: NATHAN HOGG

ADDRESS: P.O.BOX 28-345, REMUERA, AUCKLAND

CONTACT: (09) 579 5505


EMAIL: Nathan.Hogg@candor3.co.nz

RELEVANT CONSENT NUMBERS:
SUB0340/18.01 & LUC0137/19


ASBUILT

REV DESCRIPTION		BY	APPVD	DATE	PROJECT LAKESIDE, TE KAUWHATA WASTEWATER LAYOUT STAGE 5 2 OF 6	CLIENT LAKESIDE DEVELOPMENTS 2017 LIMITED	PURPOSE AS-BUILT		
							DESIGN JS DRAWN JS CHECK AP	APPROVED BY NH DATE DEC 2020	SCALE 1:750 @ A3
							PROJECT NO.	DRAWING NO.	REV.
							1239	AB-5-101	-



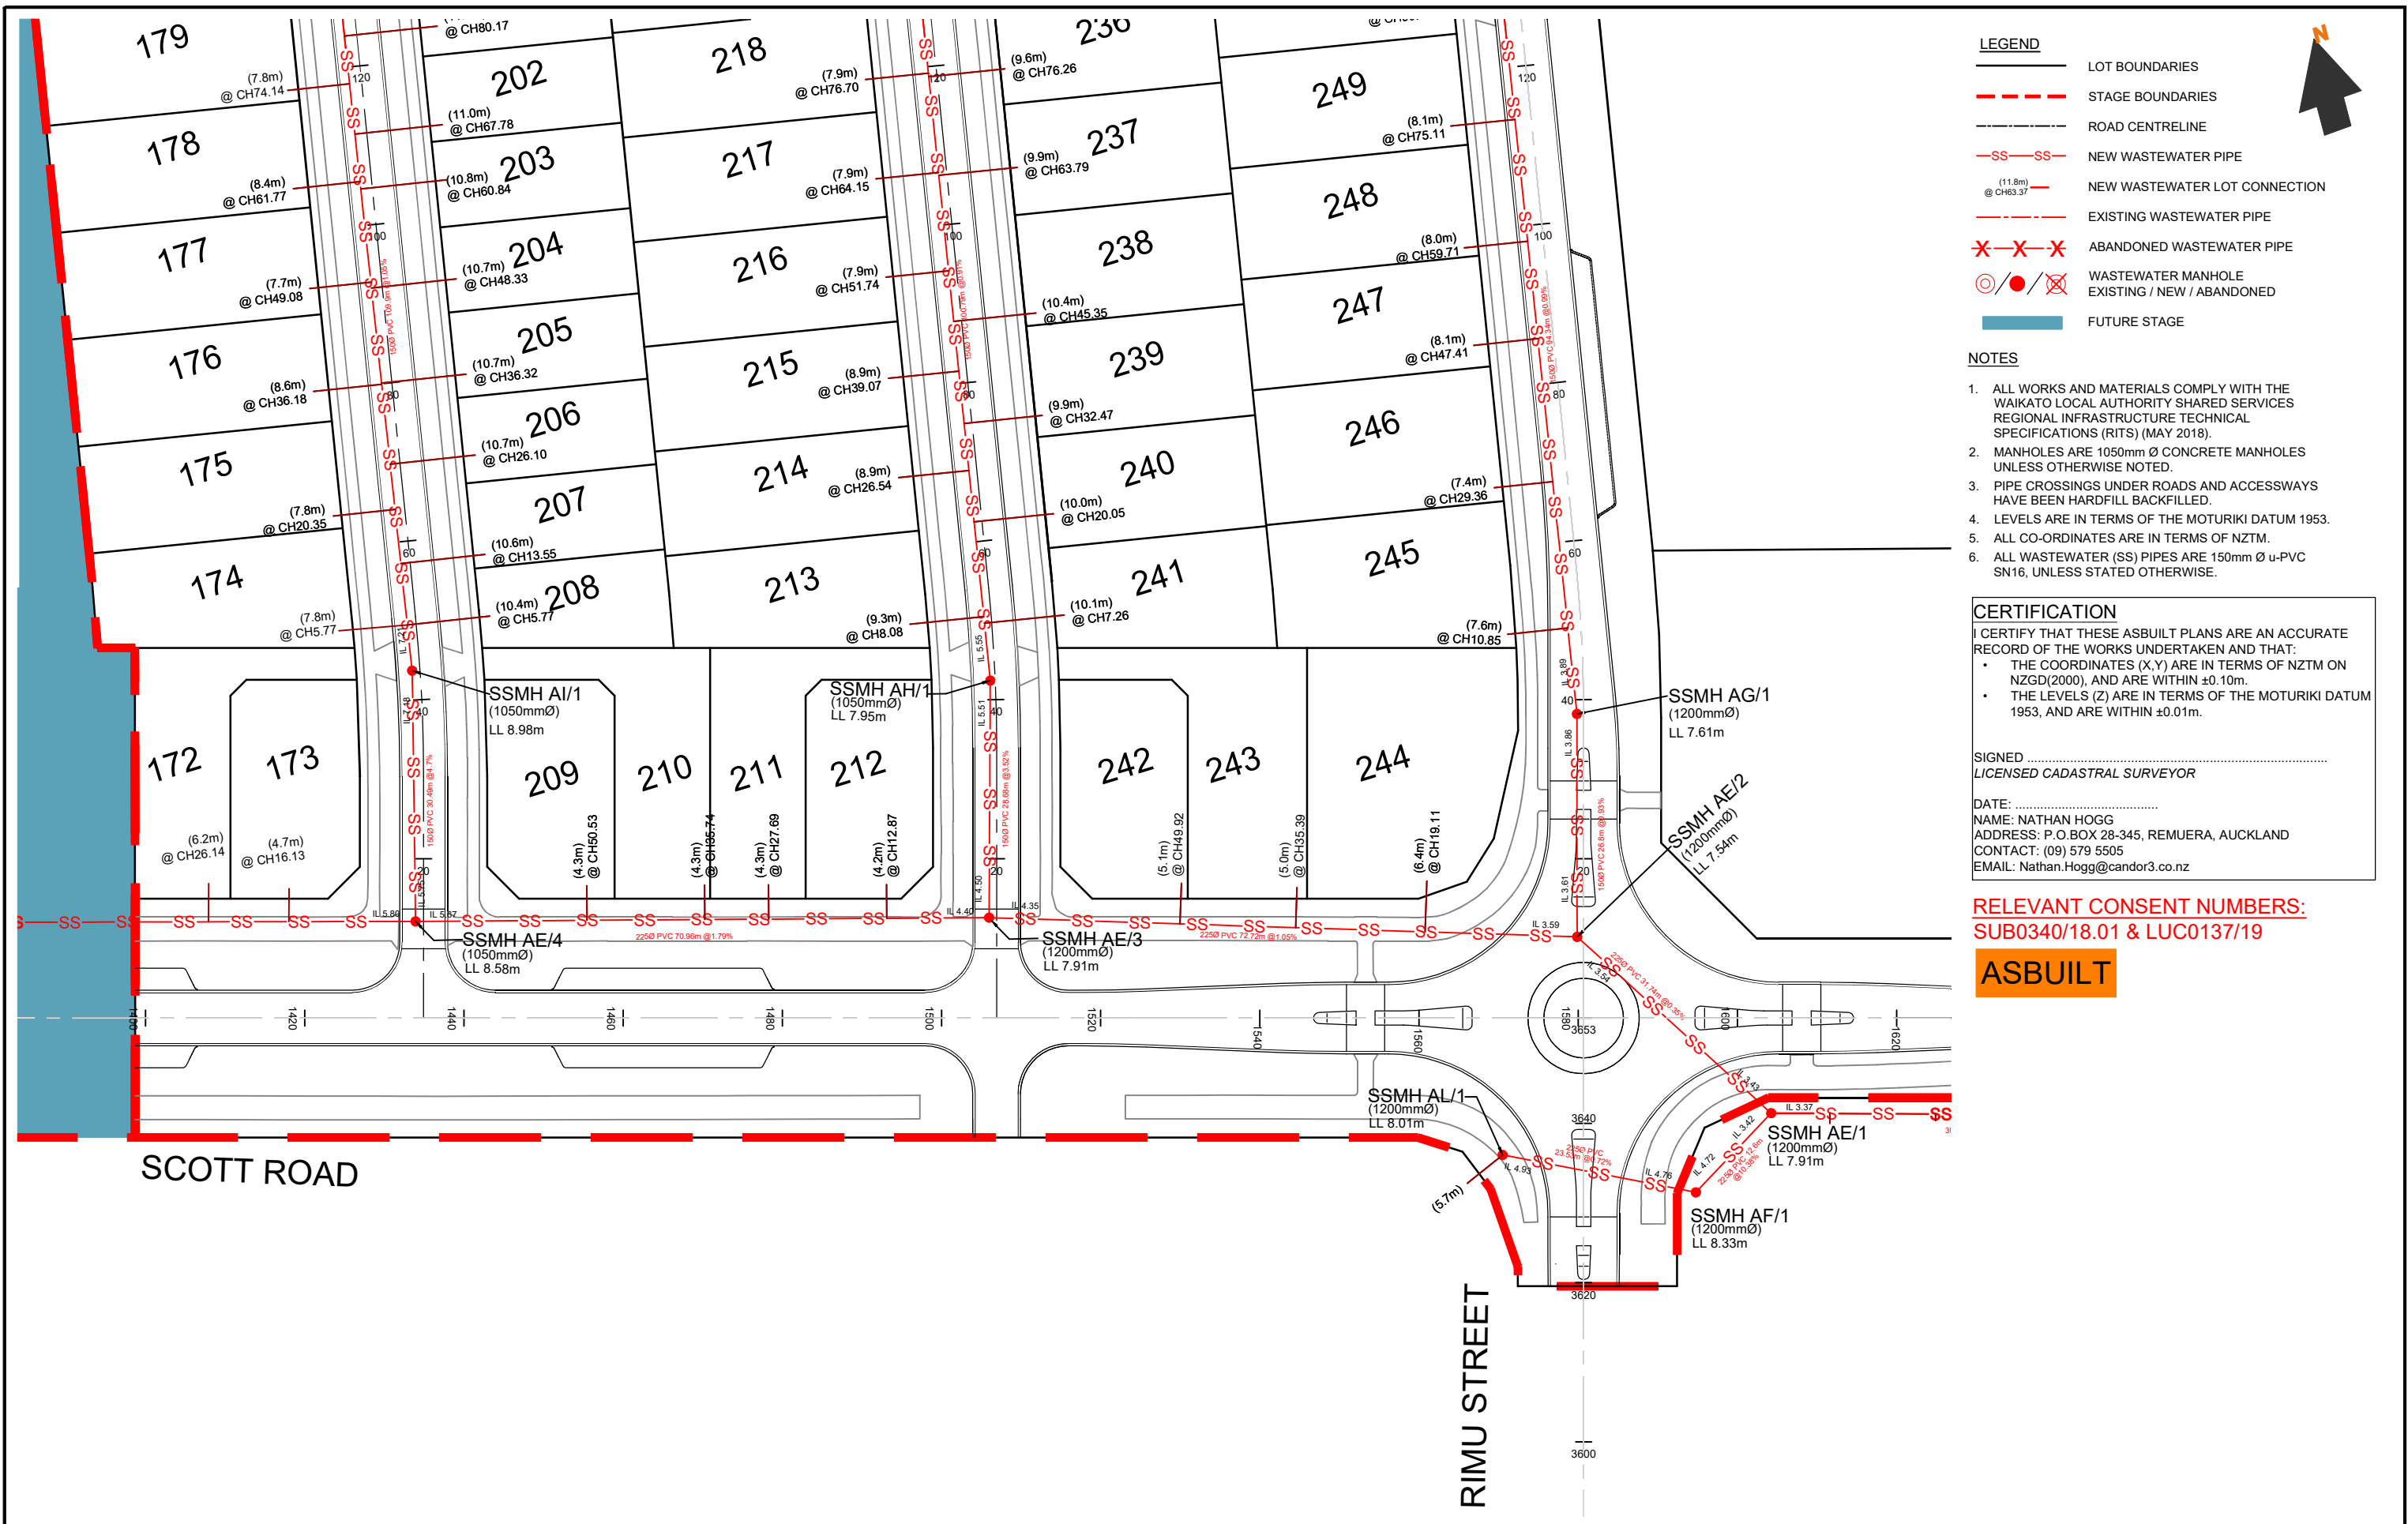

REV DESCRIPTION		BY APPVD DATE		PROJECT		CLIENT		PURPOSE				
<div>Candor³</div> <div>ENGINEERING FOR LIFE</div>				LAKESIDE, TE KAUPHATA WASTEWATER LAYOUT STAGE 5 3 OF 6		LAKESIDE DEVELOPMENTS 2017 LIMITED		AS-BUILT				
								DESIGN JS DRAWN JS CHECK AP		APPROVED BY NH DATE DEC 2020		SCALE 1:750 @ A3
								PROJECT NO. 1239		DRAWING NO. AB-5-102		REV. -

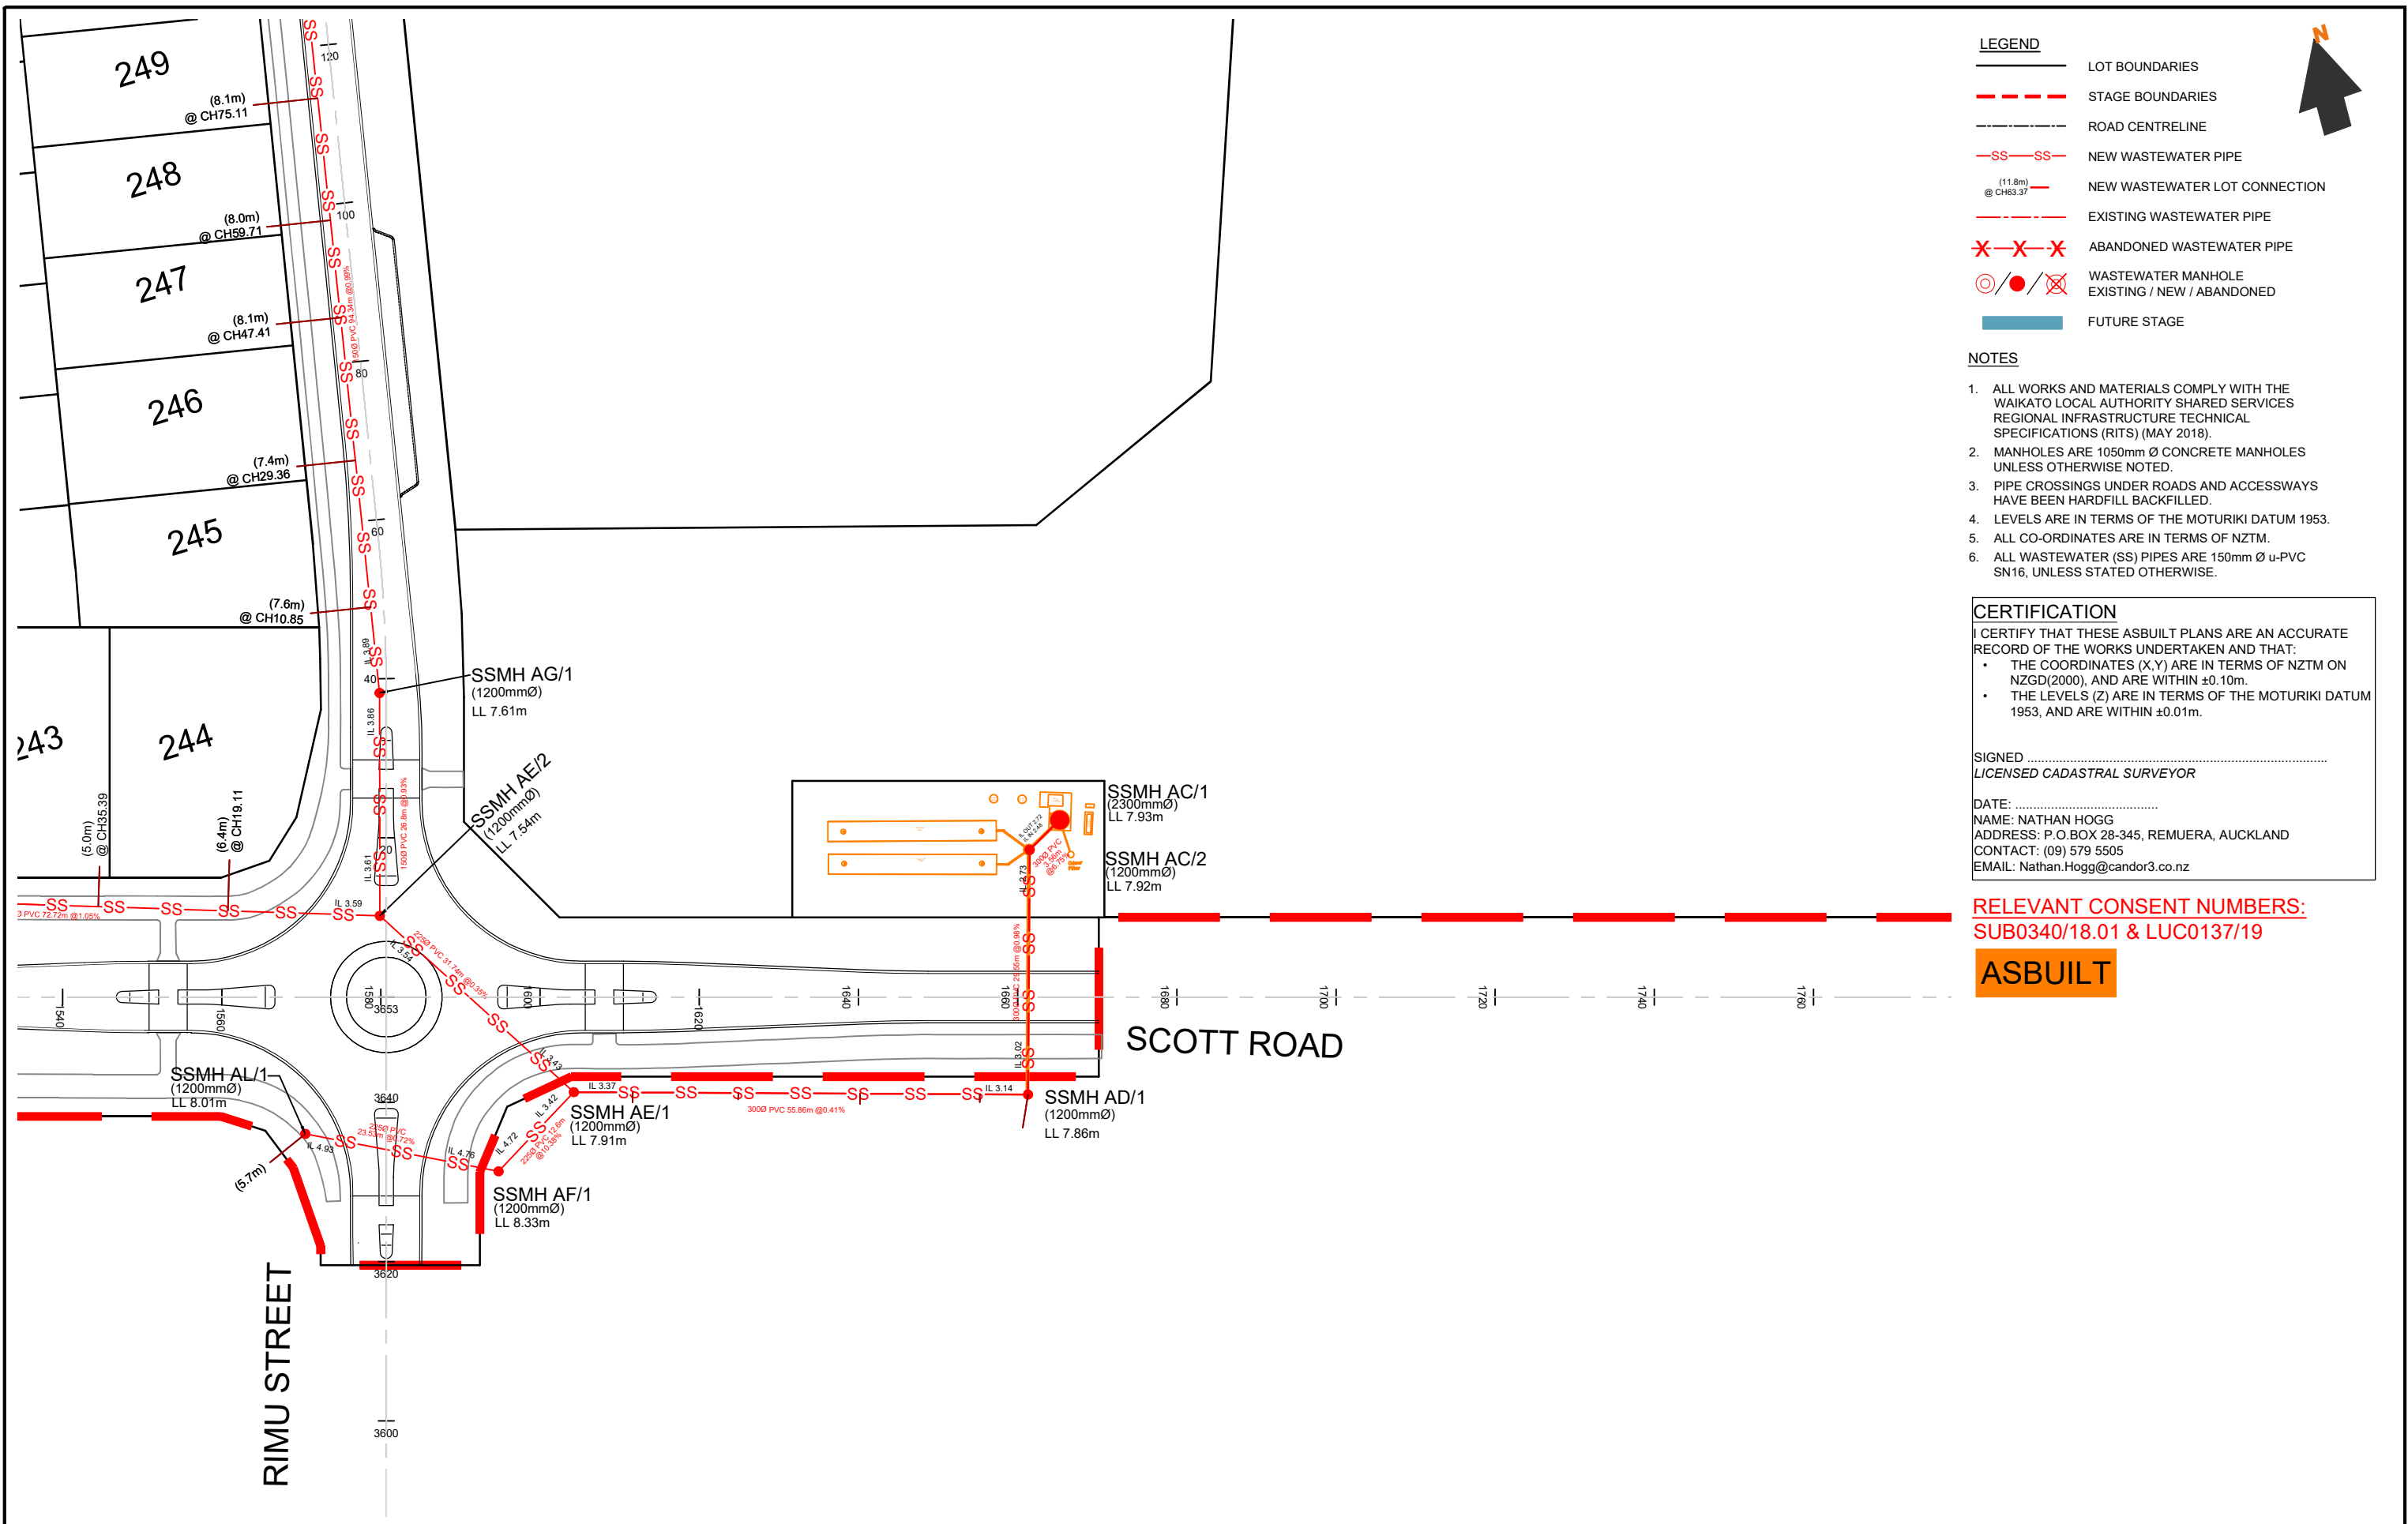

LEGEND

LOT BOUNDARIES

STAGE BOUNDARIES

ROAD CENTRELINE

NEW WASTEWATER PIPE

NEW WASTEWATER LOT CONNECTION

EXISTING WASTEWATER PIPE

ABANDONED WASTEWATER PIPE

WASTEWATER MANHOLE
EXISTING / NEW / ABANDONED

FUTURE STAGE

- NOTES
1. ALL WORKS AND MATERIALS COMPLY WITH THE WAIKATO LOCAL AUTHORITY SHARED SERVICES REGIONAL INFRASTRUCTURE TECHNICAL SPECIFICATIONS (RITS) (MAY 2018).

2. MANHOLES ARE 1050mm Ø CONCRETE MANHOLES UNLESS OTHERWISE NOTED.

3. PIPE CROSSINGS UNDER ROADS AND ACCESSWAYS HAVE BEEN HARDFILL BACKFILLED.

4. LEVELS ARE IN TERMS OF THE MOTURIKI DATUM 1953.

5. ALL CO-ORDINATES ARE IN TERMS OF NZTM.

6. ALL WASTEWATER (SS) PIPES ARE 150mm Ø u-PVC SN16, UNLESS STATED OTHERWISE.

CERTIFICATION

I CERTIFY THAT THESE ASBUILT PLANS ARE AN ACCURATE RECORD OF THE WORKS UNDERTAKEN AND THAT:

- THE COORDINATES (X,Y) ARE IN TERMS OF NZTM ON NZGD(2000), AND ARE WITHIN ±0.10m.
- THE LEVELS (Z) ARE IN TERMS OF THE MOTURIKI DATUM 1953, AND ARE WITHIN ±0.01m.

SIGNED
LICENSED CADASTRAL SURVEYOR

DATE:
NAME: NATHAN HOGG
ADDRESS: P.O.BOX 28-345, REMUERA, AUCKLAND
CONTACT: (09) 579 5505
EMAIL: Nathan.Hogg@candor3.co.nz


RELEVANT CONSENT NUMBERS:
SUB0340/18.01 & LUC0137/19

ASBUILT

REV DESCRIPTION				BY	APPVD	DATE	<div>Candor³</div> <div>ENGINEERING FOR LIFE</div>	PROJECT				LAKESIDE, TE KAUWHATA WASTEWATER LAYOUT STAGE 5 4 OF 6				CLIENT				LAKESIDE DEVELOPMENTS 2017 LIMITED				PURPOSE				AS-BUILT				
																				DESIGN JS DRAWN JS CHECK AP				APPROVED BY NH DATE DEC 2020				SCALE 1:750 @ A3				
																				PROJECT NO.				DRAWING NO.				REV.				
																				1239				AB-5-103				-				



REV DESCRIPTION		BY	APPVD	DATE	<div>Candor³</div> <div>ENGINEERING FOR LIFE</div>	PROJECT <div>LAKESIDE, TE KAUWHATA WASTEWATER LAYOUT STAGE 5 5 OF 6</div>	CLIENT <div>LAKESIDE DEVELOPMENTS 2017 LIMITED</div>	PURPOSE <div>AS-BUILT</div>						
DESIGN	JS	BY	NH	DATE				SCALE 1:750 @ A3	PROJECT NO. 1239	DRAWING NO. AB-5-104	REV. -			
DRAWN	JS													
CHECK	AP			DEC 2020										

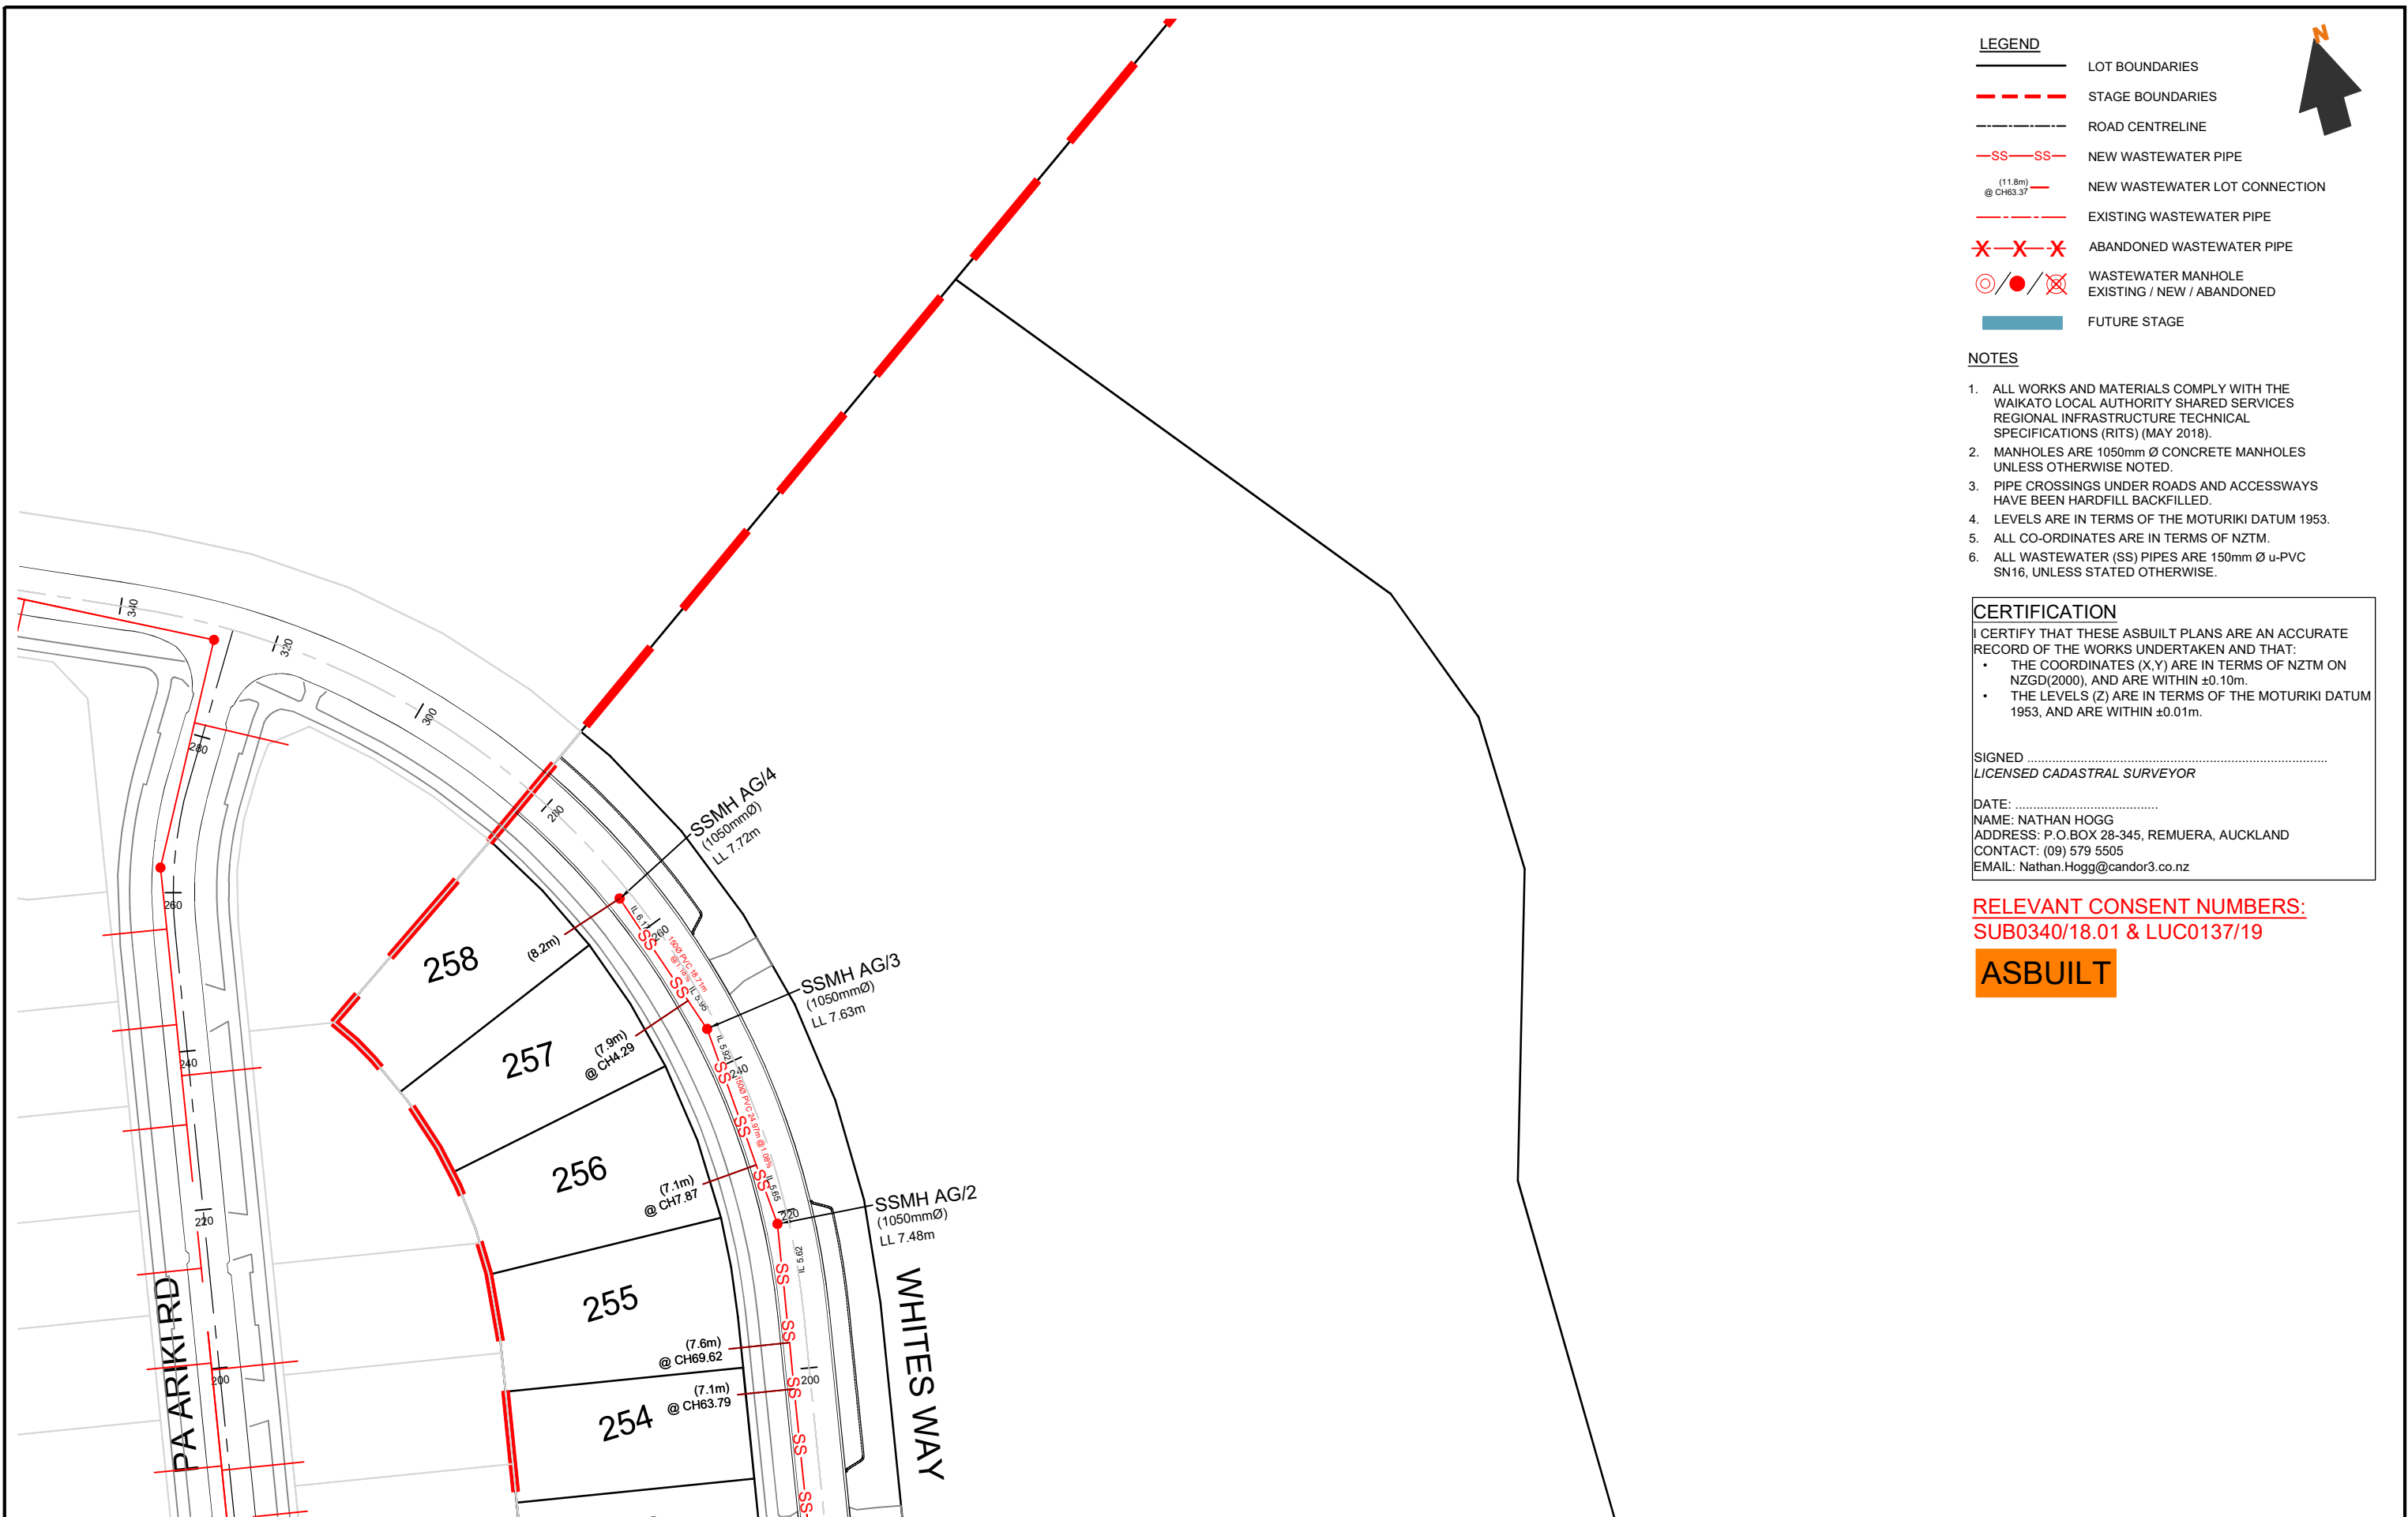

LEGEND

LOT BOUNDARIES

STAGE BOUNDARIES

ROAD CENTRELINE

NEW WASTEWATER PIPE

NEW WASTEWATER LOT CONNECTION
(11.8m)
@ CH63.37

EXISTING WASTEWATER PIPE

ABANDONED WASTEWATER PIPE

WASTEWATER MANHOLE
EXISTING / NEW / ABANDONED

FUTURE STAGE

- NOTES
1. ALL WORKS AND MATERIALS COMPLY WITH THE WAIKATO LOCAL AUTHORITY SHARED SERVICES REGIONAL INFRASTRUCTURE TECHNICAL SPECIFICATIONS (RITS) (MAY 2018).

2. MANHOLES ARE 1050mm Ø CONCRETE MANHOLES UNLESS OTHERWISE NOTED.

3. PIPE CROSSINGS UNDER ROADS AND ACCESSWAYS HAVE BEEN HARDFILL BACKFILLED.

4. LEVELS ARE IN TERMS OF THE MOTURIKI DATUM 1953.

5. ALL CO-ORDINATES ARE IN TERMS OF NZTM.

6. ALL WASTEWATER (SS) PIPES ARE 150mm Ø u-PVC SN16, UNLESS STATED OTHERWISE.

CERTIFICATION

I CERTIFY THAT THESE ASBUILT PLANS ARE AN ACCURATE RECORD OF THE WORKS UNDERTAKEN AND THAT:

- THE COORDINATES (X,Y) ARE IN TERMS OF NZTM ON NZGD(2000), AND ARE WITHIN ±0.10m.
- THE LEVELS (Z) ARE IN TERMS OF THE MOTURIKI DATUM 1953, AND ARE WITHIN ±0.01m.

SIGNED
LICENSED CADASTRAL SURVEYOR

DATE:
NAME: NATHAN HOGG
ADDRESS: P.O.BOX 28-345, REMUERA, AUCKLAND
CONTACT: (09) 579 5505
EMAIL: Nathan.Hogg@candor3.co.nz

RELEVANT CONSENT NUMBERS:
SUB0340/18.01 & LUC0137/19

ASBUILT

REV DESCRIPTION	BY	APPVD	DATE	<div>Candor³ ENGINEERING FOR LIFE</div>	PROJECT	LAKESIDE, TE KAUWHATA WASTEWATER LAYOUT STAGE 5 6 OF 6	CLIENT	LAKESIDE DEVELOPMENTS 2017 LIMITED	PURPOSE		
									AS-BUILT		
									DESIGN JS DRAWN JS CHECK AP	APPROVED BY NH DATE DEC 2020	SCALE 1:750 @ A3
							PROJECT NO.				
							DRAWING NO.				
							REV.				

	PIT ID	NORTHING	EASTING	LID LEVEL	MH Ø(mm)
1	AD/1	5856687.82	1790666.49	7.86	1200
2	AE/1	5856705.82	1790612.34	7.91	1200
3	AE/2	5856734.46	1790596.04	7.54	1200
4	AE/3	5856759.68	1790526.55	7.91	1200
5	AE/4	5856781.62	1790457.89	8.58	1050
6	AF/1	5856699.31	1790600.25	8.33	1200
7	AG/1	5856761.08	1790604.70	7.61	1200
8	AG/1A	5856854.42	1790624.78	7.56	1050
9	AG/2	5856937.11	1790642.79	7.48	1050
10	AG/3	5856963.13	1790642.00	7.63	1050
11	AG/4	5856982.14	1790636.63	7.72	1050
12	AH/1	5856787.96	1790535.93	7.95	1050
13	AH/2	5856887.48	1790557.57	8.34	1050
14	AI/1	5856811.70	1790467.26	8.98	1050
15	AI/2	5856920.23	1790490.33	10.16	1050
16	AL/1	5856711.31	1790578.63	8.01	1200
17					
18					
CERTIFICATION

I CERTIFY THAT THESE ASBUILT PLANS ARE AN ACCURATE RECORD OF THE WORKS UNDERTAKEN AND THAT:

- THE COORDINATES (X,Y) ARE IN TERMS OF NZTM ON NZGD(2000), AND ARE WITHIN ±0.10m.
- THE LEVELS (Z) ARE IN TERMS OF THE MOTURIKI DATUM 1953, AND ARE WITHIN ±0.01m.

SIGNED
LICENSED CADASTRAL SURVEYOR

DATE:
NAME: NATHAN HOGG
ADDRESS: P.O.BOX 28-345, REMUERA, AUCKLAND
CONTACT: (09) 579 5505
EMAIL: Nathan.Hogg@candor3.co.nz

RELEVANT CONSENT NUMBERS:
SUB0340/18.01 & LUC0137/19

ASBUILT

REV DESCRIPTION	BY	APPVD	DATE	<div>Candor³</div> <div>ENGINEERING FOR LIFE</div>	PROJECT	LAKESIDE, TE KAUWHATA WASTEWATER STAGE 5 COORDINATE TABLE	CLIENT	LAKESIDE DEVELOPMENTS 2017 LIMITED	PURPOSE				
									AS-BUILT				
									DESIGN DRAWN CHECK	JS JS AP	APPROVED BY DATE	NH DEC 2020	SCALE N/A
									PROJECT NO.		DRAWING NO.	REV.	
									1239	AB-5-106	-		