

- LEGEND**
- LOT BOUNDARIES
 - STAGE BOUNDARIES
 - FINISHED CONTOUR MAJOR (1m INTERVAL)
 - FINISHED CONTOUR MINOR (0.5m INTERVAL)
 - 110mmØ UNDERFILL DRAIN
 - FUTURE STAGE

- NOTE:**
- LEVELS ARE IN TERMS OF MOTURIKI VERTICAL DATUM 1953.
 - FINAL SURFACE TOPO TAKEN FOR THE PURPOSE OF GEOTECHNICAL CUT FILL AS-BUILT PLANS AND SHOULD NOT BE RELIED ON FOR DETAILED DESIGN.
 - POSITION OF UNDERFILL DRAINS IS BASED ON CONTRACTOR SUPPLIED SURVEY.

CERTIFICATION

I CERTIFY THAT THESE ASBUILT PLANS ARE AN ACCURATE RECORD OF THE WORKS UNDERTAKEN AND THAT:

- THE COORDINATES (X,Y) ARE IN TERMS OF NZTM ON NZGD(2000), AND ARE WITHIN ±0.10m.
- THE LEVELS (Z) ARE IN TERMS OF THE MOTURIKI DATUM 1953, AND ARE WITHIN ±0.01m.

SIGNED
LICENSED CADASTRAL SURVEYOR

DATE:
NAME: NATHAN HOGG
ADDRESS: P.O.BOX 28-345, REMUERA, AUCKLAND
CONTACT: (09) 579 5505
EMAIL: Nathan.Hogg@candor3.co.nz

RELEVANT CONSENT NUMBERS:
SUB0340/18.01 & LUC0137/19

ASBUILT

REV DESCRIPTION		BY APPVD DATE	<div>Candor³</div> <div>ENGINEERING FOR LIFE</div>	PROJECT LAKESIDE, TE KAUWHATA EARTHWORKS FINISHED SURFACE STAGE 1 1 OF 6	CLIENT LAKESIDE DEVELOPMENTS 2017 LIMITED	PURPOSE AS-BUILT		
						DESIGN JS DRAWN JS CHECK RS	APPROVED BY NH DATE MAR 2020	SCALE 1:2500 @ A3
						PROJECT NO. 1239	DRAWING NO. AB-2-200	REV. -

LEGEND


- LOT BOUNDARIES
- STAGE BOUNDARIES
- FINISHED CONTOUR MAJOR (1m INTERVAL)
- FINISHED CONTOUR MINOR (0.5m INTERVAL)
- 110mmØ UNDERFILL DRAIN
- FUTURE STAGE

NOTE:

- LEVELS ARE IN TERMS OF MOTURIKI VERTICAL DATUM 1953.
- FINAL SURFACE TOPO TAKEN FOR THE PURPOSE OF GEOTECHNICAL CUT FILL AS-BUILT PLANS AND SHOULD NOT BE RELIED ON FOR DETAILED DESIGN.
- POSITION OF UNDERFILL DRAINS IS BASED ON CONTRACTOR SUPPLIED SURVEY.

#94A SCOTT RD

#65 SCOTT RD

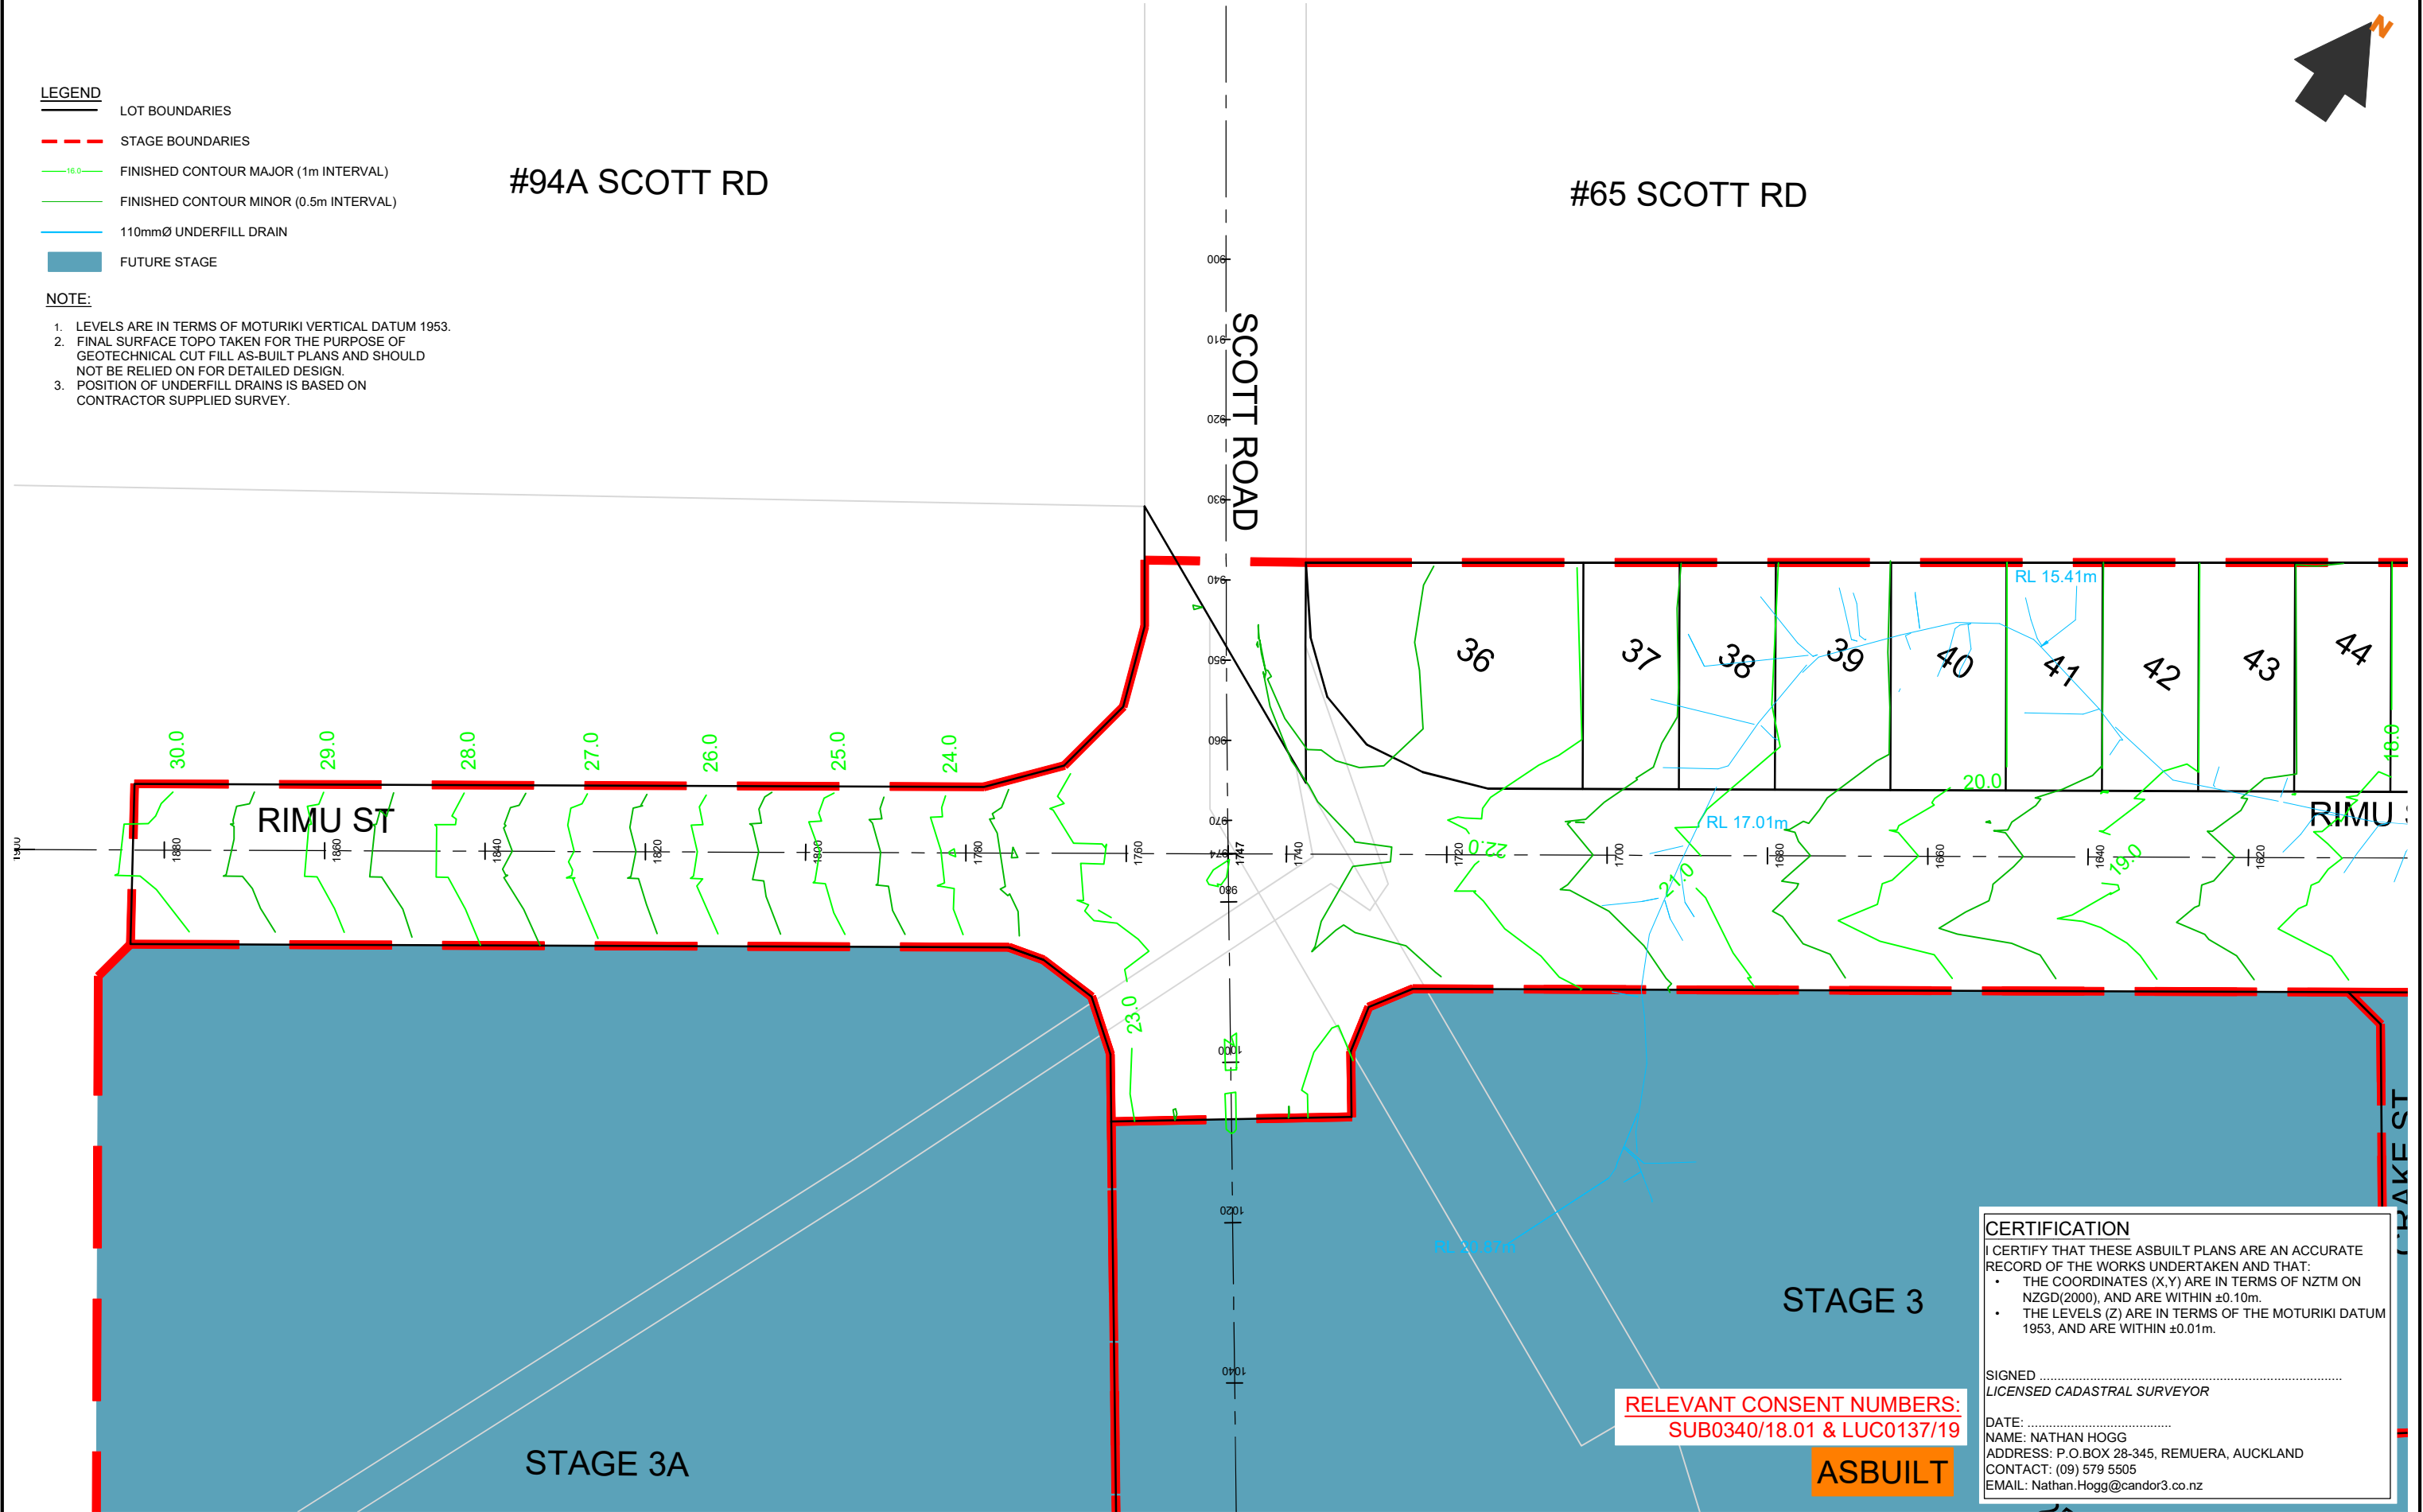

CERTIFICATION

I CERTIFY THAT THESE ASBUILT PLANS ARE AN ACCURATE RECORD OF THE WORKS UNDERTAKEN AND THAT:

- THE COORDINATES (X,Y) ARE IN TERMS OF NZTM ON NZGD(2000), AND ARE WITHIN ±0.10m.
- THE LEVELS (Z) ARE IN TERMS OF THE MOTURIKI DATUM 1953, AND ARE WITHIN ±0.01m.

SIGNED
LICENSED CADASTRAL SURVEYOR

DATE:
NAME: NATHAN HOGG
ADDRESS: P.O.BOX 28-345, REMUERA, AUCKLAND
CONTACT: (09) 579 5505
EMAIL: Nathan.Hogg@candor3.co.nz

RELEVANT CONSENT NUMBERS:
SUB0340/18.01 & LUC0137/19

ASBUILT

REV	DESCRIPTION	BY	APPVD	DATE	PROJECT	CLIENT	PURPOSE
					LAKESIDE, TE KAUWHATA EARTHWORKS FINISHED SURFACE STAGE 1 2 OF 6	LAKESIDE DEVELOPMENTS 2017 LIMITED	AS-BUILT
							DESIGN JS DRAWN JS CHECK RS
							APPROVED BY NH DATE MAR 2020
							SCALE 1:750 @ A3
							PROJECT NO. 1239
							DRAWING NO. AB-2-201
							REV. -

Candor³
ENGINEERING FOR LIFE

CERTIFICATION

I CERTIFY THAT THESE ASBUILT PLANS ARE AN ACCURATE RECORD OF THE WORKS UNDERTAKEN AND THAT:

- THE COORDINATES (X,Y) ARE IN TERMS OF NZTM ON NZGD(2000), AND ARE WITHIN ±0.10m.
- THE LEVELS (Z) ARE IN TERMS OF THE MOTURIKI DATUM 1953, AND ARE WITHIN ±0.01m.

SIGNED
LICENSED CADASTRAL SURVEYOR


DATE:
NAME: NATHAN HOGG
ADDRESS: P.O.BOX 28-345, REMUERA, AUCKLAND
CONTACT: (09) 579 5505
EMAIL: Nathan.Hogg@candor3.co.nz

RELEVANT CONSENT NUMBERS:
SUB0340/18.01 & LUC0137/19

ASBUILT

- LEGEND
- LOT BOUNDARIES
 - STAGE BOUNDARIES
 - FINISHED CONTOUR MAJOR (1m INTERVAL)
 - FINISHED CONTOUR MINOR (0.5m INTERVAL)
 - 110mmØ UNDERFILL DRAIN
 - FUTURE STAGE

- NOTE:
- LEVELS ARE IN TERMS OF MOTURIKI VERTICAL DATUM 1953.
 - FINAL SURFACE TOPO TAKEN FOR THE PURPOSE OF GEOTECHNICAL CUT FILL AS-BUILT PLANS AND SHOULD NOT BE RELIED ON FOR DETAILED DESIGN.
 - POSITION OF UNDERFILL DRAINS IS BASED ON CONTRACTOR SUPPLIED SURVEY.

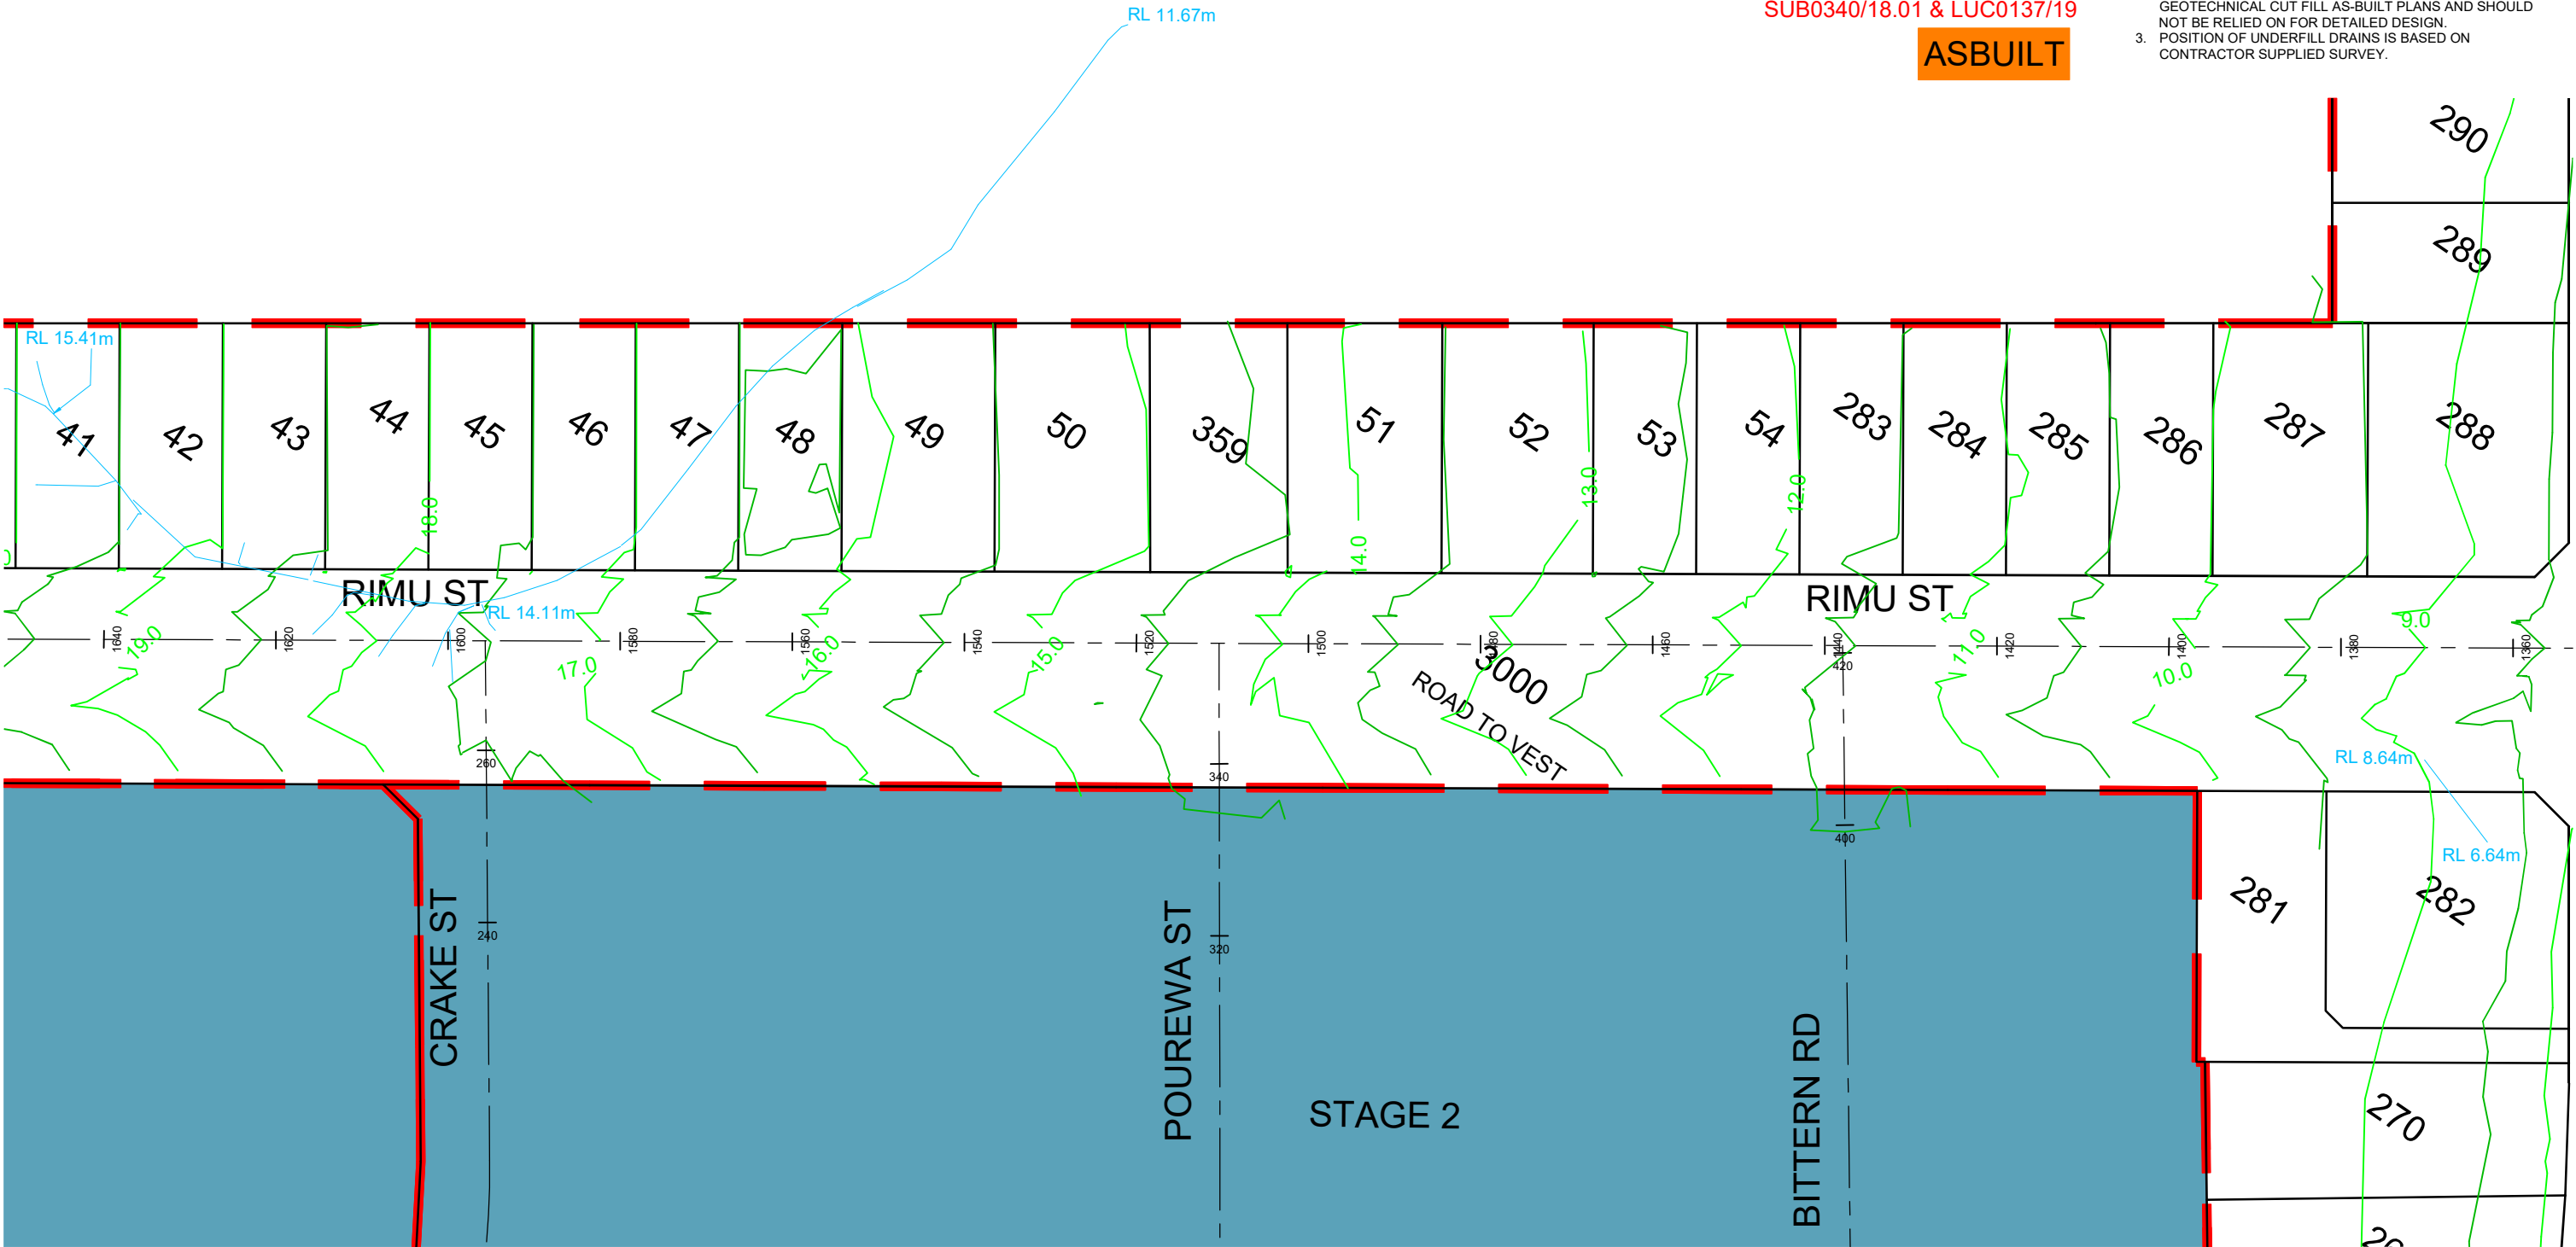

REV DESCRIPTION		BY	APPVD	DATE	PROJECT		CLIENT		PURPOSE		
					LAKESIDE, TE KAUWHATA		LAKESIDE		AS-BUILT		
					EARTHWORKS FINISHED SURFACE STAGE 1		DEVELOPMENTS 2017		DESIGN JS	APPROVED BY NH	SCALE 1:750 @ A3
					3 OF 6		LIMITED		CHECK RS	DATE MAR 2020	
									PROJECT NO.	DRAWING NO.	REV.
									1239	AB-2-202	-





- LEGEND**
- LOT BOUNDARIES
 - STAGE BOUNDARIES
 - FINISHED CONTOUR MAJOR (1m INTERVAL)
 - FINISHED CONTOUR MINOR (0.5m INTERVAL)
 - 110mmØ UNDERFILL DRAIN
 - FUTURE STAGE
- NOTE:**
- LEVELS ARE IN TERMS OF MOTURIKI VERTICAL DATUM 1953.
 - FINAL SURFACE TOPO TAKEN FOR THE PURPOSE OF GEOTECHNICAL CUT FILL AS-BUILT PLANS AND SHOULD NOT BE RELIED ON FOR DETAILED DESIGN.
 - POSITION OF UNDERFILL DRAINS IS BASED ON CONTRACTOR SUPPLIED SURVEY.

CERTIFICATION

I CERTIFY THAT THESE ASBUILT PLANS ARE AN ACCURATE RECORD OF THE WORKS UNDERTAKEN AND THAT:

- THE COORDINATES (X,Y) ARE IN TERMS OF NZTM ON NZGD(2000), AND ARE WITHIN ±0.10m.
- THE LEVELS (Z) ARE IN TERMS OF THE MOTURIKI DATUM 1953, AND ARE WITHIN ±0.01m.

SIGNED
LICENSED CADASTRAL SURVEYOR


DATE:
NAME: NATHAN HOGG
ADDRESS: P.O.BOX 28-345, REMUERA, AUCKLAND
CONTACT: (09) 579 5505
EMAIL: Nathan.Hogg@candor3.co.nz

RELEVANT CONSENT NUMBERS:
SUB0340/18.01 & LUC0137/19

ASBUILT

REV DESCRIPTION		BY	APPVD	DATE	PROJECT		CLIENT		PURPOSE		
					LAKESIDE, TE KAUWHATA		LAKESIDE		AS-BUILT		
					EARTHWORKS FINISHED SURFACE STAGE 1		DEVELOPMENTS 2017		DESIGN JS	APPROVED BY NH	SCALE 1:750 @ A3
					4 OF 6		LIMITED		CHECK RS	DATE MAR 2020	
									PROJECT NO.	DRAWING NO.	REV.
									1239	AB-2-203	-



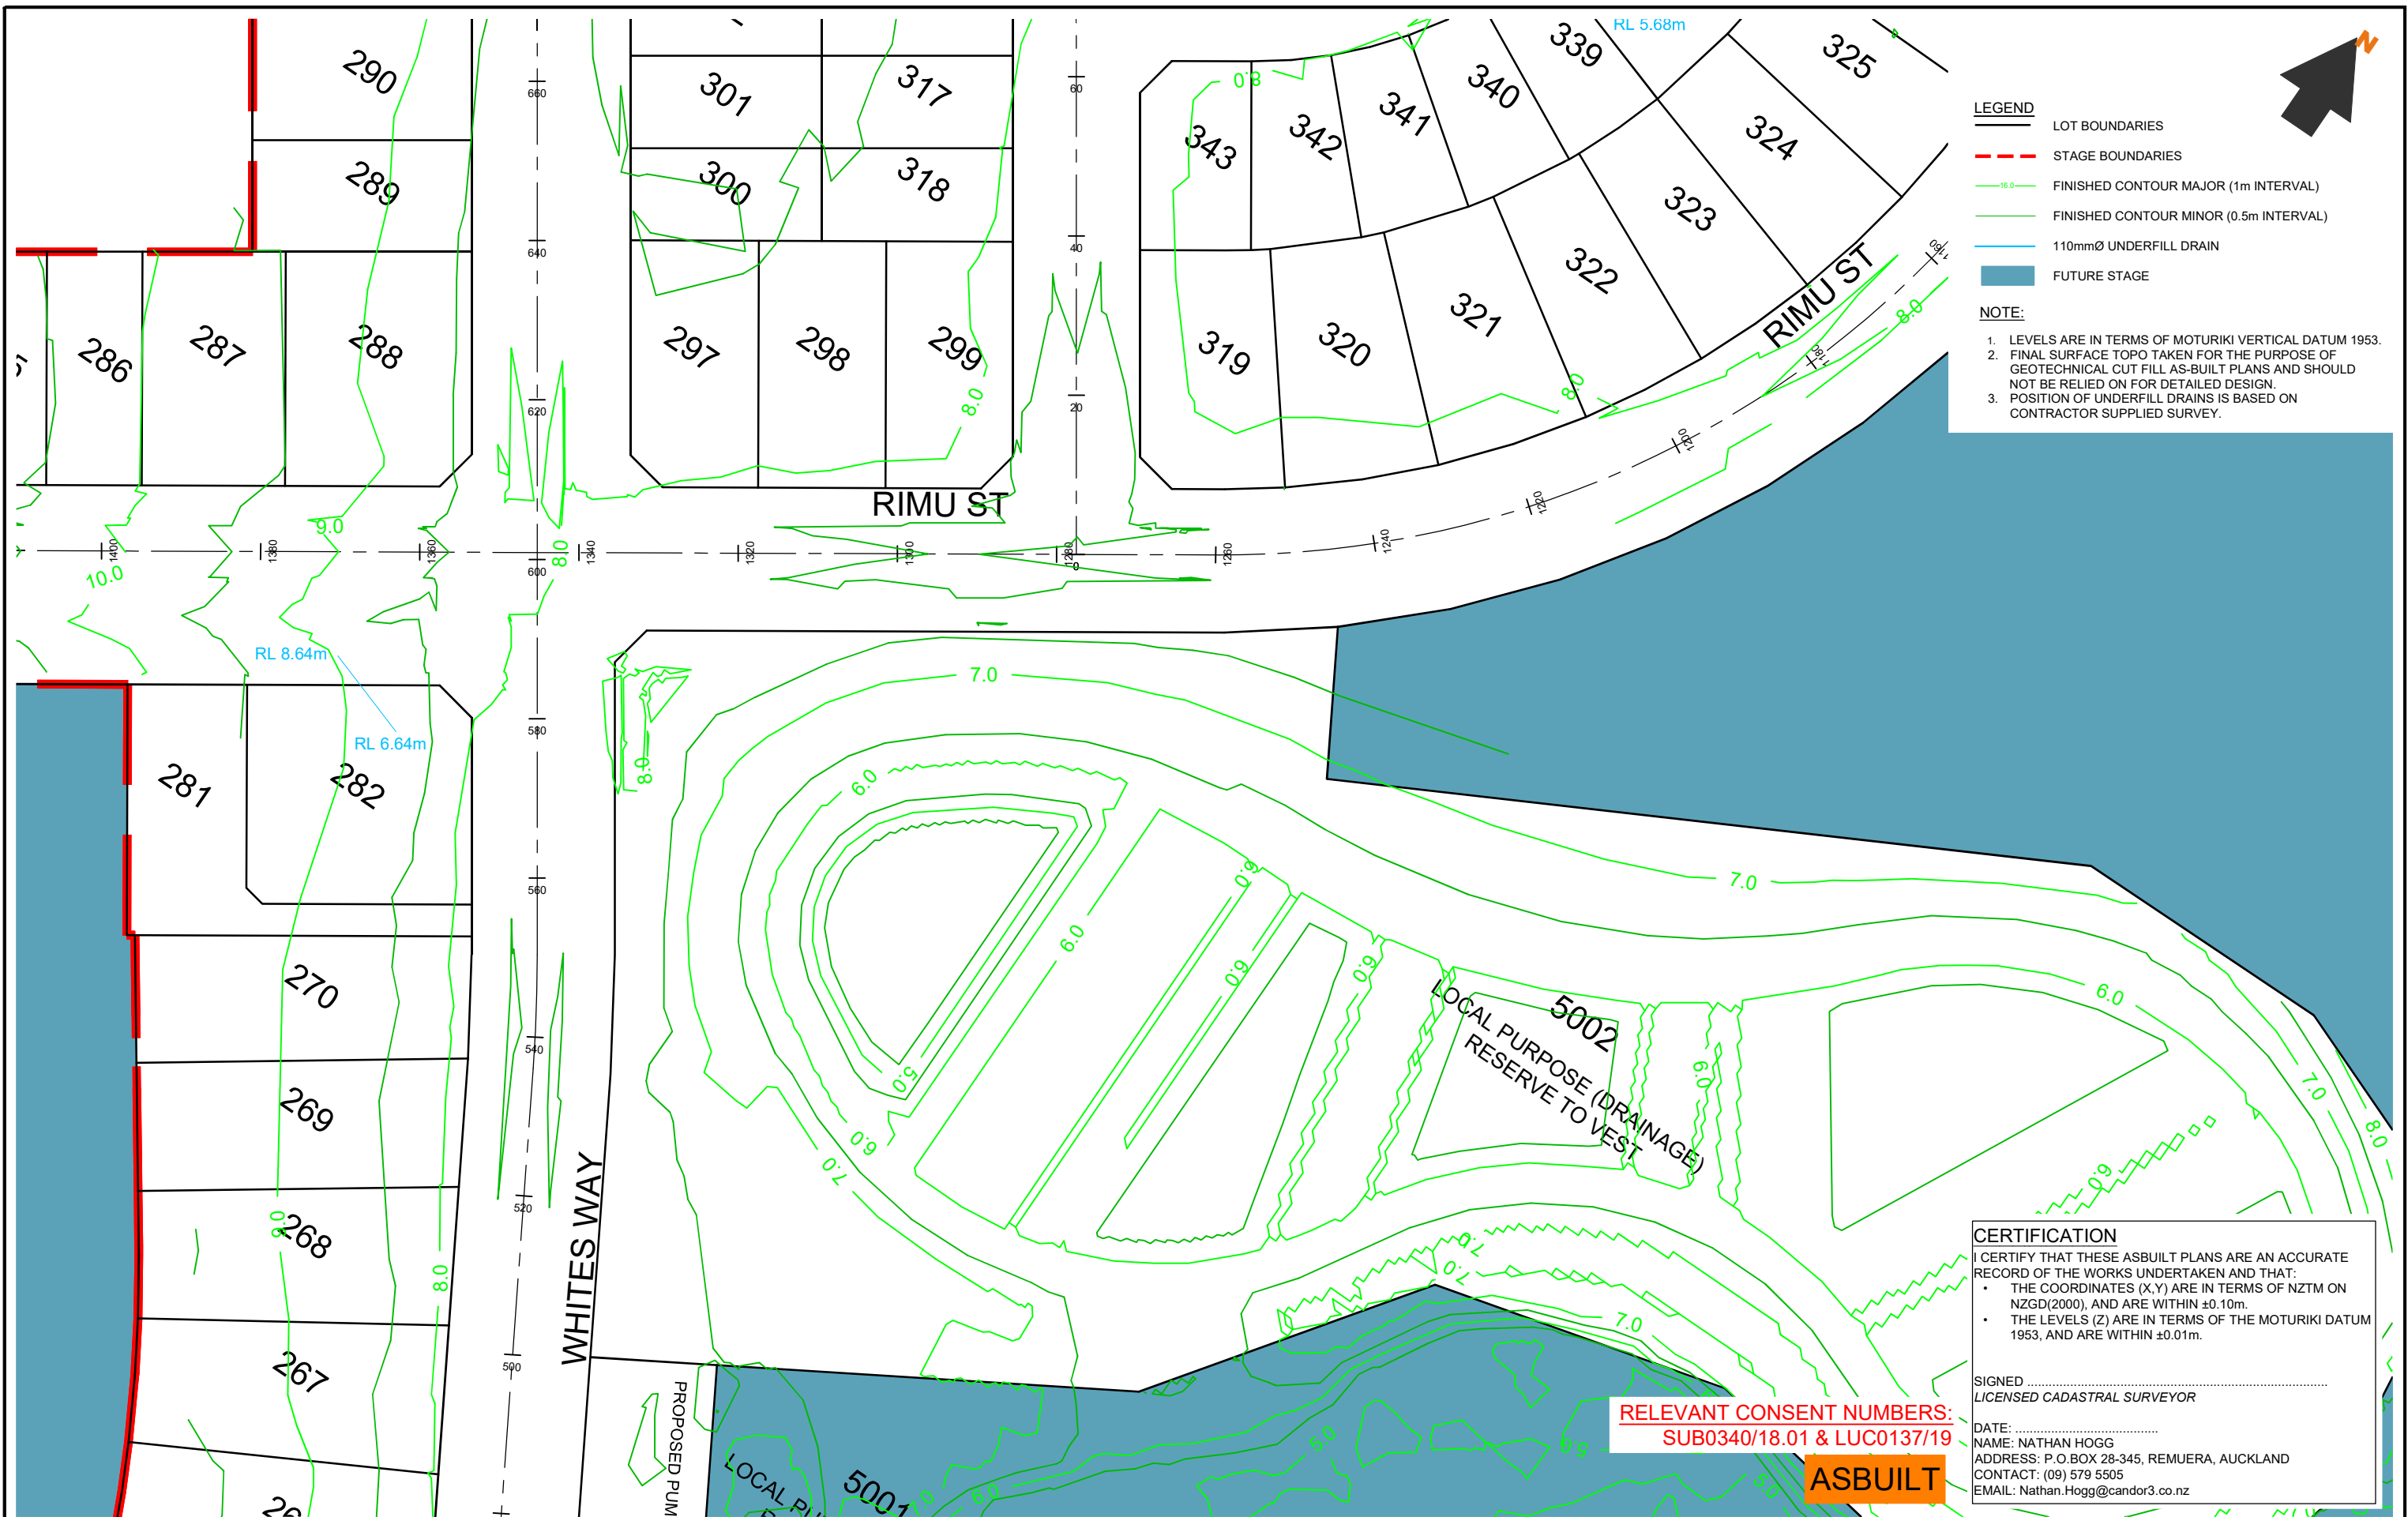

LEGEND

- LOT BOUNDARIES
- STAGE BOUNDARIES
- FINISHED CONTOUR MAJOR (1m INTERVAL)
- FINISHED CONTOUR MINOR (0.5m INTERVAL)
- 110mmØ UNDERFILL DRAIN
- FUTURE STAGE

NOTE:

- LEVELS ARE IN TERMS OF MOTURIKI VERTICAL DATUM 1953.
- FINAL SURFACE TOPO TAKEN FOR THE PURPOSE OF GEOTECHNICAL CUT FILL AS-BUILT PLANS AND SHOULD NOT BE RELIED ON FOR DETAILED DESIGN.
- POSITION OF UNDERFILL DRAINS IS BASED ON CONTRACTOR SUPPLIED SURVEY.

CERTIFICATION

I CERTIFY THAT THESE ASBUILT PLANS ARE AN ACCURATE RECORD OF THE WORKS UNDERTAKEN AND THAT:

- THE COORDINATES (X,Y) ARE IN TERMS OF NZTM ON NZGD(2000), AND ARE WITHIN ±0.10m.
- THE LEVELS (Z) ARE IN TERMS OF THE MOTURIKI DATUM 1953, AND ARE WITHIN ±0.01m.

SIGNED
LICENSED CADASTRAL SURVEYOR

DATE:
NAME: NATHAN HOGG
ADDRESS: P.O.BOX 28-345, REMUERA, AUCKLAND
CONTACT: (09) 579 5505
EMAIL: Nathan.Hogg@candor3.co.nz

RELEVANT CONSENT NUMBERS:
SUB0340/18.01 & LUC0137/19

ASBUILT

REV DESCRIPTION		BY	APPVD	DATE	PROJECT		CLIENT		PURPOSE	
					LAKESIDE, TE KAUWHATA		LAKESIDE		AS-BUILT	
					EARTHWORKS FINISHED SURFACE STAGE 1		DEVELOPMENTS 2017		DESIGN JS	
					5 OF 6		LIMITED		DRAWN JS	
									CHECK RS	
									APPROVED BY NH	
									DATE MAR 2020	
									SCALE 1:750 @ A3	
									PROJECT NO.	
									DRAWING NO.	
									REV.	
									1239	
									AB-2-204	
									-	

RELEVANT CONSENT NUMBERS:
SUB0340/18.01 & LUC0137/19

ASBUILT


CERTIFICATION
I CERTIFY THAT THESE ASBUILT PLANS ARE AN ACCURATE RECORD OF THE WORKS UNDERTAKEN AND THAT:
• THE COORDINATES (X,Y) ARE IN TERMS OF NZTM ON NZGD(2000), AND ARE WITHIN ±0.10m.
• THE LEVELS (Z) ARE IN TERMS OF THE MOTURIKI DATUM 1953, AND ARE WITHIN ±0.01m.

SIGNED
LICENSED CADASTRAL SURVEYOR

DATE:
NAME: NATHAN HOGG
ADDRESS: P.O.BOX 28-345, REMUERA, AUCKLAND
CONTACT: (09) 579 5505
EMAIL: Nathan.Hogg@candor3.co.nz

- LEGEND
- LOT BOUNDARIES
 - STAGE BOUNDARIES
 - FINISHED CONTOUR MAJOR (1m INTERVAL)
 - FINISHED CONTOUR MINOR (0.5m INTERVAL)
 - 110mmØ UNDERFILL DRAIN
 - FUTURE STAGE

- NOTE:
- LEVELS ARE IN TERMS OF MOTURIKI VERTICAL DATUM 1953.
 - FINAL SURFACE TOPO TAKEN FOR THE PURPOSE OF GEOTECHNICAL CUT FILL AS-BUILT PLANS AND SHOULD NOT BE RELIED ON FOR DETAILED DESIGN.
 - POSITION OF UNDERFILL DRAINS IS BASED ON CONTRACTOR SUPPLIED SURVEY.

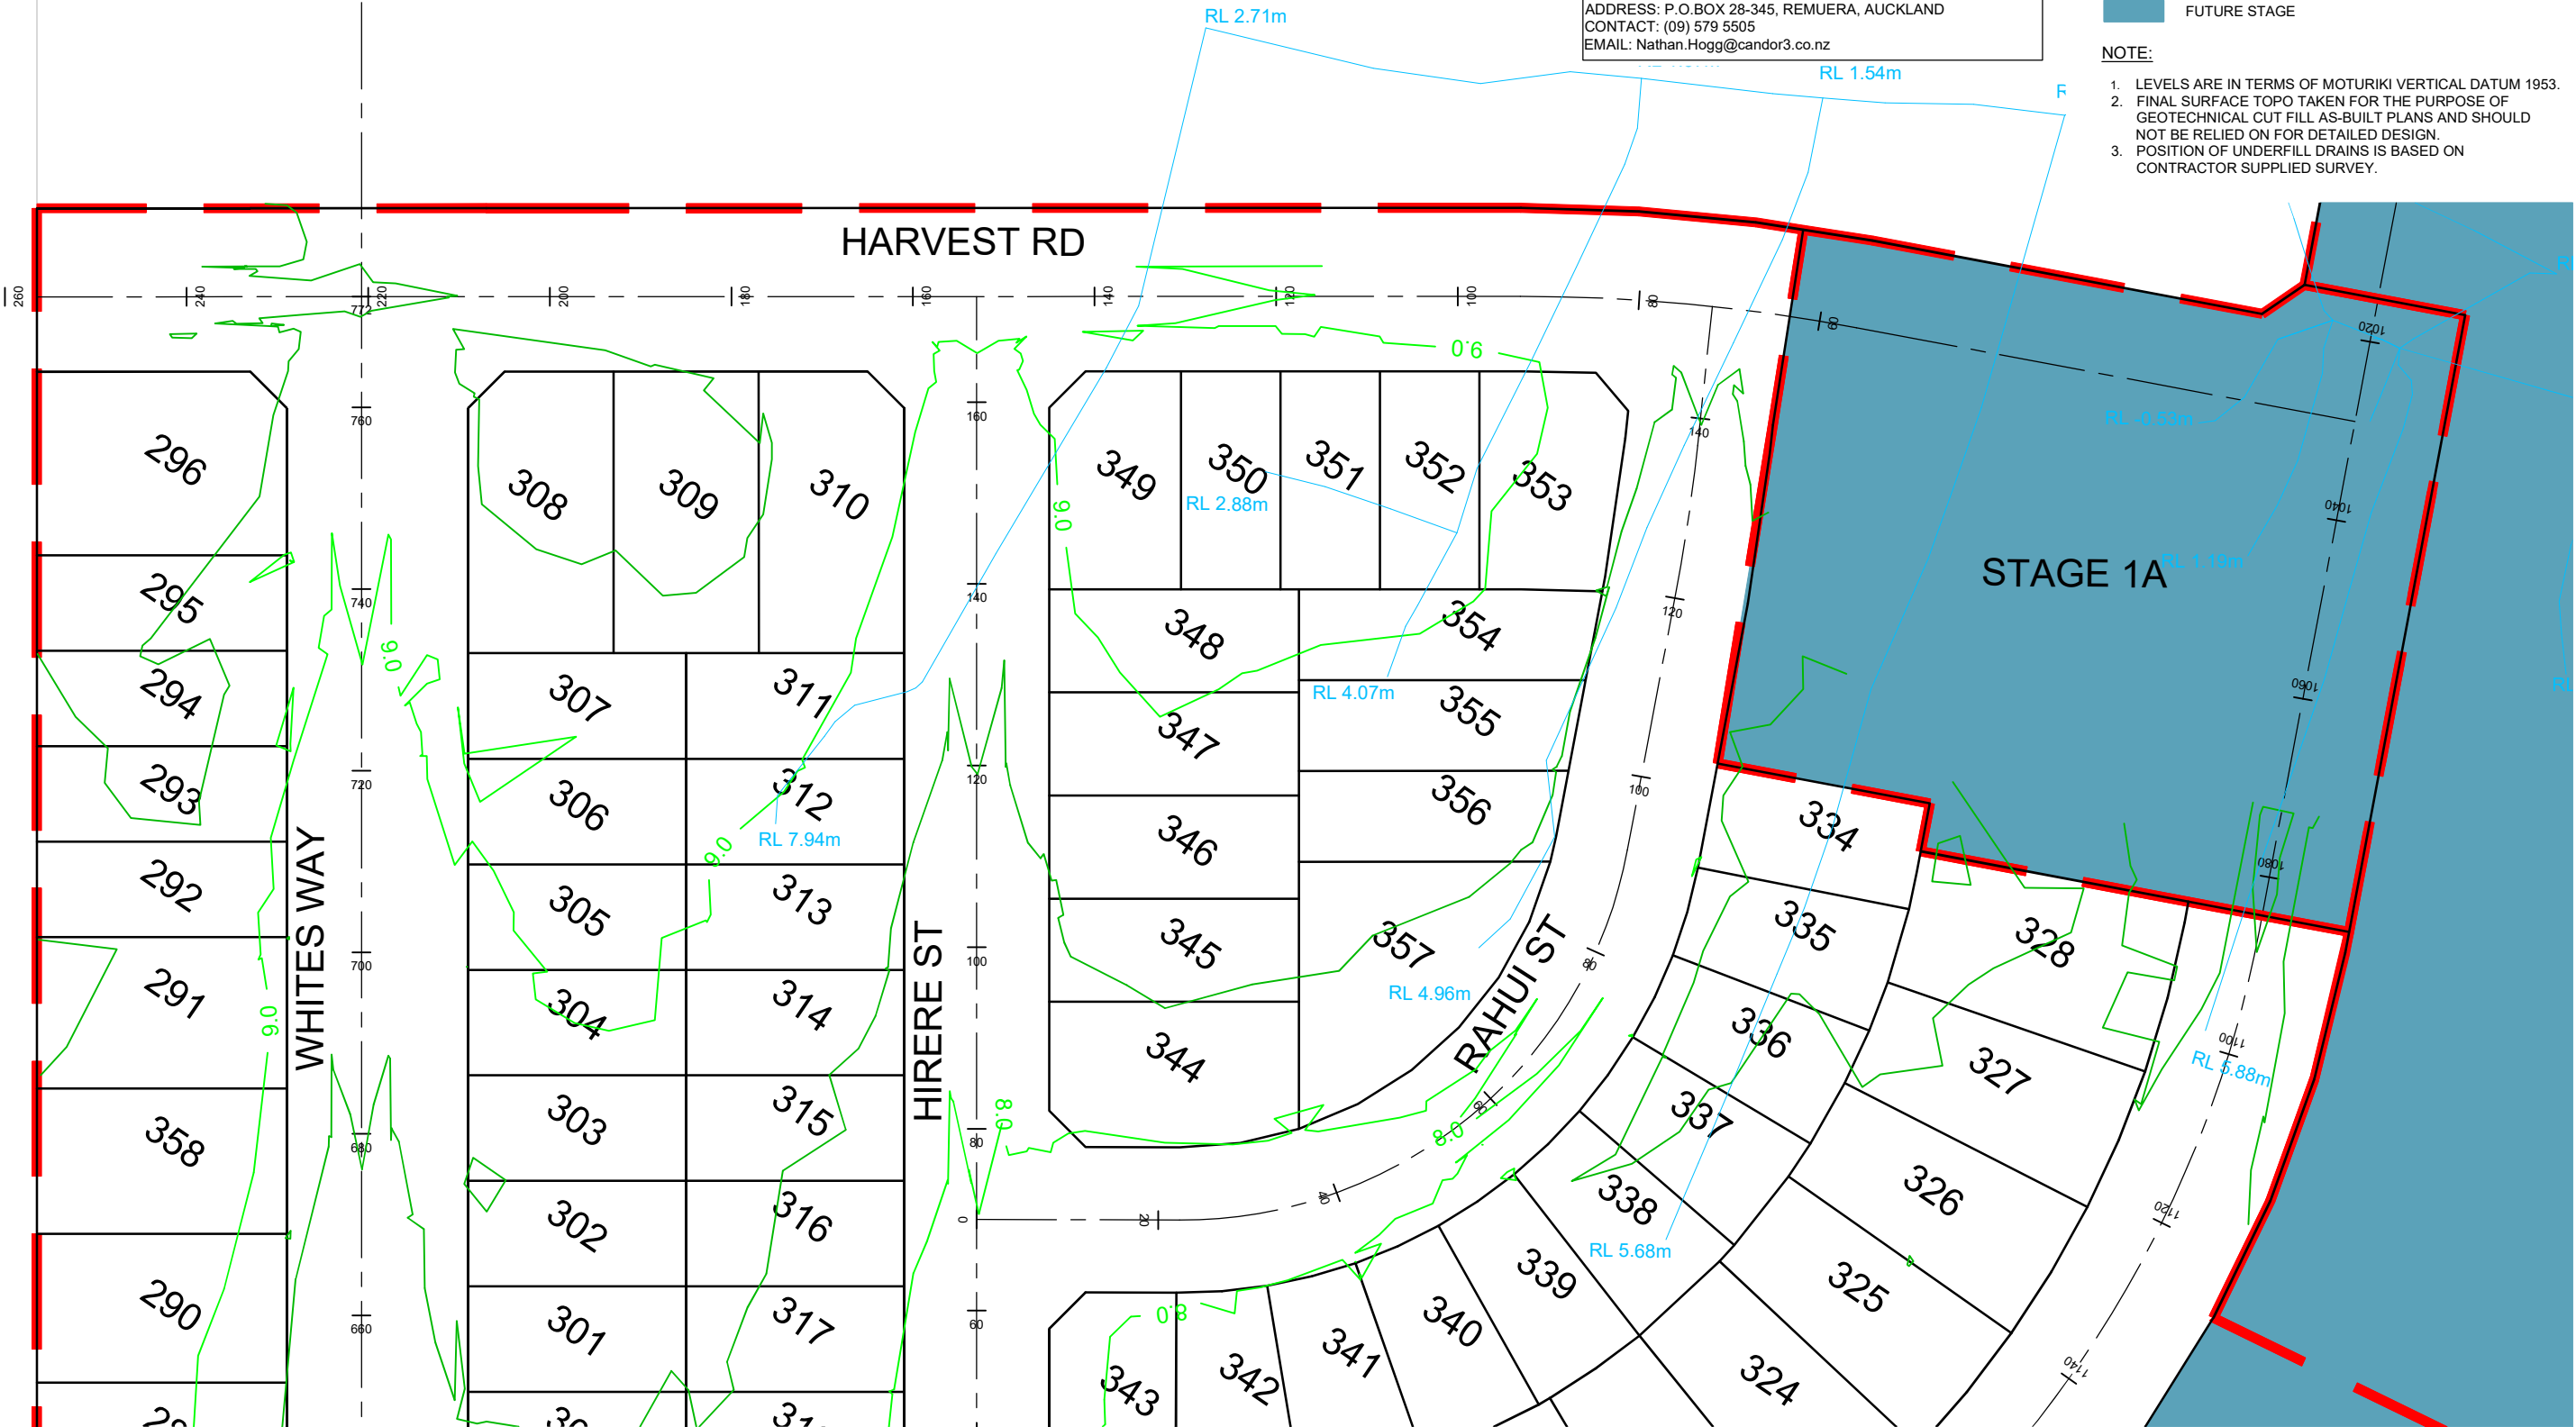

REV DESCRIPTION		BY	APPVD	DATE	PROJECT		CLIENT		PURPOSE		
					LAKESIDE, TE KAUWHATA		LAKESIDE		AS-BUILT		
					EARTHWORKS FINISHED SURFACE STAGE 1		DEVELOPMENTS 2017		DESIGN JS	APPROVED NH	SCALE
					6 OF 6		LIMITED		DRAWN JS	BY NH	1:750 @ A3
									CHECK RS	DATE MAR 2020	
									PROJECT NO. DRAWING NO. REV.		
									1239 AB-2-205 -		

Candor³
ENGINEERING FOR LIFE