

- LEGEND**
- LOT BOUNDARIES
 - STAGE BOUNDARIES
 - ROAD CENTRELINE
 - NEW WASTEWATER PIPE
 - NEW WASTEWATER LOT CONNECTION (11.8m @ CH63.37)
 - EXISTING WASTEWATER PIPE
 - ABANDONED WASTEWATER PIPE
 - WASTEWATER MANHOLE EXISTING / NEW / ABANDONED
 - FUTURE STAGE

- NOTES**
- ALL WORKS AND MATERIALS COMPLY WITH THE WAIKATO LOCAL AUTHORITY SHARED SERVICES REGIONAL INFRASTRUCTURE TECHNICAL SPECIFICATIONS (RITS) (MAY 2018).
 - MANHOLES ARE 1050mm Ø CONCRETE MANHOLES UNLESS OTHERWISE NOTED.
 - PIPE CROSSINGS UNDER ROADS AND ACCESSWAYS HAVE BEEN HARDFILL BACKFILLED.
 - LEVELS ARE IN TERMS OF THE MOTURIKI DATUM 1953.
 - ALL CO-ORDINATES ARE IN TERMS OF NZTM.
 - ALL WASTEWATER (SS) PIPES ARE 150mm Ø u-PVC SN16, UNLESS STATED OTHERWISE.

CERTIFICATION

I CERTIFY THAT THESE ASBUILT PLANS ARE AN ACCURATE RECORD OF THE WORKS UNDERTAKEN AND THAT:

- THE COORDINATES (X,Y) ARE IN TERMS OF NZTM ON NZGD(2000), AND ARE WITHIN ±0.10m.
- THE LEVELS (Z) ARE IN TERMS OF THE MOTURIKI DATUM 1953, AND ARE WITHIN ±0.01m.


SIGNED
LICENSED CADASTRAL SURVEYOR

DATE:
NAME: NATHAN HOGG
ADDRESS: P.O.BOX 28-345, REMUERA, AUCKLAND
CONTACT: (09) 579 5505
EMAIL: Nathan.Hogg@candor3.co.nz

RELEVANT CONSENT NUMBERS:
SUB0340/18.02 & LUC0137/19

ASBUILT

REV DESCRIPTION		BY	APPVD	DATE	PROJECT		CLIENT		PURPOSE		
					LAKESIDE, TE KAUPHATA		LAKESIDE		AS-BUILT		
					WASTEWATER LAYOUT STAGE 6		DEVELOPMENTS 2017		DESIGN JS	APPROVED BY NH	SCALE 1:2500 @ A3
					1 OF 4		LIMITED		CHECK RS	DATE MAR 2021	
									PROJECT NO.	DRAWING NO.	REV.
									1239	AB-5-100	-

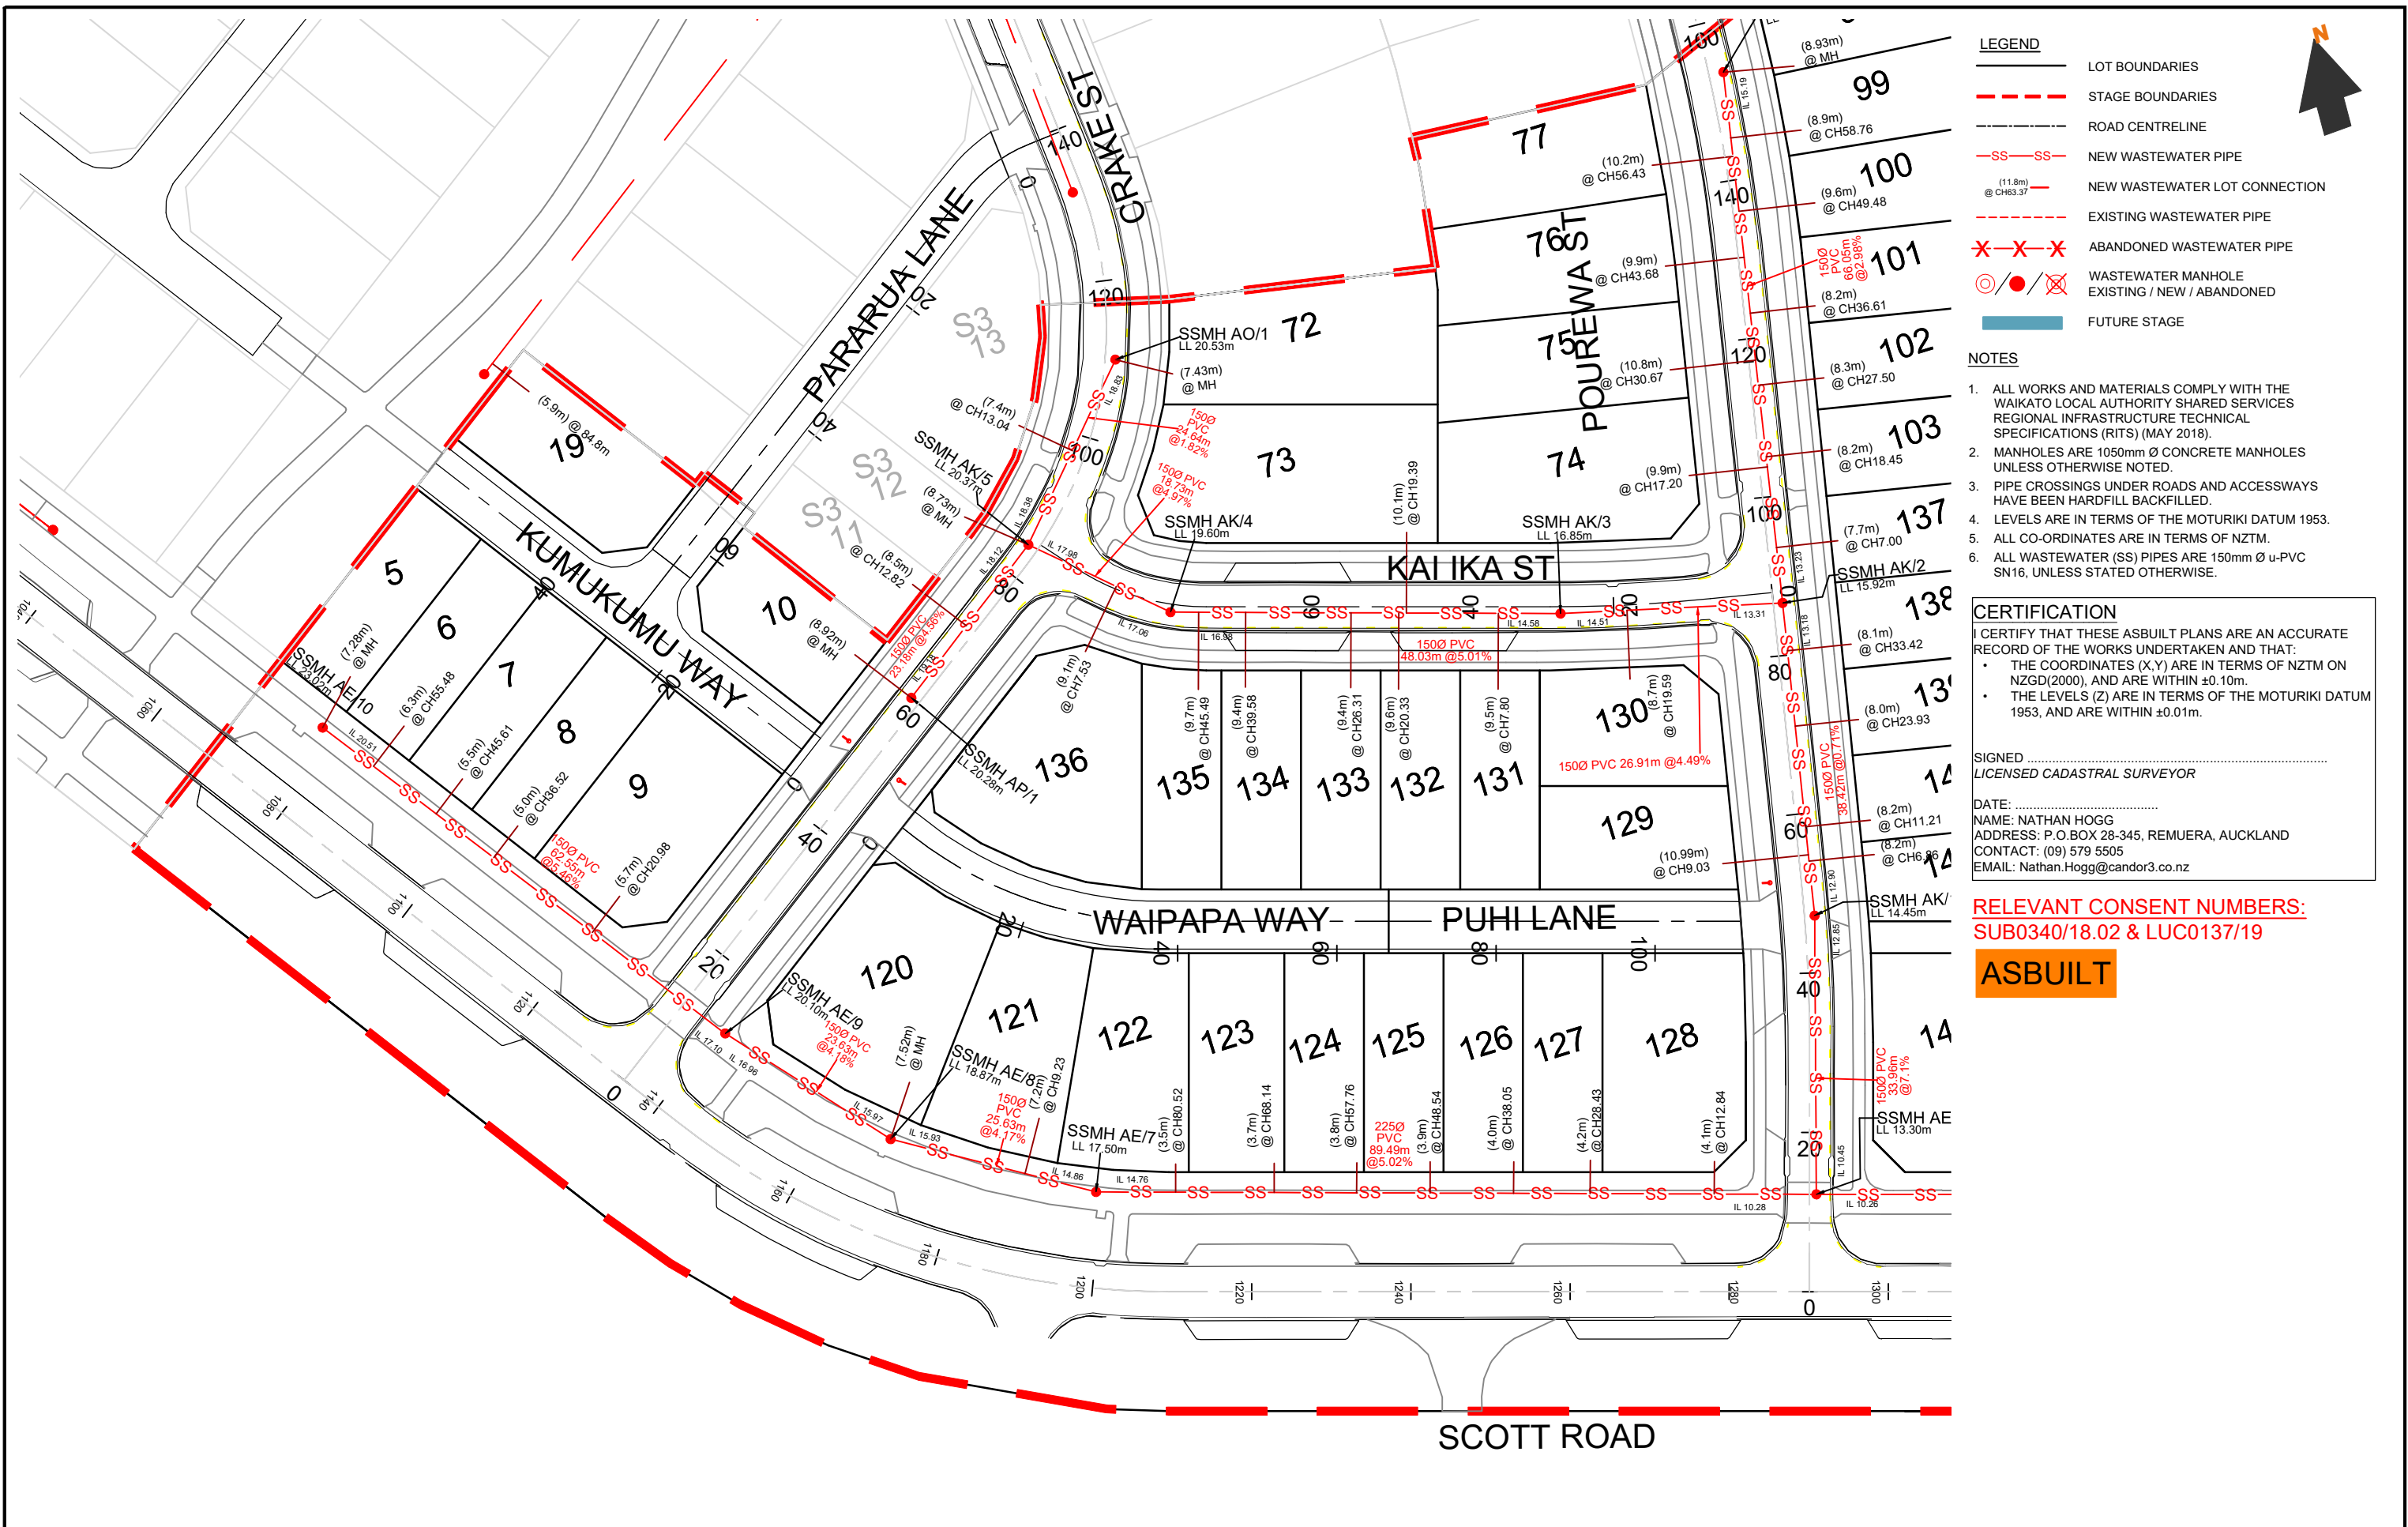

LEGEND

LOT BOUNDARIES

STAGE BOUNDARIES

ROAD CENTRELINE

NEW WASTEWATER PIPE

NEW WASTEWATER LOT CONNECTION

EXISTING WASTEWATER PIPE

ABANDONED WASTEWATER PIPE

WASTEWATER MANHOLE
EXISTING / NEW / ABANDONED

FUTURE STAGE

- NOTES
1. ALL WORKS AND MATERIALS COMPLY WITH THE WAIKATO LOCAL AUTHORITY SHARED SERVICES REGIONAL INFRASTRUCTURE TECHNICAL SPECIFICATIONS (RITS) (MAY 2018).

2. MANHOLES ARE 1050mm Ø CONCRETE MANHOLES UNLESS OTHERWISE NOTED.

3. PIPE CROSSINGS UNDER ROADS AND ACCESSWAYS HAVE BEEN HARDFILL BACKFILLED.

4. LEVELS ARE IN TERMS OF THE MOTURIKI DATUM 1953.

5. ALL CO-ORDINATES ARE IN TERMS OF NZTM.

6. ALL WASTEWATER (SS) PIPES ARE 150mm Ø u-PVC SN16, UNLESS STATED OTHERWISE.

CERTIFICATION

I CERTIFY THAT THESE ASBUILT PLANS ARE AN ACCURATE RECORD OF THE WORKS UNDERTAKEN AND THAT:

- THE COORDINATES (X,Y) ARE IN TERMS OF NZTM ON NZGD(2000), AND ARE WITHIN ±0.10m.
- THE LEVELS (Z) ARE IN TERMS OF THE MOTURIKI DATUM 1953, AND ARE WITHIN ±0.01m.


SIGNED
LICENSED CADASTRAL SURVEYOR

DATE:
NAME: NATHAN HOGG
ADDRESS: P.O.BOX 28-345, REMUERA, AUCKLAND
CONTACT: (09) 579 5505
EMAIL: Nathan.Hogg@candor3.co.nz

RELEVANT CONSENT NUMBERS:
SUB0340/18.02 & LUC0137/19

ASBUILT

REV DESCRIPTION		BY	APPVD	DATE	PROJECT		CLIENT		PURPOSE				
<div>Candor³ ENGINEERING FOR LIFE</div>					LAKESIDE, TE KAUWHATA WASTEWATER LAYOUT STAGE 6 2 OF 4		LAKESIDE DEVELOPMENTS 2017 LIMITED		AS-BUILT				
									DESIGN JS DRAWN JS CHECK RS		APPROVED BY NH DATE MAR 2021		SCALE 1:750 @ A3
									PROJECT NO.		DRAWING NO.		REV.
									1239 AB-5-101 -				

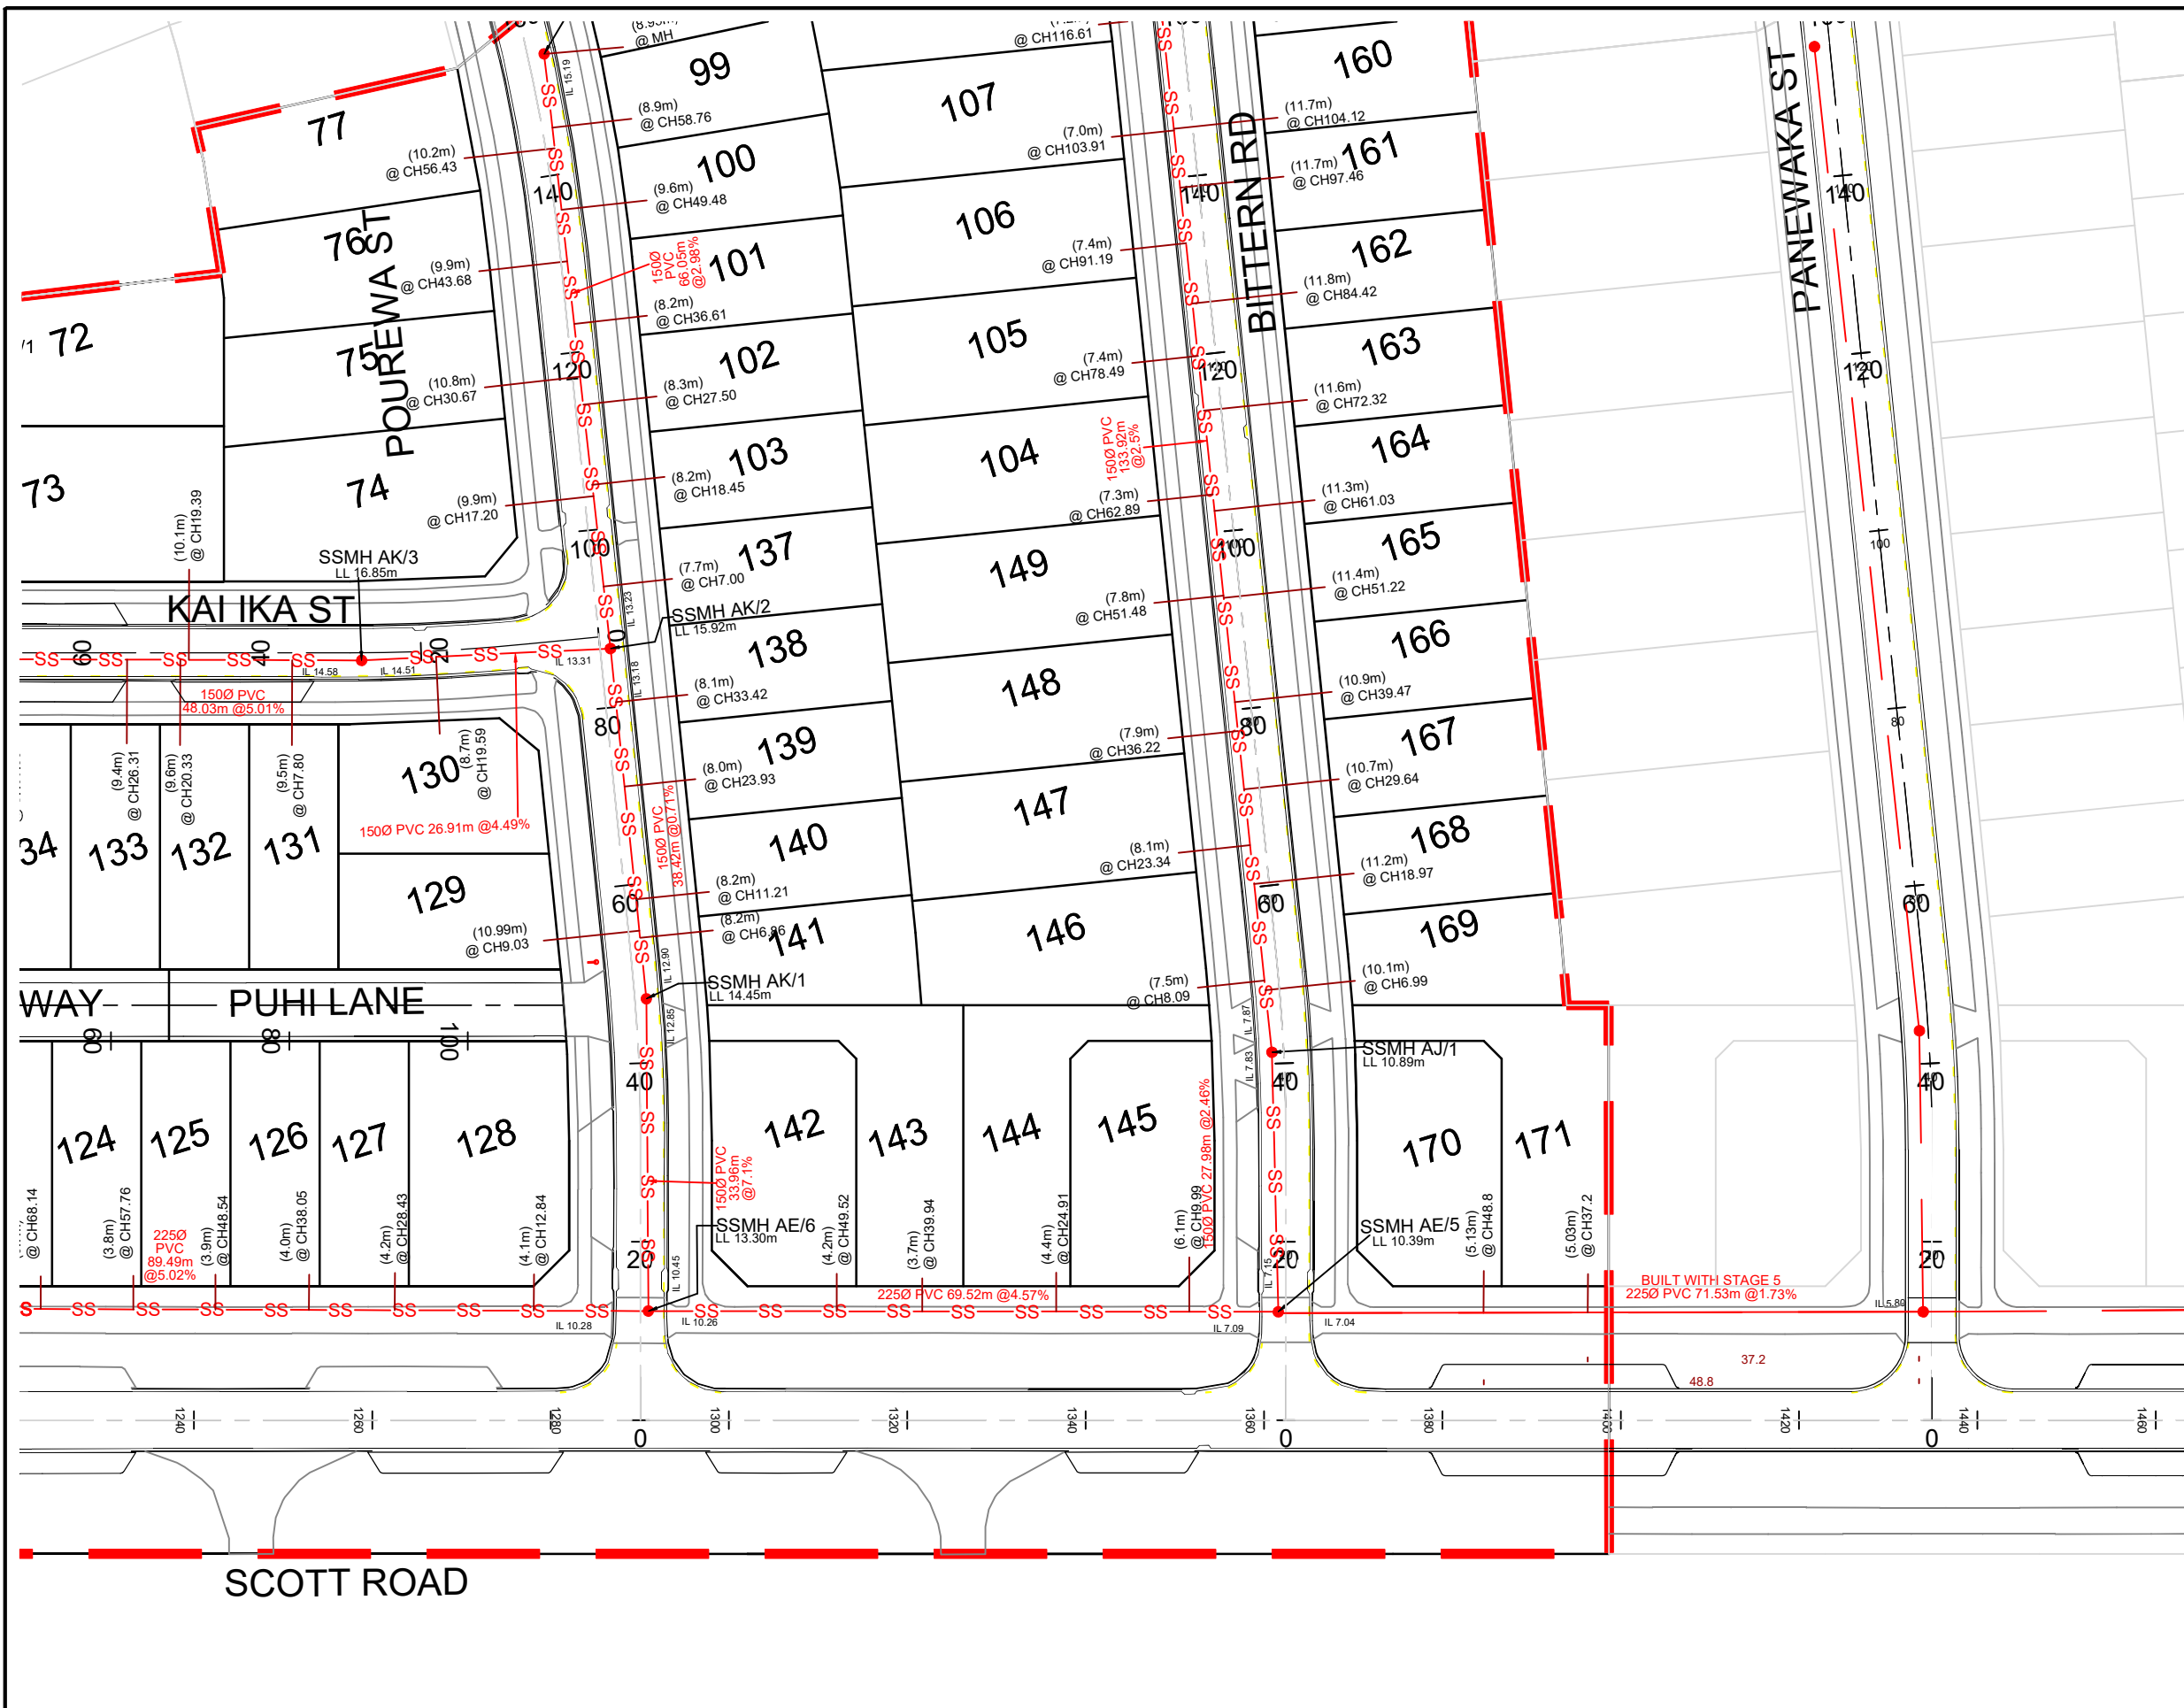

LEGEND

LOT BOUNDARIES

STAGE BOUNDARIES

ROAD CENTRELINE

NEW WASTEWATER PIPE

NEW WASTEWATER LOT CONNECTION

EXISTING WASTEWATER PIPE

ABANDONED WASTEWATER PIPE

WASTEWATER MANHOLE
EXISTING / NEW / ABANDONED

FUTURE STAGE

- NOTES**
1. ALL WORKS AND MATERIALS COMPLY WITH THE WAIKATO LOCAL AUTHORITY SHARED SERVICES REGIONAL INFRASTRUCTURE TECHNICAL SPECIFICATIONS (RITS) (MAY 2018).

2. MANHOLES ARE 1050mm Ø CONCRETE MANHOLES UNLESS OTHERWISE NOTED.

3. PIPE CROSSINGS UNDER ROADS AND ACCESSWAYS HAVE BEEN HARDFILL BACKFILLED.

4. LEVELS ARE IN TERMS OF THE MOTURIKI DATUM 1953.

5. ALL CO-ORDINATES ARE IN TERMS OF NZTM.

6. ALL WASTEWATER (SS) PIPES ARE 150mm Ø u-PVC SN16, UNLESS STATED OTHERWISE.

CERTIFICATION

I CERTIFY THAT THESE ASBUILT PLANS ARE AN ACCURATE RECORD OF THE WORKS UNDERTAKEN AND THAT:

- THE COORDINATES (X,Y) ARE IN TERMS OF NZTM ON NZGD(2000), AND ARE WITHIN ±0.10m.
- THE LEVELS (Z) ARE IN TERMS OF THE MOTURIKI DATUM 1953, AND ARE WITHIN ±0.01m.

SIGNED

LICENSED CADASTRAL SURVEYOR

DATE:

NAME: NATHAN HOGG

ADDRESS: P.O.BOX 28-345, REMUERA, AUCKLAND

CONTACT: (09) 579 5505


EMAIL: Nathan.Hogg@candor3.co.nz

RELEVANT CONSENT NUMBERS:

SUB0340/18.02 & LUC0137/19

ASBUILT

REV DESCRIPTION		BY	APPVD	DATE	PROJECT		CLIENT		PURPOSE		
					LAKESIDE, TE KAUWHATA		LAKESIDE DEVELOPMENTS 2017		AS-BUILT		
					WASTEWATER LAYOUT STAGE 6		LIMITED		DESIGN JS	APPROVED BY NH	SCALE 1:750 @ A3
					3 OF 4				CHECK RS	DATE MAR 2021	
									PROJECT NO. DRAWING NO. REV.		
									1239 AB-5-102 -		

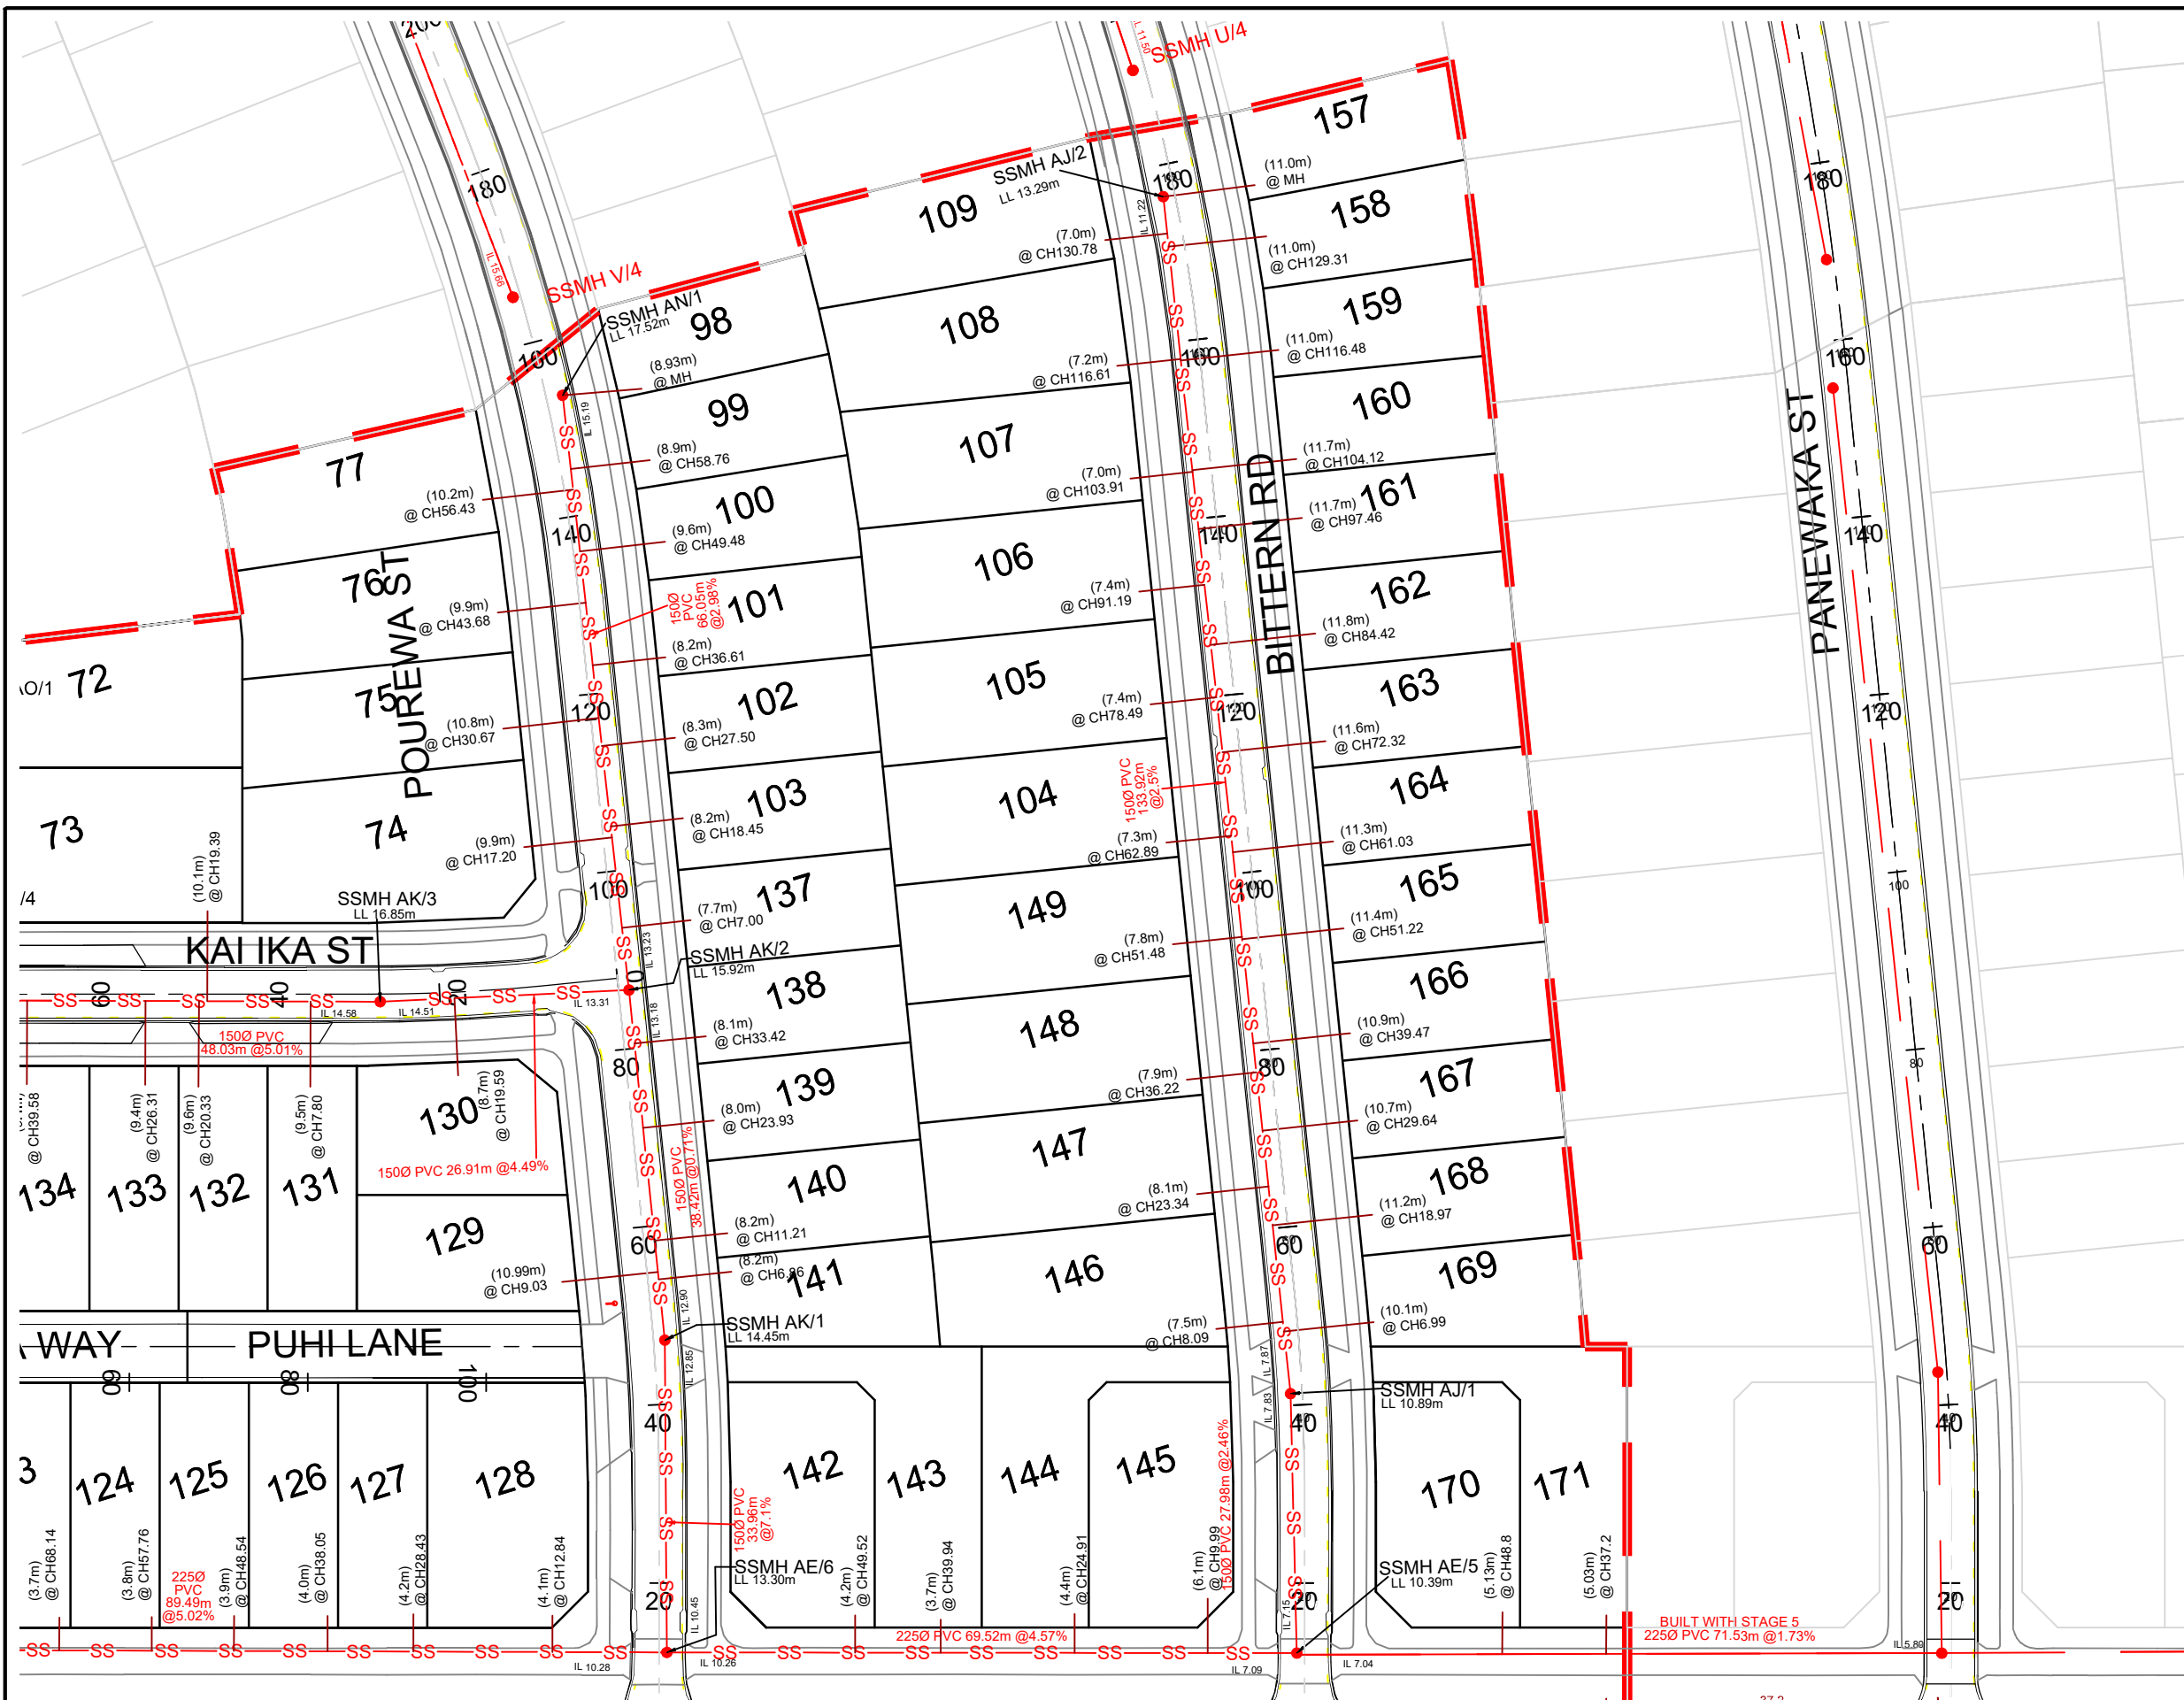

LEGEND

LOT BOUNDARIES

STAGE BOUNDARIES

ROAD CENTRELINE

NEW WASTEWATER PIPE

NEW WASTEWATER LOT CONNECTION

EXISTING WASTEWATER PIPE

ABANDONED WASTEWATER PIPE

WASTEWATER MANHOLE
EXISTING / NEW / ABANDONED

FUTURE STAGE

NOTES

1. ALL WORKS AND MATERIALS COMPLY WITH THE WAIKATO LOCAL AUTHORITY SHARED SERVICES REGIONAL INFRASTRUCTURE TECHNICAL SPECIFICATIONS (RITS) (MAY 2018).

2. MANHOLES ARE 1050mm Ø CONCRETE MANHOLES UNLESS OTHERWISE NOTED.

3. PIPE CROSSINGS UNDER ROADS AND ACCESSWAYS HAVE BEEN HARDFILL BACKFILLED.

4. LEVELS ARE IN TERMS OF THE MOTURIKI DATUM 1953.

5. ALL CO-ORDINATES ARE IN TERMS OF NZTM.

6. ALL WASTEWATER (SS) PIPES ARE 150mm Ø u-PVC SN16, UNLESS STATED OTHERWISE.

CERTIFICATION

I CERTIFY THAT THESE ASBUILT PLANS ARE AN ACCURATE RECORD OF THE WORKS UNDERTAKEN AND THAT:

• THE COORDINATES (X,Y) ARE IN TERMS OF NZTM ON NZGD(2000), AND ARE WITHIN ±0.10m.

• THE LEVELS (Z) ARE IN TERMS OF THE MOTURIKI DATUM 1953, AND ARE WITHIN ±0.01m.

SIGNED

LICENSED CADASTRAL SURVEYOR

DATE:

NAME: NATHAN HOGG

ADDRESS: P.O BOX 28-345, REMUERA, AUCKLAND

CONTACT: (09) 579 5505

EMAIL: Nathan.Hogg@candor3.co.nz

RELEVANT CONSENT NUMBERS:
SUB0340/18.02 & LUC0137/19

ASBUILT

REV DESCRIPTION		BY	APPVD	DATE	PROJECT		CLIENT		PURPOSE		
					LAKESIDE, TE KAUWHATA WASTEWATER LAYOUT STAGE 6 4 OF 4		LAKESIDE DEVELOPMENTS 2017 LIMITED		AS-BUILT		
									DESIGN JS	APPROVED BY NH	SCALE 1:750 @ A3
									CHECK RS	DATE MAR 2021	
									PROJECT NO. DRAWING NO. REV.		
									1239 AB-5-103 -		

PIT ID	NORTHING	EASTING	LID LEVEL	MH Ø(mm)
AE/5	5856804.08	1790389.14	10.39	1050
AE/6	5856826.08	1790322.00	13.30	1050
AE/7	5856854.48	1790236.05	17.50	1050
AE/8	5856868.80	1790213.56	18.87	1050
AE/9	5856887.87	1790197.93	20.10	1050
AE/10	5856940.10	1790161.77	23.02	1050
AJ/1	5856831.95	1790397.50	10.89	1050
AJ/2	5856963.94	1790425.61	13.29	1050
AK/1	5856859.43	1790332.65	14.45	1050
AK/2	5856898.01	1790341.03	15.92	1050
AK/3	5856905.41	1790314.09	16.85	1050
AK/4	5856920.79	1790267.54	19.60	1050
AK/5	5856934.39	1790253.20	20.37	1050
AN/1	5856963.69	1790354.65	17.52	1050
AO/1	5856953.10	1790270.81	20.53	1050
AP/1	5856920.67	1790233.25	20.28	1050

CERTIFICATION

I CERTIFY THAT THESE ASBUILT PLANS ARE AN ACCURATE RECORD OF THE WORKS UNDERTAKEN AND THAT:

- THE COORDINATES (X,Y) ARE IN TERMS OF NZTM ON NZGD(2000), AND ARE WITHIN ±0.10m.
- THE LEVELS (Z) ARE IN TERMS OF THE MOTURIKI DATUM 1953, AND ARE WITHIN ±0.01m.

SIGNED
LICENSED CADASTRAL SURVEYOR

DATE:
NAME: NATHAN HOGG
ADDRESS: P.O.BOX 28-345, REMUERA, AUCKLAND
CONTACT: (09) 579 5505
EMAIL: Nathan.Hogg@candor3.co.nz

RELEVANT CONSENT NUMBERS:
SUB0340/18.02 & LUC0137/19

ASBUILT

REV DESCRIPTION		BY APPVD DATE	<div>Candor³</div> <div>ENGINEERING FOR LIFE</div>	PROJECT	LAKESIDE, TE KAUWHATA WASTEWATER LAYOUT STAGE 6 COORDINATE TABLE	CLIENT	LAKESIDE DEVELOPMENTS 2017 LIMITED	PURPOSE		
								AS-BUILT		
								DESIGN JS DRAWN JS CHECK RS	APPROVED BY NH DATE MAR 2021	SCALE 1:750 @ A3
								PROJECT NO.	DRAWING NO.	REV.
								1239	AB-5-104	-