

LEGEND

—

LOT BOUNDARIES

STAGE BOUNDARIES

ROAD CENTRELINE

—SS—SS—

NEW WASTEWATER PIPE

(11.8m)
@ CH63.37

NEW WASTEWATER LOT CONNECTION

EXISTING WASTEWATER PIPE

X-X-X

ABANDONED WASTEWATER PIPE

○/●/⊗

WASTEWATER MANHOLE
EXISTING / NEW / ABANDONED

FUTURE STAGE

- NOTES**
1. ALL WORKS AND MATERIALS COMPLY WITH THE WAIKATO LOCAL AUTHORITY SHARED SERVICES REGIONAL INFRASTRUCTURE TECHNICAL SPECIFICATIONS (RITS) (MAY 2018).

2. MANHOLES ARE 1050mm Ø CONCRETE MANHOLES UNLESS OTHERWISE NOTED.

3. PIPE CROSSINGS UNDER ROADS AND ACCESSWAYS HAVE BEEN HARDFILL BACKFILLED.

4. LEVELS ARE IN TERMS OF THE MOTURIKI DATUM 1953.

5. ALL CO-ORDINATES ARE IN TERMS OF NZTM.

6. ALL WASTEWATER (SS) PIPES ARE 150mm Ø u-PVC SN16, UNLESS STATED OTHERWISE.

CERTIFICATION

I CERTIFY THAT THESE ASBUILT PLANS ARE AN ACCURATE RECORD OF THE WORKS UNDERTAKEN AND THAT:

• THE COORDINATES (X,Y) ARE IN TERMS OF NZTM ON NZGD(2000), AND ARE WITHIN ±0.10m.

• THE LEVELS (Z) ARE IN TERMS OF THE MOTURIKI DATUM 1953, AND ARE WITHIN ±0.01m.

SIGNED
LICENSED CADASTRAL SURVEYOR

DATE:
NAME: NATHAN HOGG
ADDRESS: P.O.BOX 28-345, REMUERA, AUCKLAND
CONTACT: (09) 579 5505
EMAIL: Nathan.Hogg@candor3.co.nz

RELEVANT CONSENT NUMBERS:
SUB0340/18.02 & LUC0137/19

ASBUILT

REV DESCRIPTION		BY	APPVD	DATE	PROJECT		CLIENT		PURPOSE		
<div>Candor³ ENGINEERING FOR LIFE</div>					LAKESIDE, TE KAUWHATA WASTEWATER LAYOUT STAGE 4 1 OF 3		LAKESIDE DEVELOPMENTS 2017 LIMITED		AS-BUILT		
DESIGN JS		APPROVED BY NH		SCALE 1:2500 @ A3		PROJECT NO.	DRAWING NO.	REV.			
DRAWN JS		DATE SEP 2020									
CHECK RS						1239	AB-5-100	-			

- LEGEND**
- LOT BOUNDARIES
 - STAGE BOUNDARIES
 - ROAD CENTRELINE
 - NEW WASTEWATER PIPE
 - NEW WASTEWATER LOT CONNECTION
(11.8m)
@ CH63.37
 - EXISTING WASTEWATER PIPE
 - ABANDONED WASTEWATER PIPE
 - WASTEWATER MANHOLE
EXISTING / NEW / ABANDONED
 - FUTURE STAGE

NOTES

- ALL WORKS AND MATERIALS COMPLY WITH THE WAIKATO LOCAL AUTHORITY SHARED SERVICES REGIONAL INFRASTRUCTURE TECHNICAL SPECIFICATIONS (RITS) (MAY 2018).
- MANHOLES ARE 1050mm Ø CONCRETE MANHOLES UNLESS OTHERWISE NOTED.
- PIPE CROSSINGS UNDER ROADS AND ACCESSWAYS HAVE BEEN HARDFILL BACKFILLED.
- LEVELS ARE IN TERMS OF THE MOTURIKI DATUM 1953.
- ALL CO-ORDINATES ARE IN TERMS OF NZTM.
- ALL WASTEWATER (SS) PIPES ARE 150mm Ø u-PVC SN16, UNLESS STATED OTHERWISE.

CERTIFICATION

I CERTIFY THAT THESE ASBUILT PLANS ARE AN ACCURATE RECORD OF THE WORKS UNDERTAKEN AND THAT:


- THE COORDINATES (X,Y) ARE IN TERMS OF NZTM ON NZGD(2000), AND ARE WITHIN ±0.10m.
- THE LEVELS (Z) ARE IN TERMS OF THE MOTURIKI DATUM 1953, AND ARE WITHIN ±0.01m.

SIGNED
LICENSED CADASTRAL SURVEYOR

DATE:
NAME: NATHAN HOGG
ADDRESS: P.O.BOX 28-345, REMUERA, AUCKLAND
CONTACT: (09) 579 5505
EMAIL: Nathan.Hogg@candor3.co.nz

RELEVANT CONSENT NUMBERS:
SUB0340/18.02 & LUC0137/19

ASBUILT

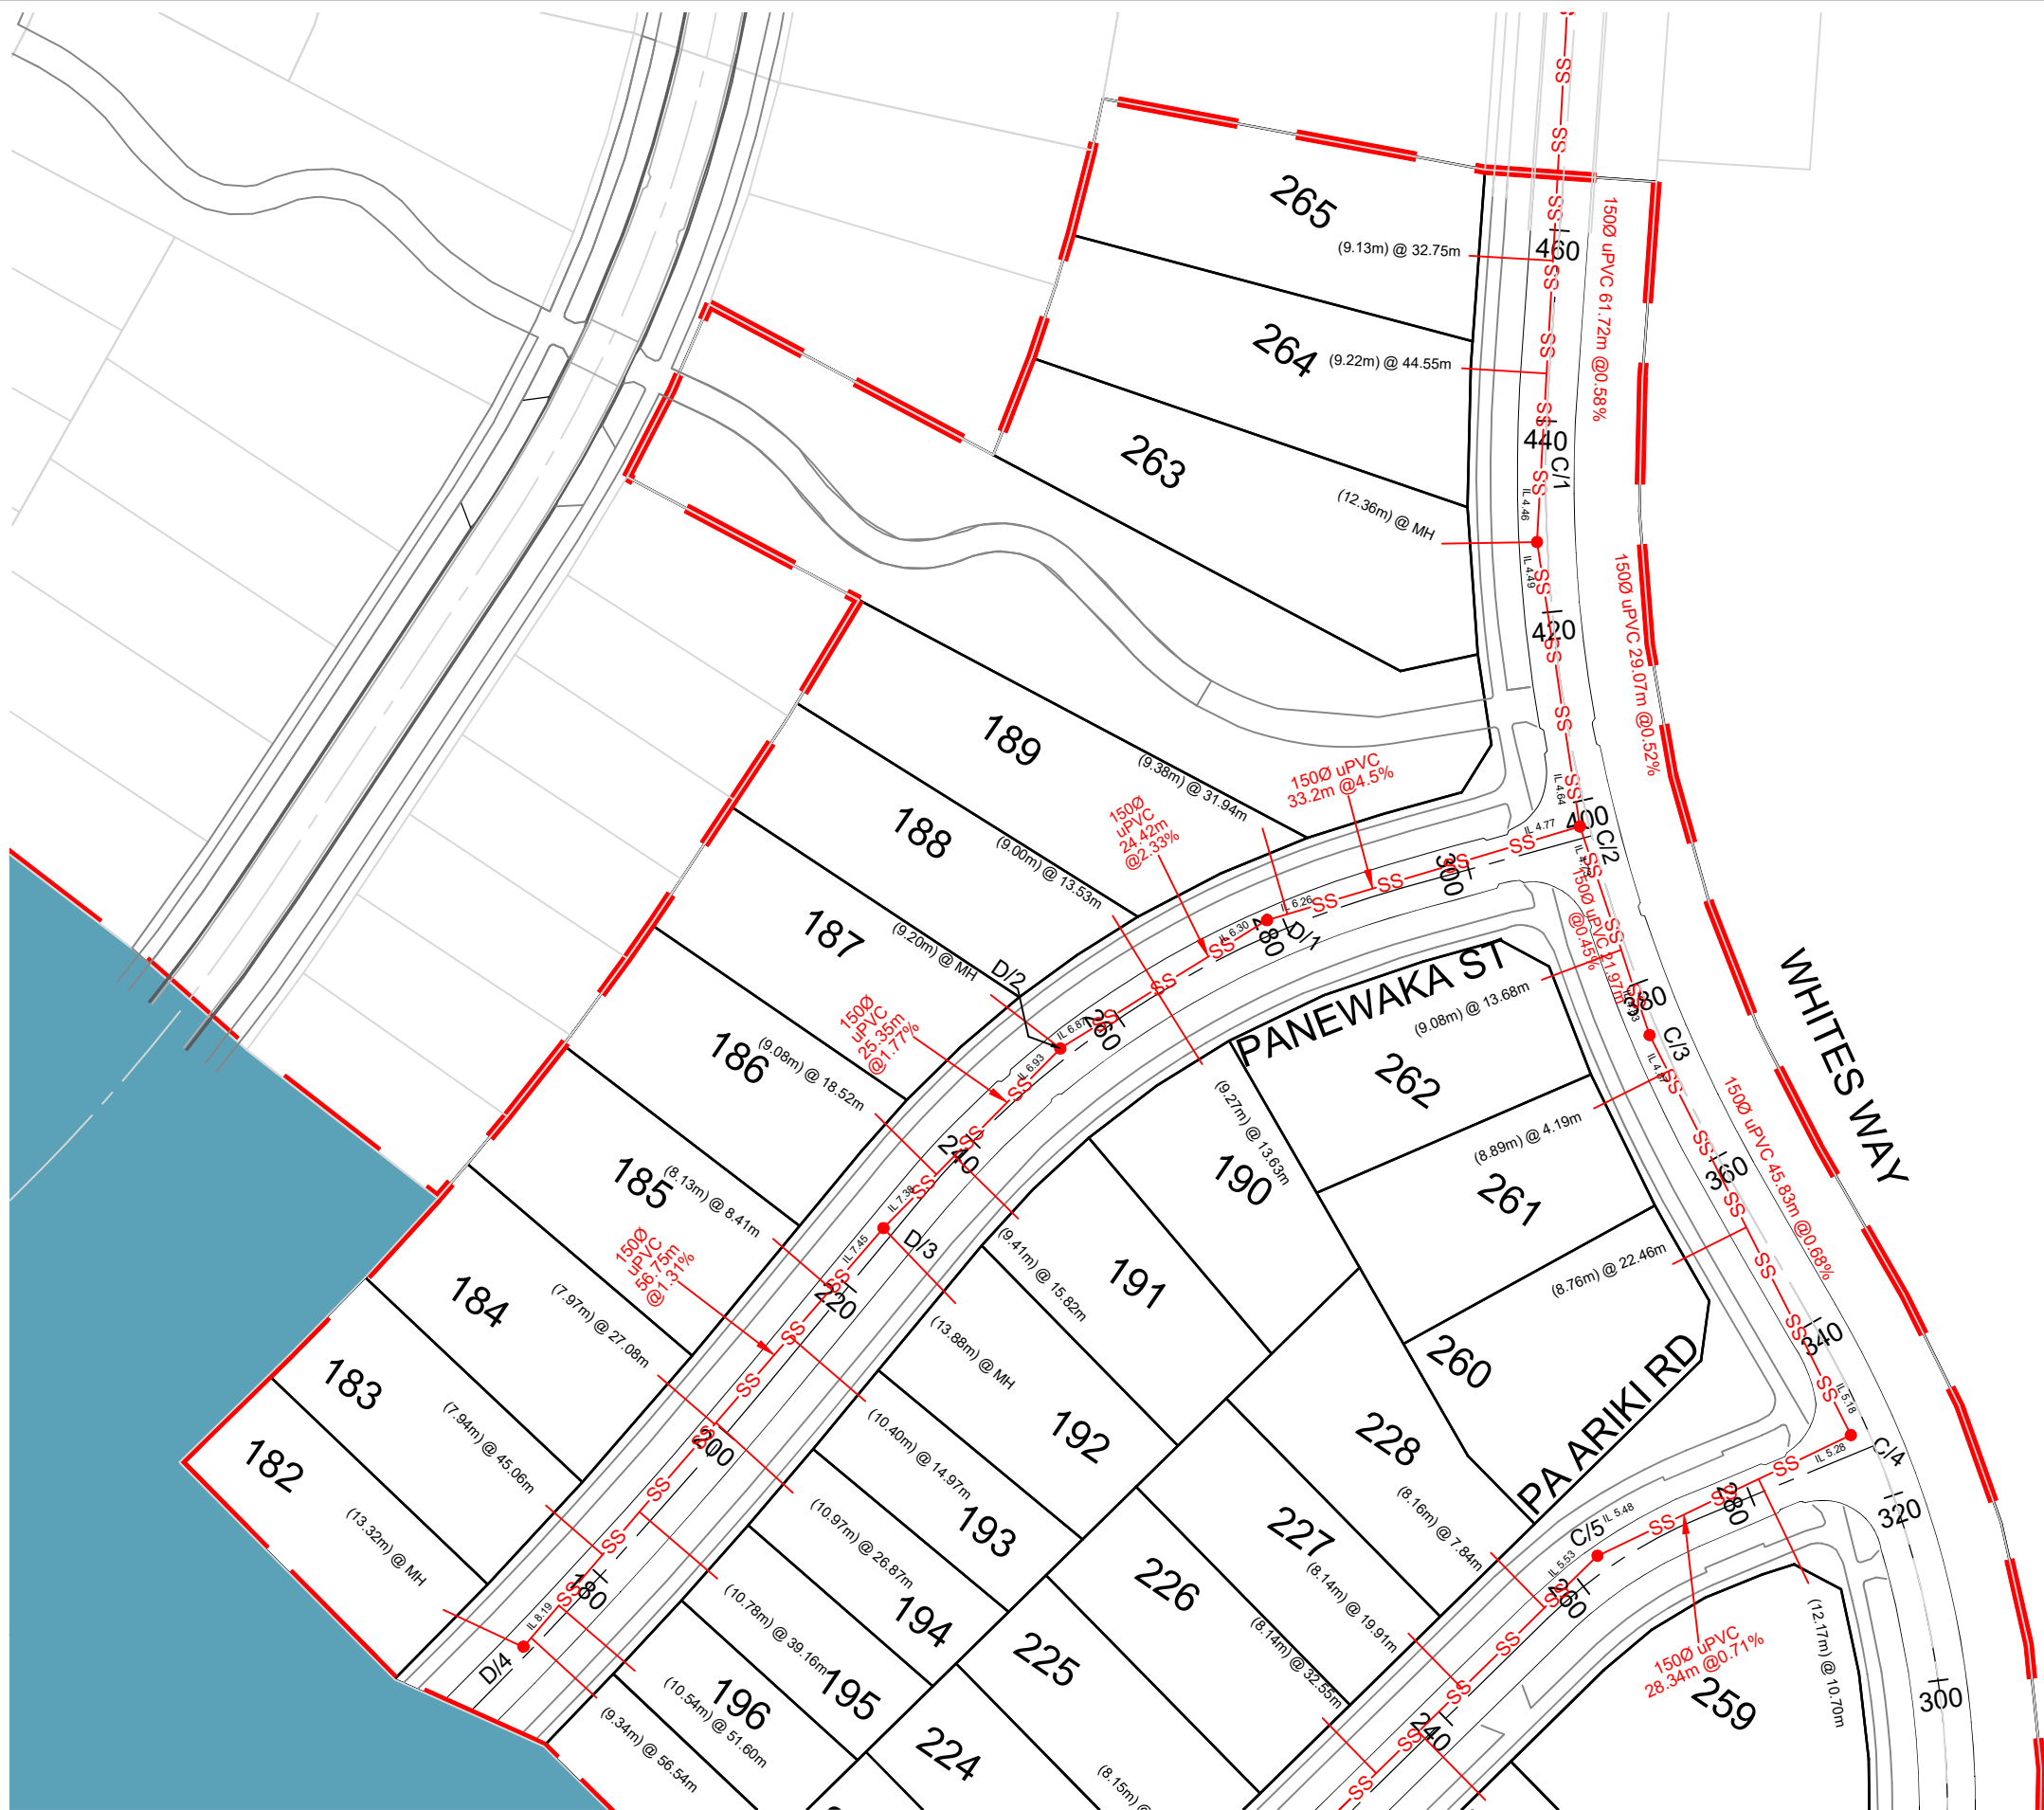

REV	DESCRIPTION	BY	APPVD	DATE
-----	-------------	----	-------	------

Candor³
ENGINEERING FOR LIFE

PROJECT

LAKESIDE, TE KAUPHATA
WASTEWATER LAYOUT STAGE 4
2 OF 3

CLIENT

LAKESIDE
DEVELOPMENTS 2017
LIMITED

PURPOSE

AS-BUILT

DESIGN	JS	APPROVED	BY	SCALE
DRAWN	JS	BY	NH	1:750 @ A3
CHECK	RS	DATE	SEP 2020	

PROJECT NO.	DRAWING NO.	REV.
-------------	-------------	------

1239	AB-5-101	-
------	----------	---



REV	DESCRIPTION	BY	APPVD	DATE	PROJECT	CLIENT	PURPOSE
					LAKESIDE, TE KAUPHATA WASTEWATER LAYOUT STAGE 4 3 OF 3	LAKESIDE DEVELOPMENTS 2017 LIMITED	AS-BUILT
							DESIGN JS DRAWN JS CHECK RS
							APPROVED BY NH DATE SEP 2020
							SCALE 1:750 @ A3
							PROJECT NO. 1239
							DRAWING NO. AB-5-102
							REV. -

PIT ID	NORTHING	EASTING	LID LEVEL	MH Ø(mm)
C/1	5857089.05	1790519.54	7.60	1050
C/2	5857066.59	1790539.62	7.52	1050
C/3	5857052.32	1790557.68	7.63	1050
C/4	5857028.85	1790598.27	7.84	1050
C/5	5857003.73	1790582.99	7.78	1050
C/6	5856907.70	1790562.11	8.34	1050
D/1	5857040.43	1790517.57	8.30	1050
D/2	5857017.34	1790506.82	9.12	1050
D/3	5856991.45	1790501.64	9.55	1050
D/4	5856934.14	1790494.11	10.13	1050

CERTIFICATION

I CERTIFY THAT THESE ASBUILT PLANS ARE AN ACCURATE
RECORD OF THE WORKS UNDERTAKEN AND THAT:

- THE COORDINATES (X,Y) ARE IN TERMS OF NZTM ON NZGD(2000), AND ARE WITHIN $\pm 0.10\text{m}$.
- THE LEVELS (Z) ARE IN TERMS OF THE MOTURIKI DATUM 1953, AND ARE WITHIN $\pm 0.01\text{m}$.

SIGNED
LICENSED CADASTRAL SURVEYOR

DATE:
NAME: NATHAN HOGG
ADDRESS: P.O.BOX 28-345, REMUERA, AUCKLAND
CONTACT: (09) 579 5505
EMAIL: Nathan.Hogg@candor3.co.nz

RELEVANT CONSENT NUMBERS:
SUB0340/18.02 & LUC0137/19

ASBUILT

REV DESCRIPTION					BY	APPVD	DATE	<div>Candor³ ENGINEERING FOR LIFE</div>	PROJECT	LAKESIDE, TE KAUWHATA WASTEWATER LAYOUT STAGE 4 COORDINATE TABLE	CLIENT	LAKESIDE DEVELOPMENTS 2017 LIMITED	PURPOSE		
													AS-BUILT		
DESIGN	JS	APPROVED BY DATE	JS	NH SEP 2020	SCALE N/A										
DRAWN	JS		RS												
CHECK	RS														
PROJECT NO.								DRAWING NO.		REV.					
1239								AB-5-103		-					