

LEGEND

LOT BOUNDARIES

STAGE BOUNDARIES

EXISTING SURFACE CONTOUR MAJOR (1m INTERVAL)

EXISTING SURFACE CONTOUR MINOR (0.5m INTERVAL)

FUTURE STAGE

- NOTE:
1. LEVELS ARE IN TERMS OF MOTURIKI VERTICAL DATUM 1953.

2. ALL CO-ORDINATES ARE IN TERMS OF NZTM.

3. EXISTING SURFACE TOPO IS TAKEN FOR THE PURPOSE OF GEOTECHNICAL CUT FILL AS-BUILT PLANS AND SHOULD NOT BE RELIED ON FOR DETAILED DESIGN.

4. EXISTING CONTOURS SHOWN ARE PRIOR TO STAGES 1 TO 7 EARTHWORKS STARTING. CONTOURS PROVIDED ARE CIRCA SEPTEMBER 2018.

CERTIFICATION

I CERTIFY THAT THESE ASBUILT PLANS ARE AN ACCURATE RECORD OF THE WORKS UNDERTAKEN AND THAT:

THE COORDINATES (X,Y) ARE IN TERMS OF NZTM ON NZGD(2000), AND ARE WITHIN ±50mm.

THE LEVELS (Z) ARE IN TERMS OF THE MOTURIKI DATUM 1953 LINZ DATUM, AND ARE WITHIN ±25mm.

SIGNED

LICENSED CADASTRAL SURVEYOR

DATE:

NAME: NATHAN HOGG

ADDRESS: P.O.BOX 28-345, REMUERA, AUCKLAND


CONTACT: (09) 579 5505

EMAIL: Nathan.Hogg@candor3.co.nz

RELEVANT CONSENT NUMBERS:
SUB0340/18.02 & LUC0137/19

ASBUILT

REV DESCRIPTION		BY	APPVD	DATE	PROJECT		CLIENT		PURPOSE		
					LAKESIDE, TE KAUPHATA		LAKESIDE		AS-BUILT		
					EARTHWORKS EXISTING SURFACE STAGE 6		DEVELOPMENTS 2017		DESIGN JS	APPROVED BY NH	SCALE 1:2500 @ A3
					SHEET 1 OF 4		LIMITED		CHECK RS	DATE MAR 2021	
									PROJECT NO.	DRAWING NO.	REV.
									1239	AB-2-100	-

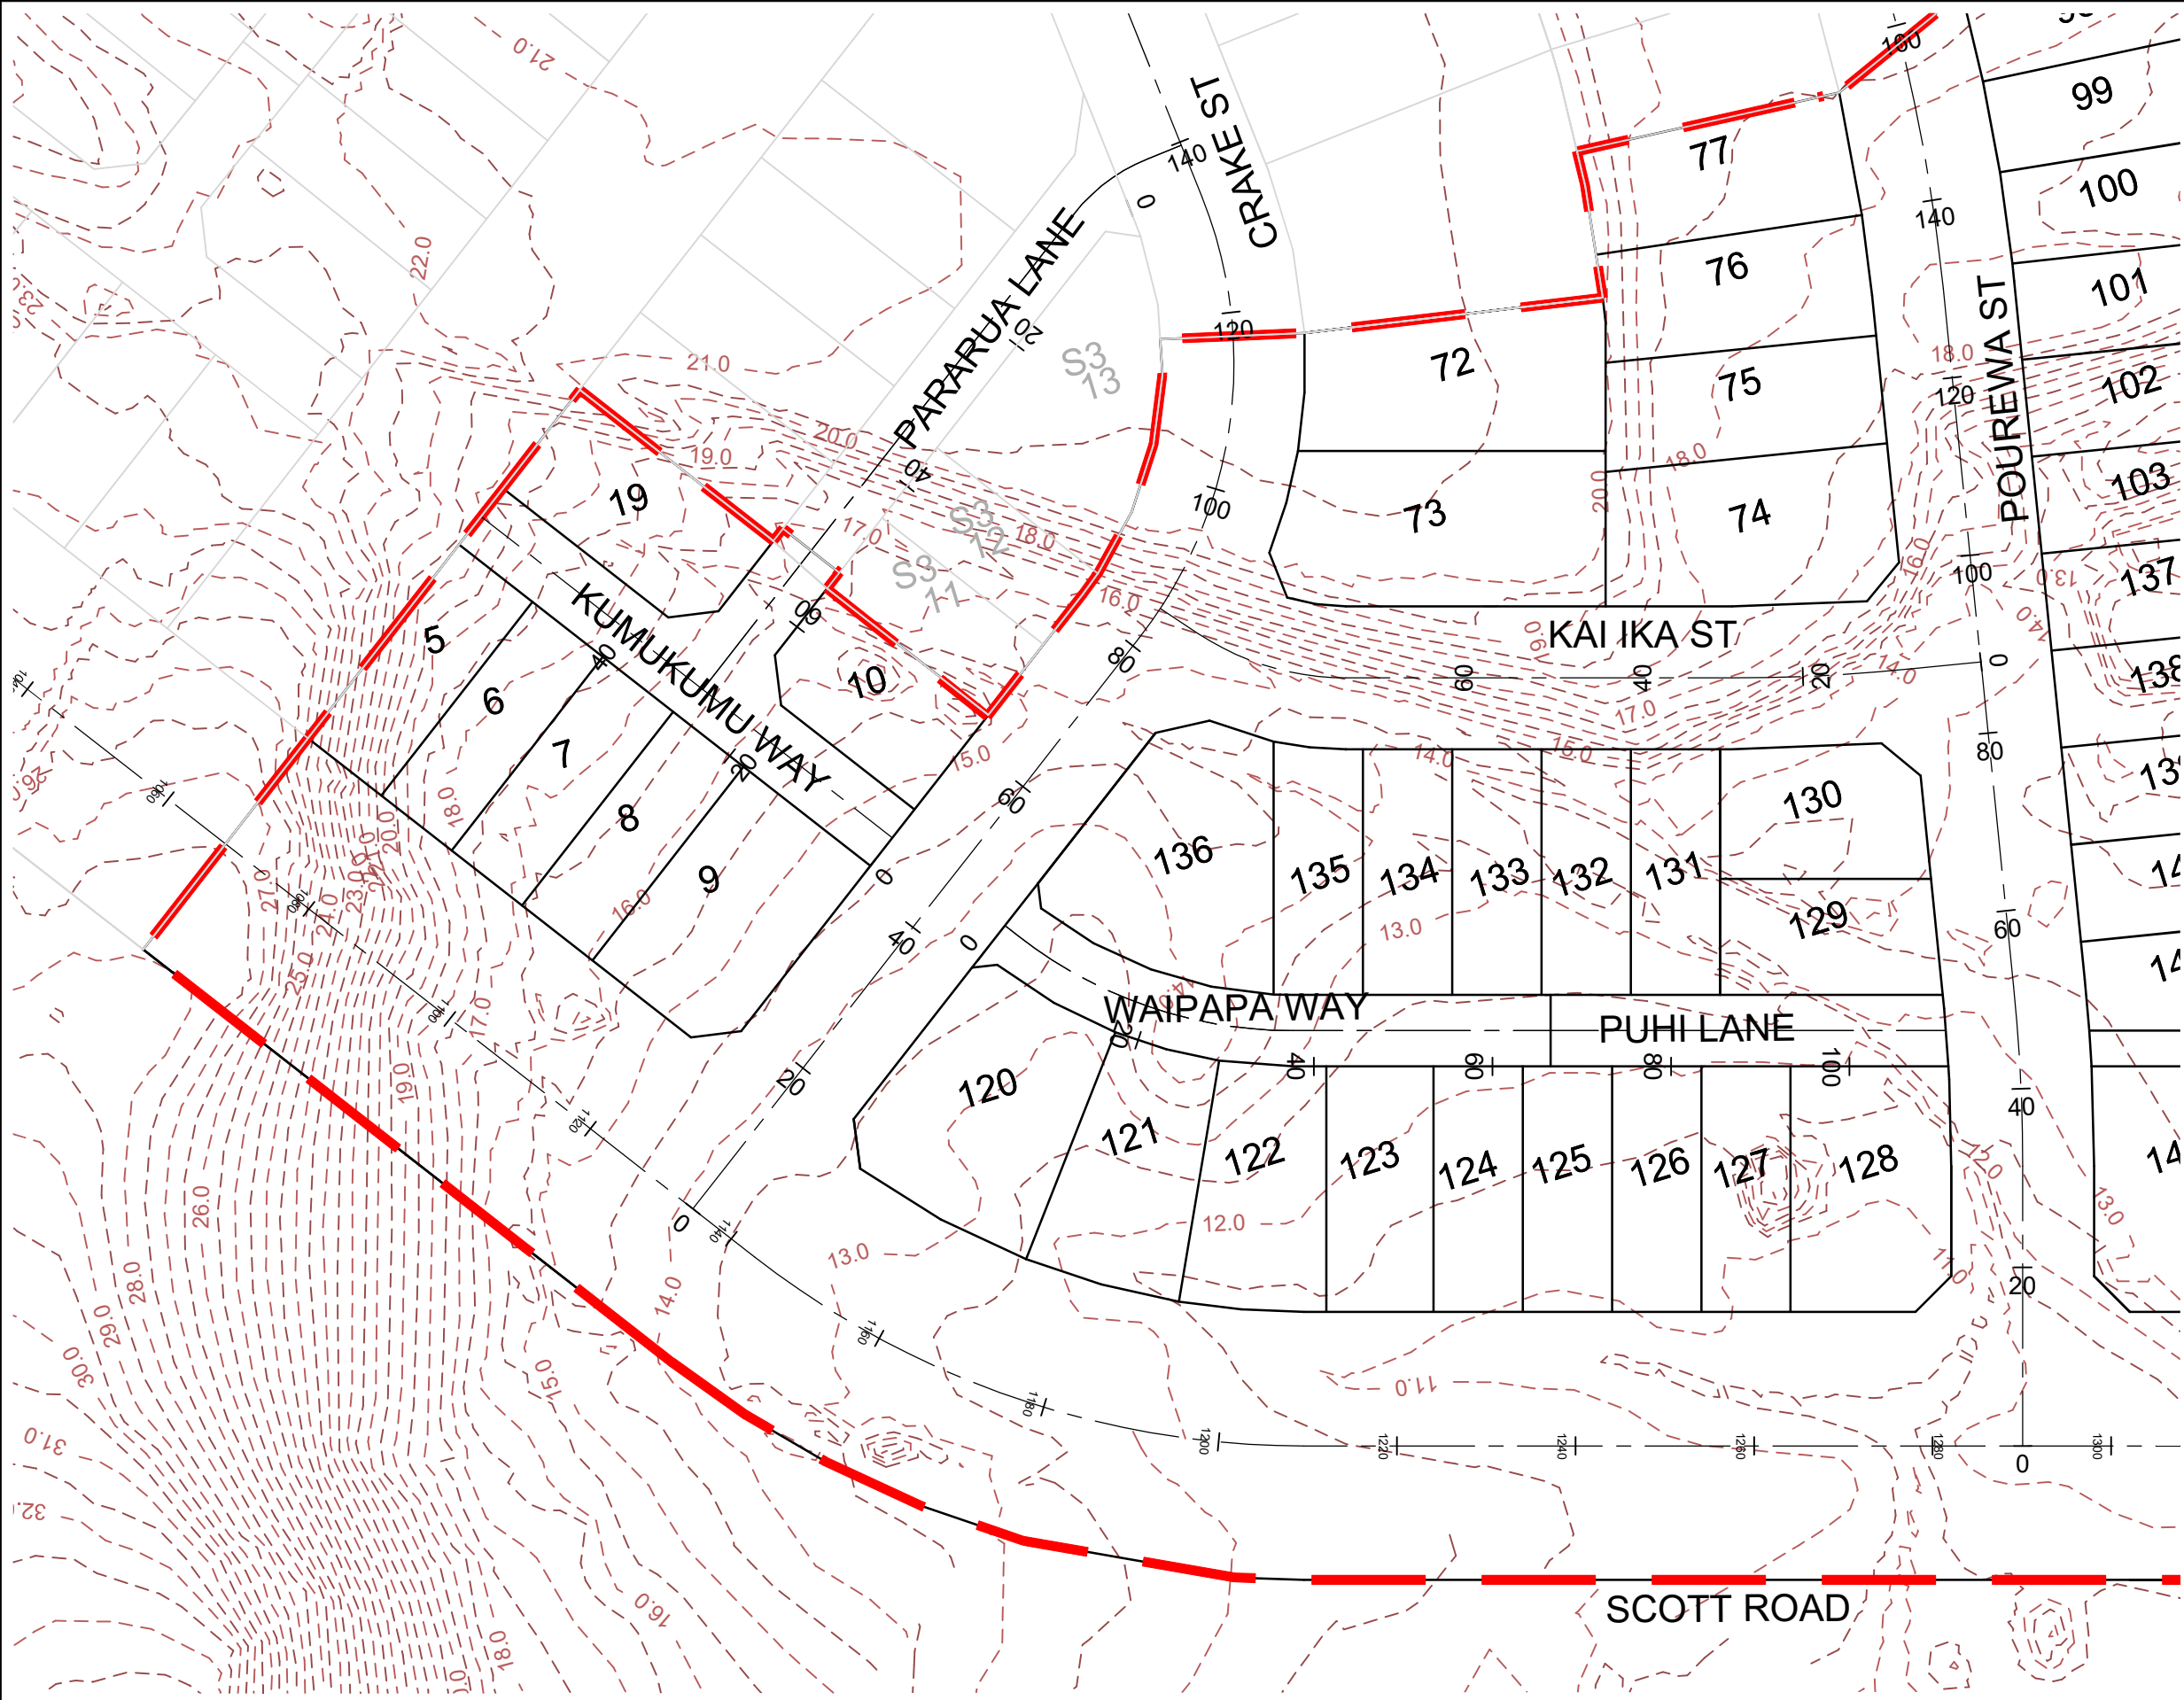

- LEGEND**
- LOT BOUNDARIES
 - STAGE BOUNDARIES
 - EXISTING SURFACE CONTOUR MAJOR (1m INTERVAL)
 - EXISTING SURFACE CONTOUR MINOR (0.5m INTERVAL)
 - FUTURE STAGE

- NOTE:**
- LEVELS ARE IN TERMS OF MOTURIKI VERTICAL DATUM 1953.
 - ALL CO-ORDINATES ARE IN TERMS OF NZTM.
 - EXISTING SURFACE TOPO IS TAKEN FOR THE PURPOSE OF GEOTECHNICAL CUT FILL AS-BUILT PLANS AND SHOULD NOT BE RELIED ON FOR DETAILED DESIGN.
 - EXISTING CONTOURS SHOWN ARE PRIOR TO STAGES 1 TO 7 EARTHWORKS STARTING. CONTOURS PROVIDED ARE CIRCA SEPTEMBER 2018.

CERTIFICATION

I CERTIFY THAT THESE ASBUILT PLANS ARE AN ACCURATE RECORD OF THE WORKS UNDERTAKEN AND THAT:

- THE COORDINATES (X,Y) ARE IN TERMS OF NZTM ON NZGD(2000), AND ARE WITHIN ±50mm.
- THE LEVELS (Z) ARE IN TERMS OF THE MOTURIKI DATUM 1953 LINZ DATUM, AND ARE WITHIN ±25mm.


SIGNED
LICENSED CADASTRAL SURVEYOR

DATE:
NAME: NATHAN HOGG
ADDRESS: P.O BOX 28-345, REMUERA, AUCKLAND
CONTACT: (09) 579 5505
EMAIL: Nathan.Hogg@candor3.co.nz

RELEVANT CONSENT NUMBERS:
SUB0340/18.02 & LUC0137/19

ASBUILT

REV DESCRIPTION		BY	APPVD	DATE	PROJECT		CLIENT		PURPOSE		
					LAKESIDE, TE KAUWHATA		LAKESIDE		AS-BUILT		
					EARTHWORKS EXISTING SURFACE STAGE 6		DEVELOPMENTS 2017		DESIGN JS	APPROVED BY NH	SCALE 1:750 @ A3
					SHEET 2 OF 4		LIMITED		DRAWN JS	DATE MAR 2021	
									CHECK RS		
									PROJECT NO.	DRAWING NO.	REV.
									1239	AB-2-101	-

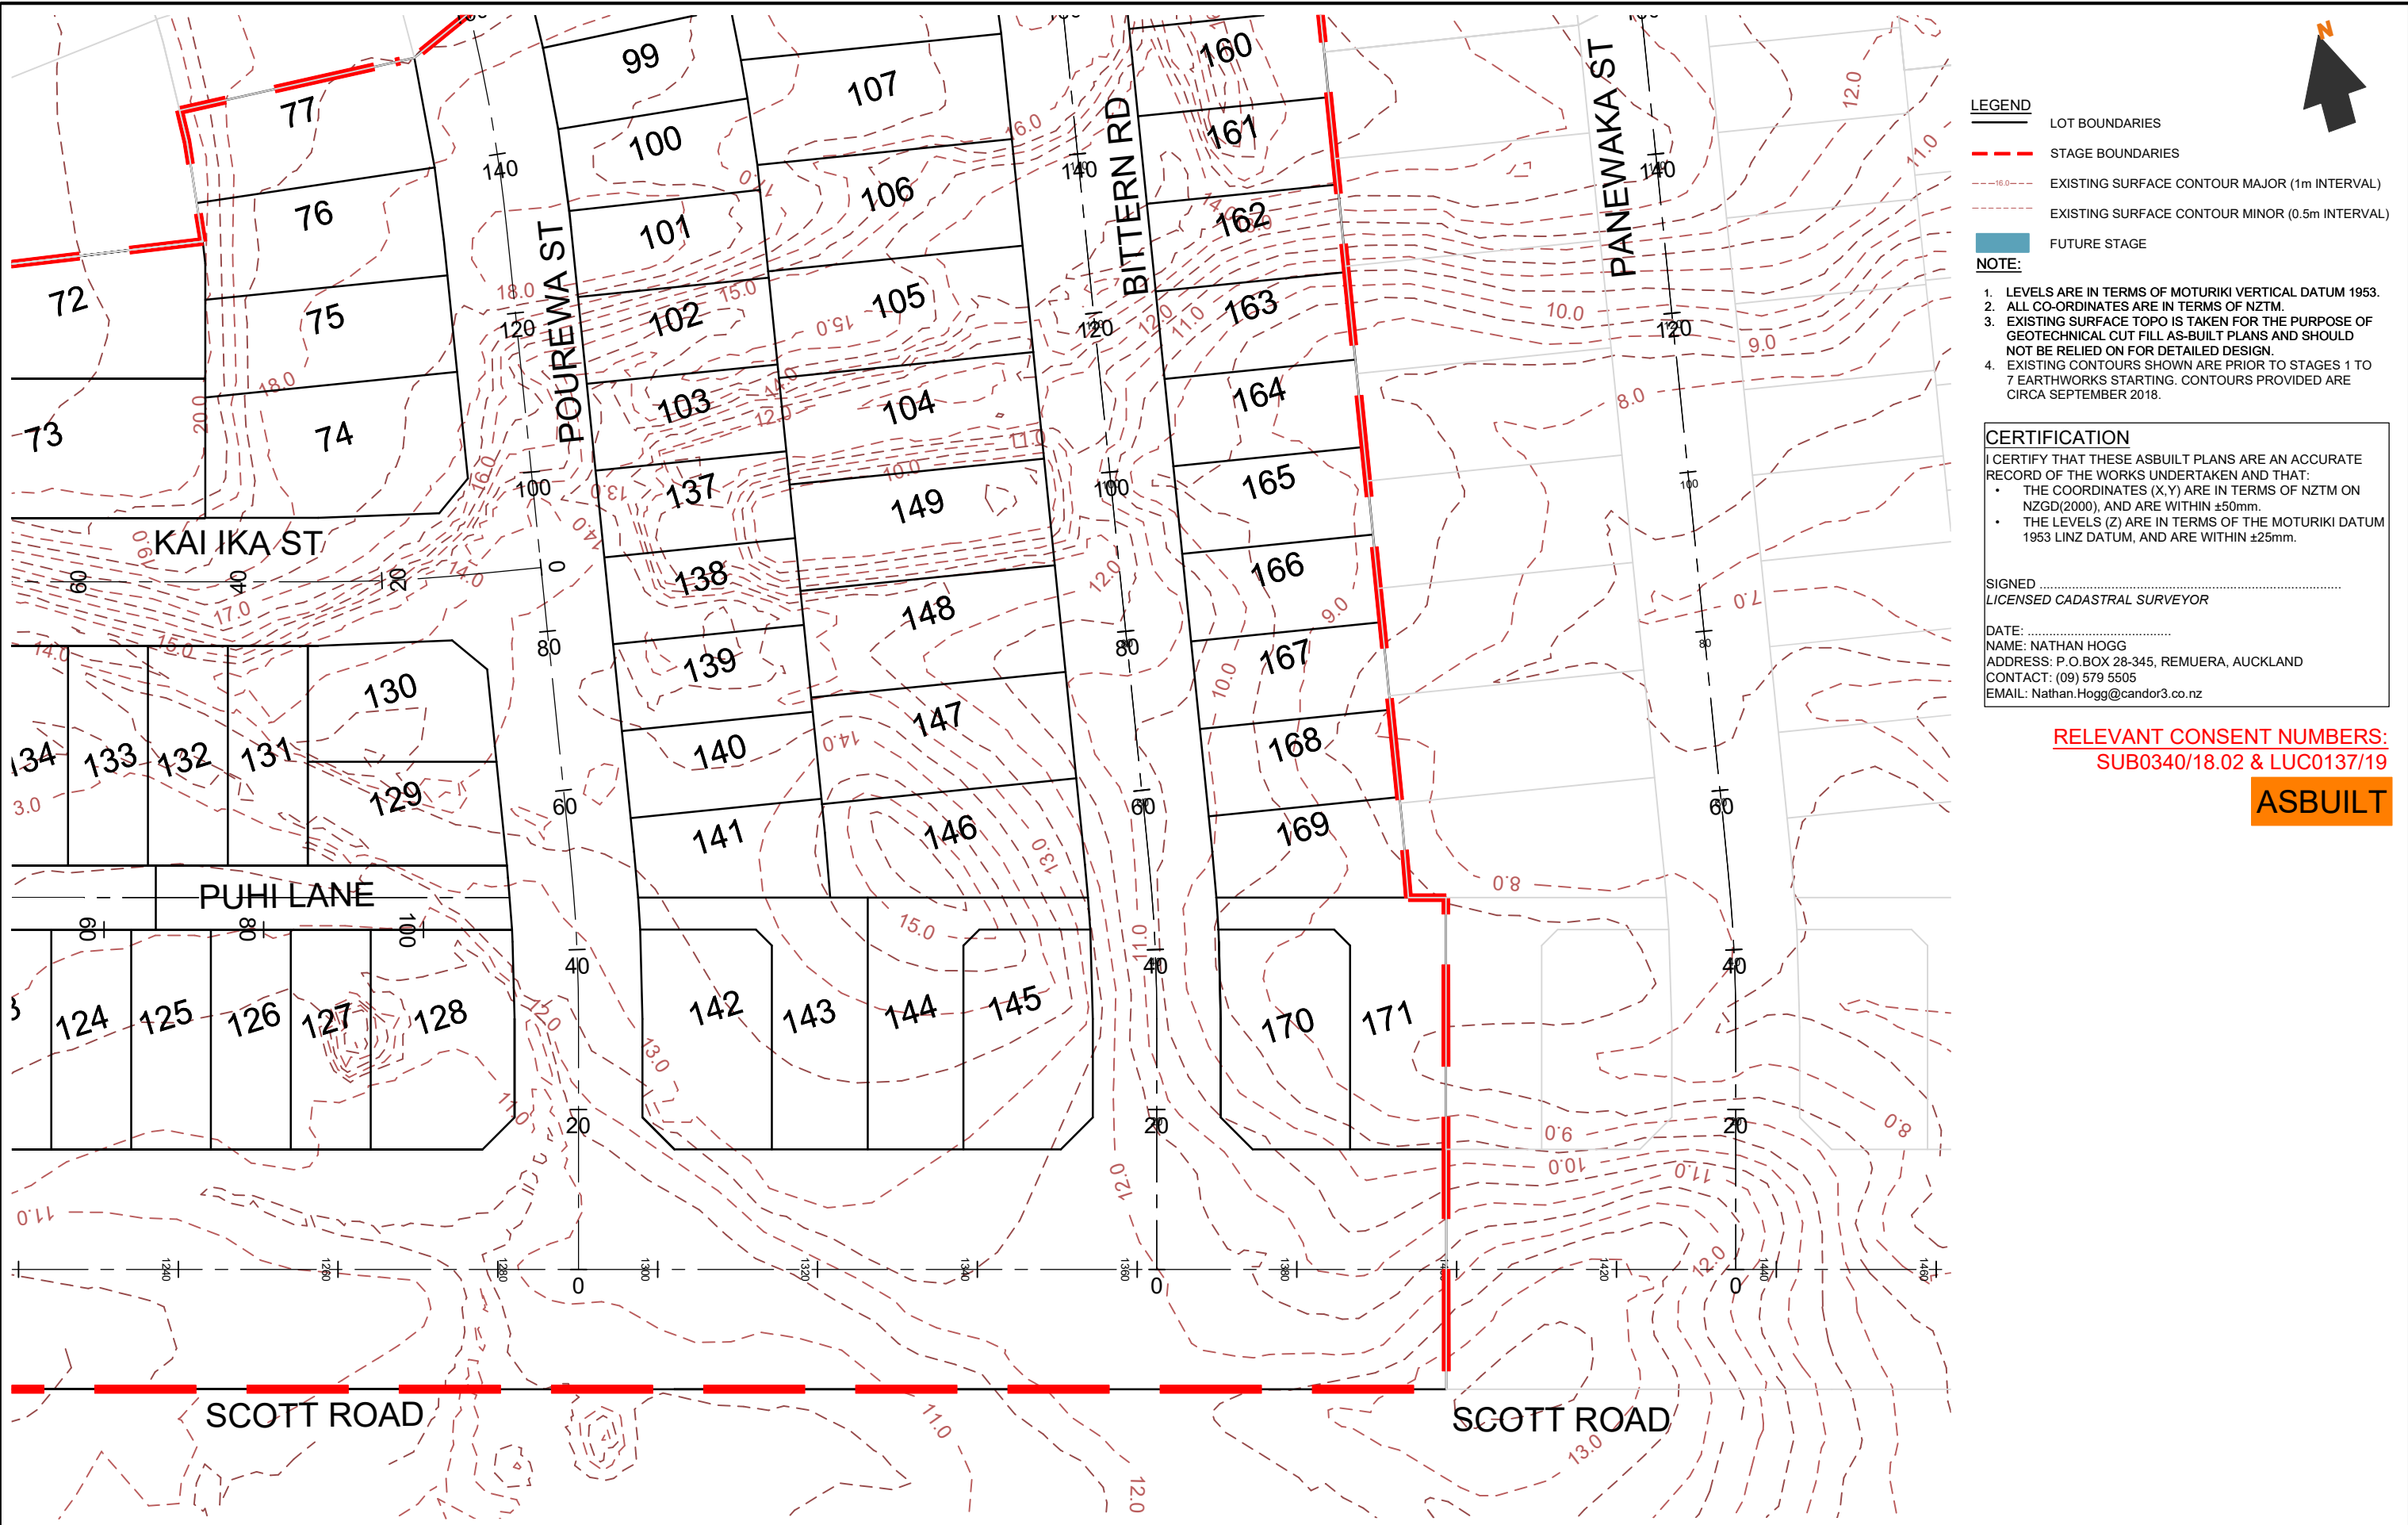

LEGEND

LOT BOUNDARIES

STAGE BOUNDARIES

EXISTING SURFACE CONTOUR MAJOR (1m INTERVAL)

EXISTING SURFACE CONTOUR MINOR (0.5m INTERVAL)

FUTURE STAGE

- NOTE:
1. LEVELS ARE IN TERMS OF MOTURIKI VERTICAL DATUM 1953.

2. ALL CO-ORDINATES ARE IN TERMS OF NZTM.

3. EXISTING SURFACE TOPO IS TAKEN FOR THE PURPOSE OF GEOTECHNICAL CUT FILL AS-BUILT PLANS AND SHOULD NOT BE RELIED ON FOR DETAILED DESIGN.

4. EXISTING CONTOURS SHOWN ARE PRIOR TO STAGES 1 TO 7 EARTHWORKS STARTING. CONTOURS PROVIDED ARE CIRCA SEPTEMBER 2018.

CERTIFICATION

I CERTIFY THAT THESE ASBUILT PLANS ARE AN ACCURATE RECORD OF THE WORKS UNDERTAKEN AND THAT:

- THE COORDINATES (X,Y) ARE IN TERMS OF NZTM ON NZGD(2000), AND ARE WITHIN ±50mm.
- THE LEVELS (Z) ARE IN TERMS OF THE MOTURIKI DATUM 1953 LINZ DATUM, AND ARE WITHIN ±25mm.


SIGNED
LICENSED CADASTRAL SURVEYOR

DATE:
NAME: NATHAN HOGG
ADDRESS: P.O BOX 28-345, REMUERA, AUCKLAND
CONTACT: (09) 579 5505
EMAIL: Nathan.Hogg@candor3.co.nz

RELEVANT CONSENT NUMBERS:
SUB0340/18.02 & LUC0137/19

ASBUILT

REV DESCRIPTION		BY APPVD DATE	PROJECT LAKESIDE, TE KAUPHATA EARTHWORKS EXISTING SURFACE STAGE 6 SHEET 3 OF 4	CLIENT LAKESIDE DEVELOPMENTS 2017 LIMITED	PURPOSE AS-BUILT		
					DESIGN JS DRAWN JS CHECK RS	APPROVED BY NH DATE MAR 2021	SCALE 1:750 @ A3
					PROJECT NO.	DRAWING NO.	REV.
					1239	AB-2-102	-

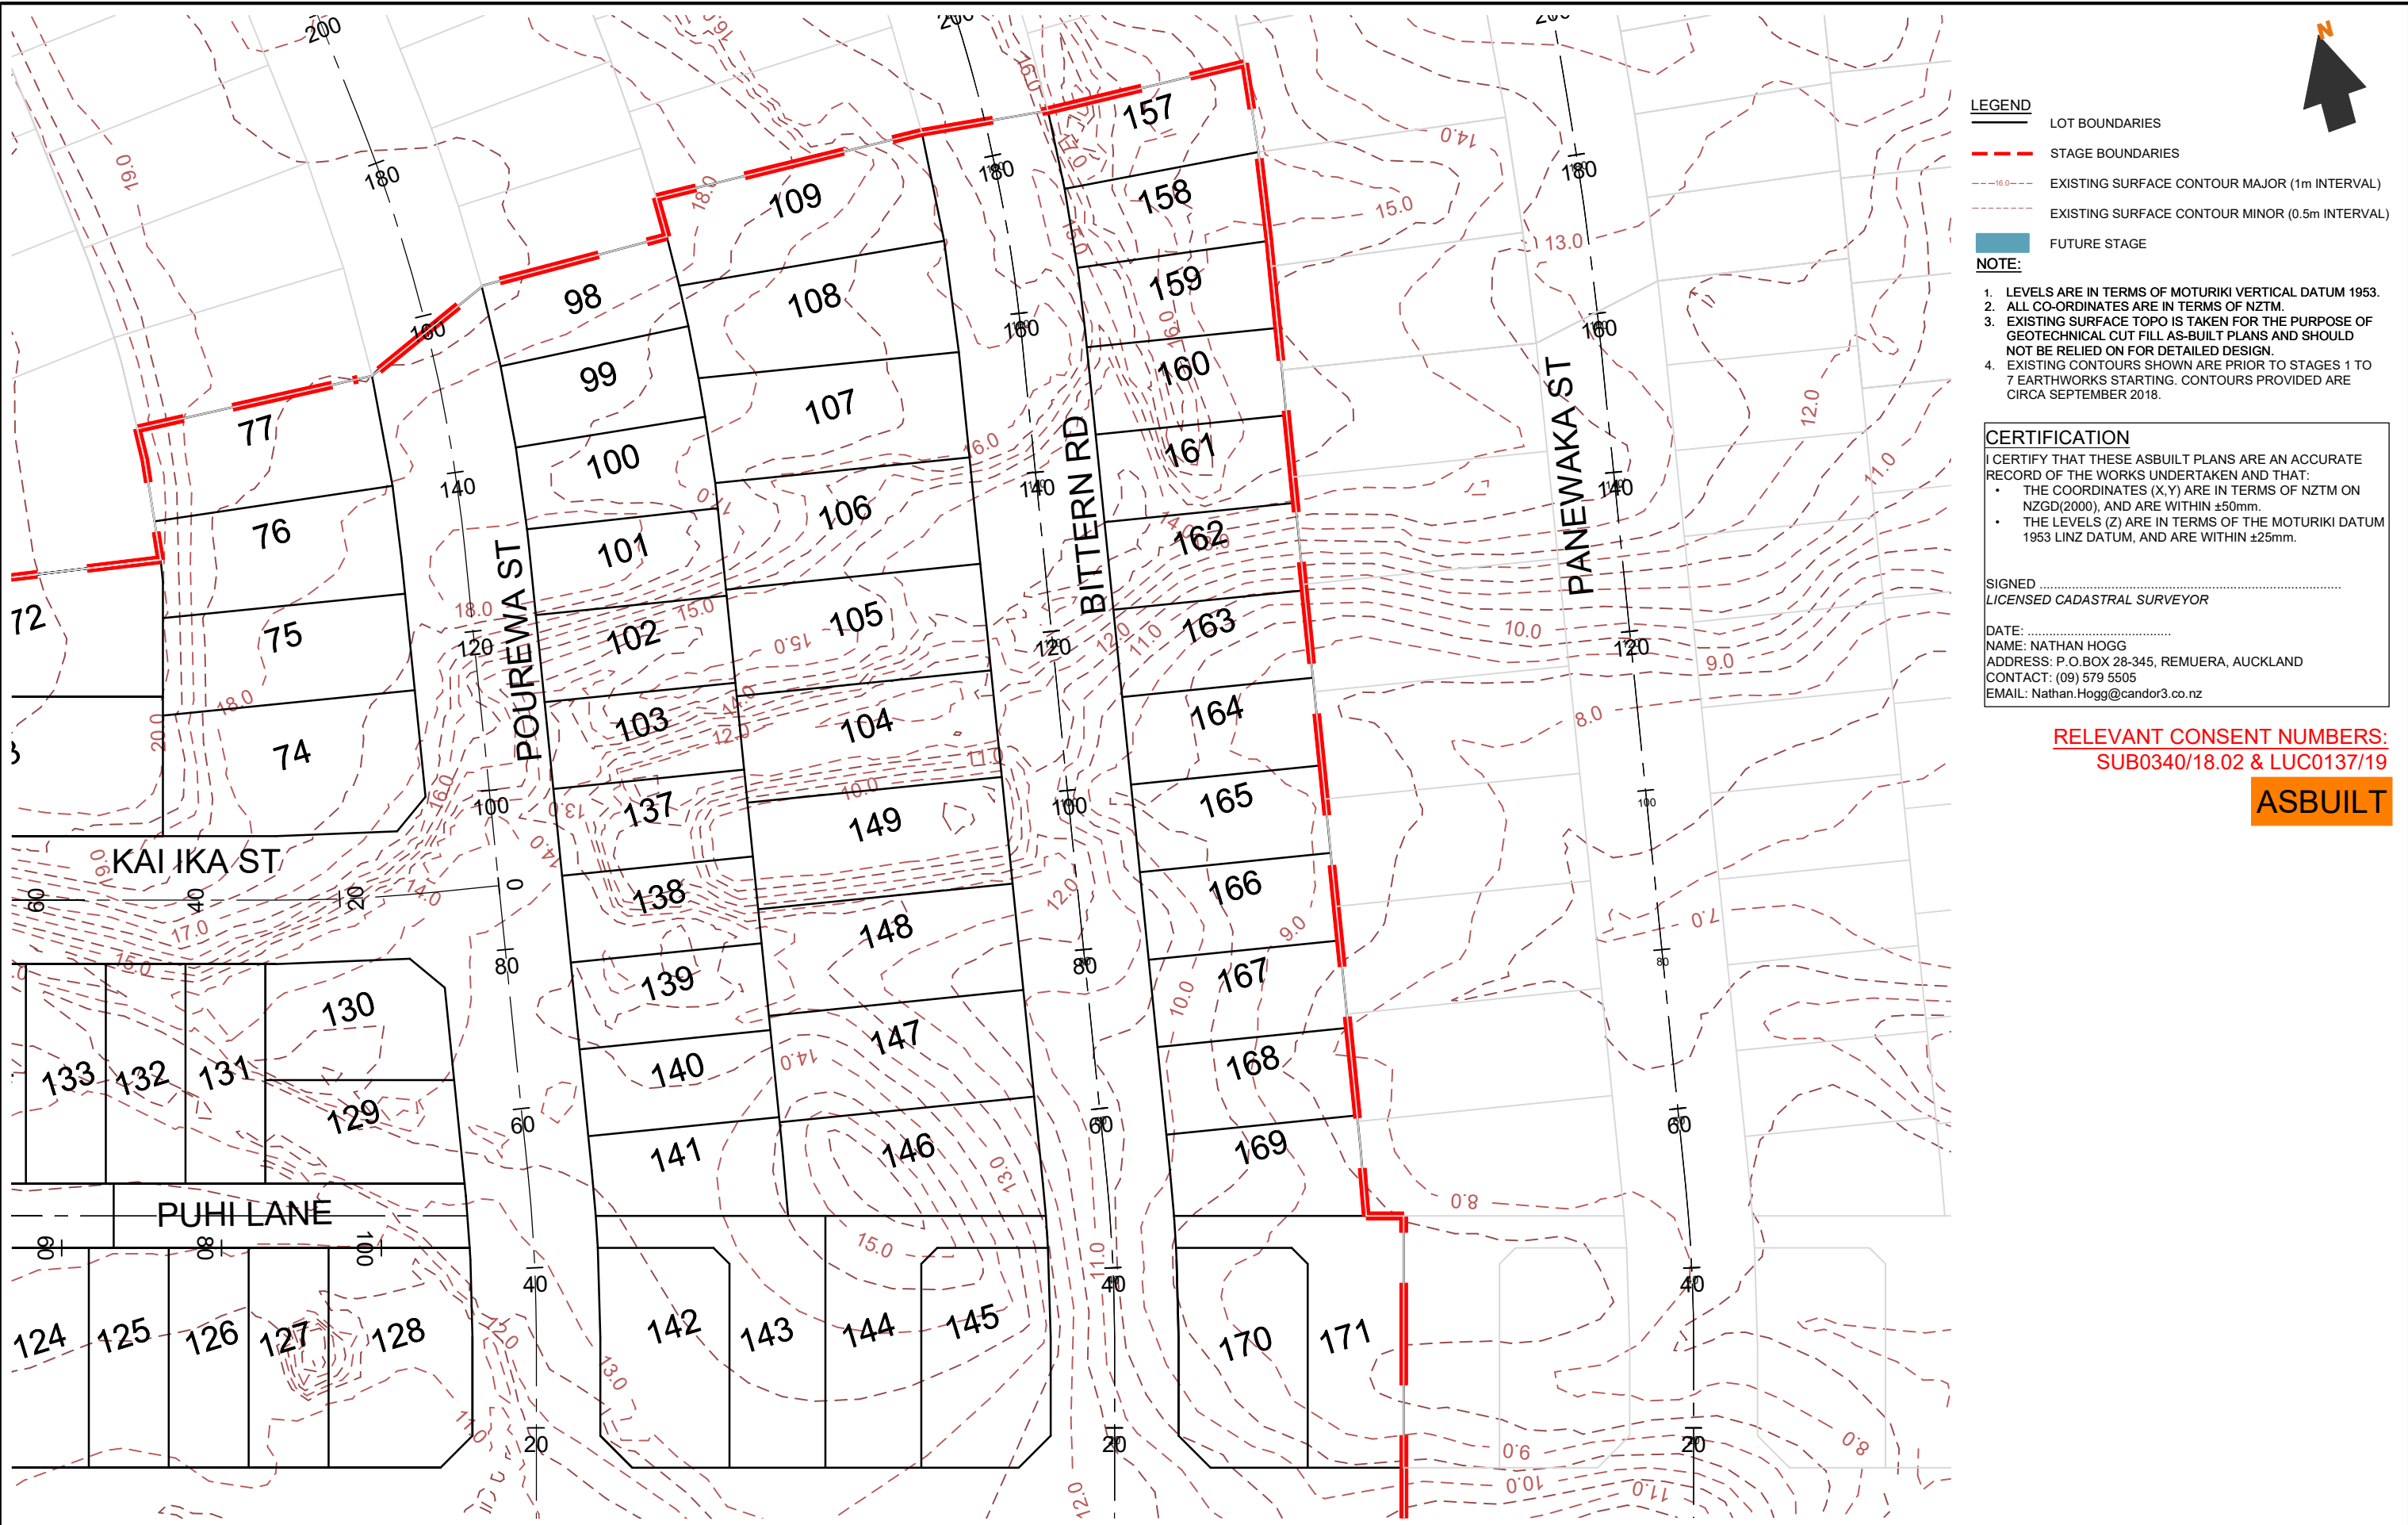

LEGEND

LOT BOUNDARIES

STAGE BOUNDARIES

EXISTING SURFACE CONTOUR MAJOR (1m INTERVAL)

EXISTING SURFACE CONTOUR MINOR (0.5m INTERVAL)

FUTURE STAGE

NOTE:

- LEVELS ARE IN TERMS OF MOTURIKI VERTICAL DATUM 1953.
- ALL CO-ORDINATES ARE IN TERMS OF NZTM.
- EXISTING SURFACE TOPO IS TAKEN FOR THE PURPOSE OF GEOTECHNICAL CUT FILL AS-BUILT PLANS AND SHOULD NOT BE RELIED ON FOR DETAILED DESIGN.
- EXISTING CONTOURS SHOWN ARE PRIOR TO STAGES 1 TO 7 EARTHWORKS STARTING. CONTOURS PROVIDED ARE CIRCA SEPTEMBER 2018.

CERTIFICATION

I CERTIFY THAT THESE ASBUILT PLANS ARE AN ACCURATE RECORD OF THE WORKS UNDERTAKEN AND THAT:

- THE COORDINATES (X,Y) ARE IN TERMS OF NZTM ON NZGD(2000), AND ARE WITHIN ±50mm.
- THE LEVELS (Z) ARE IN TERMS OF THE MOTURIKI DATUM 1953 LINZ DATUM, AND ARE WITHIN ±25mm.


SIGNED
LICENSED CADASTRAL SURVEYOR

DATE:
NAME: NATHAN HOGG
ADDRESS: P.O.BOX 28-345, REMUERA, AUCKLAND
CONTACT: (09) 579 5505
EMAIL: Nathan.Hogg@candor3.co.nz

RELEVANT CONSENT NUMBERS:
SUB0340/18.02 & LUC0137/19

ASBUILT

REV DESCRIPTION		BY	APPVD	DATE	PROJECT		CLIENT		PURPOSE		
					LAKESIDE, TE KAUWHATA		LAKESIDE		AS-BUILT		
					EARTHWORKS EXISTING SURFACE STAGE 6		DEVELOPMENTS 2017		DESIGN JS	APPROVED BY NH	SCALE 1:750 @ A3
					SHEET 4 OF 4		LIMITED		DRAWN JS	CHECK RS	DATE MAR 2021
									PROJECT NO.	DRAWING NO.	REV.
									1239	AB-2-103	-

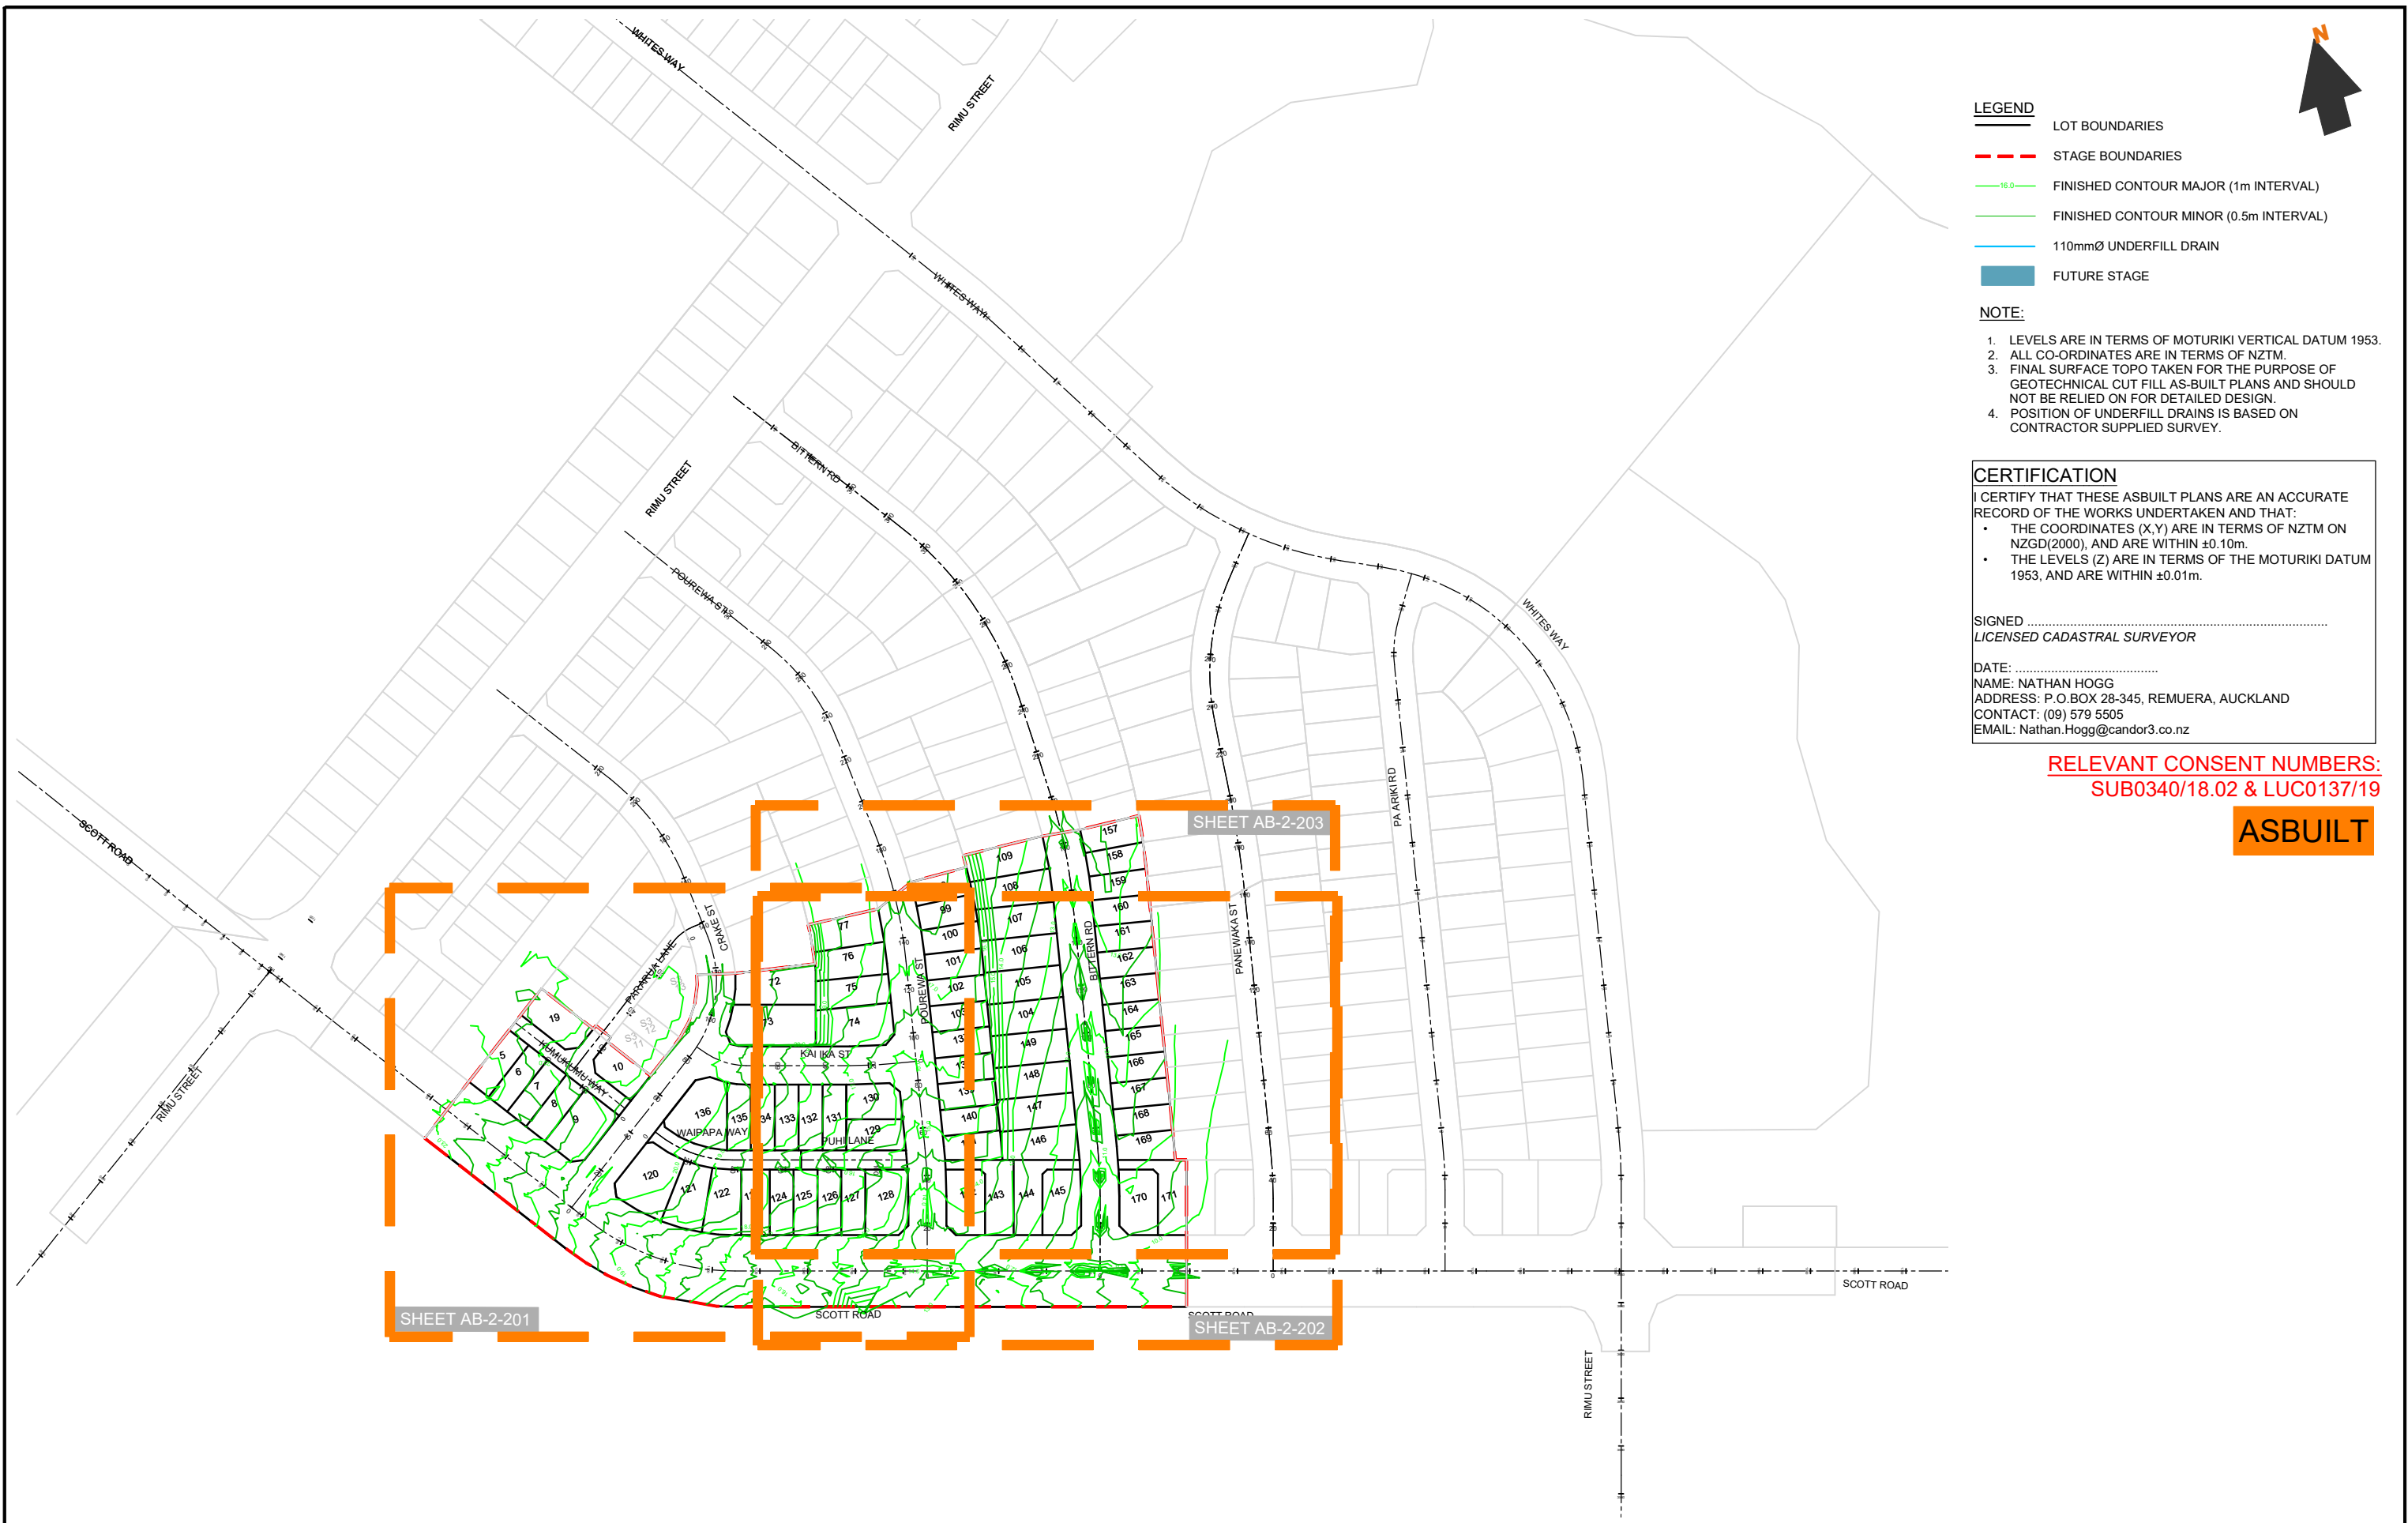

LEGEND

LOT BOUNDARIES

STAGE BOUNDARIES

FINISHED CONTOUR MAJOR (1m INTERVAL)

FINISHED CONTOUR MINOR (0.5m INTERVAL)

110mmØ UNDERFILL DRAIN

FUTURE STAGE

- NOTE:
1. LEVELS ARE IN TERMS OF MOTURIKI VERTICAL DATUM 1953.

2. ALL CO-ORDINATES ARE IN TERMS OF NZTM.

3. FINAL SURFACE TOPO TAKEN FOR THE PURPOSE OF GEOTECHNICAL CUT FILL AS-BUILT PLANS AND SHOULD NOT BE RELIED ON FOR DETAILED DESIGN.

4. POSITION OF UNDERFILL DRAINS IS BASED ON CONTRACTOR SUPPLIED SURVEY.

CERTIFICATION

I CERTIFY THAT THESE ASBUILT PLANS ARE AN ACCURATE RECORD OF THE WORKS UNDERTAKEN AND THAT:

THE COORDINATES (X,Y) ARE IN TERMS OF NZTM ON NZGD(2000), AND ARE WITHIN ±0.10m.

THE LEVELS (Z) ARE IN TERMS OF THE MOTURIKI DATUM 1953, AND ARE WITHIN ±0.01m.

SIGNED

LICENSED CADASTRAL SURVEYOR

DATE:

NAME: NATHAN HOGG

ADDRESS: P.O.BOX 28-345, REMUERA, AUCKLAND


CONTACT: (09) 579 5505

EMAIL: Nathan.Hogg@candor3.co.nz

RELEVANT CONSENT NUMBERS:
SUB0340/18.02 & LUC0137/19

ASBUILT

REV DESCRIPTION			BY	APPVD	DATE	PROJECT			CLIENT			PURPOSE		
						LAKESIDE, TE KAUWHATA			LAKESIDE DEVELOPMENTS 2017 LIMITED			AS-BUILT		
						EARTHWORKS FINISHED SURFACE STAGE 6						DESIGN JS	APPROVED BY NH	SCALE 1:2500 @ A3
						SHEET 1 OF 4						DRAWN JS	DATE MAR 2021	
												CHECK RS		
												PROJECT NO.	DRAWING NO.	REV.
												1239	AB-2-200	-

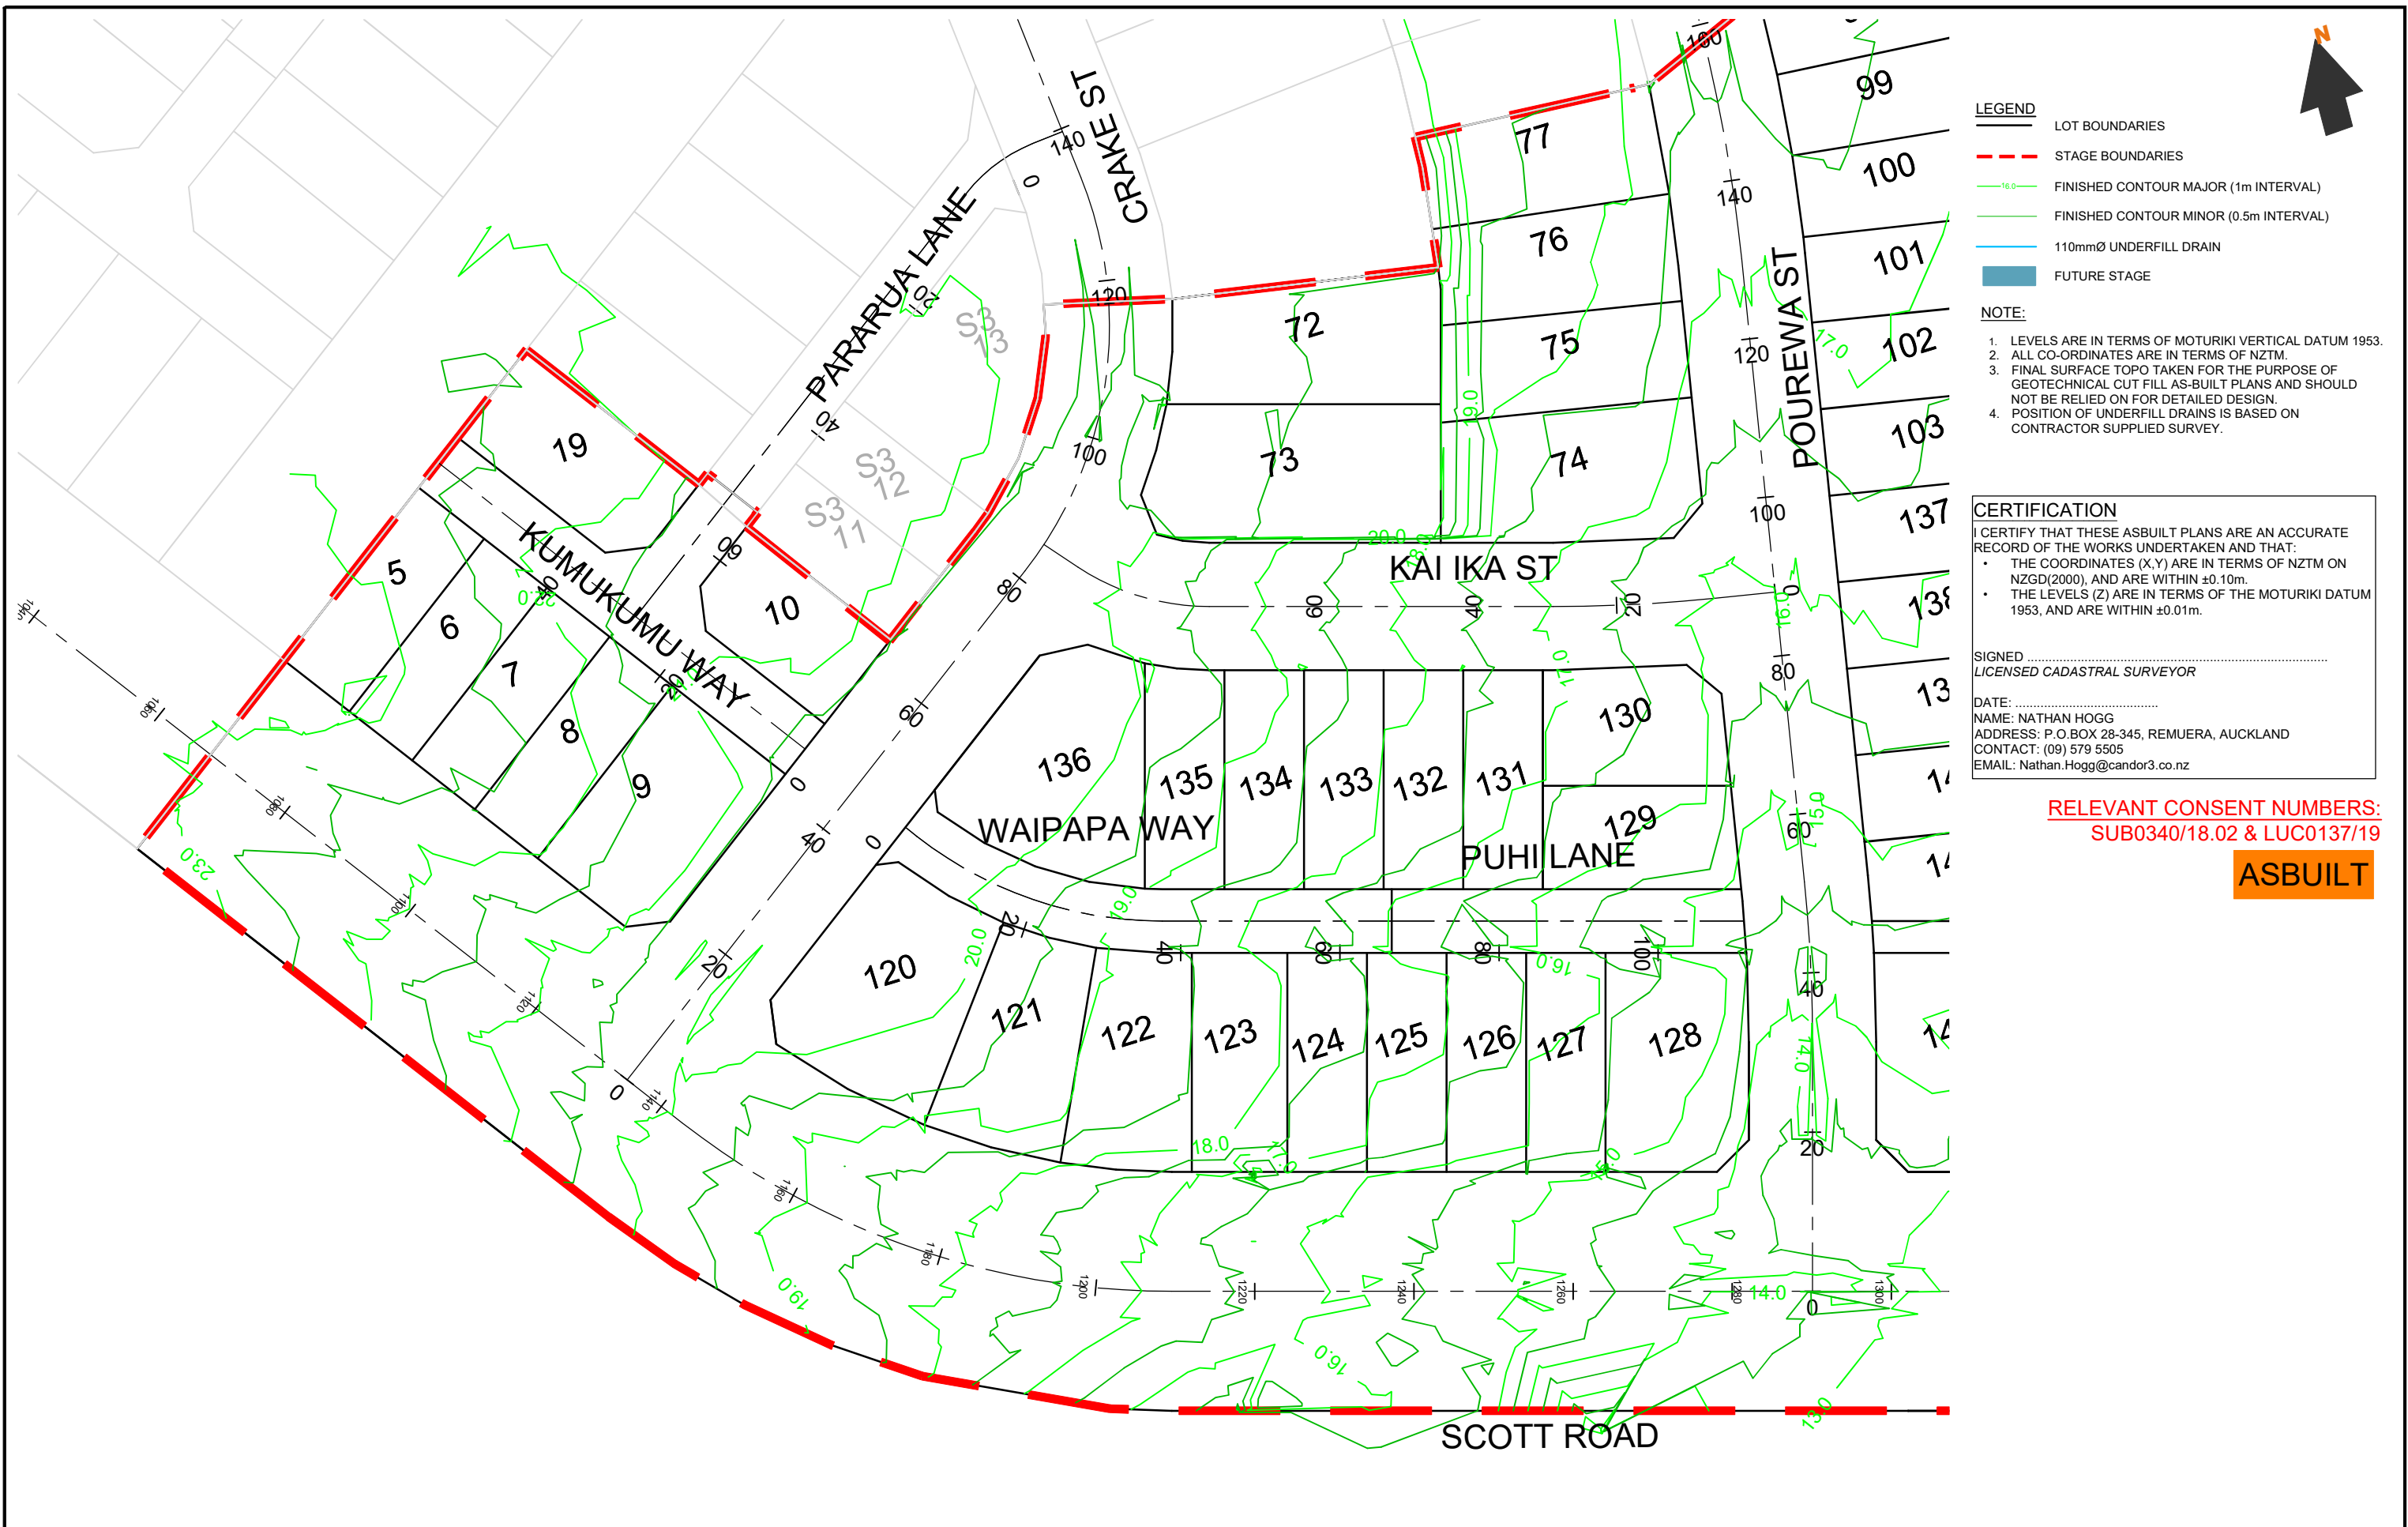

LEGEND

LOT BOUNDARIES

STAGE BOUNDARIES

FINISHED CONTOUR MAJOR (1m INTERVAL)

FINISHED CONTOUR MINOR (0.5m INTERVAL)

110mmØ UNDERFILL DRAIN

FUTURE STAGE

- NOTE:
1. LEVELS ARE IN TERMS OF MOTURIKI VERTICAL DATUM 1953.

2. ALL CO-ORDINATES ARE IN TERMS OF NZTM.

3. FINAL SURFACE TOPO TAKEN FOR THE PURPOSE OF GEOTECHNICAL CUT FILL AS-BUILT PLANS AND SHOULD NOT BE RELIED ON FOR DETAILED DESIGN.

4. POSITION OF UNDERFILL DRAINS IS BASED ON CONTRACTOR SUPPLIED SURVEY.

CERTIFICATION

I CERTIFY THAT THESE ASBUILT PLANS ARE AN ACCURATE RECORD OF THE WORKS UNDERTAKEN AND THAT:

• THE COORDINATES (X,Y) ARE IN TERMS OF NZTM ON NZGD(2000), AND ARE WITHIN ±0.10m.

• THE LEVELS (Z) ARE IN TERMS OF THE MOTURIKI DATUM 1953, AND ARE WITHIN ±0.01m.

SIGNED

LICENSED CADASTRAL SURVEYOR

DATE:

NAME: NATHAN HOGG

ADDRESS: P.O.BOX 28-345, REMUERA, AUCKLAND


CONTACT: (09) 579 5505

EMAIL: Nathan.Hogg@candor3.co.nz

RELEVANT CONSENT NUMBERS:
SUB0340/18.02 & LUC0137/19

ASBUILT

REV DESCRIPTION		BY	APPVD	DATE	PROJECT		CLIENT		PURPOSE			
<div>Candor³ ENGINEERING FOR LIFE</div>					LAKESIDE, TE KAUWHATA EARTHWORKS FINISHED SURFACE STAGE 6 SHEET 2 OF 4		LAKESIDE DEVELOPMENTS 2017 LIMITED		AS-BUILT			
DESIGN JS		APPROVED BY NH		SCALE 1:750 @ A3		DRAWN JS		DATE MAR 2021				
CHECK RS												
PROJECT NO.			DRAWING NO.			REV.						
1239			AB-2-201			-						

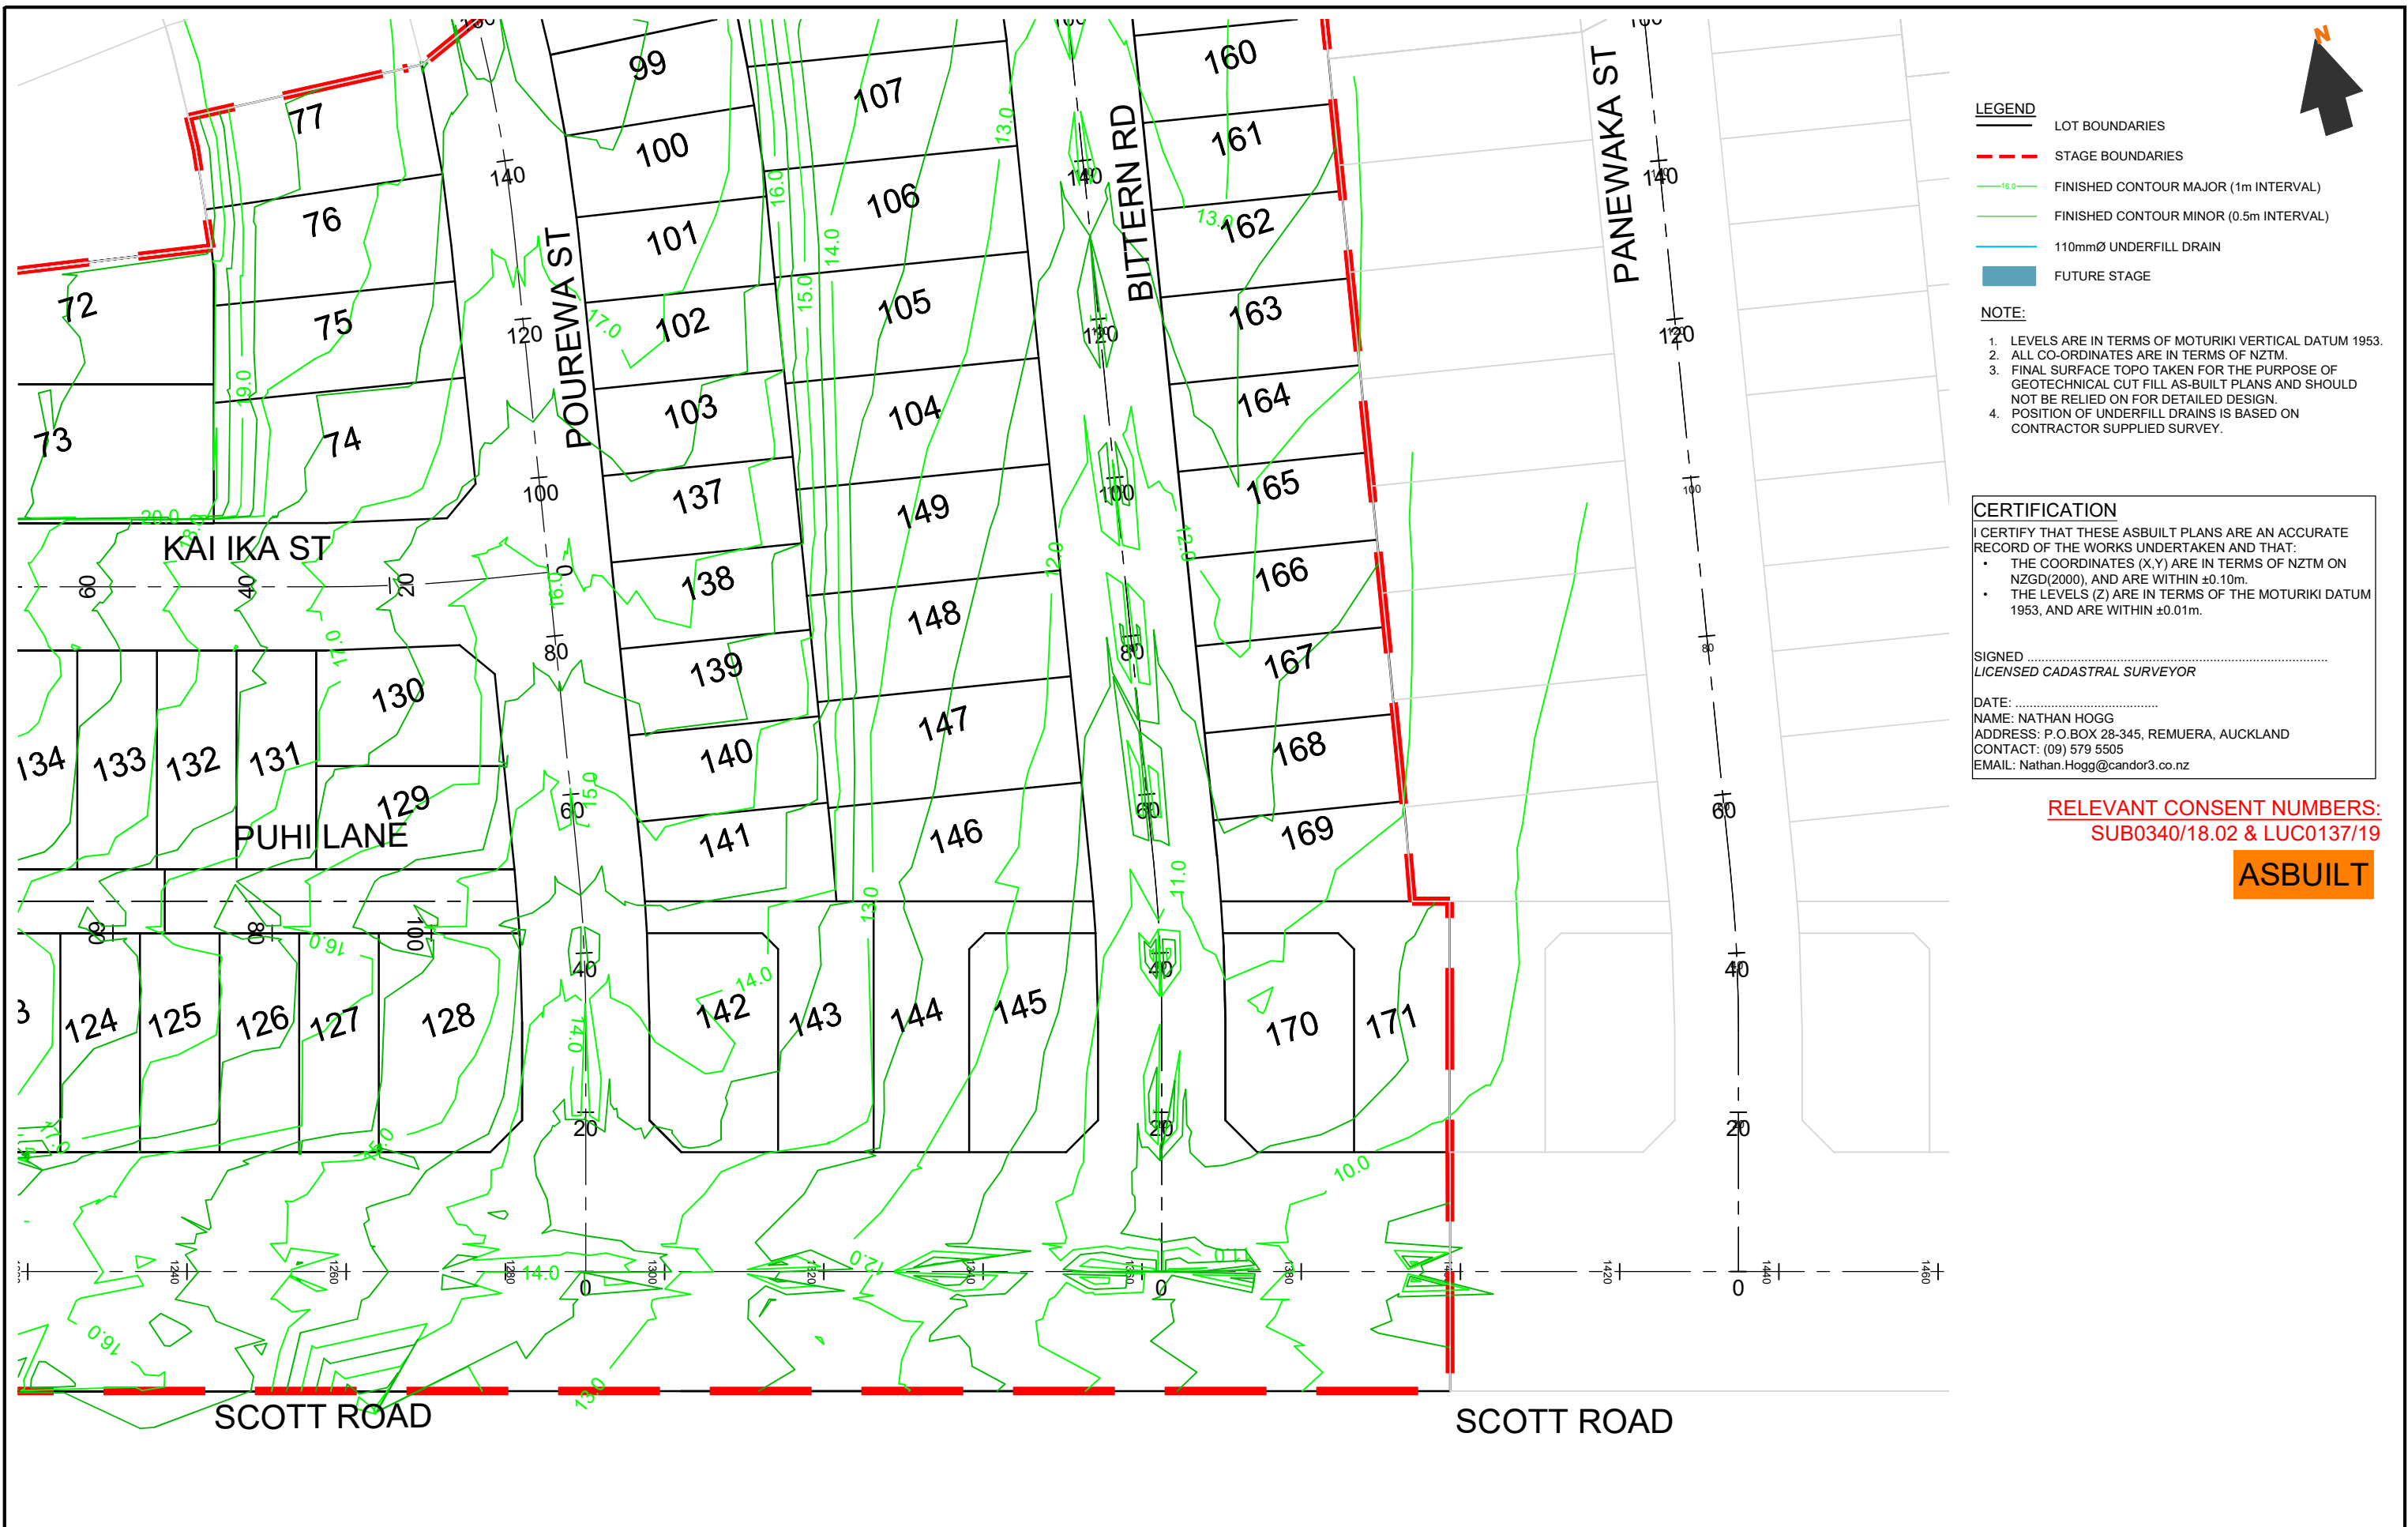

LEGEND

LOT BOUNDARIES

STAGE BOUNDARIES

FINISHED CONTOUR MAJOR (1m INTERVAL)

FINISHED CONTOUR MINOR (0.5m INTERVAL)

110mmØ UNDERFILL DRAIN

FUTURE STAGE

- NOTE:
1. LEVELS ARE IN TERMS OF MOTURIKI VERTICAL DATUM 1953.

2. ALL CO-ORDINATES ARE IN TERMS OF NZTM.

3. FINAL SURFACE TOPO TAKEN FOR THE PURPOSE OF GEOTECHNICAL CUT FILL AS-BUILT PLANS AND SHOULD NOT BE RELIED ON FOR DETAILED DESIGN.

4. POSITION OF UNDERFILL DRAINS IS BASED ON CONTRACTOR SUPPLIED SURVEY.

CERTIFICATION

I CERTIFY THAT THESE ASBUILT PLANS ARE AN ACCURATE RECORD OF THE WORKS UNDERTAKEN AND THAT:

• THE COORDINATES (X,Y) ARE IN TERMS OF NZTM ON NZGD(2000), AND ARE WITHIN ±0.10m.

• THE LEVELS (Z) ARE IN TERMS OF THE MOTURIKI DATUM 1953, AND ARE WITHIN ±0.01m.

SIGNED
LICENSED CADASTRAL SURVEYOR


DATE:
NAME: NATHAN HOGG
ADDRESS: P.O.BOX 28-345, REMUERA, AUCKLAND
CONTACT: (09) 579 5505
EMAIL: Nathan.Hogg@candor3.co.nz

RELEVANT CONSENT NUMBERS:

SUB0340/18.02 & LUC0137/19

ASBUILT

REV DESCRIPTION		BY	APPVD	DATE	PROJECT		CLIENT		PURPOSE		
					LAKESIDE, TE KAUWHATA		LAKESIDE		AS-BUILT		
					EARTHWORKS FINISHED SURFACE STAGE 6		DEVELOPMENTS 2017		DESIGN JS	APPROVED BY NH	SCALE 1:750 @ A3
					SHEET 3 OF 4		LIMITED		CHECK RS	DATE MAR 2021	
									PROJECT NO.	DRAWING NO.	REV.
									1239	AB-2-202	-

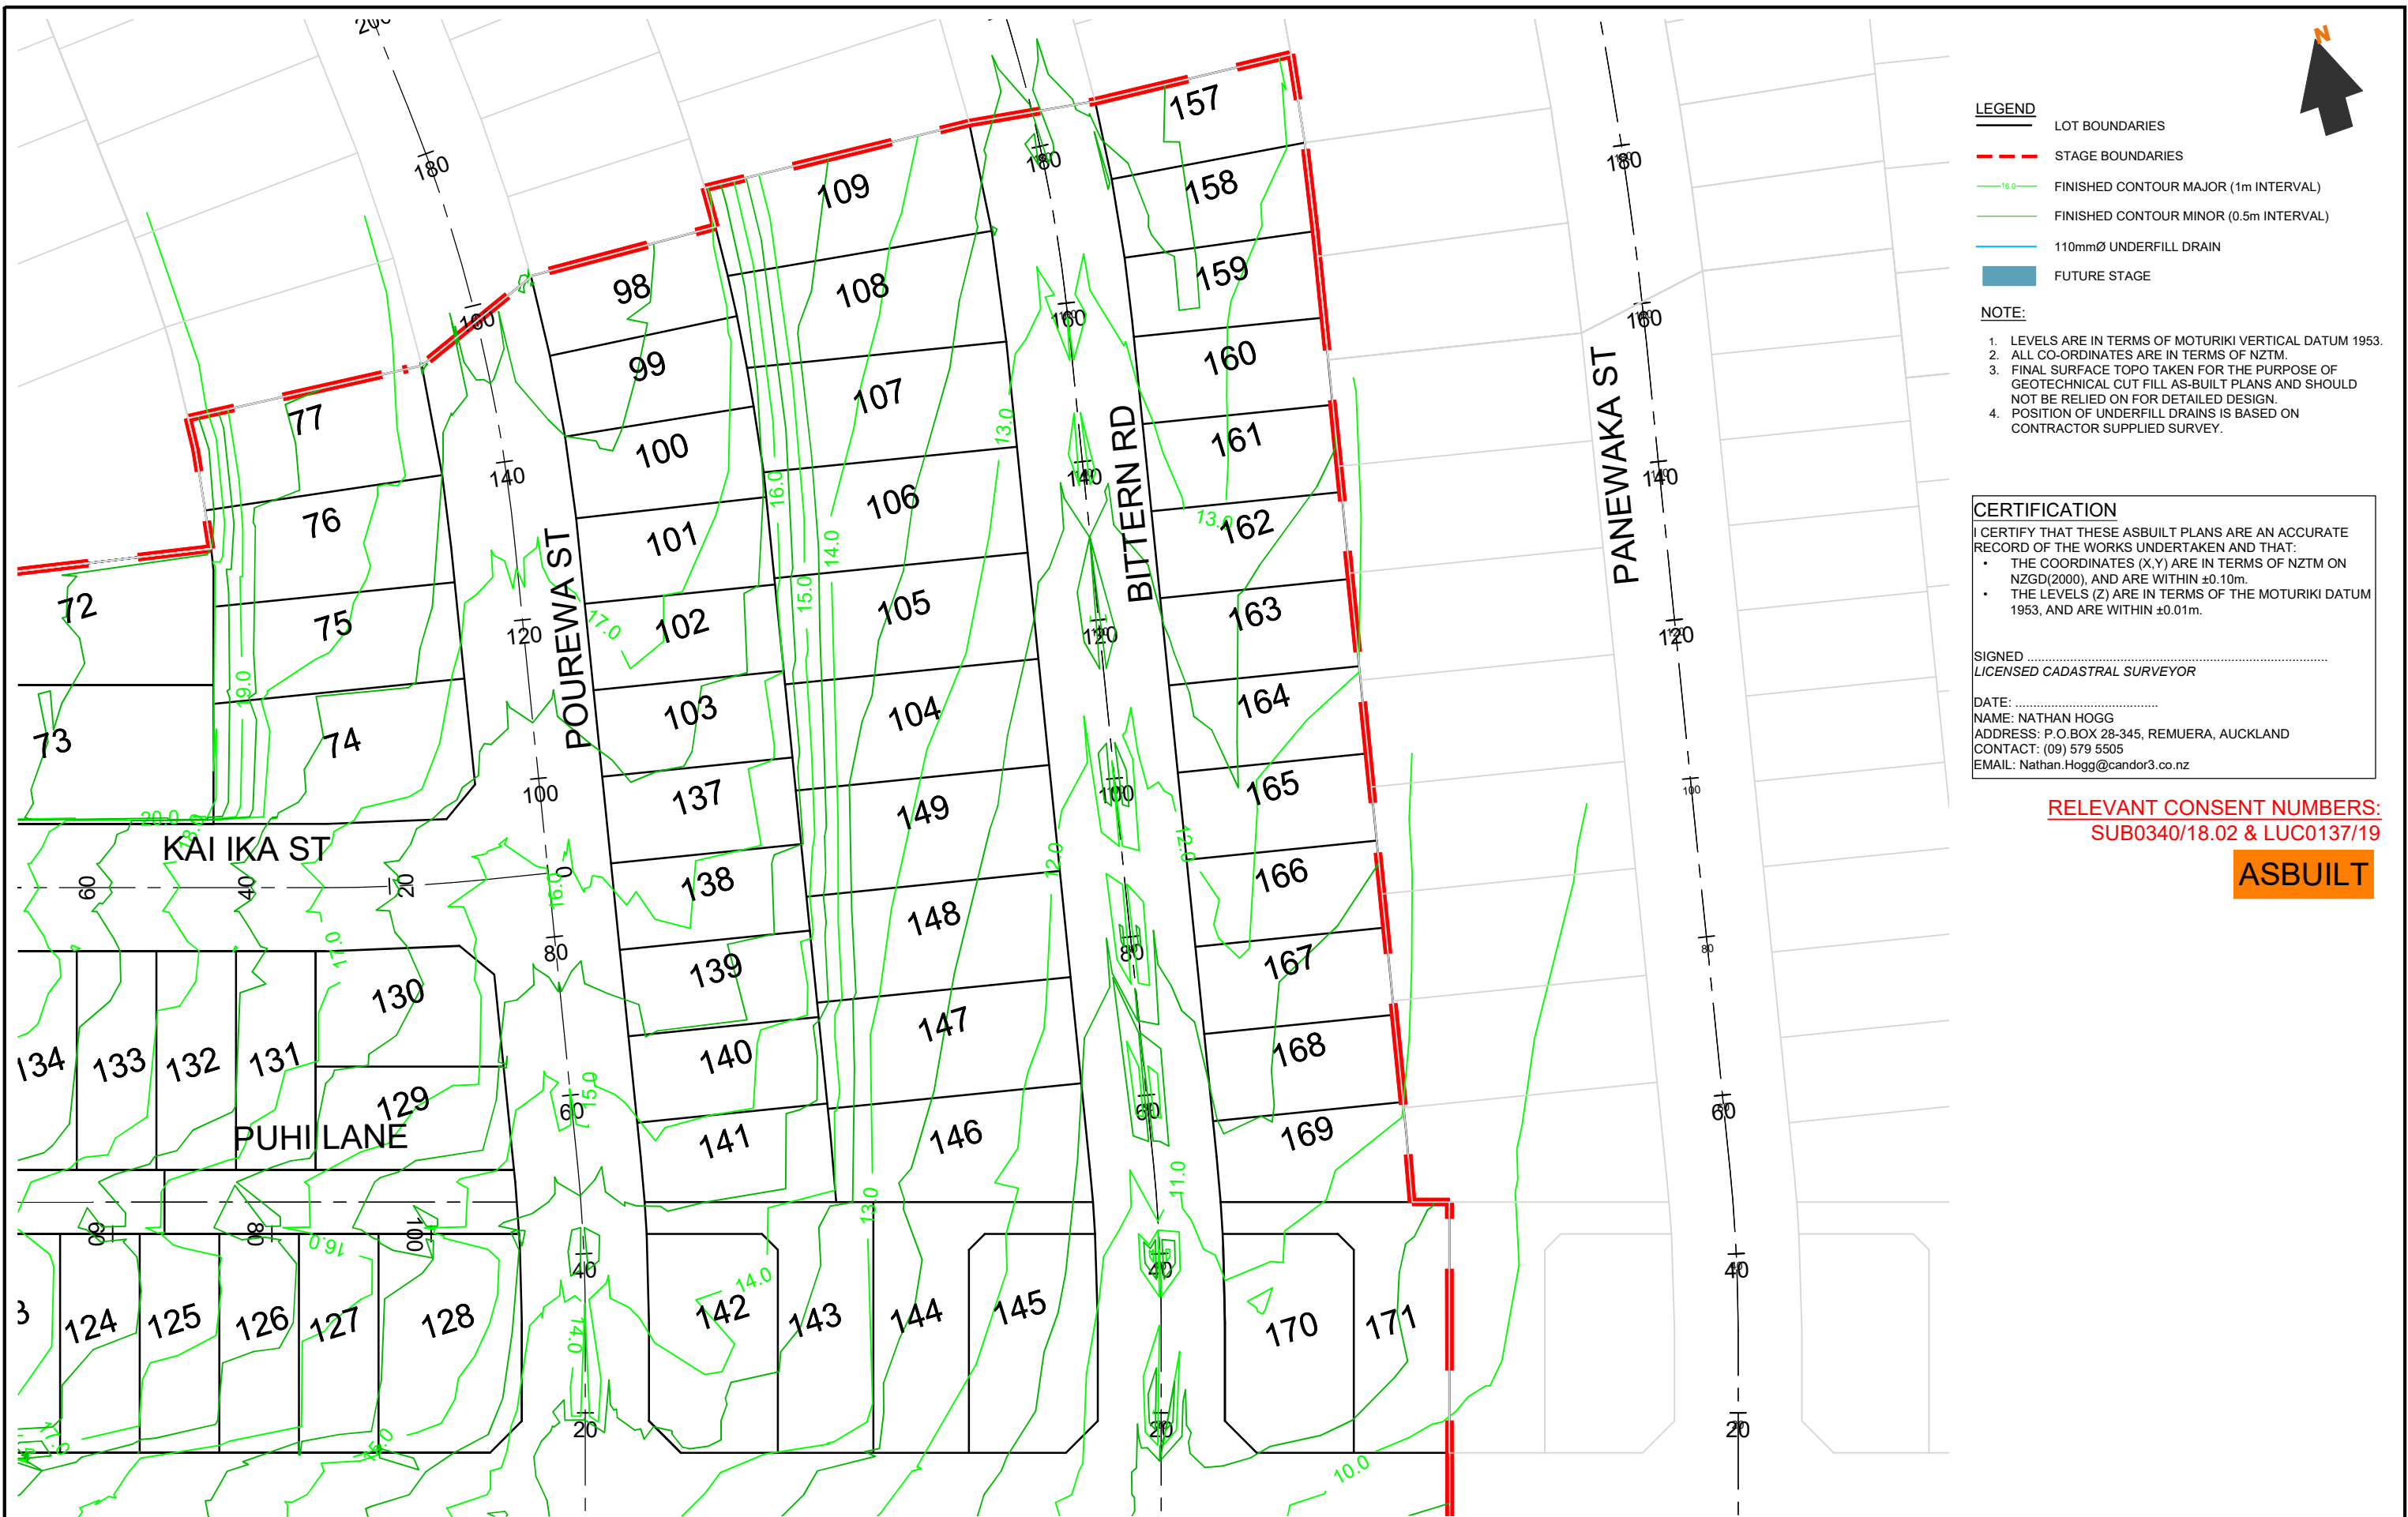

LEGEND

LOT BOUNDARIES

STAGE BOUNDARIES

FINISHED CONTOUR MAJOR (1m INTERVAL)

FINISHED CONTOUR MINOR (0.5m INTERVAL)

110mmØ UNDERFILL DRAIN

FUTURE STAGE

- NOTE:
1. LEVELS ARE IN TERMS OF MOTURIKI VERTICAL DATUM 1953.

2. ALL CO-ORDINATES ARE IN TERMS OF NZTM.

3. FINAL SURFACE TOPO TAKEN FOR THE PURPOSE OF GEOTECHNICAL CUT FILL AS-BUILT PLANS AND SHOULD NOT BE RELIED ON FOR DETAILED DESIGN.

4. POSITION OF UNDERFILL DRAINS IS BASED ON CONTRACTOR SUPPLIED SURVEY.

CERTIFICATION

I CERTIFY THAT THESE ASBUILT PLANS ARE AN ACCURATE RECORD OF THE WORKS UNDERTAKEN AND THAT:

- THE COORDINATES (X,Y) ARE IN TERMS OF NZTM ON NZGD(2000), AND ARE WITHIN ±0.10m.
- THE LEVELS (Z) ARE IN TERMS OF THE MOTURIKI DATUM 1953, AND ARE WITHIN ±0.01m.

SIGNED
LICENSED CADASTRAL SURVEYOR


DATE:
NAME: NATHAN HOGG
ADDRESS: P.O.BOX 28-345, REMUERA, AUCKLAND
CONTACT: (09) 579 5505
EMAIL: Nathan.Hogg@candor3.co.nz

RELEVANT CONSENT NUMBERS:
SUB0340/18.02 & LUC0137/19

ASBUILT

REV DESCRIPTION		BY	APPVD	DATE	PROJECT		CLIENT		PURPOSE		
					LAKESIDE, TE KAUWHATA		LAKESIDE		AS-BUILT		
					EARTHWORKS FINISHED SURFACE STAGE 6		DEVELOPMENTS 2017		DESIGN JS	APPROVED BY NH	SCALE 1:750 @ A3
					SHEET 4 OF 4		LIMITED		CHECK RS	DATE MAR 2021	
									PROJECT NO.	DRAWING NO.	REV.
									1239	AB-2-203	-



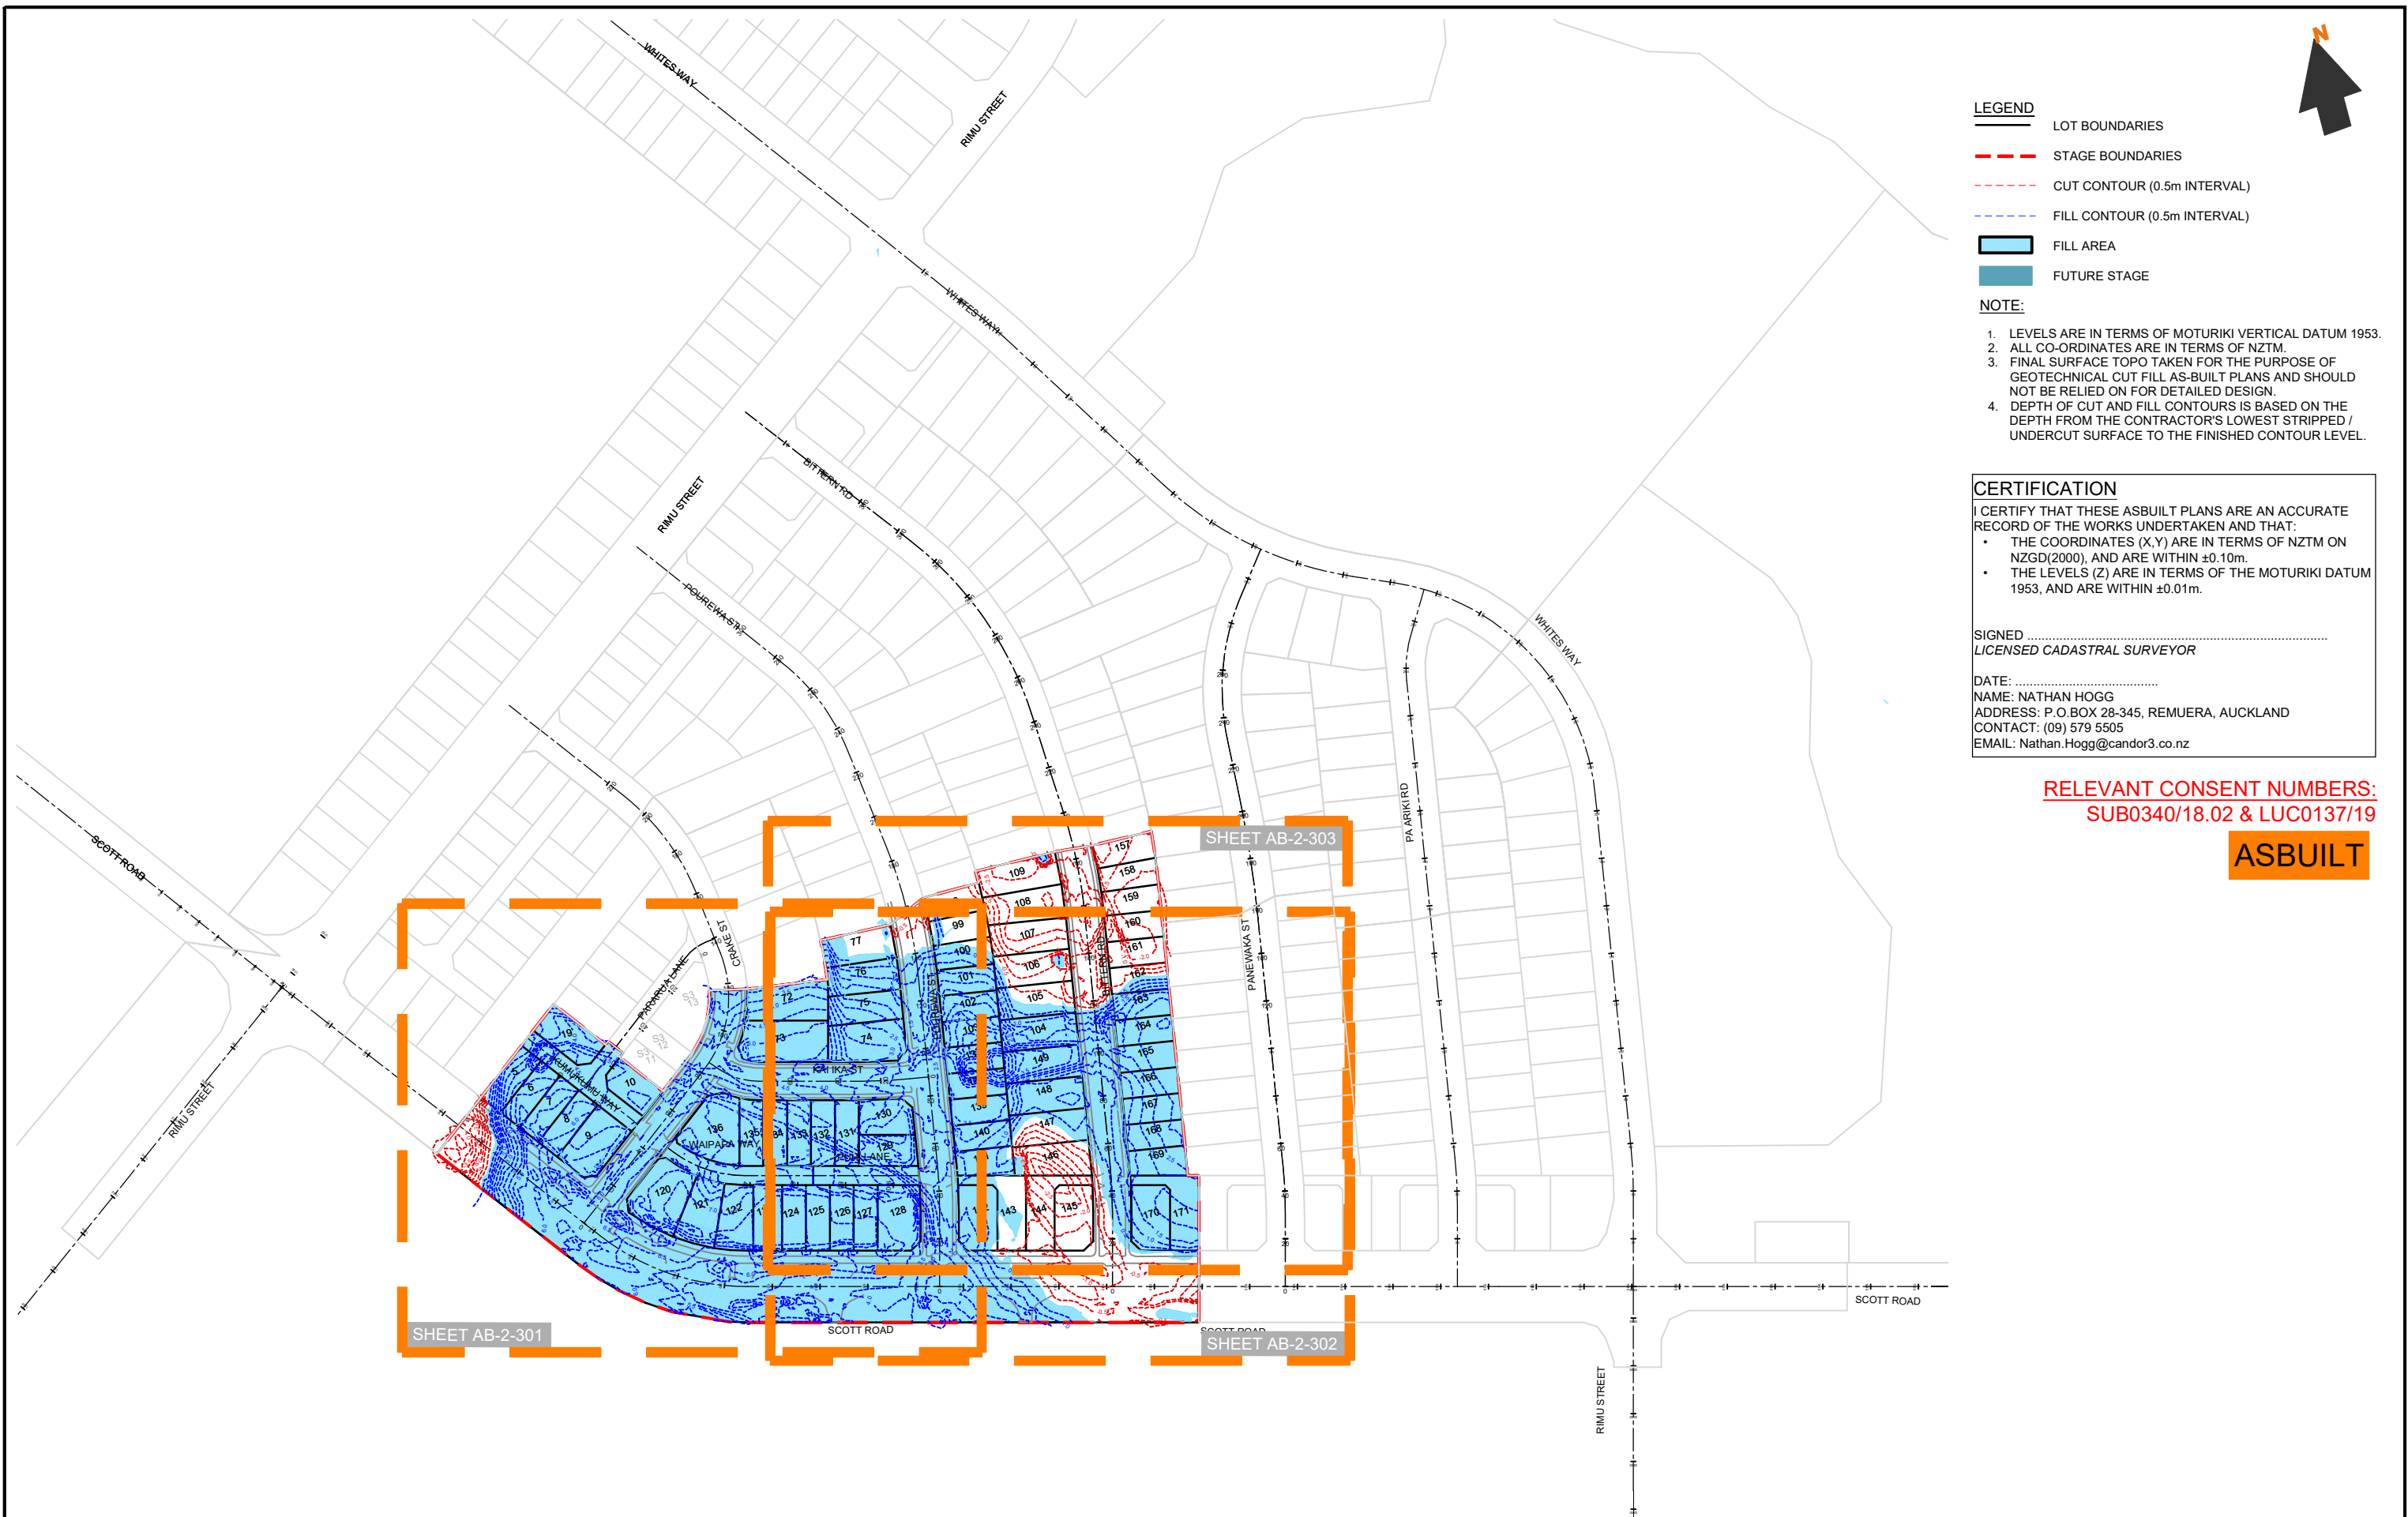

LEGEND

- LOT BOUNDARIES
- STAGE BOUNDARIES
- CUT CONTOUR (0.5m INTERVAL)
- FILL CONTOUR (0.5m INTERVAL)
- FILL AREA
- FUTURE STAGE

NOTE:

- LEVELS ARE IN TERMS OF MOTURIKI VERTICAL DATUM 1953.
- ALL CO-ORDINATES ARE IN TERMS OF NZTM.
- FINAL SURFACE TOPO TAKEN FOR THE PURPOSE OF GEOTECHNICAL CUT FILL AS-BUILT PLANS AND SHOULD NOT BE RELIED ON FOR DETAILED DESIGN.
- DEPTH OF CUT AND FILL CONTOURS IS BASED ON THE DEPTH FROM THE CONTRACTOR'S LOWEST STRIPPED / UNDERCUT SURFACE TO THE FINISHED CONTOUR LEVEL.

CERTIFICATION

I CERTIFY THAT THESE ASBUILT PLANS ARE AN ACCURATE RECORD OF THE WORKS UNDERTAKEN AND THAT:

- THE COORDINATES (X,Y) ARE IN TERMS OF NZTM ON NZGD(2000), AND ARE WITHIN ±0.10m.
- THE LEVELS (Z) ARE IN TERMS OF THE MOTURIKI DATUM 1953, AND ARE WITHIN ±0.01m.


SIGNED
LICENSED CADASTRAL SURVEYOR

DATE:
NAME: NATHAN HOGG
ADDRESS: P.O.BOX 28-345, REMUERA, AUCKLAND
CONTACT: (09) 579 5505
EMAIL: Nathan.Hogg@candor3.co.nz

RELEVANT CONSENT NUMBERS:
SUB0340/18.02 & LUC0137/19

ASBUILT

REV DESCRIPTION		BY	APPVD	DATE	<div>Candor³</div> <div>ENGINEERING FOR LIFE</div>	PROJECT	LAKESIDE, TE KAUWHATA EARTHWORKS DEPTH CONTOURS STAGE 6 SHEET 1 OF 4	CLIENT	LAKESIDE DEVELOPMENTS 2017 LIMITED	PURPOSE		
										AS-BUILT		
DESIGN JS		APPROVED		SCALE								
DRAWN JS		BY NH		1:2500 @ A3								
CHECK RS		DATE MAR 2021										
PROJECT NO.		DRAWING NO.		REV.								
1239		AB-2-300		-								

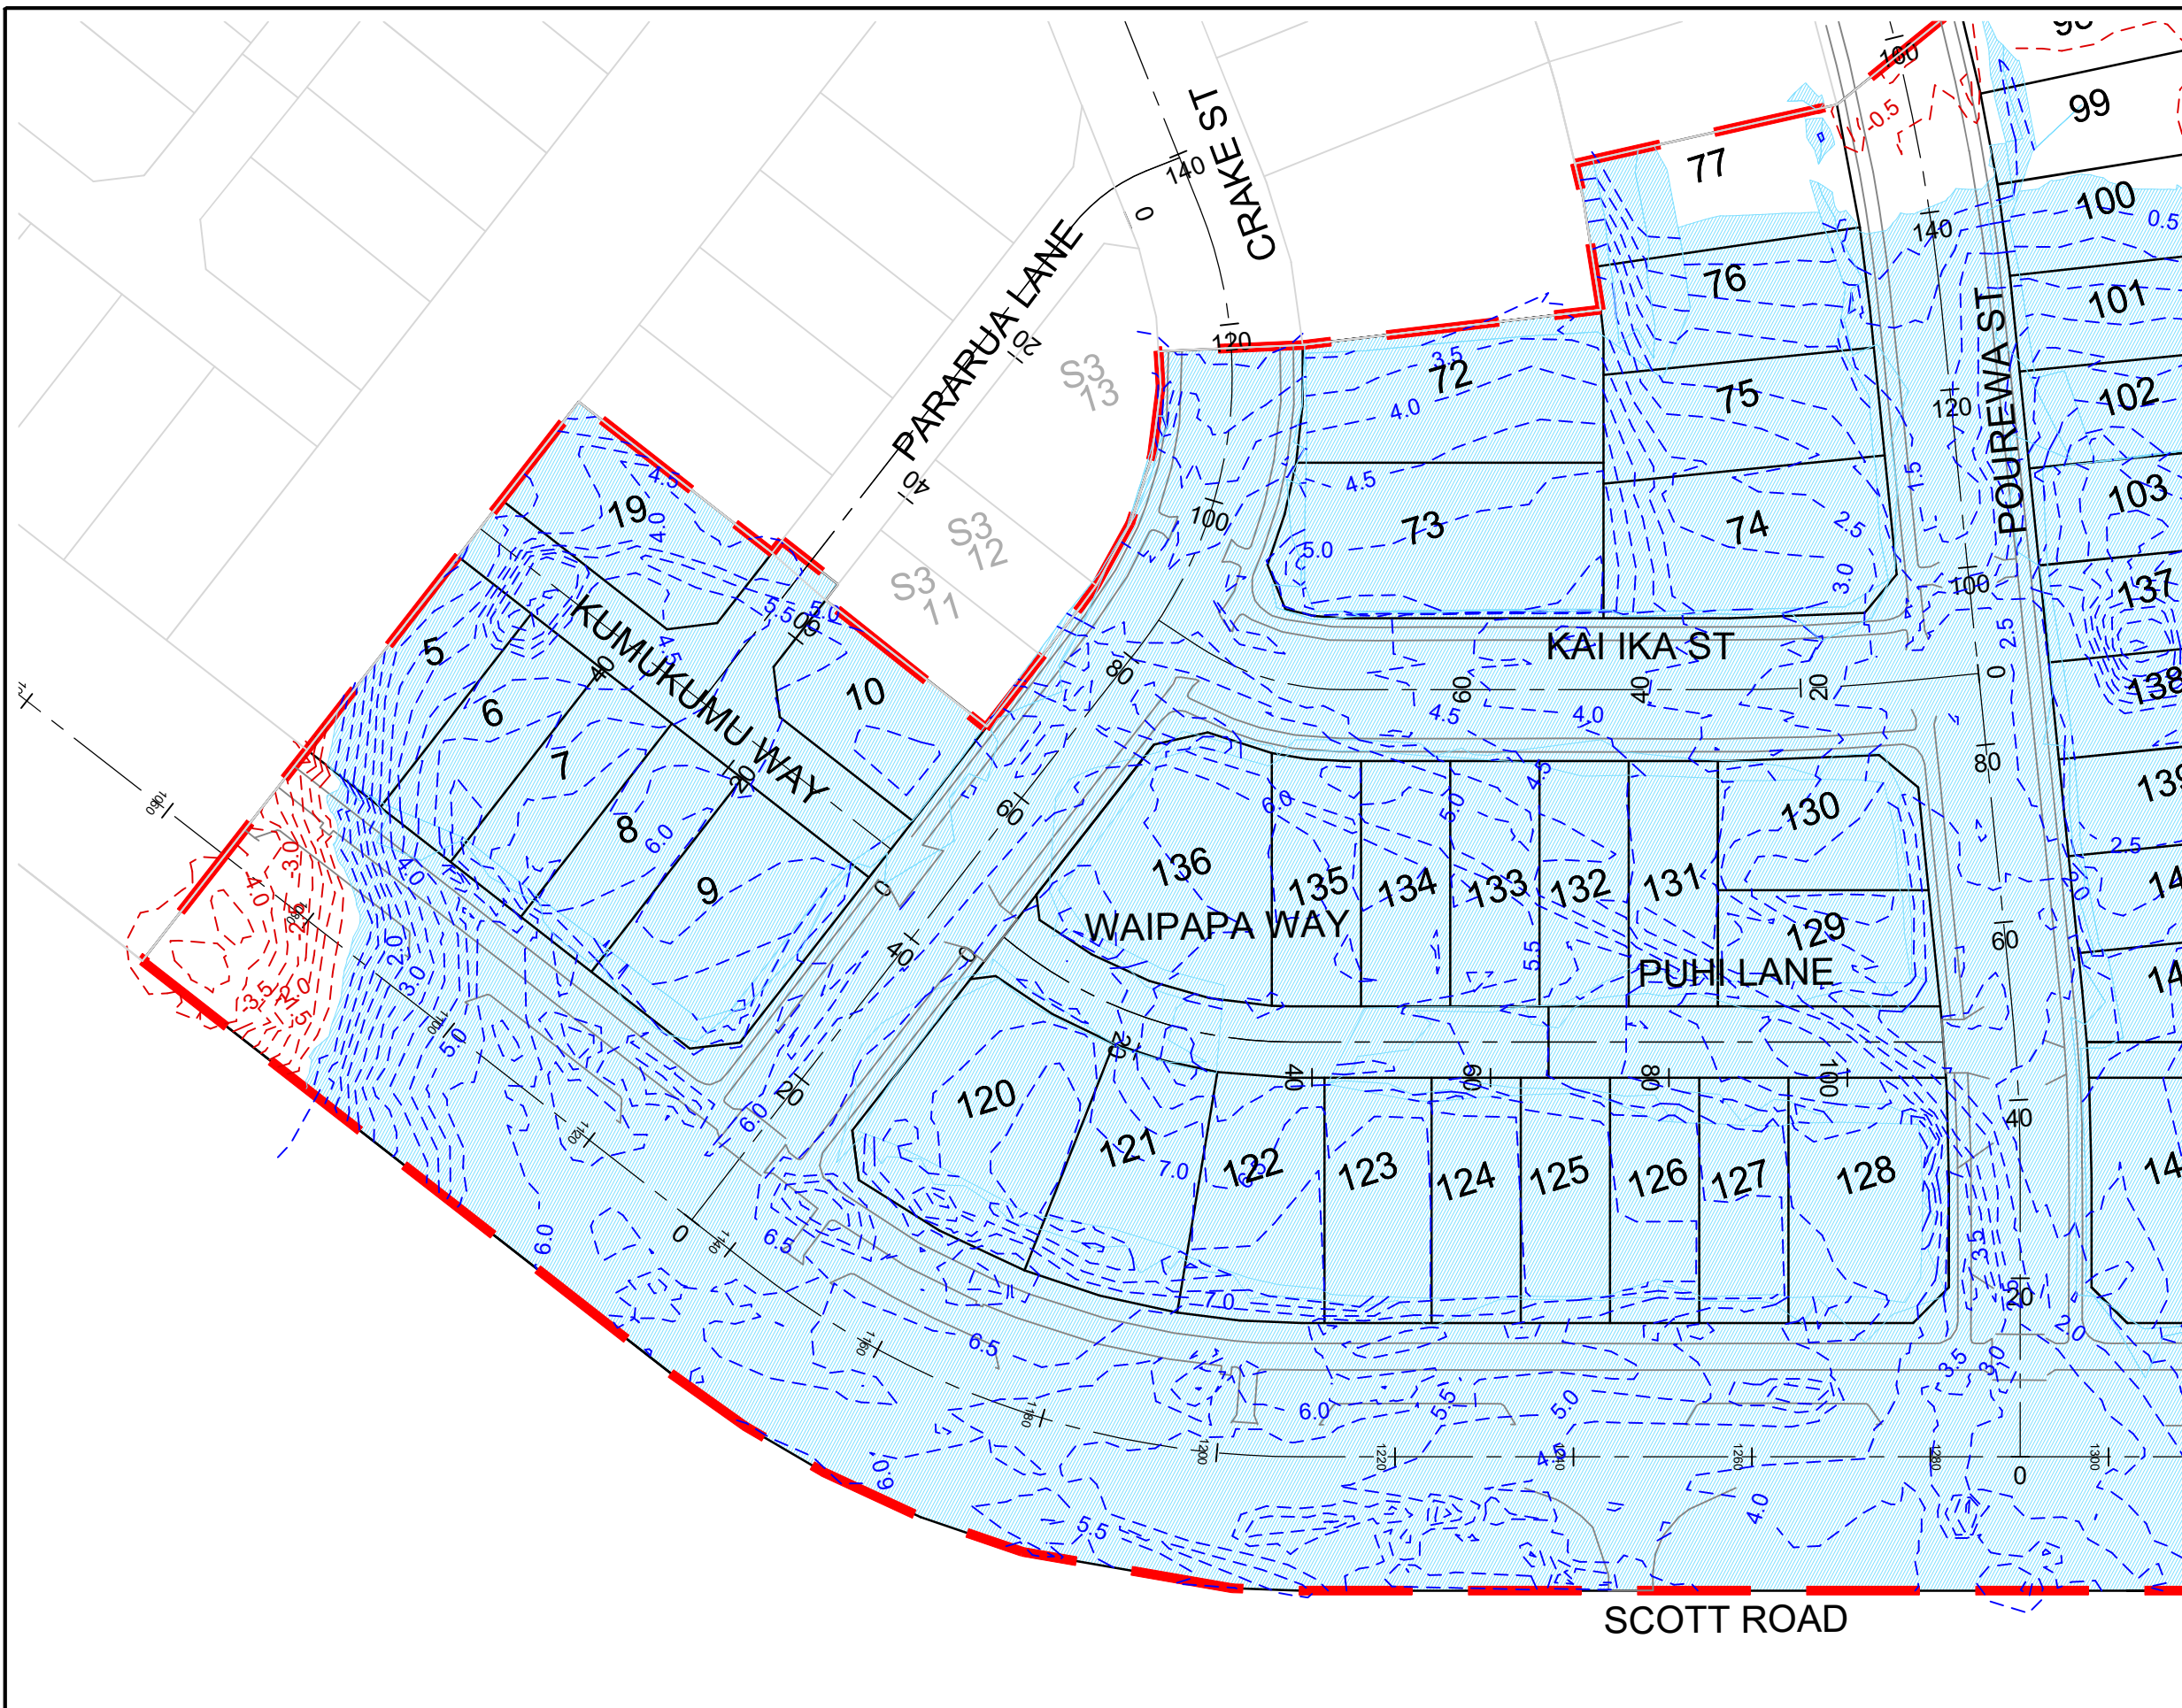

LEGEND

LOT BOUNDARIES

STAGE BOUNDARIES

CUT CONTOUR (0.5m INTERVAL)

FILL CONTOUR (0.5m INTERVAL)

FILL AREA

FUTURE STAGE

NOTE:

1. LEVELS ARE IN TERMS OF MOTURIKI VERTICAL DATUM 1953.

2. ALL CO-ORDINATES ARE IN TERMS OF NZTM.

3. FINAL SURFACE TOPO TAKEN FOR THE PURPOSE OF GEOTECHNICAL CUT FILL AS-BUILT PLANS AND SHOULD NOT BE RELIED ON FOR DETAILED DESIGN.

4. DEPTH OF CUT AND FILL CONTOURS IS BASED ON THE DEPTH FROM THE CONTRACTOR'S LOWEST STRIPPED / UNDERCUT SURFACE TO THE FINISHED CONTOUR LEVEL.

CERTIFICATION

I CERTIFY THAT THESE ASBUILT PLANS ARE AN ACCURATE RECORD OF THE WORKS UNDERTAKEN AND THAT:

- THE COORDINATES (X,Y) ARE IN TERMS OF NZTM ON NZGD(2000), AND ARE WITHIN ±0.10m.
- THE LEVELS (Z) ARE IN TERMS OF THE MOTURIKI DATUM 1953, AND ARE WITHIN ±0.01m.


SIGNED
LICENSED CADASTRAL SURVEYOR


DATE:
NAME: NATHAN HOGG
ADDRESS: P.O.BOX 28-345, REMUERA, AUCKLAND
CONTACT: (09) 579 5505
EMAIL: Nathan.Hogg@candor3.co.nz

RELEVANT CONSENT NUMBERS:
SUB0340/18.02 & LUC0137/19

ASBUILT

REV DESCRIPTION		BY APPVD DATE	<div>Candor³</div> <div>ENGINEERING FOR LIFE</div>	PROJECT LAKESIDE, TE KAUWHATA EARTHWORKS DEPTH CONTOURS STAGE 6 SHEET 2 OF 4	CLIENT LAKESIDE DEVELOPMENTS 2017 LIMITED	PURPOSE AS-BUILT		
						DESIGN JS DRAWN JS CHECK RS	APPROVED BY NH DATE MAR 2021	SCALE 1:750 @ A3
						PROJECT NO.	DRAWING NO.	REV.
						1239	AB-2-301	-

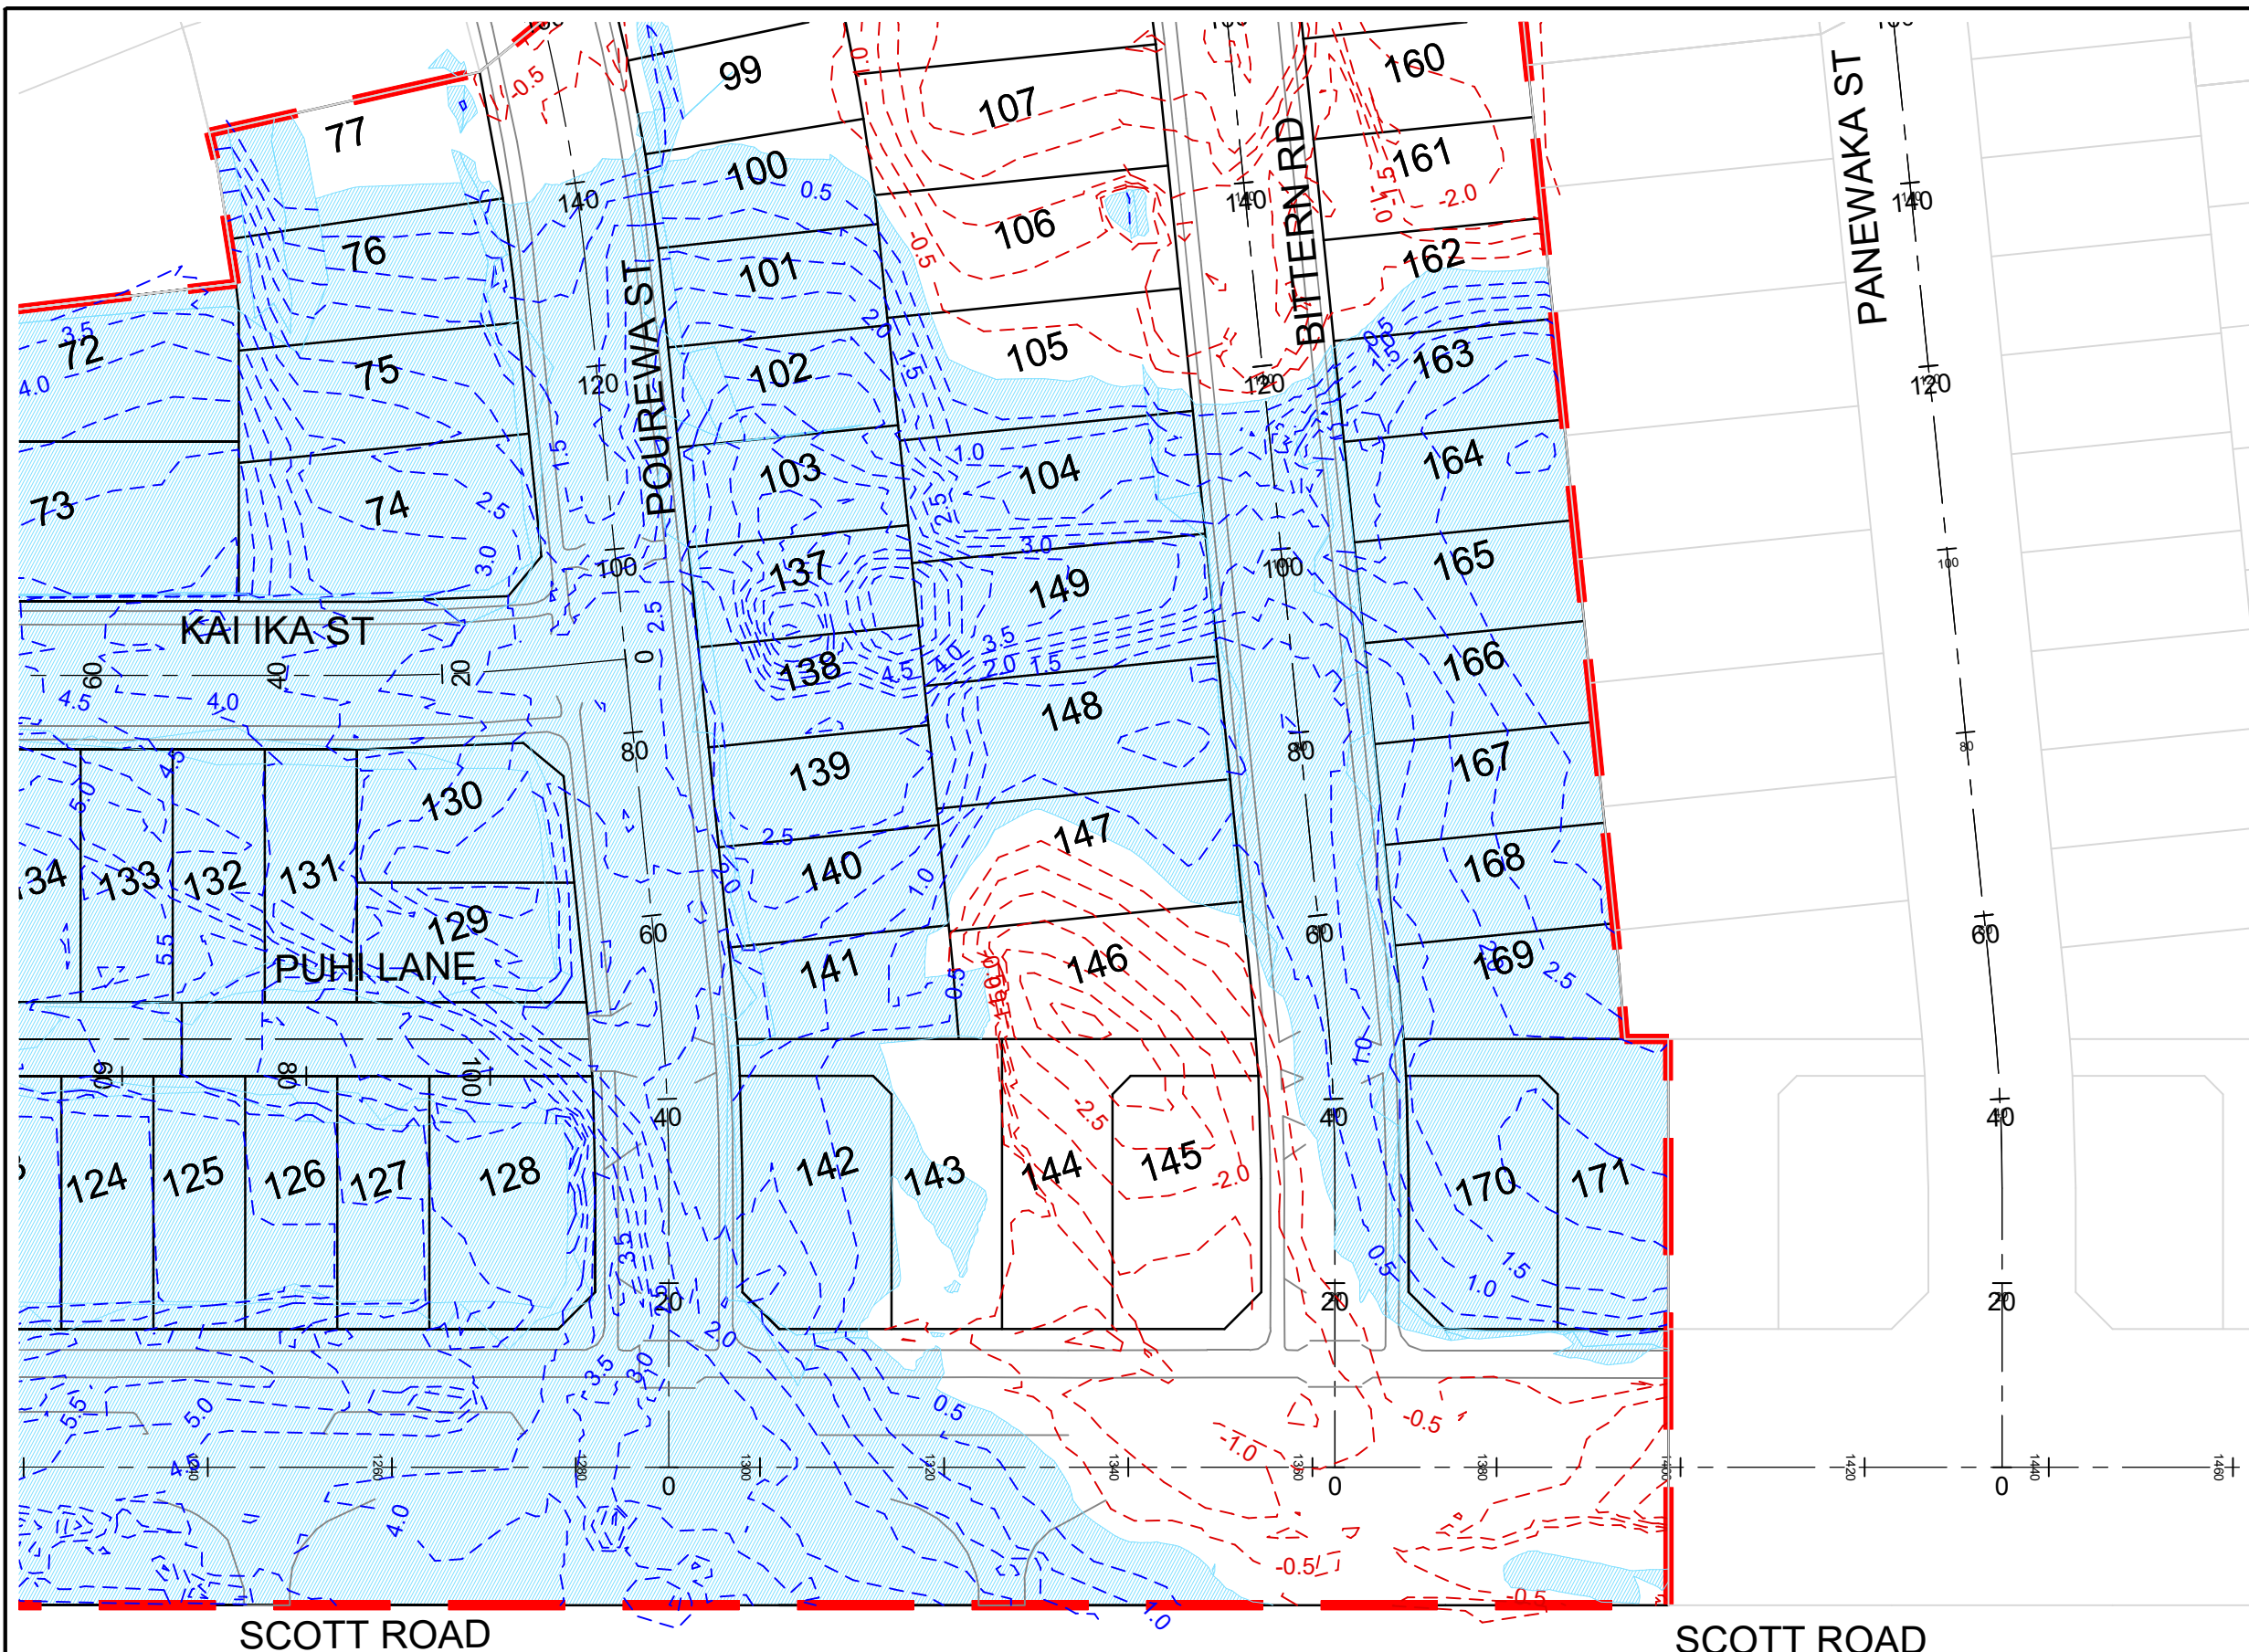

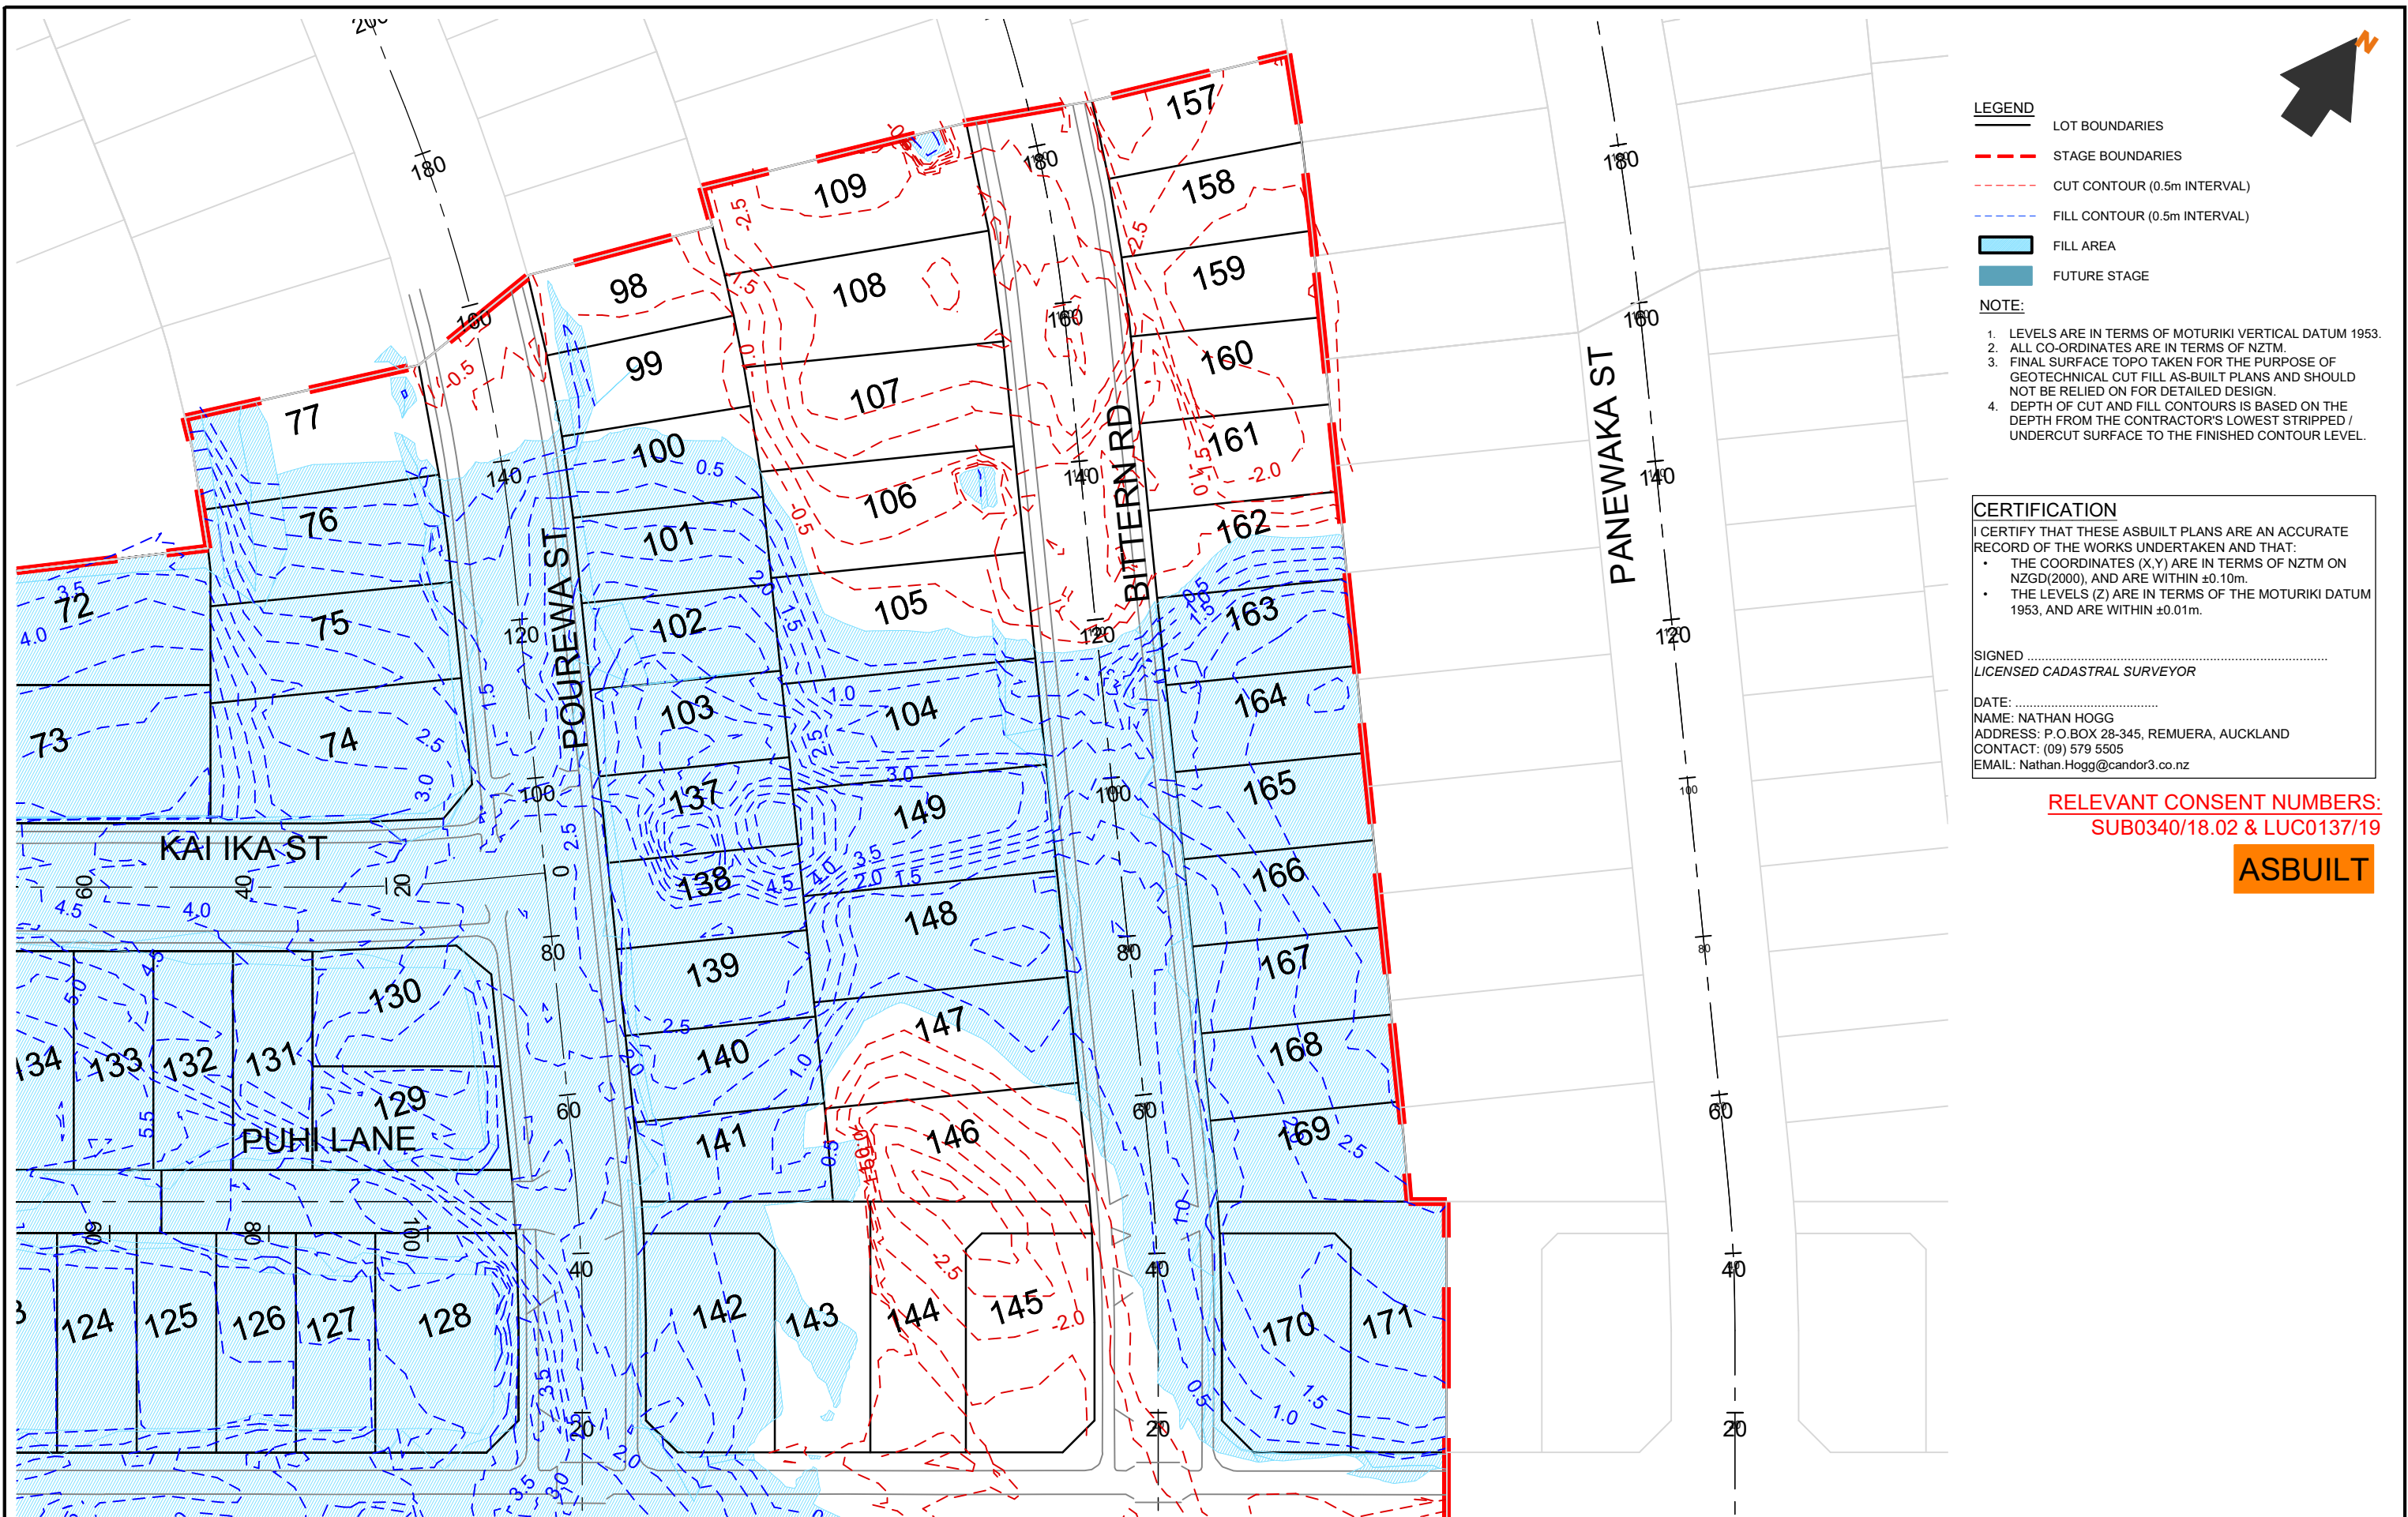

- LEGEND**
- LOT BOUNDARIES
 - STAGE BOUNDARIES
 - CUT CONTOUR (0.5m INTERVAL)
 - FILL CONTOUR (0.5m INTERVAL)
 - FILL AREA
 - FUTURE STAGE
- NOTE:**
- LEVELS ARE IN TERMS OF MOTURIKI VERTICAL DATUM 1953.
 - ALL CO-ORDINATES ARE IN TERMS OF NZTM.
 - FINAL SURFACE TOPO TAKEN FOR THE PURPOSE OF GEOTECHNICAL CUT FILL AS-BUILT PLANS AND SHOULD NOT BE RELIED ON FOR DETAILED DESIGN.
 - DEPTH OF CUT AND FILL CONTOURS IS BASED ON THE DEPTH FROM THE CONTRACTOR'S LOWEST STRIPPED / UNDERCUT SURFACE TO THE FINISHED CONTOUR LEVEL.

CERTIFICATION

I CERTIFY THAT THESE ASBUILT PLANS ARE AN ACCURATE RECORD OF THE WORKS UNDERTAKEN AND THAT:

- THE COORDINATES (X,Y) ARE IN TERMS OF NZTM ON NZGD(2000), AND ARE WITHIN ±0.10m.
- THE LEVELS (Z) ARE IN TERMS OF THE MOTURIKI DATUM 1953, AND ARE WITHIN ±0.01m.

SIGNED
LICENSED CADASTRAL SURVEYOR

DATE:
NAME: NATHAN HOGG
ADDRESS: P.O.BOX 28-345, REMUERA, AUCKLAND
CONTACT: (09) 579 5505
EMAIL: Nathan.Hogg@candor3.co.nz

RELEVANT CONSENT NUMBERS:
SUB0340/18.02 & LUC0137/19

ASBUILT

REV DESCRIPTION		BY APPVD DATE	<div>Candor³</div> <div>ENGINEERING FOR LIFE</div>	PROJECT LAKESIDE, TE KAUWHATA EARTHWORKS DEPTH CONTOURS STAGE 6 SHEET 4 OF 4	CLIENT LAKESIDE DEVELOPMENTS 2017 LIMITED	PURPOSE AS-BUILT		
DESIGN JS DRAWN JS CHECK RS		APPROVED BY NH DATE MAR 2021				SCALE 1:750 @ A3	PROJECT NO. 1239	DRAWING NO. AB-2-303
							REV.	-