

- LEGEND**
- LOT BOUNDARIES
 - STAGE BOUNDARIES
 - ROAD CENTRELINE
 - RAINGARDEN AND OUTLET PIPE
 - NEW STORMWATER PIPE
 - (17.4m)
@ CH58.92 NEW STORMWATER LOT CONNECTION
 - NEW STORMWATER SINGLE CATCHPIT / DOUBLE CATCHPIT
 - EXISTING STORMWATER PIPE
 - EXISTING SINGLE / DOUBLE CATCHPIT
 - ABANDONED STORMWATER PIPE
 - STORMWATER MANHOLE EXISTING / NEW / ABANDONED
 - GRASSED SW TREATMENT SWALE
 - FUTURE STAGE

- NOTES**
- ALL WORKS AND MATERIALS COMPLY WITH THE WAIKATO LOCAL AUTHORITY SHARED SERVICES REGIONAL INFRASTRUCTURE TECHNICAL SPECIFICATIONS (RITS) (MAY 2018).
 - MANHOLES ARE TO BE 1050mm Ø CONCRETE MANHOLES UNLESS OTHERWISE NOTED.
 - PIPES ARE CLASS 2 RCRRJ UNLESS OTHERWISE NOTED.
 - ALL SINGLE CATCHPIT LEADS ARE CLASS 4 RCRRJ 225mm Ø AND ALL DOUBLE CATCHPIT LEADS ARE CLASS 4 RCRRJ 300mm Ø UNLESS OTHERWISE NOTED.
 - PIPE CROSSINGS UNDER ROADS AND ACCESSWAYS HAVE BEEN HARDFILL BACKFILLED.
 - ALL BELOW GROUND ALIGNMENT OF LATERAL LOT CONNECTIONS AND POSITION OF SADDLE CONNECTIONS OF CATCHPITS ON THE MAIN LINES WAS COMPLETED BY ROSS REID CONTRACTORS.
 - LEVELS ARE IN TERMS OF THE MOTURIKI DATUM 1953.
 - ALL CO-ORDINATES ARE IN TERMS OF NZTM.
 - ALL LOT CONNECTION PIPES ARE 100mmØ u-PVC SN16.

CERTIFICATION
I CERTIFY THAT THESE ASBUILT PLANS ARE AN ACCURATE RECORD OF THE WORKS UNDERTAKEN AND THAT:
• THE COORDINATES (X,Y) ARE IN TERMS OF NZTM ON NZGD(2000), AND ARE WITHIN ±0.10m.
• THE LEVELS (Z) ARE IN TERMS OF THE MOTURIKI DATUM 1953, AND ARE WITHIN ±0.01m.


SIGNED
LICENSED CADASTRAL SURVEYOR

DATE:
NAME: NATHAN HOGG
ADDRESS: P.O. BOX 28-345, REMUERA, AUCKLAND
CONTACT: (09) 579 5505
EMAIL: Nathan.Hogg@candor3.co.nz

RELEVANT CONSENT NUMBERS:
SUB0340/18.02 & LUC0137/19

ASBUILT

REV	DESCRIPTION	BY	APPVD	DATE	PROJECT	CLIENT	PURPOSE
					LAKESIDE, TE KAUWHATA STORMWATER LAYOUT STAGE 6 1 OF 4	LAKESIDE DEVELOPMENTS 2017 LIMITED	AS-BUILT
							DESIGN JS DRAWN JS CHECK RS
							APPROVED BY NH DATE MAR 2021
							SCALE 1:2500 @ A3
							PROJECT NO. 1239
							DRAWING NO. AB-4-100
							REV. -

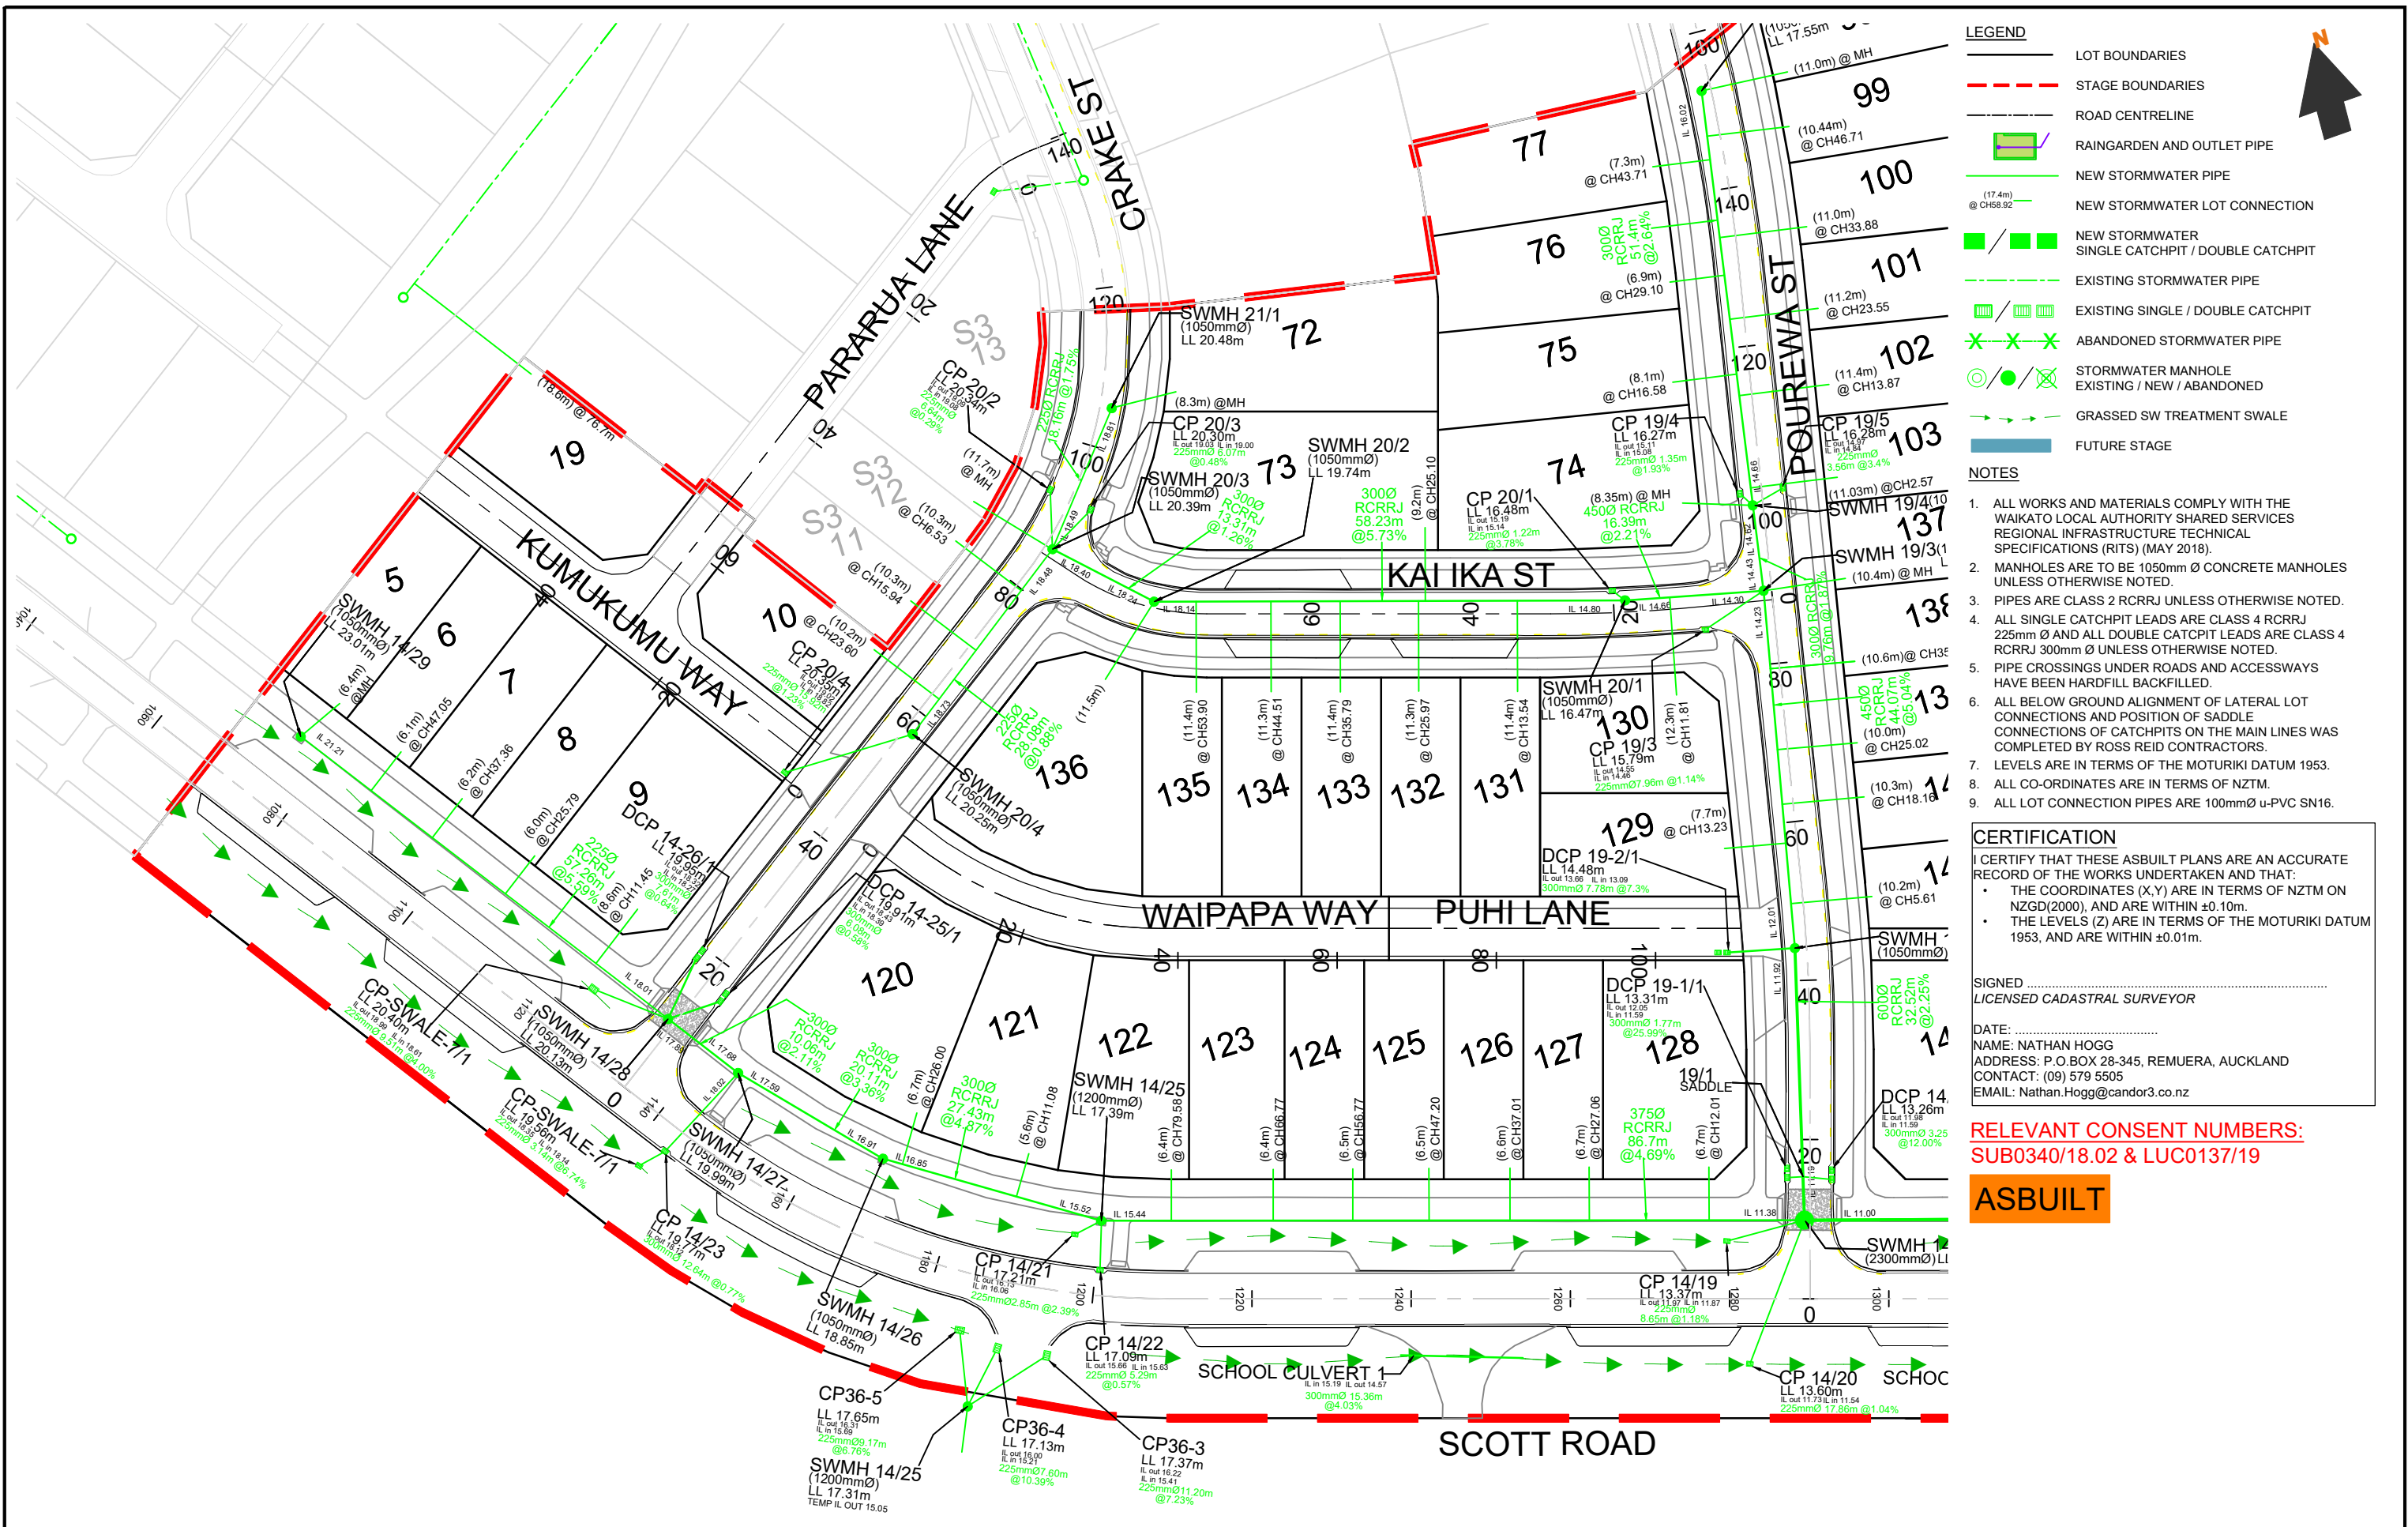

- LEGEND**
- LOT BOUNDARIES
 - STAGE BOUNDARIES
 - ROAD CENTRELINE
 - RAINGARDEN AND OUTLET PIPE
 - NEW STORMWATER PIPE
 - NEW STORMWATER LOT CONNECTION
 - NEW STORMWATER SINGLE CATCHPIT / DOUBLE CATCHPIT
 - EXISTING STORMWATER PIPE
 - EXISTING SINGLE / DOUBLE CATCHPIT
 - ABANDONED STORMWATER PIPE
 - STORMWATER MANHOLE EXISTING / NEW / ABANDONED
 - GRASSED SW TREATMENT SWALE
 - FUTURE STAGE

- NOTES**
- ALL WORKS AND MATERIALS COMPLY WITH THE WAIKATO LOCAL AUTHORITY SHARED SERVICES REGIONAL INFRASTRUCTURE TECHNICAL SPECIFICATIONS (RITS) (MAY 2018).
 - MANHOLES ARE TO BE 1050mm Ø CONCRETE MANHOLES UNLESS OTHERWISE NOTED.
 - PIPES ARE CLASS 2 RCRRJ UNLESS OTHERWISE NOTED.
 - ALL SINGLE CATCHPIT LEADS ARE CLASS 4 RCRRJ 225mm Ø AND ALL DOUBLE CATCHPIT LEADS ARE CLASS 4 RCRRJ 300mm Ø UNLESS OTHERWISE NOTED.
 - PIPE CROSSINGS UNDER ROADS AND ACCESSWAYS HAVE BEEN HARDFILL BACKFILLED.
 - ALL BELOW GROUND ALIGNMENT OF LATERAL LOT CONNECTIONS AND POSITION OF SADDLE CONNECTIONS OF CATCHPITS ON THE MAIN LINES WAS COMPLETED BY ROSS REID CONTRACTORS.
 - LEVELS ARE IN TERMS OF THE MOTURIKI DATUM 1953.
 - ALL CO-ORDINATES ARE IN TERMS OF NZTM.
 - ALL LOT CONNECTION PIPES ARE 100mm Ø u-PVC SN16.

CERTIFICATION

I CERTIFY THAT THESE ASBUILT PLANS ARE AN ACCURATE RECORD OF THE WORKS UNDERTAKEN AND THAT:

- THE COORDINATES (X,Y) ARE IN TERMS OF NZTM ON NZGD(2000), AND ARE WITHIN ±0.10m.
- THE LEVELS (Z) ARE IN TERMS OF THE MOTURIKI DATUM 1953, AND ARE WITHIN ±0.01m.


SIGNED
LICENSED CADASTRAL SURVEYOR

DATE:
NAME: NATHAN HOGG
ADDRESS: P.O.BOX 28-345, REMUERA, AUCKLAND
CONTACT: (09) 579 5505
EMAIL: Nathan.Hogg@candor3.co.nz

RELEVANT CONSENT NUMBERS:
SUB0340/18.02 & LUC0137/19

ASBUILT

<div>REV DESCRIPTION</div> <div>BY APPVD DATE</div> <div>Candor³ ENGINEERING FOR LIFE</div>	<div>PROJECT</div> <div>LAKESIDE, TE KAUWHATA STORMWATER LAYOUT STAGE 6 2 OF 4</div>	<div>CLIENT</div> <div>LAKESIDE DEVELOPMENTS 2017 LIMITED</div>	<div>PURPOSE</div> <div>AS-BUILT</div> <div>DESIGN JS DRAWN JS CHECK RS</div> <div>APPROVED BY NH DATE MAR 2021</div> <div>SCALE 1:750 @ A3</div> <div>PROJECT NO. 1239</div> <div>DRAWING NO. AB-4-101</div> <div>REV. -</div>
--	--	---	---

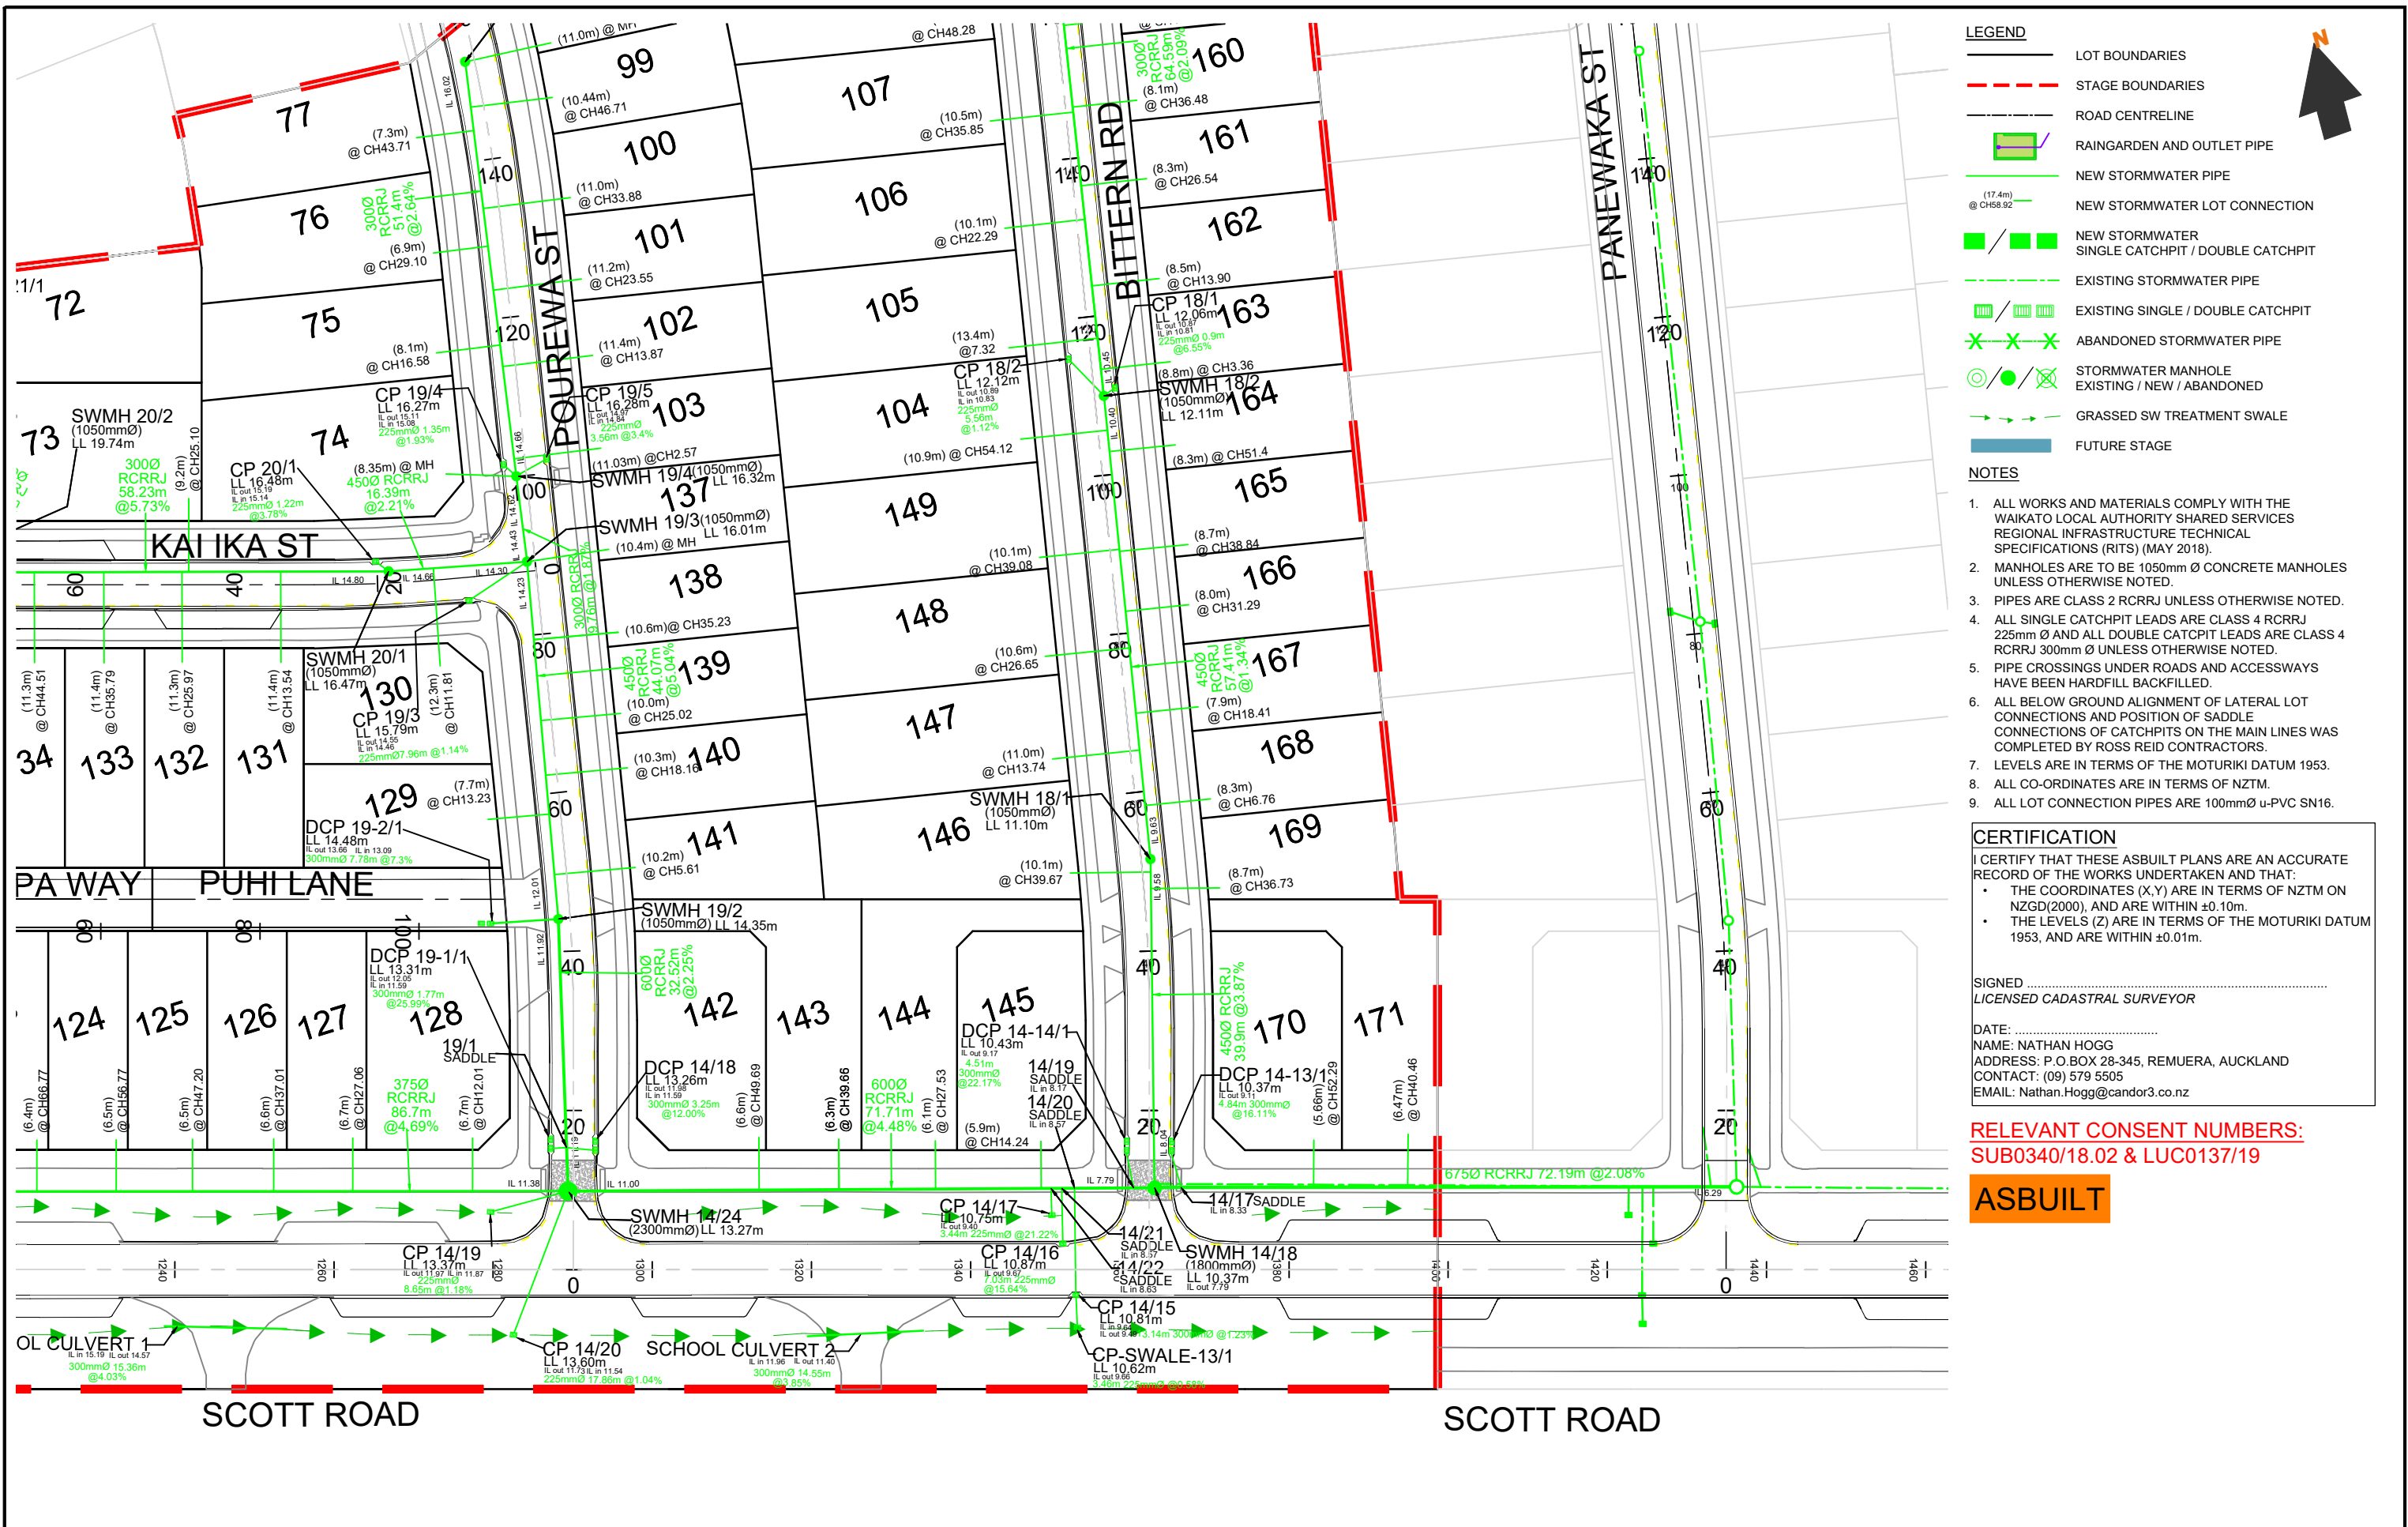

LEGEND

LOT BOUNDARIES

STAGE BOUNDARIES

ROAD CENTRELINE

RAINGARDEN AND OUTLET PIPE

NEW STORMWATER PIPE

NEW STORMWATER LOT CONNECTION

NEW STORMWATER SINGLE CATCHPIT / DOUBLE CATCHPIT

EXISTING STORMWATER PIPE

EXISTING SINGLE / DOUBLE CATCHPIT

ABANDONED STORMWATER PIPE

STORMWATER MANHOLE EXISTING / NEW / ABANDONED

GRASSED SW TREATMENT SWALE

FUTURE STAGE

- NOTES**
1. ALL WORKS AND MATERIALS COMPLY WITH THE WAIKATO LOCAL AUTHORITY SHARED SERVICES REGIONAL INFRASTRUCTURE TECHNICAL SPECIFICATIONS (RITS) (MAY 2018).

2. MANHOLES ARE TO BE 1050mm Ø CONCRETE MANHOLES UNLESS OTHERWISE NOTED.

3. PIPES ARE CLASS 2 RCRRJ UNLESS OTHERWISE NOTED.

4. ALL SINGLE CATCHPIT LEADS ARE CLASS 4 RCRRJ 225mm Ø AND ALL DOUBLE CATCPIT LEADS ARE CLASS 4 RCRRJ 300mm Ø UNLESS OTHERWISE NOTED.

5. PIPE CROSSINGS UNDER ROADS AND ACCESSWAYS HAVE BEEN HARDFILL BACKFILLED.

6. ALL BELOW GROUND ALIGNMENT OF LATERAL LOT CONNECTIONS AND POSITION OF SADDLE CONNECTIONS OF CATCHPITS ON THE MAIN LINES WAS COMPLETED BY ROSS REID CONTRACTORS.

7. LEVELS ARE IN TERMS OF THE MOTURIKI DATUM 1953.

8. ALL CO-ORDINATES ARE IN TERMS OF NZTM.

9. ALL LOT CONNECTION PIPES ARE 100mmØ u-PVC SN16.

CERTIFICATION

I CERTIFY THAT THESE ASBUILT PLANS ARE AN ACCURATE RECORD OF THE WORKS UNDERTAKEN AND THAT:

• THE COORDINATES (X,Y) ARE IN TERMS OF NZTM ON NZGD(2000), AND ARE WITHIN ±0.10m.

• THE LEVELS (Z) ARE IN TERMS OF THE MOTURIKI DATUM 1953, AND ARE WITHIN ±0.01m.

SIGNED

LICENSED CADASTRAL SURVEYOR

DATE:

NAME: NATHAN HOGG

ADDRESS: P.O.BOX 28-345, REMUERA, AUCKLAND


CONTACT: (09) 579 5505

EMAIL: Nathan.Hogg@candor3.co.nz

RELEVANT CONSENT NUMBERS:
SUB0340/18.02 & LUC0137/19

ASBUILT

REV DESCRIPTION				BY	APPVD	DATE	<div>Candor³</div> <div>ENGINEERING FOR LIFE</div>	PROJECT	LAKESIDE, TE KAUWHATA STORMWATER LAYOUT STAGE 6 3 OF 4	CLIENT	LAKESIDE DEVELOPMENTS 2017 LIMITED	PURPOSE AS-BUILT		
								DESIGN JS	APPROVED BY NH		SCALE 1:750 @ A3			
								DRAWN JS	DATE MAR 2021					
								CHECK RS						
								PROJECT NO.		DRAWING NO.		REV.		
							1239		AB-4-102		-			

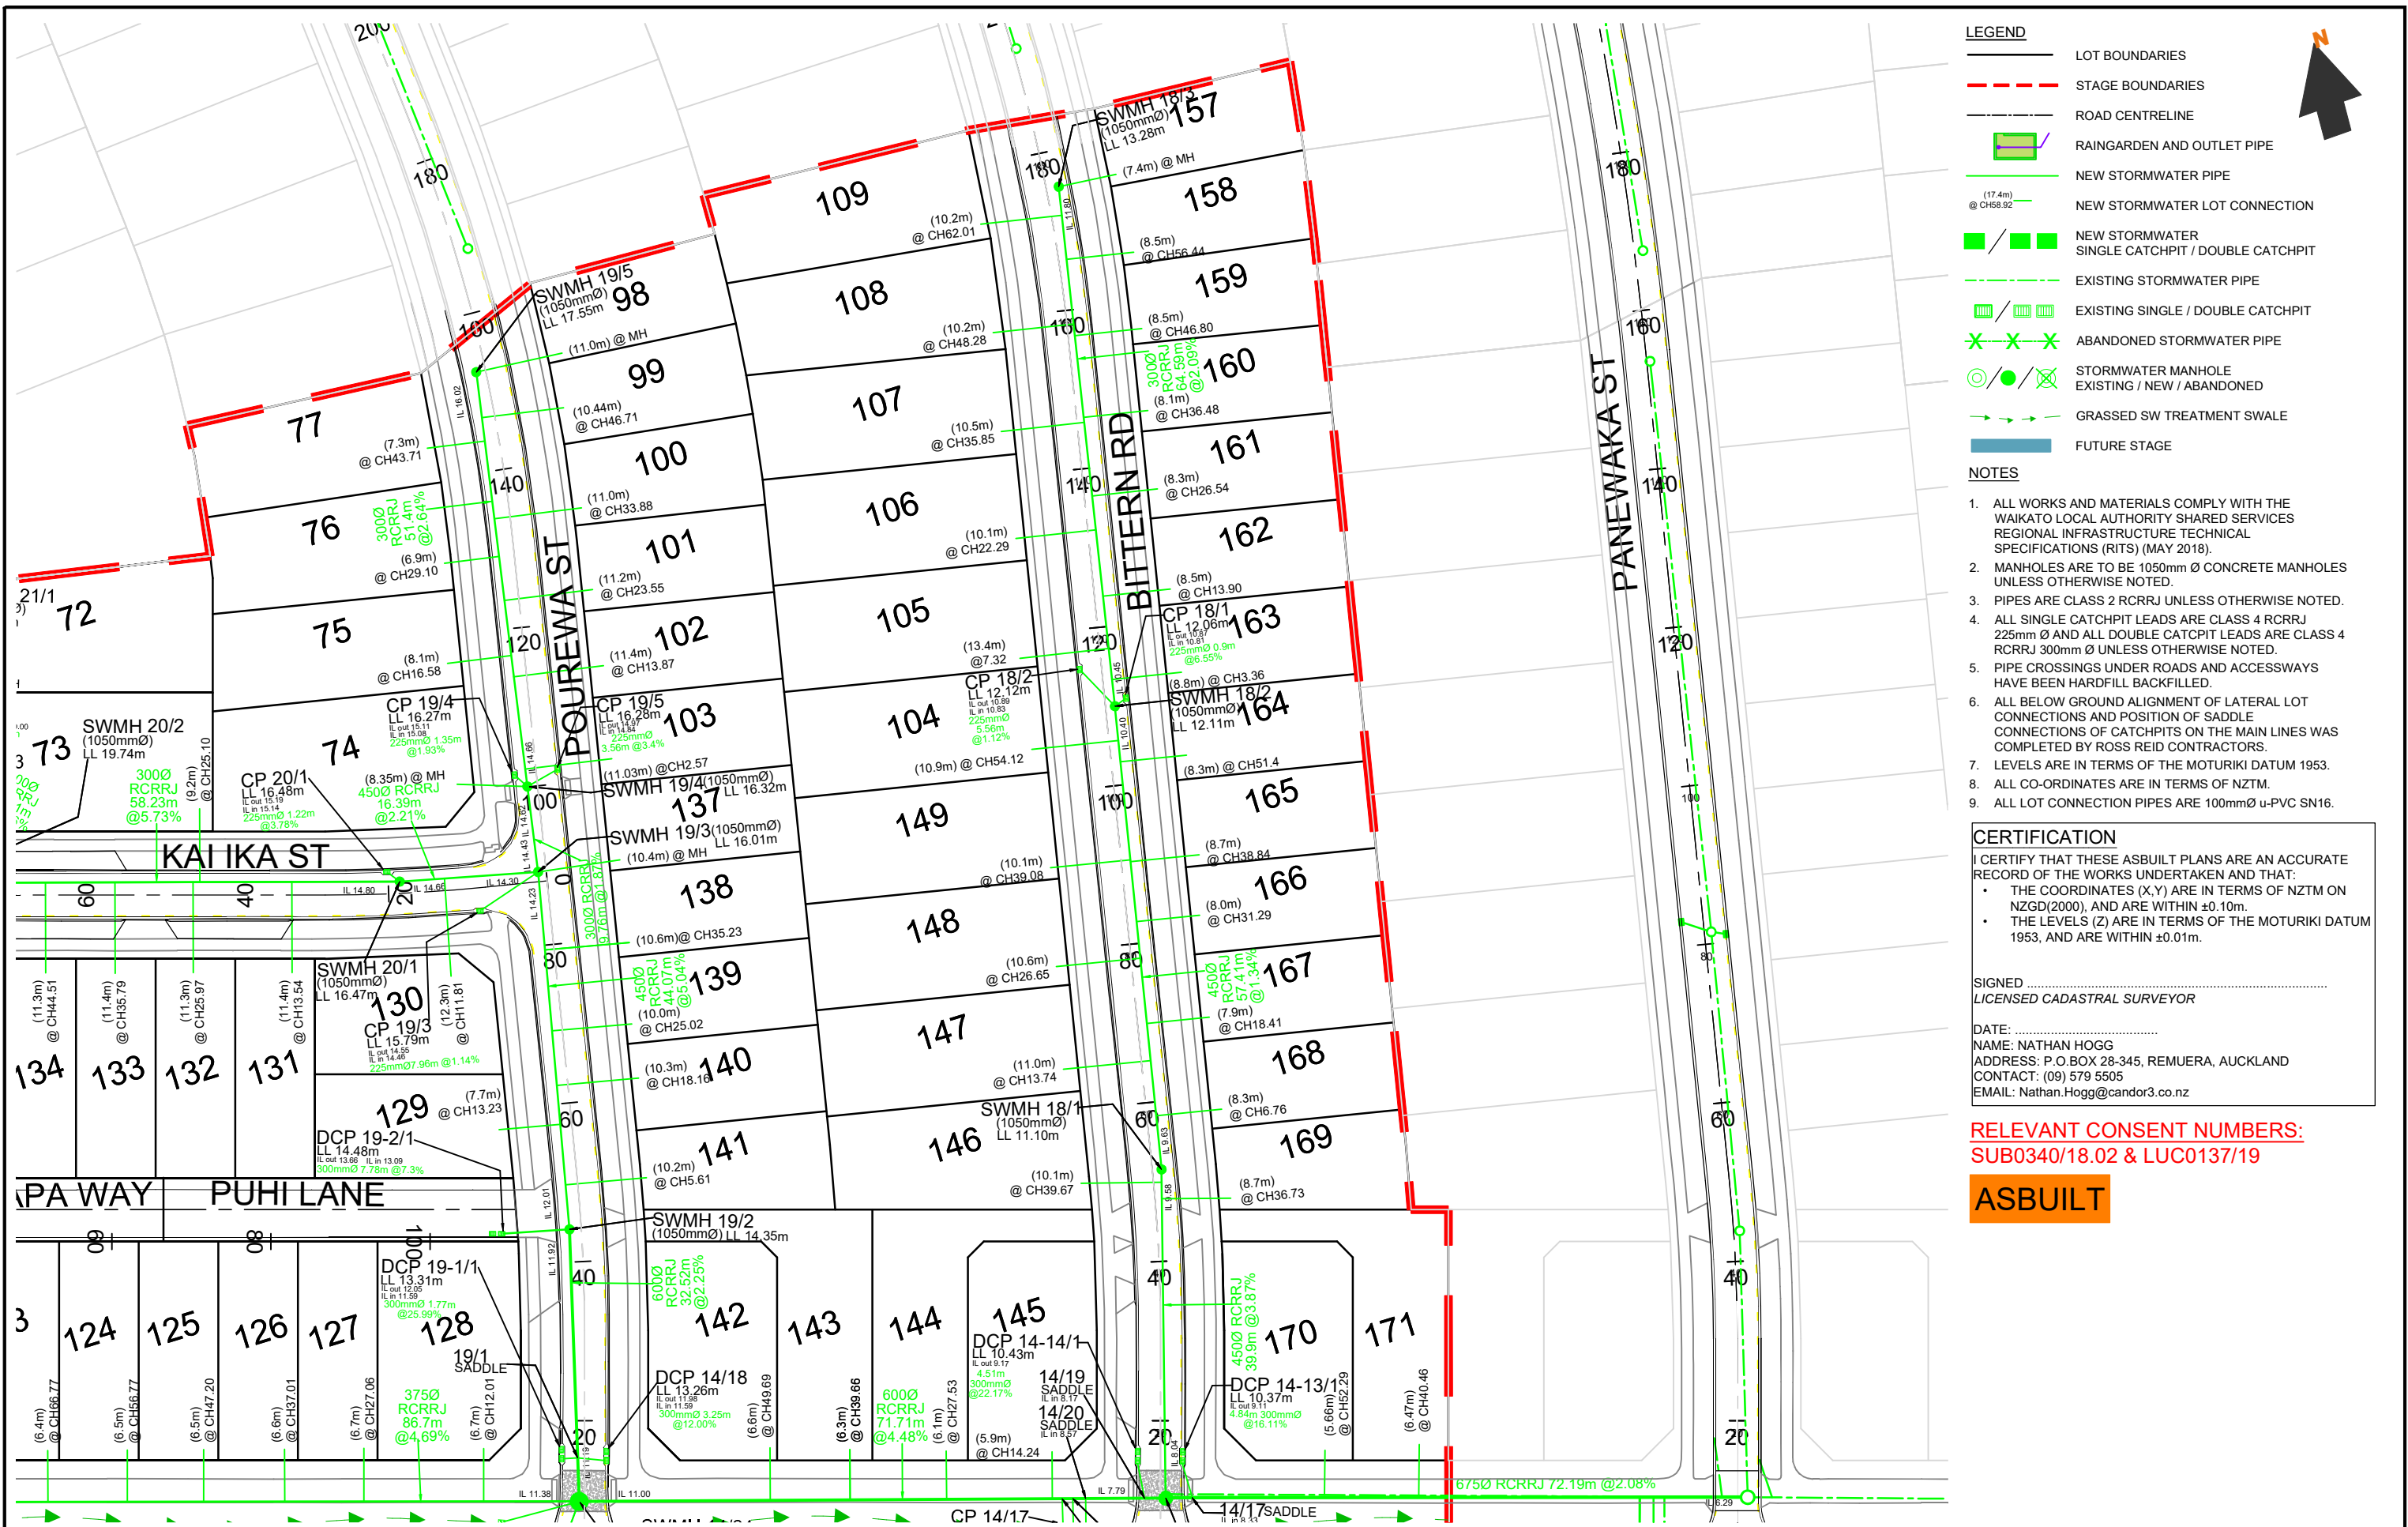

LEGEND

LOT BOUNDARIES

STAGE BOUNDARIES

ROAD CENTRELINE

RAINGARDEN AND OUTLET PIPE

NEW STORMWATER PIPE

NEW STORMWATER LOT CONNECTION

NEW STORMWATER SINGLE CATCHPIT / DOUBLE CATCHPIT

EXISTING STORMWATER PIPE

EXISTING SINGLE / DOUBLE CATCHPIT

ABANDONED STORMWATER PIPE

STORMWATER MANHOLE EXISTING / NEW / ABANDONED

GRASSED SW TREATMENT SWALE

FUTURE STAGE

- NOTES
1. ALL WORKS AND MATERIALS COMPLY WITH THE WAIKATO LOCAL AUTHORITY SHARED SERVICES REGIONAL INFRASTRUCTURE TECHNICAL SPECIFICATIONS (RITS) (MAY 2018).

2. MANHOLES ARE TO BE 1050mm Ø CONCRETE MANHOLES UNLESS OTHERWISE NOTED.

3. PIPES ARE CLASS 2 RCRRJ UNLESS OTHERWISE NOTED.

4. ALL SINGLE CATCHPIT LEADS ARE CLASS 4 RCRRJ 225mm Ø AND ALL DOUBLE CATCHPIT LEADS ARE CLASS 4 RCRRJ 300mm Ø UNLESS OTHERWISE NOTED.

5. PIPE CROSSINGS UNDER ROADS AND ACCESSWAYS HAVE BEEN HARDFILL BACKFILLED.

6. ALL BELOW GROUND ALIGNMENT OF LATERAL LOT CONNECTIONS AND POSITION OF SADDLE CONNECTIONS OF CATCHPITS ON THE MAIN LINES WAS COMPLETED BY ROSS REID CONTRACTORS.

7. LEVELS ARE IN TERMS OF THE MOTURIKI DATUM 1953.

8. ALL CO-ORDINATES ARE IN TERMS OF NZTM.

9. ALL LOT CONNECTION PIPES ARE 100mmØ u-PVC SN16.

CERTIFICATION

I CERTIFY THAT THESE ASBUILT PLANS ARE AN ACCURATE RECORD OF THE WORKS UNDERTAKEN AND THAT:

- THE COORDINATES (X,Y) ARE IN TERMS OF NZTM ON NZGD(2000), AND ARE WITHIN ±0.10m.
- THE LEVELS (Z) ARE IN TERMS OF THE MOTURIKI DATUM 1953, AND ARE WITHIN ±0.01m.

SIGNED
LICENSED CADASTRAL SURVEYOR

DATE:
NAME: NATHAN HOGG
ADDRESS: P.O.BOX 28-345, REMUERA, AUCKLAND
CONTACT: (09) 579 5505
EMAIL: Nathan.Hogg@candor3.co.nz

RELEVANT CONSENT NUMBERS:
SUB0340/18.02 & LUC0137/19

ASBUILT

REV DESCRIPTION		BY	APPVD	DATE	PROJECT		CLIENT		PURPOSE		
					LAKESIDE, TE KAUWHATA		LAKESIDE DEVELOPMENTS 2017 LIMITED		AS-BUILT		
					STORMWATER LAYOUT STAGE 6				DESIGN JS	APPROVED BY NH	SCALE 1:750 @ A3
					4 OF 4				DRAWN JS	DATE MAR 2021	
									CHECK RS		
									PROJECT NO.	DRAWING NO.	REV.
									1239	AB-4-103	-

PIT ID	NORTHING	EASTING	LID LEVEL	MH Ø(mm)
SWMH 14/18	740415.74	434279.26	10.37	1800
SWMH 14/24	740436.92	434208.68	13.27	2300
SWMH 14/25	740462.71	434124.17	17.39	1200
SWMH 14/26	740478.18	434100.21	18.85	1050
SWMH 14/27	740493.80	434085.95	19.99	1050
SWMH 14/28	740502.86	434079.53	20.13	1050
SWMH 14/29	740550.30	434045.77	23.01	1050
SWMH 18/1	740455.38	434290.85	11.10	1050
SWMH 18/2	740512.71	434302.27	12.11	1050
SWMH 18/3	740577.16	434314.61	13.28	1050
SWMH 19/2	740469.94	434217.51	14.35	1050
SWMH 19/3	740514.02	434226.87	16.01	1500
SWMH 19/4	740524.67	434228.72	16.32	1050
SWMH 19/5	740576.31	434237.80	17.55	1050
SWMH 20/1	740517.95	434209.89	16.47	1050
SWMH 20/2	740535.11	434153.25	19.74	1050
SWMH 20/3	740545.15	434142.98	20.39	1050
SWMH 20/4	740528.08	434119.37	20.25	1050
SWMH 21/1	740559.91	434155.27	20.48	1050
SWMH 36/3	740445.33	434101.29	17.31	1200
CP-SWALE-13/1	740401.82	434264.86	10.62	-
CP-14-15	740405.76	434265.86	10.81	-
CP-14-16	740412.42	434266.18	10.87	-
CP-14-17	740416.25	434265.92	10.75	-
CP-14-19	740437.26	434198.59	13.37	-
CP-14-20	740421.67	434196.83	13.60	-
CP-14-21	740462.05	434120.48	17.21	-
CP-14-22	740456.84	434122.21	17.09	-
CP-36-3	740448.53	434112.64	17.37	-
CP-36-4	740451.22	434107.00	17.13	-
CP-36-5	740454.77	434103.11	17.65	-
CP-14-23	740487.08	434074.29	19.77	-
CP-SWALE-7/1	740486.30	434070.64	19.56	-
CP-14-24	740509.21	434071.65	20.40	-
DCP14-13	740419.63	434282.68	10.37	-
DCP14-14	740421.30	434277.30	10.43	-
CP18-1	740513.27	434303.90	12.06	-
CP18-2	740518.41	434299.38	12.12	-
DCP14-18	740440.94	434213.53	13.26	-
DCP19-1	740442.73	434208.15	13.31	-
DCP19-2	740471.92	434209.16	14.48	-
CP19-3	740511.48	434218.46	15.79	-
CP19-4	740526.53	434227.60	16.27	-
CP19-5	740525.64	434233.00	16.28	-
DCP14-25	740503.06	434086.43	19.91	-
DCP14-26	740509.13	434085.17	19.95	-
CP20-4	740528.16	434102.63	20.35	-
CP20-2	740552.36	434144.89	20.35	-
CP20-3	740548.46	434149.03	20.30	-

CERTIFICATION

I CERTIFY THAT THESE ASBUILT PLANS ARE AN ACCURATE RECORD OF THE WORKS UNDERTAKEN AND THAT:

- THE COORDINATES (X,Y) ARE IN TERMS OF NZTM ON NZGD(2000), AND ARE WITHIN ±0.10m.
- THE LEVELS (Z) ARE IN TERMS OF THE MOTURIKI DATUM 1953, AND ARE WITHIN ±0.01m.


SIGNED
LICENSED CADASTRAL SURVEYOR

DATE:
NAME: NATHAN HOGG
ADDRESS: P.O.BOX 28-345, REMUERA, AUCKLAND
CONTACT: (09) 579 5505
EMAIL: Nathan.Hogg@candor3.co.nz

RELEVANT CONSENT NUMBERS:
SUB0340/18.02 & LUC0137/19

ASBUILT

REV DESCRIPTION				BY		APPVD		DATE		<div>Candor³</div> <div>ENGINEERING FOR LIFE</div>	PROJECT	LAKESIDE, TE KAUWHATA STORMWATER LAYOUT STAGE 6 COORDINATE TABLE	CLIENT	LAKESIDE DEVELOPMENTS 2017 LIMITED	PURPOSE				
															AS-BUILT				
DESIGN JS				APPROVED BY NH				SCALE											
DRAWN JS				DATE MAR 2021				N/A											
CHECK RS																			
PROJECT NO.												DRAWING NO.		REV.					
1239												AB-4-104		-					

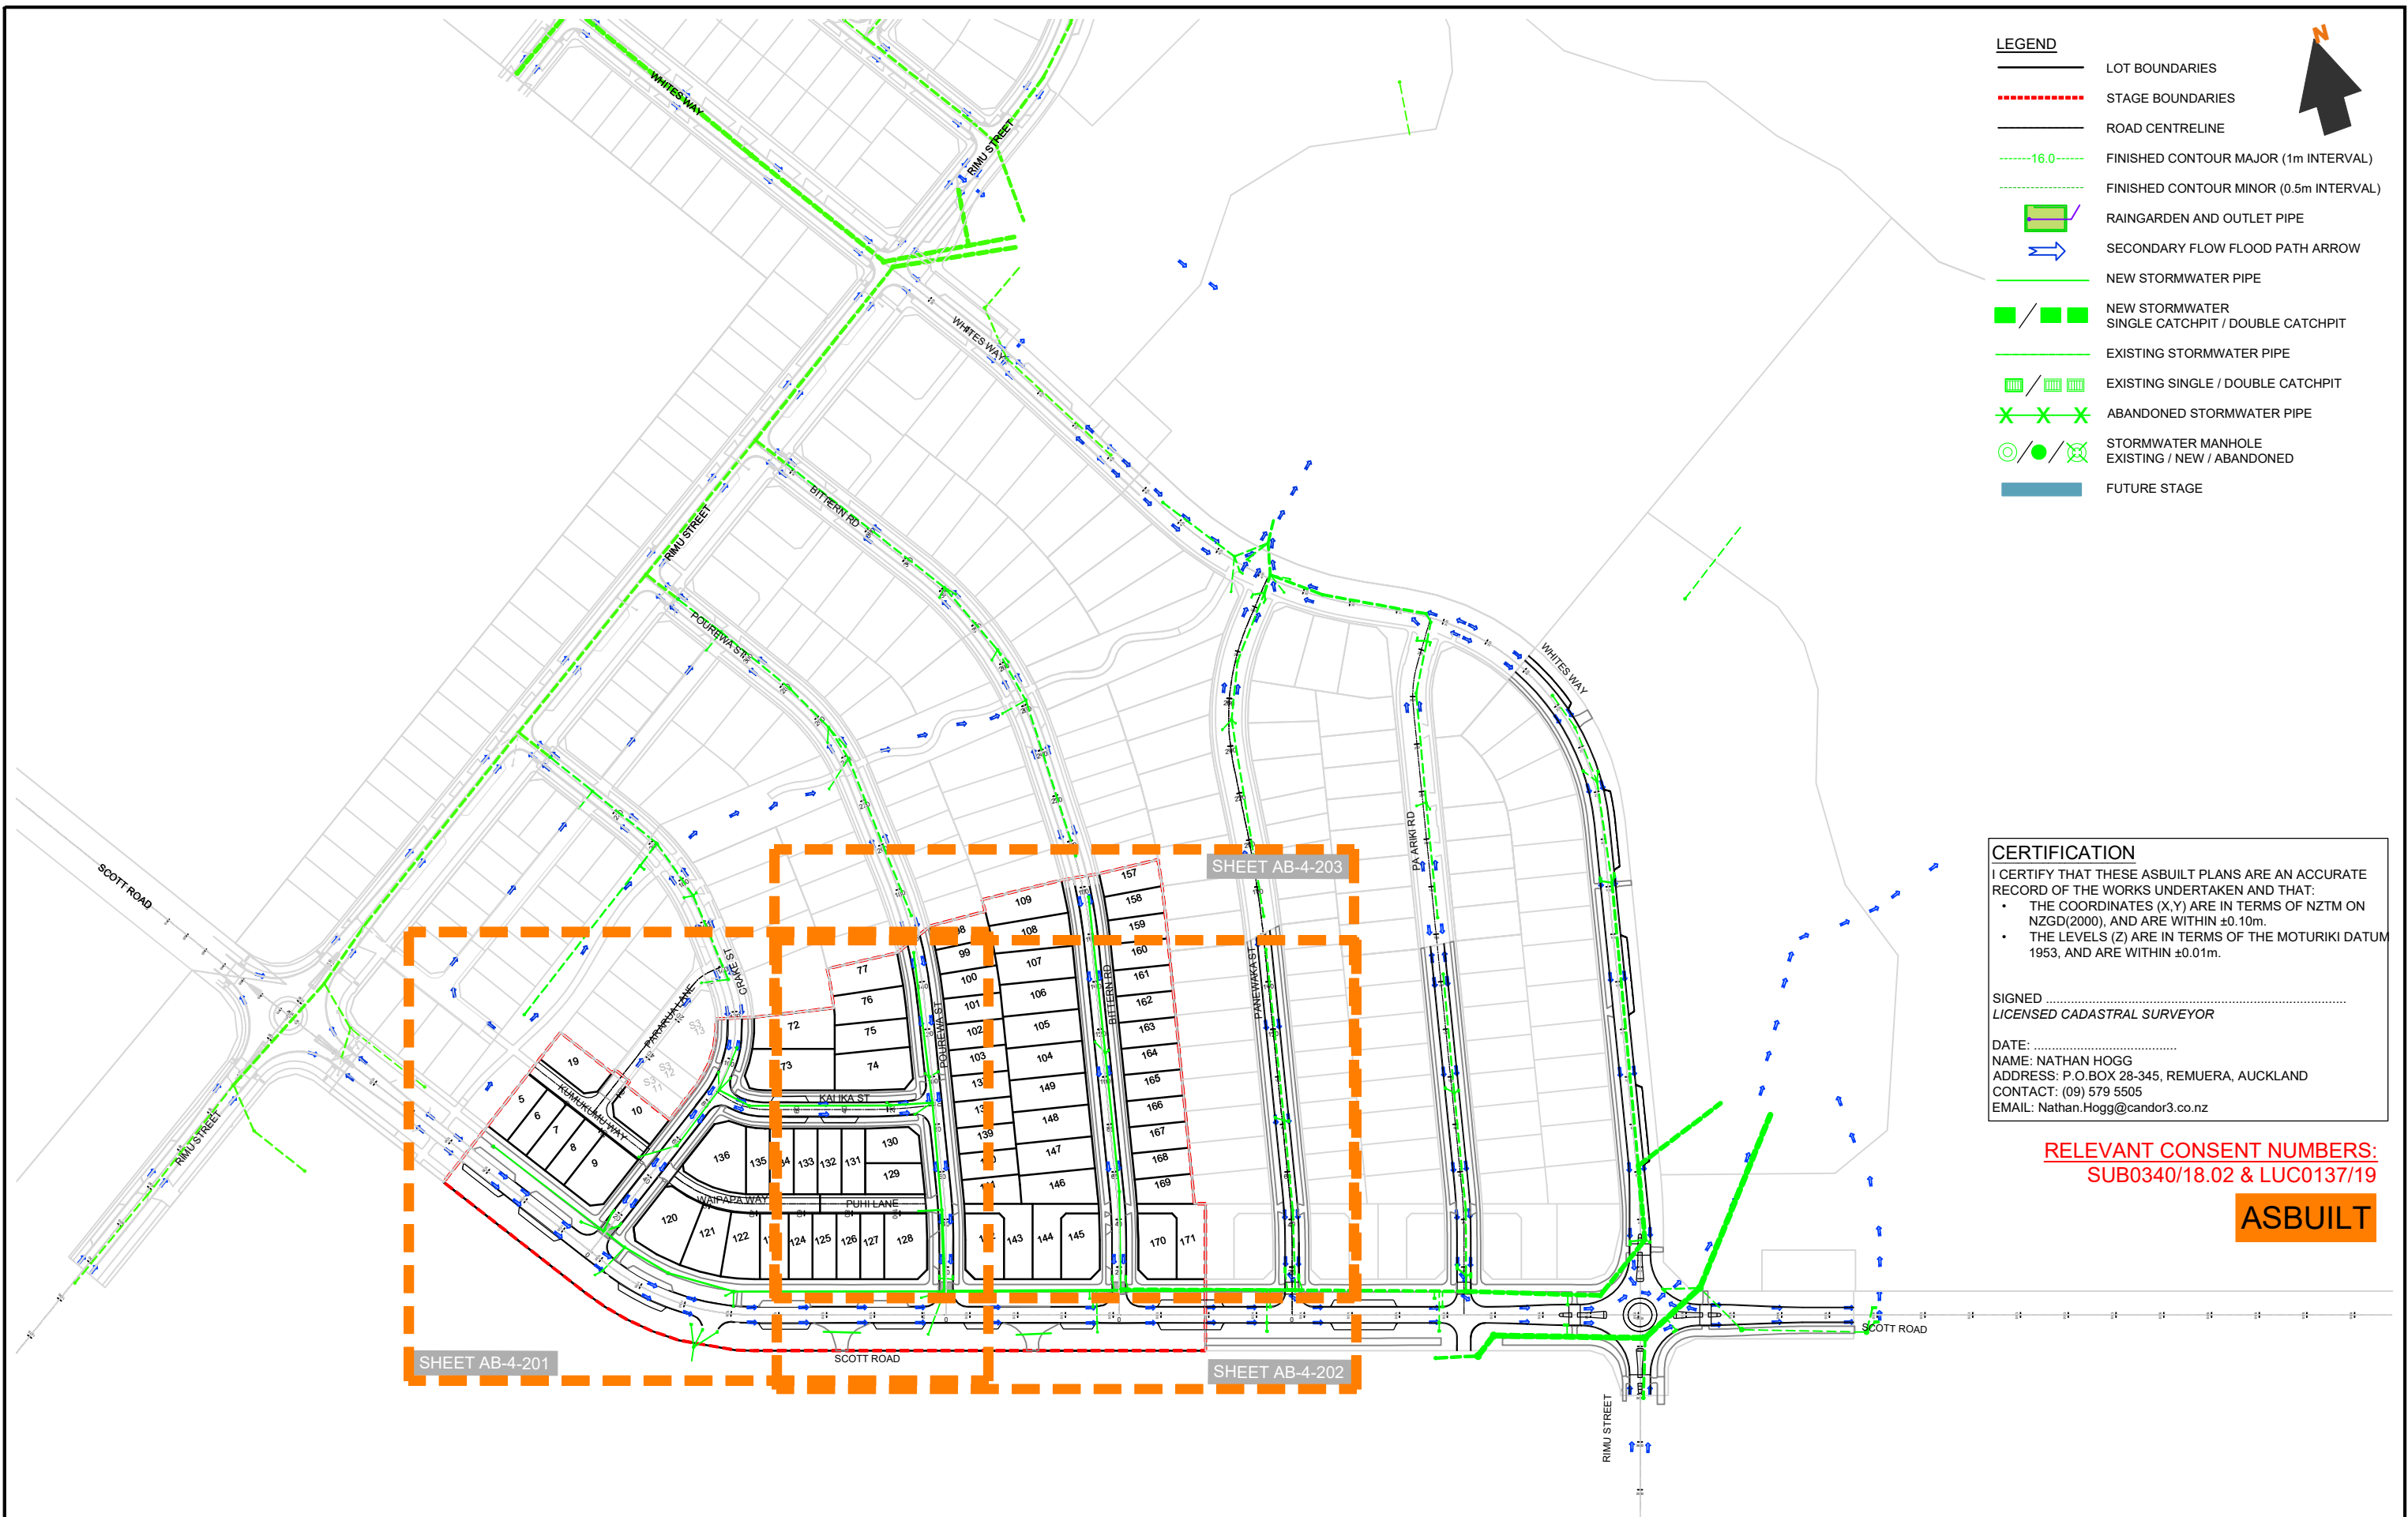

LEGEND

LOT BOUNDARIES

STAGE BOUNDARIES

ROAD CENTRELINE

FINISHED CONTOUR MAJOR (1m INTERVAL)

FINISHED CONTOUR MINOR (0.5m INTERVAL)

RAINGARDEN AND OUTLET PIPE

SECONDARY FLOW FLOOD PATH ARROW

NEW STORMWATER PIPE

NEW STORMWATER SINGLE CATCHPIT / DOUBLE CATCHPIT

EXISTING STORMWATER PIPE

EXISTING SINGLE / DOUBLE CATCHPIT

ABANDONED STORMWATER PIPE

STORMWATER MANHOLE EXISTING / NEW / ABANDONED

FUTURE STAGE

CERTIFICATION

I CERTIFY THAT THESE ASBUILT PLANS ARE AN ACCURATE RECORD OF THE WORKS UNDERTAKEN AND THAT:

THE COORDINATES (X,Y) ARE IN TERMS OF NZTM ON NZGD(2000), AND ARE WITHIN ±0.10m.

THE LEVELS (Z) ARE IN TERMS OF THE MOTURIKI DATUM 1953, AND ARE WITHIN ±0.01m.

SIGNED

LICENSED CADASTRAL SURVEYOR

DATE:

NAME: NATHAN HOGG

ADDRESS: P.O. BOX 28-345, REMUERA, AUCKLAND

CONTACT: (09) 579 5505


EMAIL: Nathan.Hogg@candor3.co.nz

RELEVANT CONSENT NUMBERS:

SUB0340/18.02 & LUC0137/19

ASBUILT

REV DESCRIPTION		BY	APPVD	DATE	<div>Candor³</div> <div>ENGINEERING FOR LIFE</div>	PROJECT	LAKESIDE, TE KAUWHATA STORMWATER OVERLAND FLOWPATH STAGE 6 1 OF 4	CLIENT	LAKESIDE DEVELOPMENTS 2017 LIMITED	PURPOSE		
										AS-BUILT		
DESIGN JS		APPROVED BY NH		SCALE								
DRAWN JS		DATE MAR 2021		1:2500 @ A3								
CHECK RS												
PROJECT NO.		DRAWING NO.		REV.								
1239		AB-4-200		-								

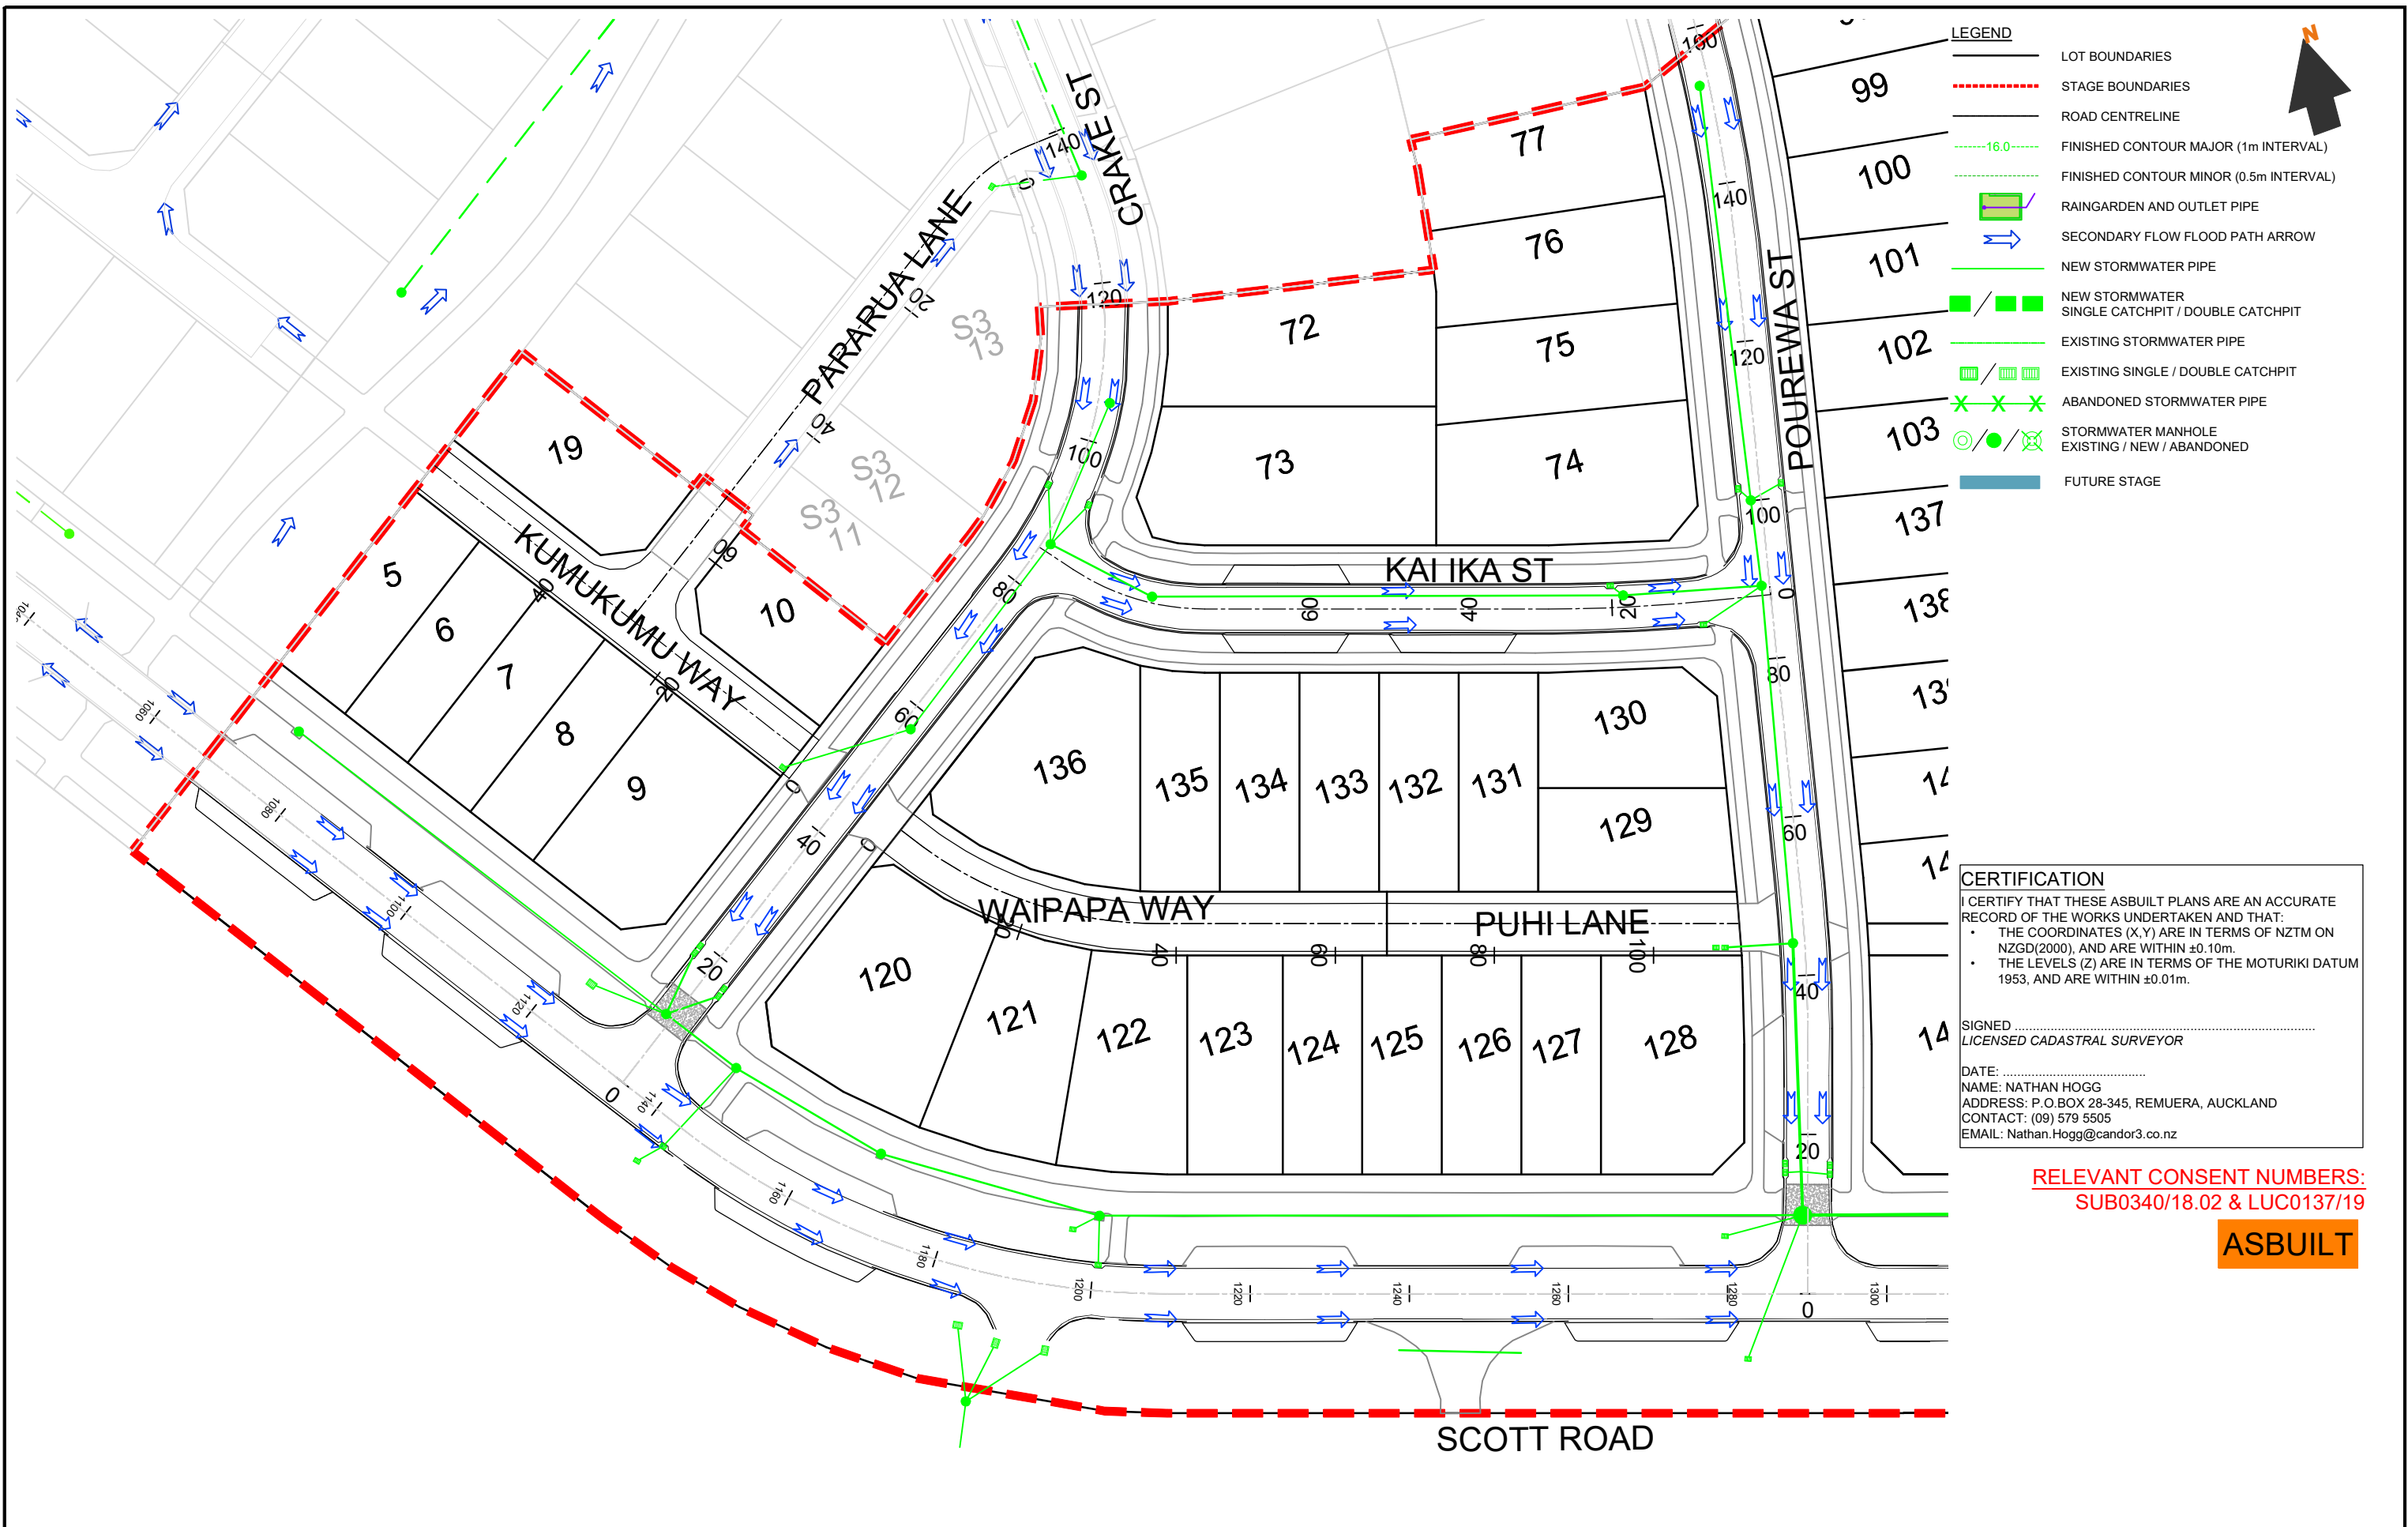

LEGEND

LOT BOUNDARIES

STAGE BOUNDARIES

ROAD CENTRELINE

FINISHED CONTOUR MAJOR (1m INTERVAL)

FINISHED CONTOUR MINOR (0.5m INTERVAL)

RAINGARDEN AND OUTLET PIPE

SECONDARY FLOW FLOOD PATH ARROW

NEW STORMWATER PIPE

NEW STORMWATER SINGLE CATCHPIT / DOUBLE CATCHPIT

EXISTING STORMWATER PIPE

EXISTING SINGLE / DOUBLE CATCHPIT

ABANDONED STORMWATER PIPE

STORMWATER MANHOLE EXISTING / NEW / ABANDONED

FUTURE STAGE

CERTIFICATION
I CERTIFY THAT THESE ASBUILT PLANS ARE AN ACCURATE RECORD OF THE WORKS UNDERTAKEN AND THAT:
• THE COORDINATES (X,Y) ARE IN TERMS OF NZTM ON NZGD(2000), AND ARE WITHIN ±0.10m.
• THE LEVELS (Z) ARE IN TERMS OF THE MOTURIKI DATUM 1953, AND ARE WITHIN ±0.01m.


SIGNED
LICENSED CADASTRAL SURVEYOR

DATE:
NAME: NATHAN HOGG
ADDRESS: P.O.BOX 28-345, REMUERA, AUCKLAND
CONTACT: (09) 579 5505
EMAIL: Nathan.Hogg@candor3.co.nz

RELEVANT CONSENT NUMBERS:
SUB0340/18.02 & LUC0137/19

ASBUILT

REV DESCRIPTION		BY	APPVD	DATE	PROJECT		CLIENT		PURPOSE		
<div><div>Candor³</div><div>ENGINEERING FOR LIFE</div></div>					LAKESIDE, TE KAUWHATA STORMWATER OVERLAND FLOWPATH STAGE 6 2 OF 4		LAKESIDE DEVELOPMENTS 2017 LIMITED		AS-BUILT		
DESIGN JS		APPROVED BY NH		SCALE		PROJECT NO.		DRAWING NO.		REV.	
DRAWN JS		DATE MAR 2021		1:750 @ A3		1239		AB-4-201		-	
CHECK RS											

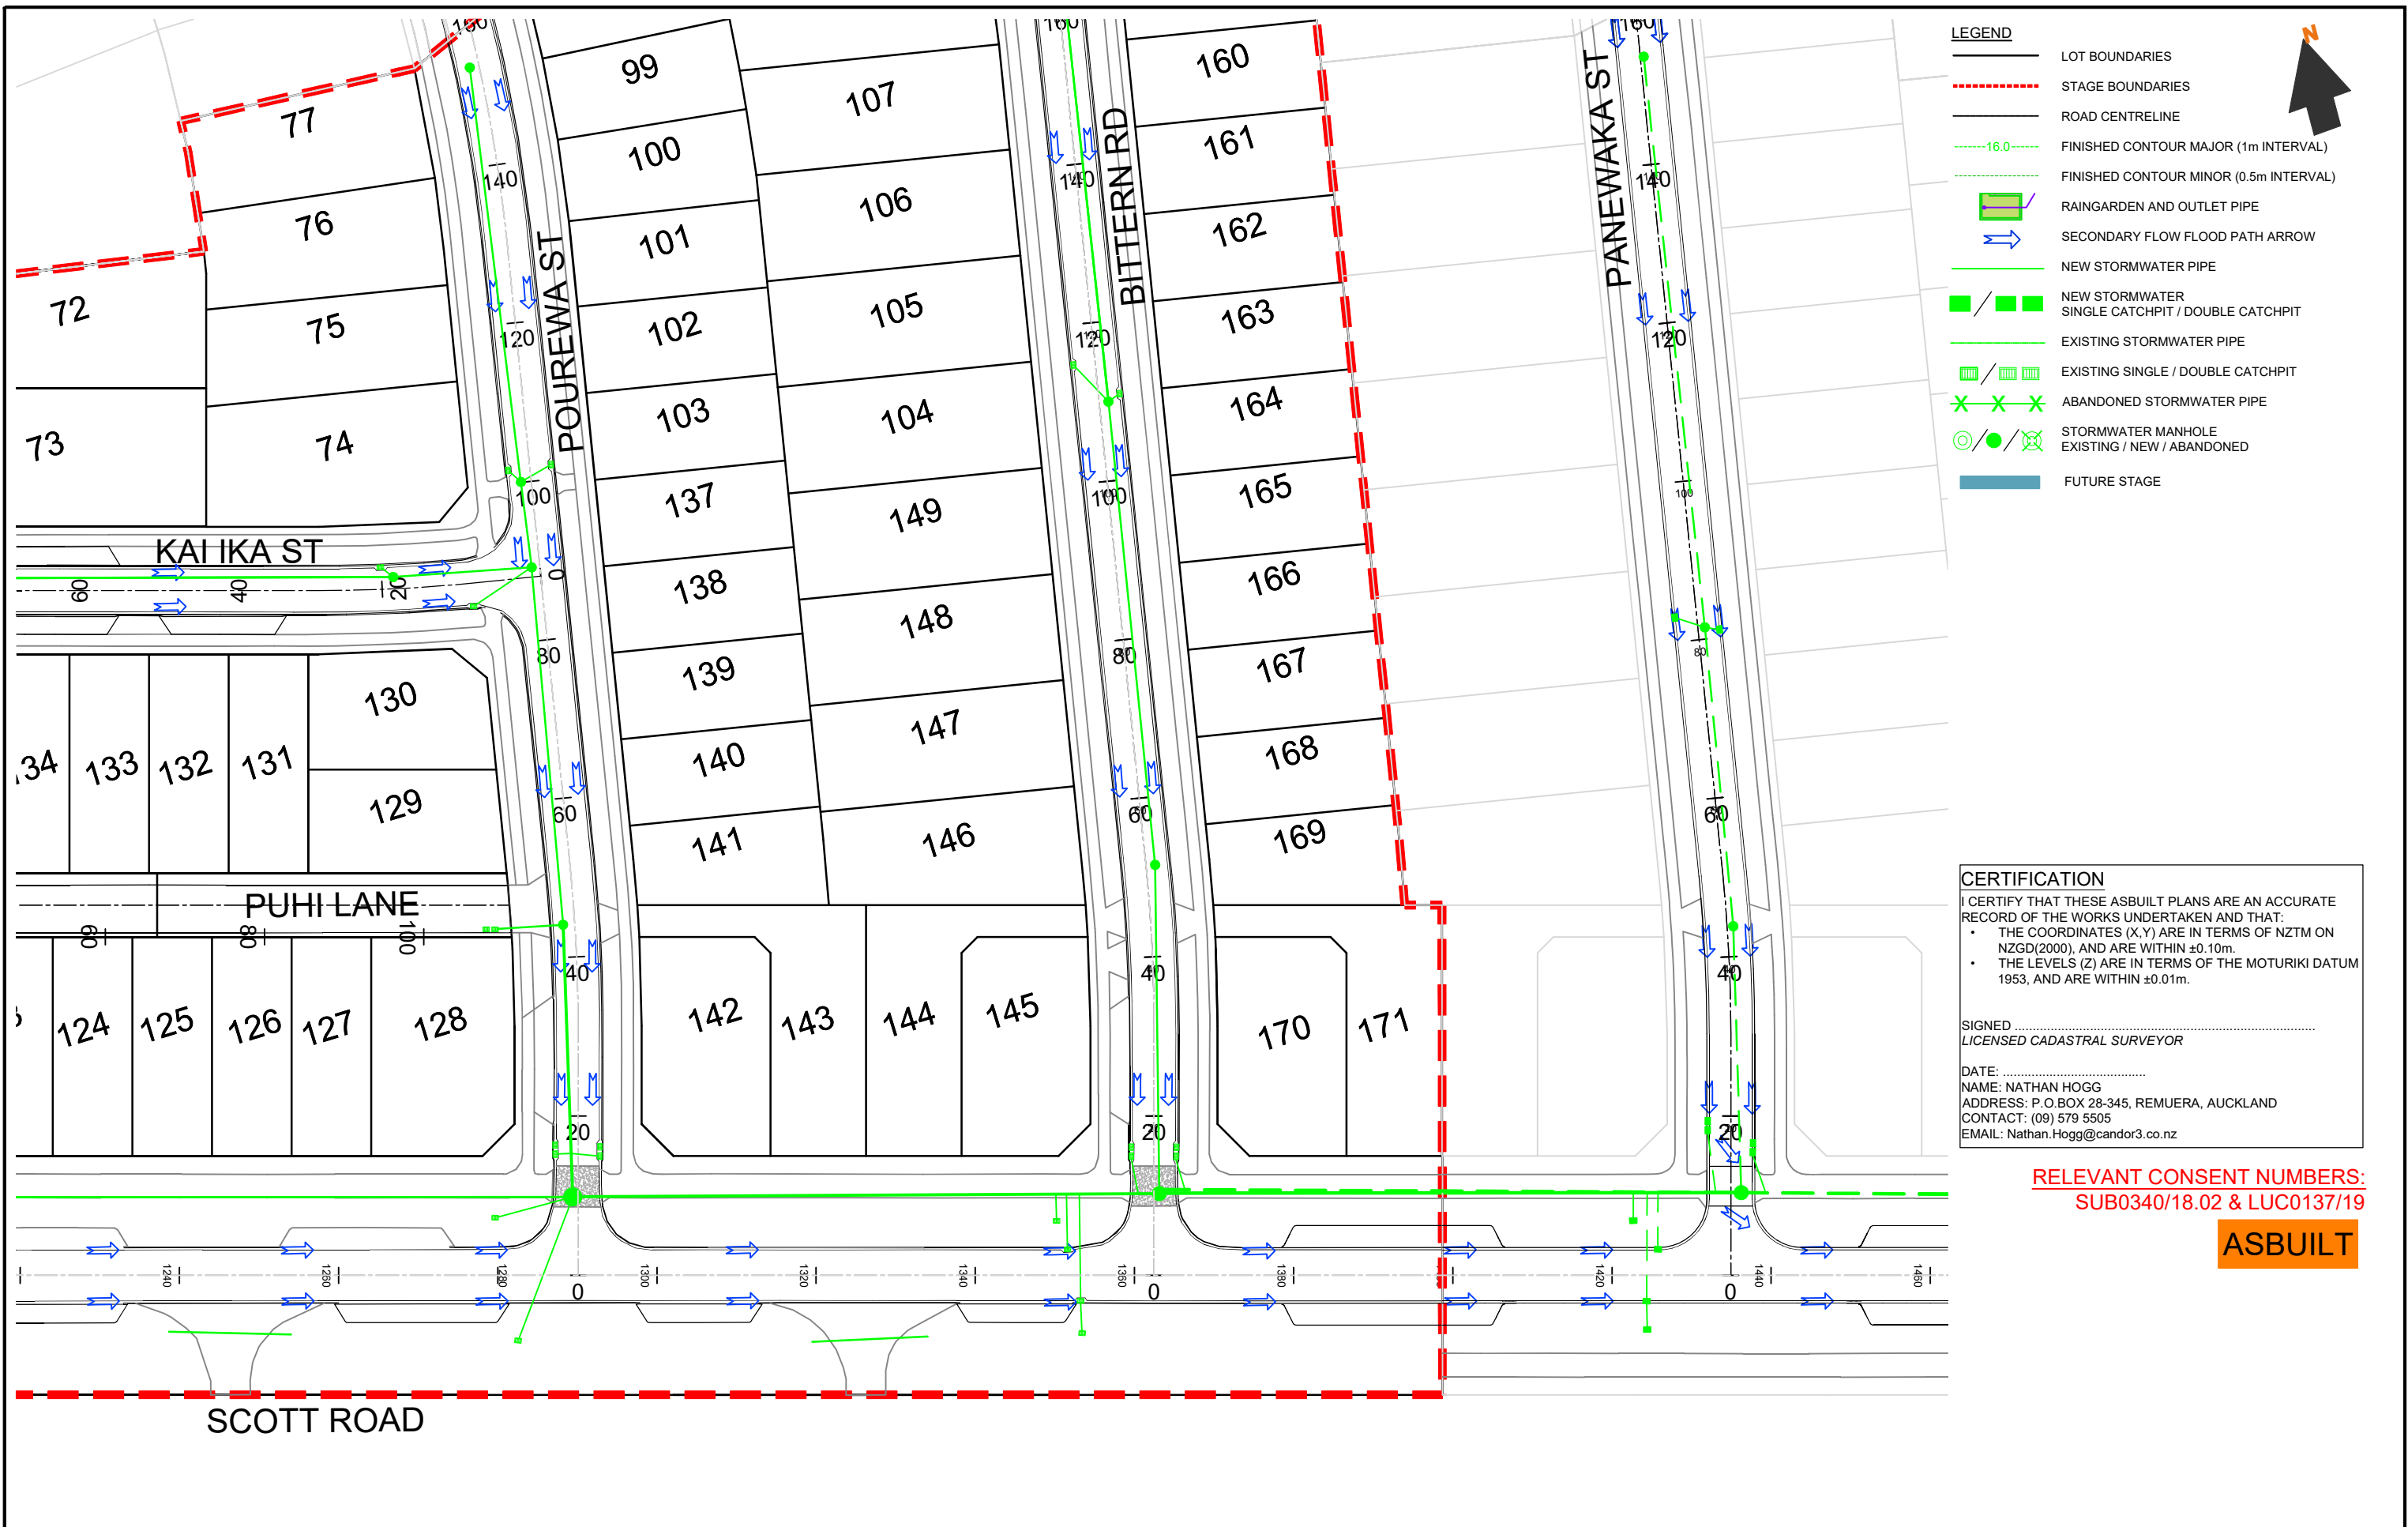

LEGEND

LOT BOUNDARIES

STAGE BOUNDARIES

ROAD CENTRELINE

FINISHED CONTOUR MAJOR (1m INTERVAL)

FINISHED CONTOUR MINOR (0.5m INTERVAL)

RAINGARDEN AND OUTLET PIPE

SECONDARY FLOW FLOOD PATH ARROW

NEW STORMWATER PIPE

NEW STORMWATER SINGLE CATCHPIT / DOUBLE CATCHPIT

EXISTING STORMWATER PIPE

EXISTING SINGLE / DOUBLE CATCHPIT

ABANDONED STORMWATER PIPE

STORMWATER MANHOLE EXISTING / NEW / ABANDONED

FUTURE STAGE

CERTIFICATION

I CERTIFY THAT THESE ASBUILT PLANS ARE AN ACCURATE RECORD OF THE WORKS UNDERTAKEN AND THAT:

- THE COORDINATES (X,Y) ARE IN TERMS OF NZTM ON NZGD(2000), AND ARE WITHIN ±0.10m.
- THE LEVELS (Z) ARE IN TERMS OF THE MOTURIKI DATUM 1953, AND ARE WITHIN ±0.01m.


SIGNED
LICENSED CADASTRAL SURVEYOR

DATE:
NAME: NATHAN HOGG
ADDRESS: P.O.BOX 28-345, REMUERA, AUCKLAND
CONTACT: (09) 579 5505
EMAIL: Nathan.Hogg@candor3.co.nz

RELEVANT CONSENT NUMBERS:
SUB0340/18.02 & LUC0137/19

ASBUILT

REV DESCRIPTION		BY	APPVD	DATE	PROJECT		CLIENT		PURPOSE		
					LAKESIDE, TE KAUWHATA		LAKESIDE DEVELOPMENTS 2017 LIMITED		AS-BUILT		
					STORMWATER OVERLAND FLOWPATH STAGE 6				DESIGN JS	APPROVED BY NH	SCALE 1:750 @ A3
					3 OF 4				DRAWN JS	DATE MAR 2021	
									CHECK RS		
									PROJECT NO.	DRAWING NO.	REV.
									1239	AB-4-202	-

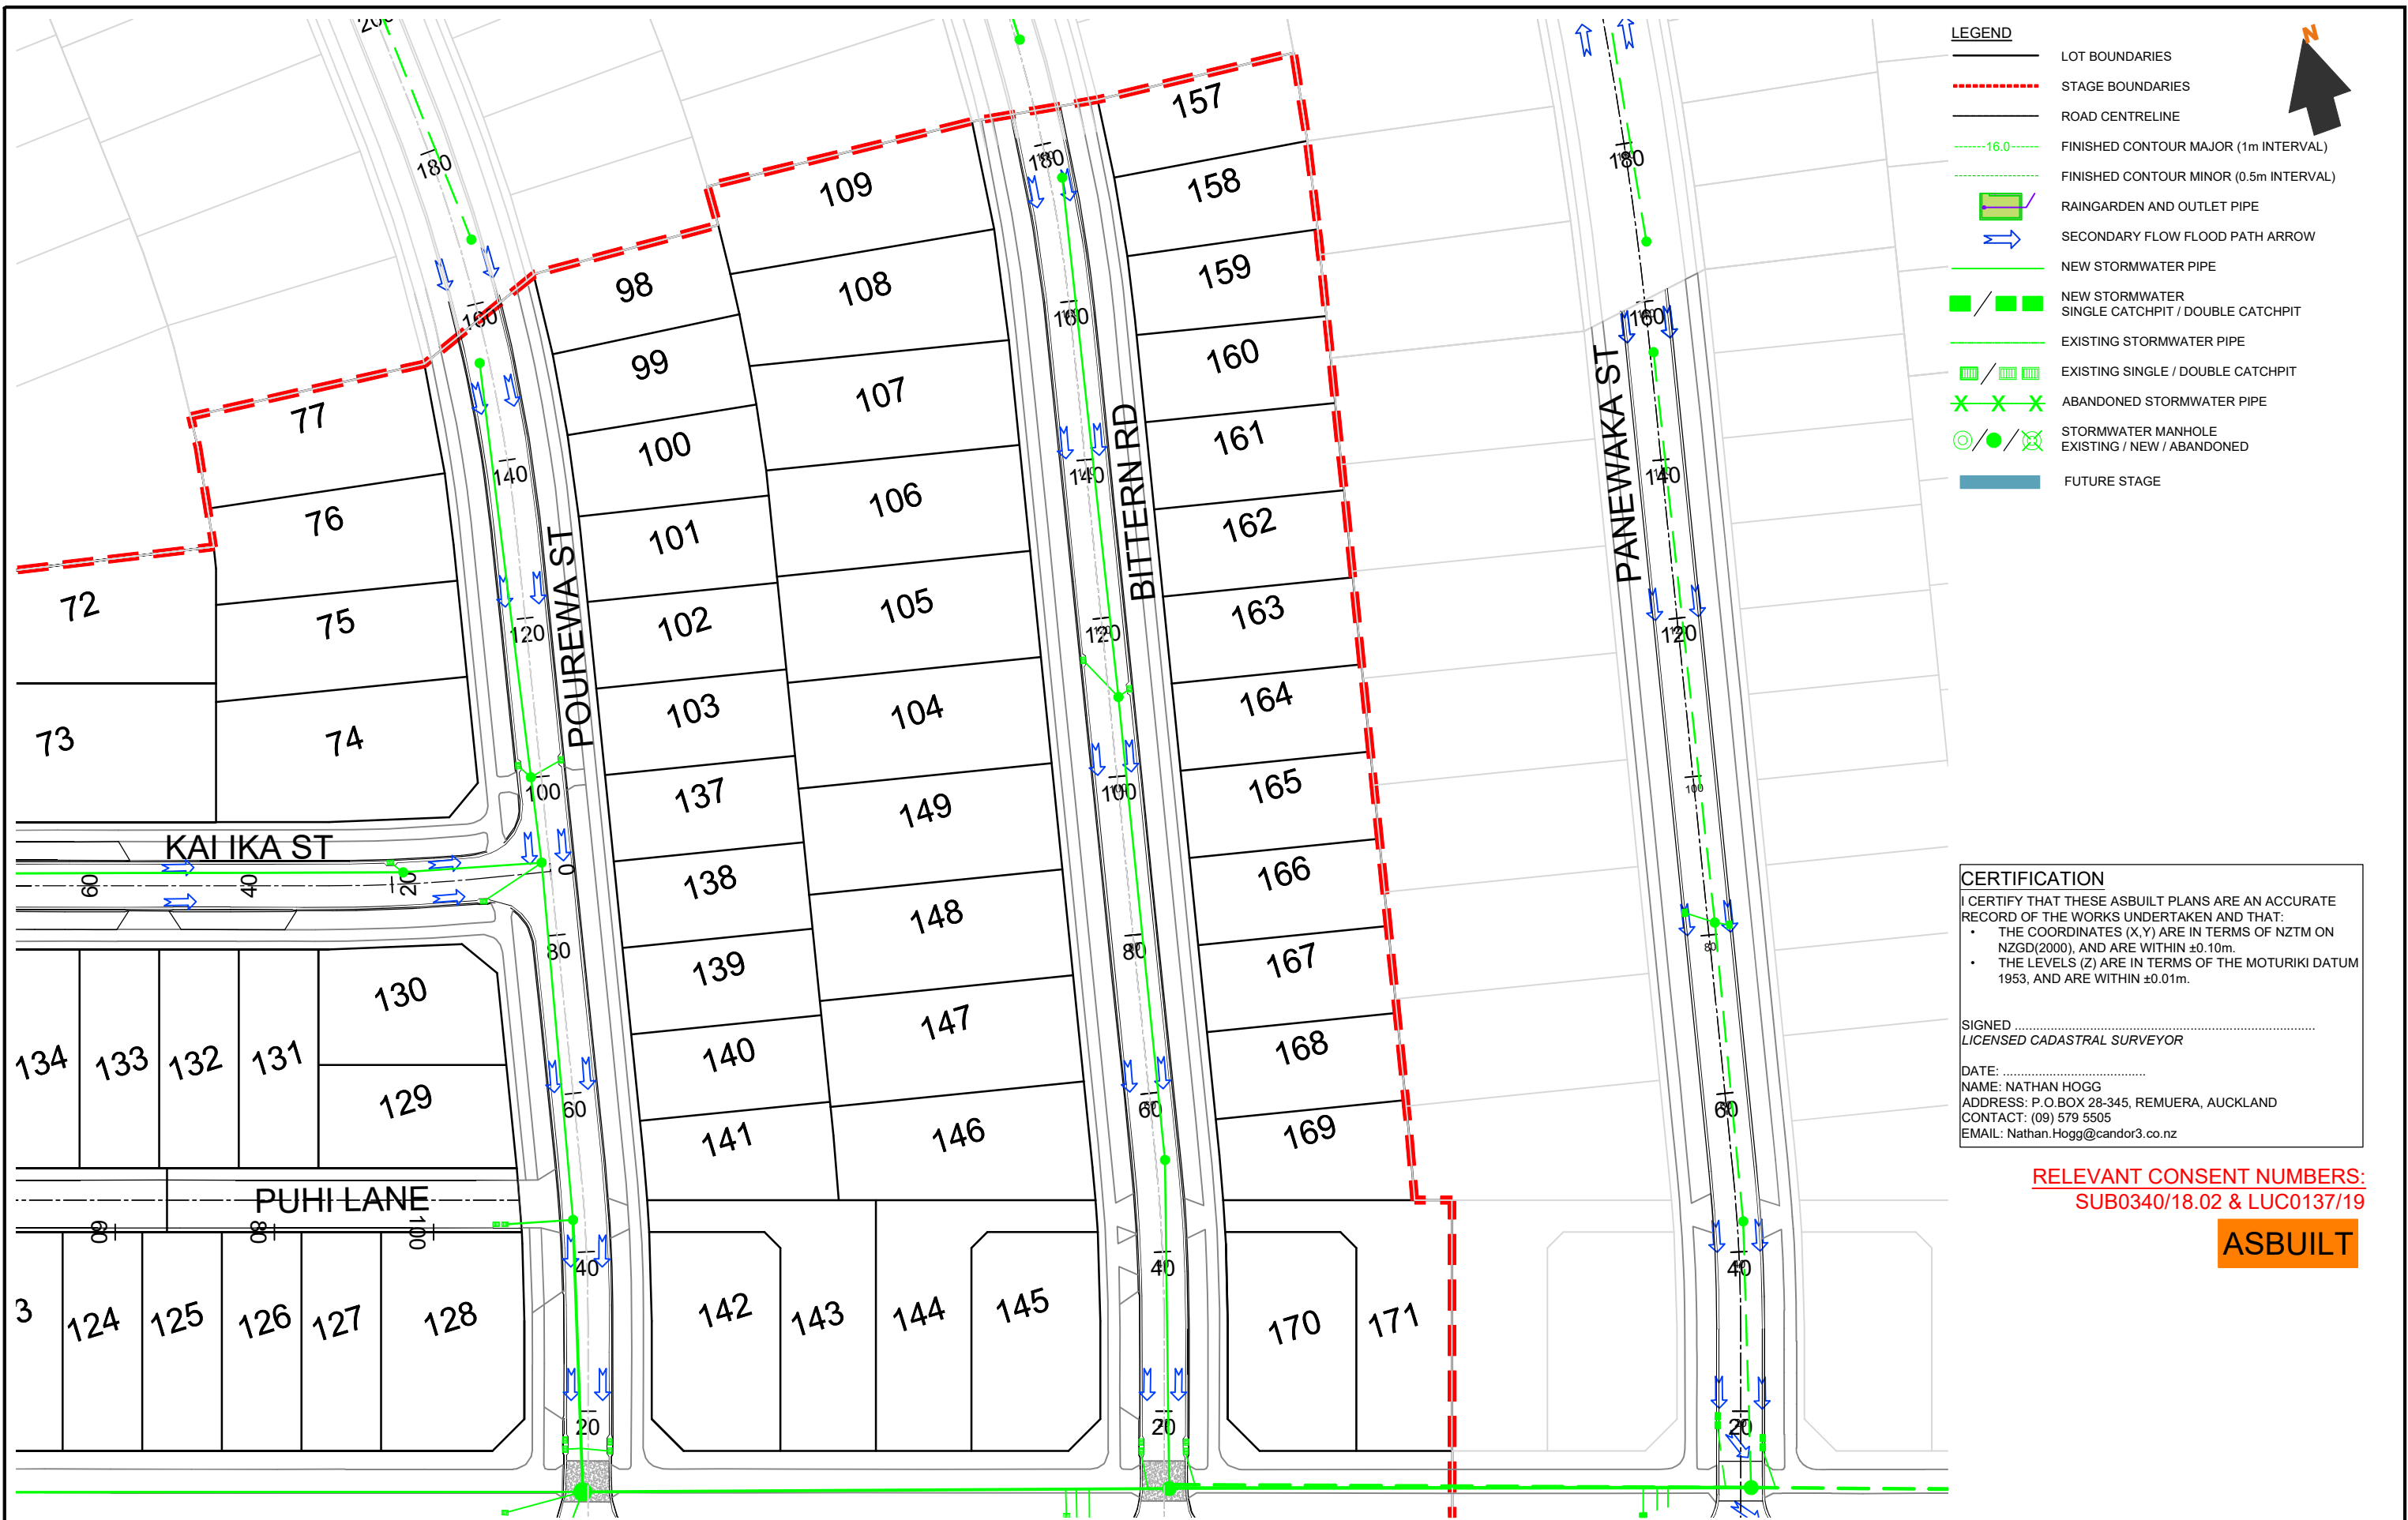

CERTIFICATION
I CERTIFY THAT THESE ASBUILT PLANS ARE AN ACCURATE RECORD OF THE WORKS UNDERTAKEN AND THAT:
• THE COORDINATES (X,Y) ARE IN TERMS OF NZTM ON NZGD(2000), AND ARE WITHIN ±0.10m.
• THE LEVELS (Z) ARE IN TERMS OF THE MOTURIKI DATUM 1953, AND ARE WITHIN ±0.01m.

SIGNED
LICENSED CADASTRAL SURVEYOR

DATE:
NAME: NATHAN HOGG
ADDRESS: P.O.BOX 28-345, REMUERA, AUCKLAND
CONTACT: (09) 579 5505
EMAIL: Nathan.Hogg@candor3.co.nz

RELEVANT CONSENT NUMBERS:
SUB0340/18.02 & LUC0137/19

ASBUILT

REV DESCRIPTION		BY	APPVD	DATE	PROJECT		CLIENT		PURPOSE		
					LAKESIDE, TE KAUPHATA		LAKESIDE DEVELOPMENTS 2017 LIMITED		AS-BUILT		
					STORMWATER OVERLAND FLOWPATH STAGE 6				DESIGN JS	APPROVED BY NH	SCALE 1:750 @ A3
					4 OF 4				DRAWN JS	DATE MAR 2021	
									CHECK RS		
									PROJECT NO.	DRAWING NO.	REV.
									1239	AB-4-203	-