

- LEGEND**
- LOT BOUNDARIES
 - STAGE BOUNDARIES
 - ROAD CENTRELINE
 - NEW WASTEWATER PIPE
 - NEW WASTEWATER LOT CONNECTION
 - EXISTING WASTEWATER PIPE
 - ABANDONED WASTEWATER PIPE
 - WASTEWATER MANHOLE
EXISTING / NEW / ABANDONED
 - FUTURE STAGE

- NOTES**
- ALL WORKS AND MATERIALS COMPLY WITH THE WAIKATO LOCAL AUTHORITY SHARED SERVICES REGIONAL INFRASTRUCTURE TECHNICAL SPECIFICATIONS (RITS) (MAY 2018).
 - MANHOLES ARE 1050mm Ø CONCRETE MANHOLES UNLESS OTHERWISE NOTED.
 - PIPE CROSSINGS UNDER ROADS AND ACCESSWAYS HAVE BEEN HARDFILL BACKFILLED.
 - LEVELS ARE IN TERMS OF THE MOTURIKI DATUM 1953.
 - ALL CO-ORDINATES ARE IN TERMS OF NZTM.
 - ALL WASTEWATER (SS) PIPES ARE 150mm Ø u-PVC SN16, UNLESS STATED OTHERWISE.

CERTIFICATION

I CERTIFY THAT THESE ASBUILT PLANS ARE AN ACCURATE RECORD OF THE WORKS UNDERTAKEN AND THAT:

- THE COORDINATES (X,Y) ARE IN TERMS OF NZTM ON NZGD(2000), AND ARE WITHIN ±0.10m.
- THE LEVELS (Z) ARE IN TERMS OF THE MOTURIKI DATUM 1953, AND ARE WITHIN ±0.01m.

SIGNED
LICENSED CADASTRAL SURVEYOR

DATE:
NAME: NATHAN HOGG
ADDRESS: P.O.BOX 28-345, REMUERA, AUCKLAND
CONTACT: (09) 579 5505
EMAIL: Nathan.Hogg@candor3.co.nz

REV DESCRIPTION		BY	APPVD	DATE	PROJECT		CLIENT		PURPOSE		
					LAKESIDE, TE KAUWHATA WASTEWATER LAYOUT STAGE 3 1 OF 2		LAKESIDE DEVELOPMENTS 2017 LIMITED		AS-BUILT		
									DESIGN JS	APPROVED BY NH	SCALE 1:2500 @ A3
									DRAWN JS	DATE MAY 2020	
									CHECK RS		
									PROJECT NO.	DRAWING NO.	REV.
									1239	AB-5-100	-

- LEGEND**
- LOT BOUNDARIES
 - STAGE BOUNDARIES
 - ROAD CENTRELINE
 - NEW WASTEWATER PIPE
 - NEW WASTEWATER LOT CONNECTION
 - EXISTING WASTEWATER PIPE
 - ABANDONED WASTEWATER PIPE
 - WASTEWATER MANHOLE
EXISTING / NEW / ABANDONED
 - FUTURE STAGE

- NOTES**
- ALL WORKS AND MATERIALS COMPLY WITH THE WAIKATO LOCAL AUTHORITY SHARED SERVICES REGIONAL INFRASTRUCTURE TECHNICAL SPECIFICATIONS (RITS) (MAY 2018).
 - MANHOLES ARE 1050mm Ø CONCRETE MANHOLES UNLESS OTHERWISE NOTED.
 - PIPE CROSSINGS UNDER ROADS AND ACCESSWAYS HAVE BEEN HARDFILL BACKFILLED.
 - LEVELS ARE IN TERMS OF THE MOTURIKI DATUM 1953.
 - ALL CO-ORDINATES ARE IN TERMS OF NZTM.
 - ALL WASTEWATER (SS) PIPES ARE 150mm Ø u-PVC SN16, UNLESS STATED OTHERWISE.

CERTIFICATION

I CERTIFY THAT THESE ASBUILT PLANS ARE AN ACCURATE RECORD OF THE WORKS UNDERTAKEN AND THAT:


- THE COORDINATES (X,Y) ARE IN TERMS OF NZTM ON NZGD(2000), AND ARE WITHIN ±0.10m.
- THE LEVELS (Z) ARE IN TERMS OF THE MOTURIKI DATUM 1953, AND ARE WITHIN ±0.01m.

SIGNED
LICENSED CADASTRAL SURVEYOR

DATE:
NAME: NATHAN HOGG
ADDRESS: P.O.BOX 28-345, REMUERA, AUCKLAND
CONTACT: (09) 579 5505
EMAIL: Nathan.Hogg@candor3.co.nz

RELEVANT CONSENT NUMBERS:
SUB0340/18.01 & LUC0137/19

ASBUILT

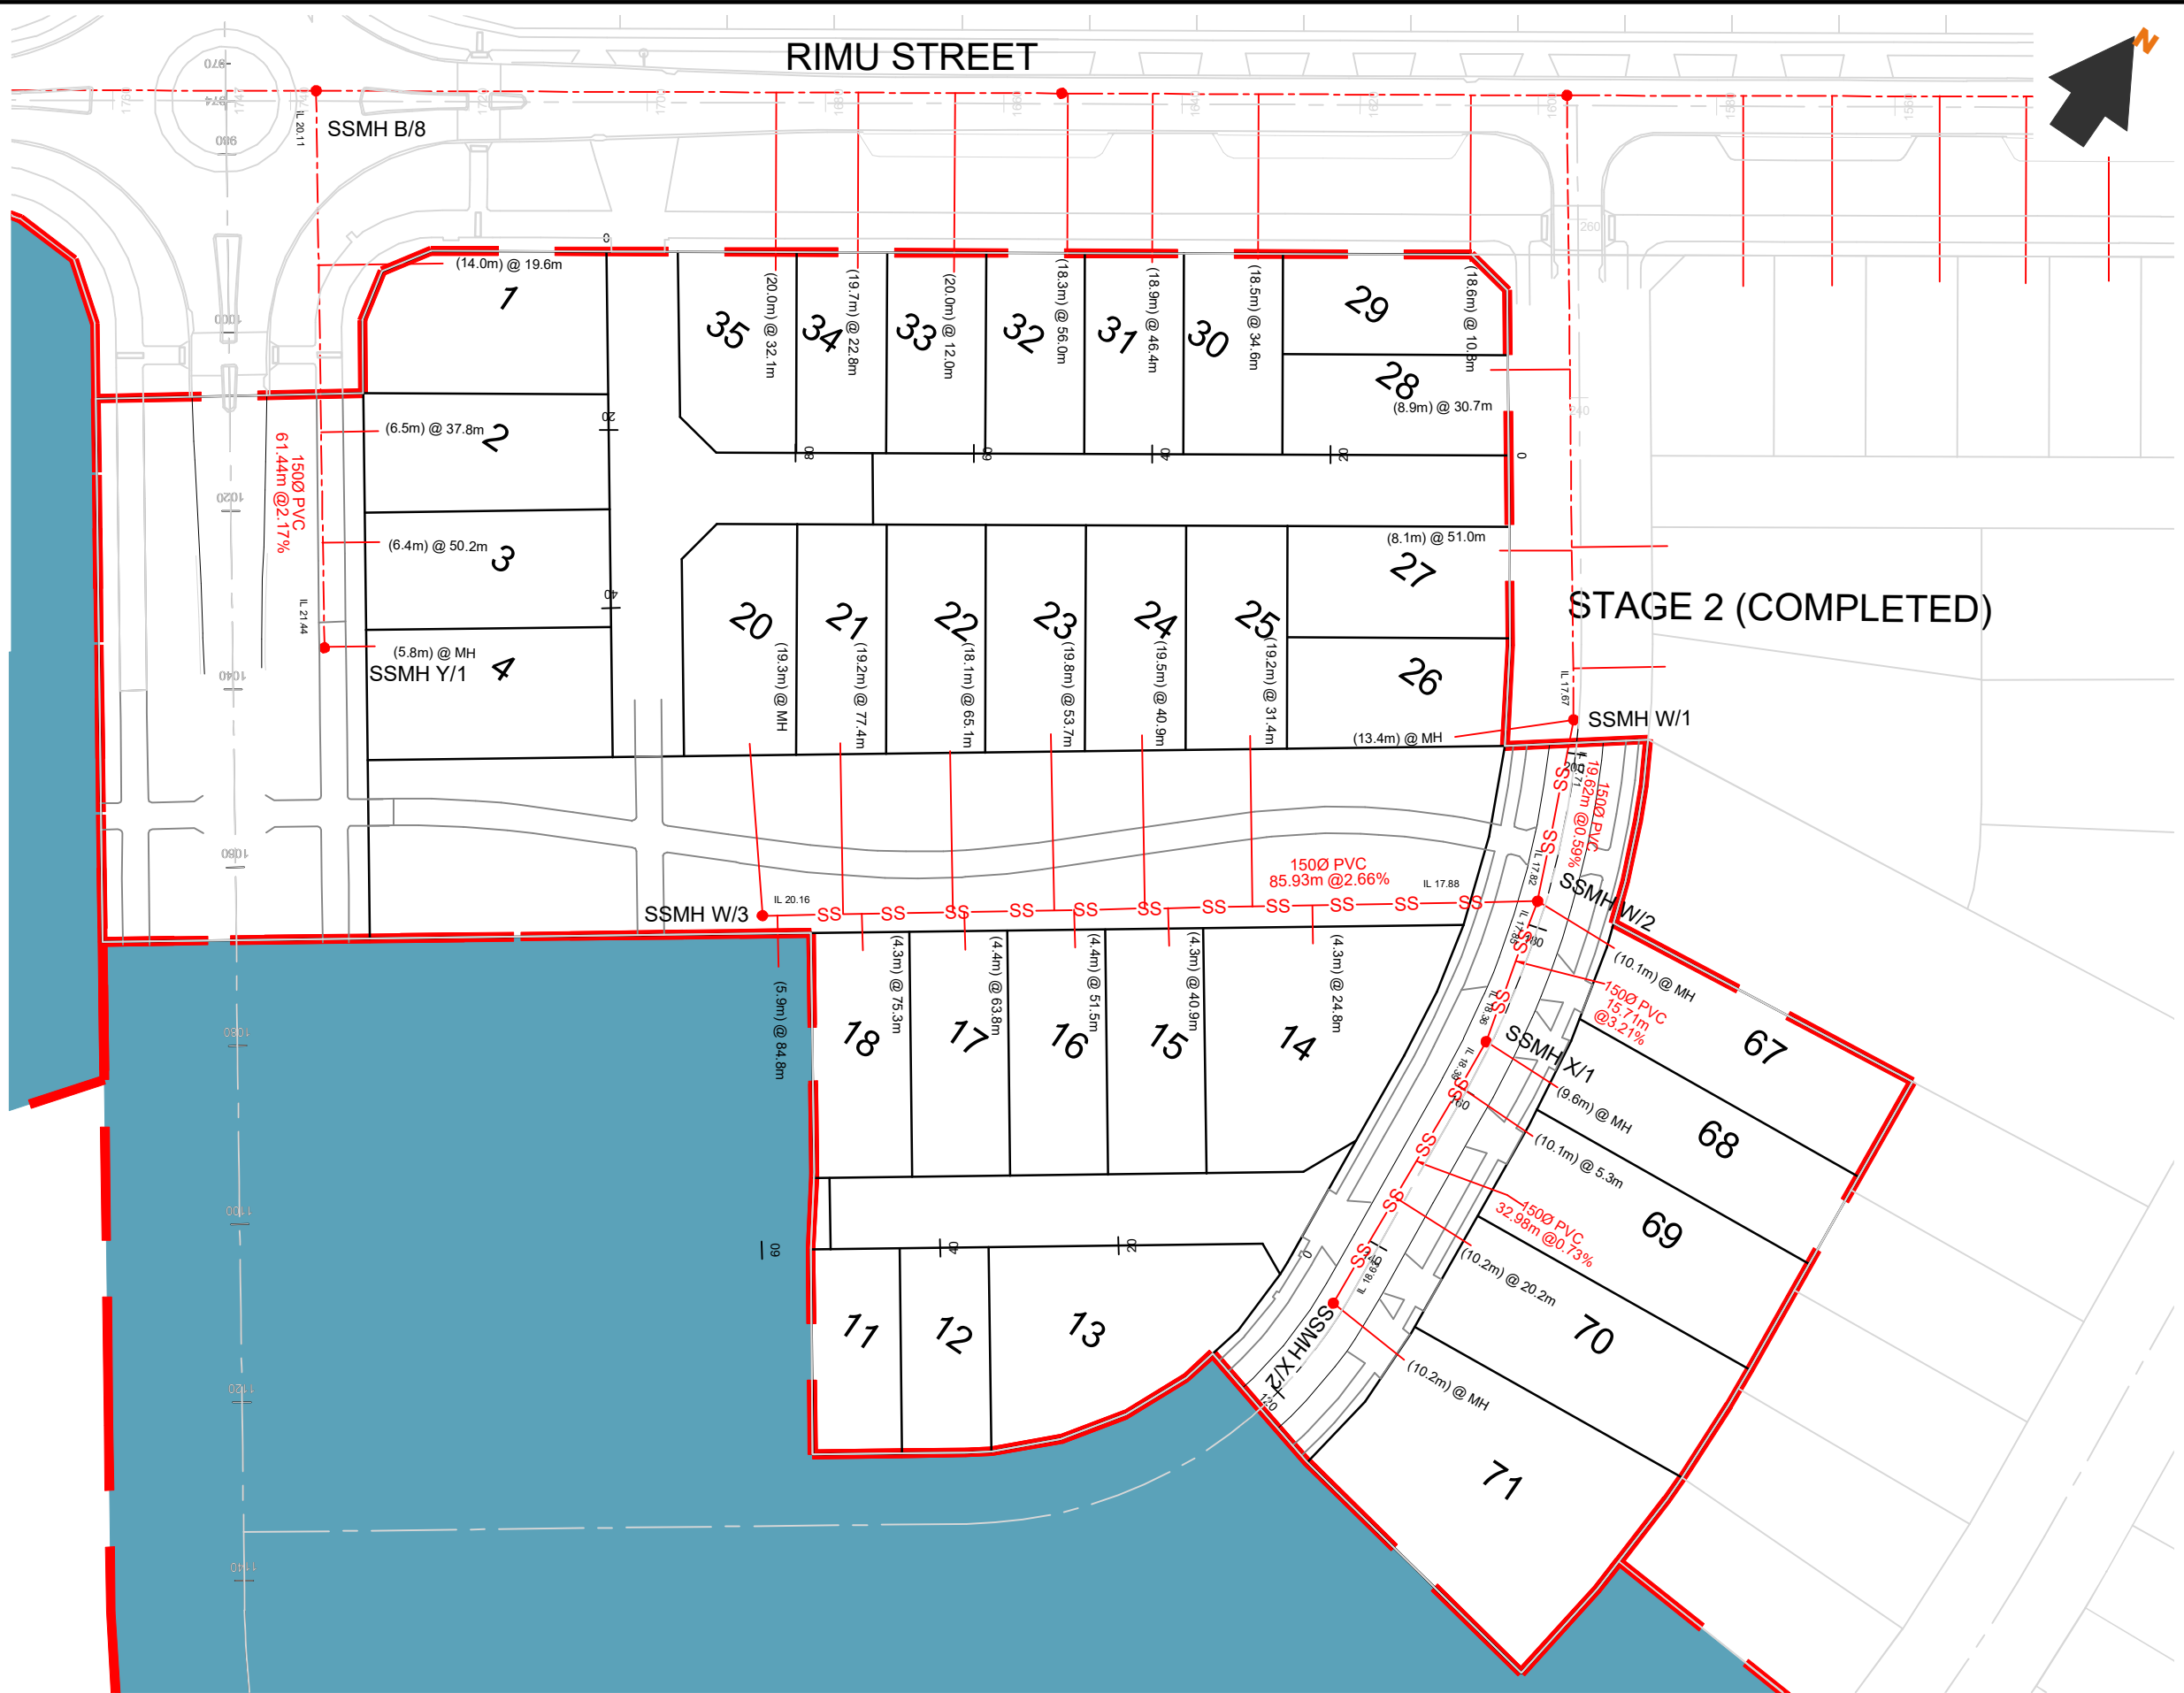

REV DESCRIPTION			BY	APPVD	DATE	PROJECT			CLIENT			PURPOSE		
						LAKESIDE, TE KAUPHATA WASTEWATER LAYOUT STAGE 3 2 OF 2			LAKESIDE DEVELOPMENTS 2017 LIMITED			AS-BUILT		
												DESIGN JS	APPROVED BY NH	SCALE 1:750 @ A3
												DRAWN JS	DATE MAY 2020	
												CHECK RS		
												PROJECT NO.	DRAWING NO.	REV.
												1239	AB-5-101	-

[illegible]

CERTIFICATION

I CERTIFY THAT THESE ASBUILT PLANS ARE AN ACCURATE RECORD OF THE WORKS UNDERTAKEN AND THAT:

- THE COORDINATES (X,Y) ARE IN TERMS OF NZTM ON NZGD(2000), AND ARE WITHIN $\pm 0.10\text{m}$.
- THE LEVELS (Z) ARE IN TERMS OF THE MOTURIKI DATUM 1953, AND ARE WITHIN $\pm 0.01\text{m}$.

SIGNED

LICENSED CADASTRAL SURVEYOR

DATE:

NAME: NATHAN HOGG

ADDRESS: P.O.BOX 28-345, REMUERA, AUCKLAND

CONTACT: (09) 579 5505

EMAIL: Nathan.Hogg@candor3.co.nz

RELEVANT CONSENT NUMBERS:
SUB0340/18.01 & LUC0137/19

ASBUILT

REV		DESCRIPTION	BY	APPVD	DATE	<div>Candor³</div> <div>ENGINEERING FOR LIFE</div>	PROJECT	LAKESIDE, TE KAUWHATA WASTEWATER LAYOUT STAGE 3 COORDINATE TABLE	CLIENT	LAKESIDE DEVELOPMENTS 2017 LIMITED	PURPOSE		
					AS-BUILT								
DESIGN	JS	APPROVED		SCALE									
DRAWN	JS	BY	NH		N/A								
CHECK	RS	DATE	MAY 2020										
					PROJECT NO.	DRAWING NO.	REV.						
					1239	AB-5-102	-						