

LEGEND

LOT BOUNDARIES

STAGE BOUNDARIES

EXISTING SURFACE CONTOUR MAJOR (1m INTERVAL)

EXISTING SURFACE CONTOUR MINOR (0.5m INTERVAL)

FUTURE STAGE

- NOTE:
1. LEVELS ARE IN TERMS OF MOTURIKI VERTICAL DATUM 1953.

2. ALL CO-ORDINATES ARE IN TERMS OF NZTM.

3. EXISTING SURFACE TOPO IS TAKEN FOR THE PURPOSE OF GEOTECHNICAL CUT FILL AS-BUILT PLANS AND SHOULD NOT BE RELIED ON FOR DETAILED DESIGN.

4. EXISTING CONTOURS SHOWN ARE PRE-STAGES 1 TO 7 EARTHWORKS STARTING.

CERTIFICATION

I CERTIFY THAT THESE ASBUILT PLANS ARE AN ACCURATE RECORD OF THE WORKS UNDERTAKEN AND THAT:

- THE COORDINATES (X,Y) ARE IN TERMS OF NZTM ON NZGD(2000), AND ARE WITHIN ±0.10m.
- THE LEVELS (Z) ARE IN TERMS OF THE MOTURIKI DATUM 1953 LINZ DATUM, AND ARE WITHIN ±0.01m.

SIGNED
LICENSED CADASTRAL SURVEYOR

DATE:
NAME: NATHAN HOGG
ADDRESS: P.O.BOX 28-345, REMUERA, AUCKLAND
CONTACT: (09) 579 5505
EMAIL: Nathan.Hogg@candor3.co.nz

RELEVANT CONSENT NUMBERS:
SUB0340/18.01 & LUC0137/19

ASBUILT


REV DESCRIPTION		BY	APPVD	DATE	PROJECT		CLIENT		PURPOSE		
<div>Candor³ ENGINEERING FOR LIFE</div>					LAKESIDE, TE KAUWHATA EARTHWORKS EXISTING SURFACE STAGE 2 SHEET 1 OF 3		LAKESIDE DEVELOPMENTS 2017 LIMITED		AS-BUILT		
DESIGN JS		APPROVED BY NH		SCALE		PROJECT NO.		DRAWING NO.		REV.	
DRAWN RS		DATE MAY 2020		1:2500 @ A3		1239		AB-2-100		-	
CHECK RS											

LEGEND

- LOT BOUNDARIES
- STAGE BOUNDARIES
- EXISTING SURFACE CONTOUR MAJOR (1m INTERVAL)
- EXISTING SURFACE CONTOUR MINOR (0.5m INTERVAL)
- FUTURE STAGE

NOTE:

- LEVELS ARE IN TERMS OF MOTURIKI VERTICAL DATUM 1953.
- ALL CO-ORDINATES ARE IN TERMS OF NZTM.
- EXISTING SURFACE TOPO IS TAKEN FOR THE PURPOSE OF GEOTECHNICAL CUT FILL AS-BUILT PLANS AND SHOULD NOT BE RELIED ON FOR DETAILED DESIGN.
- EXISTING CONTOURS SHOWN ARE PRE-STAGES 1 TO 7 EARTHWORKS STARTING.

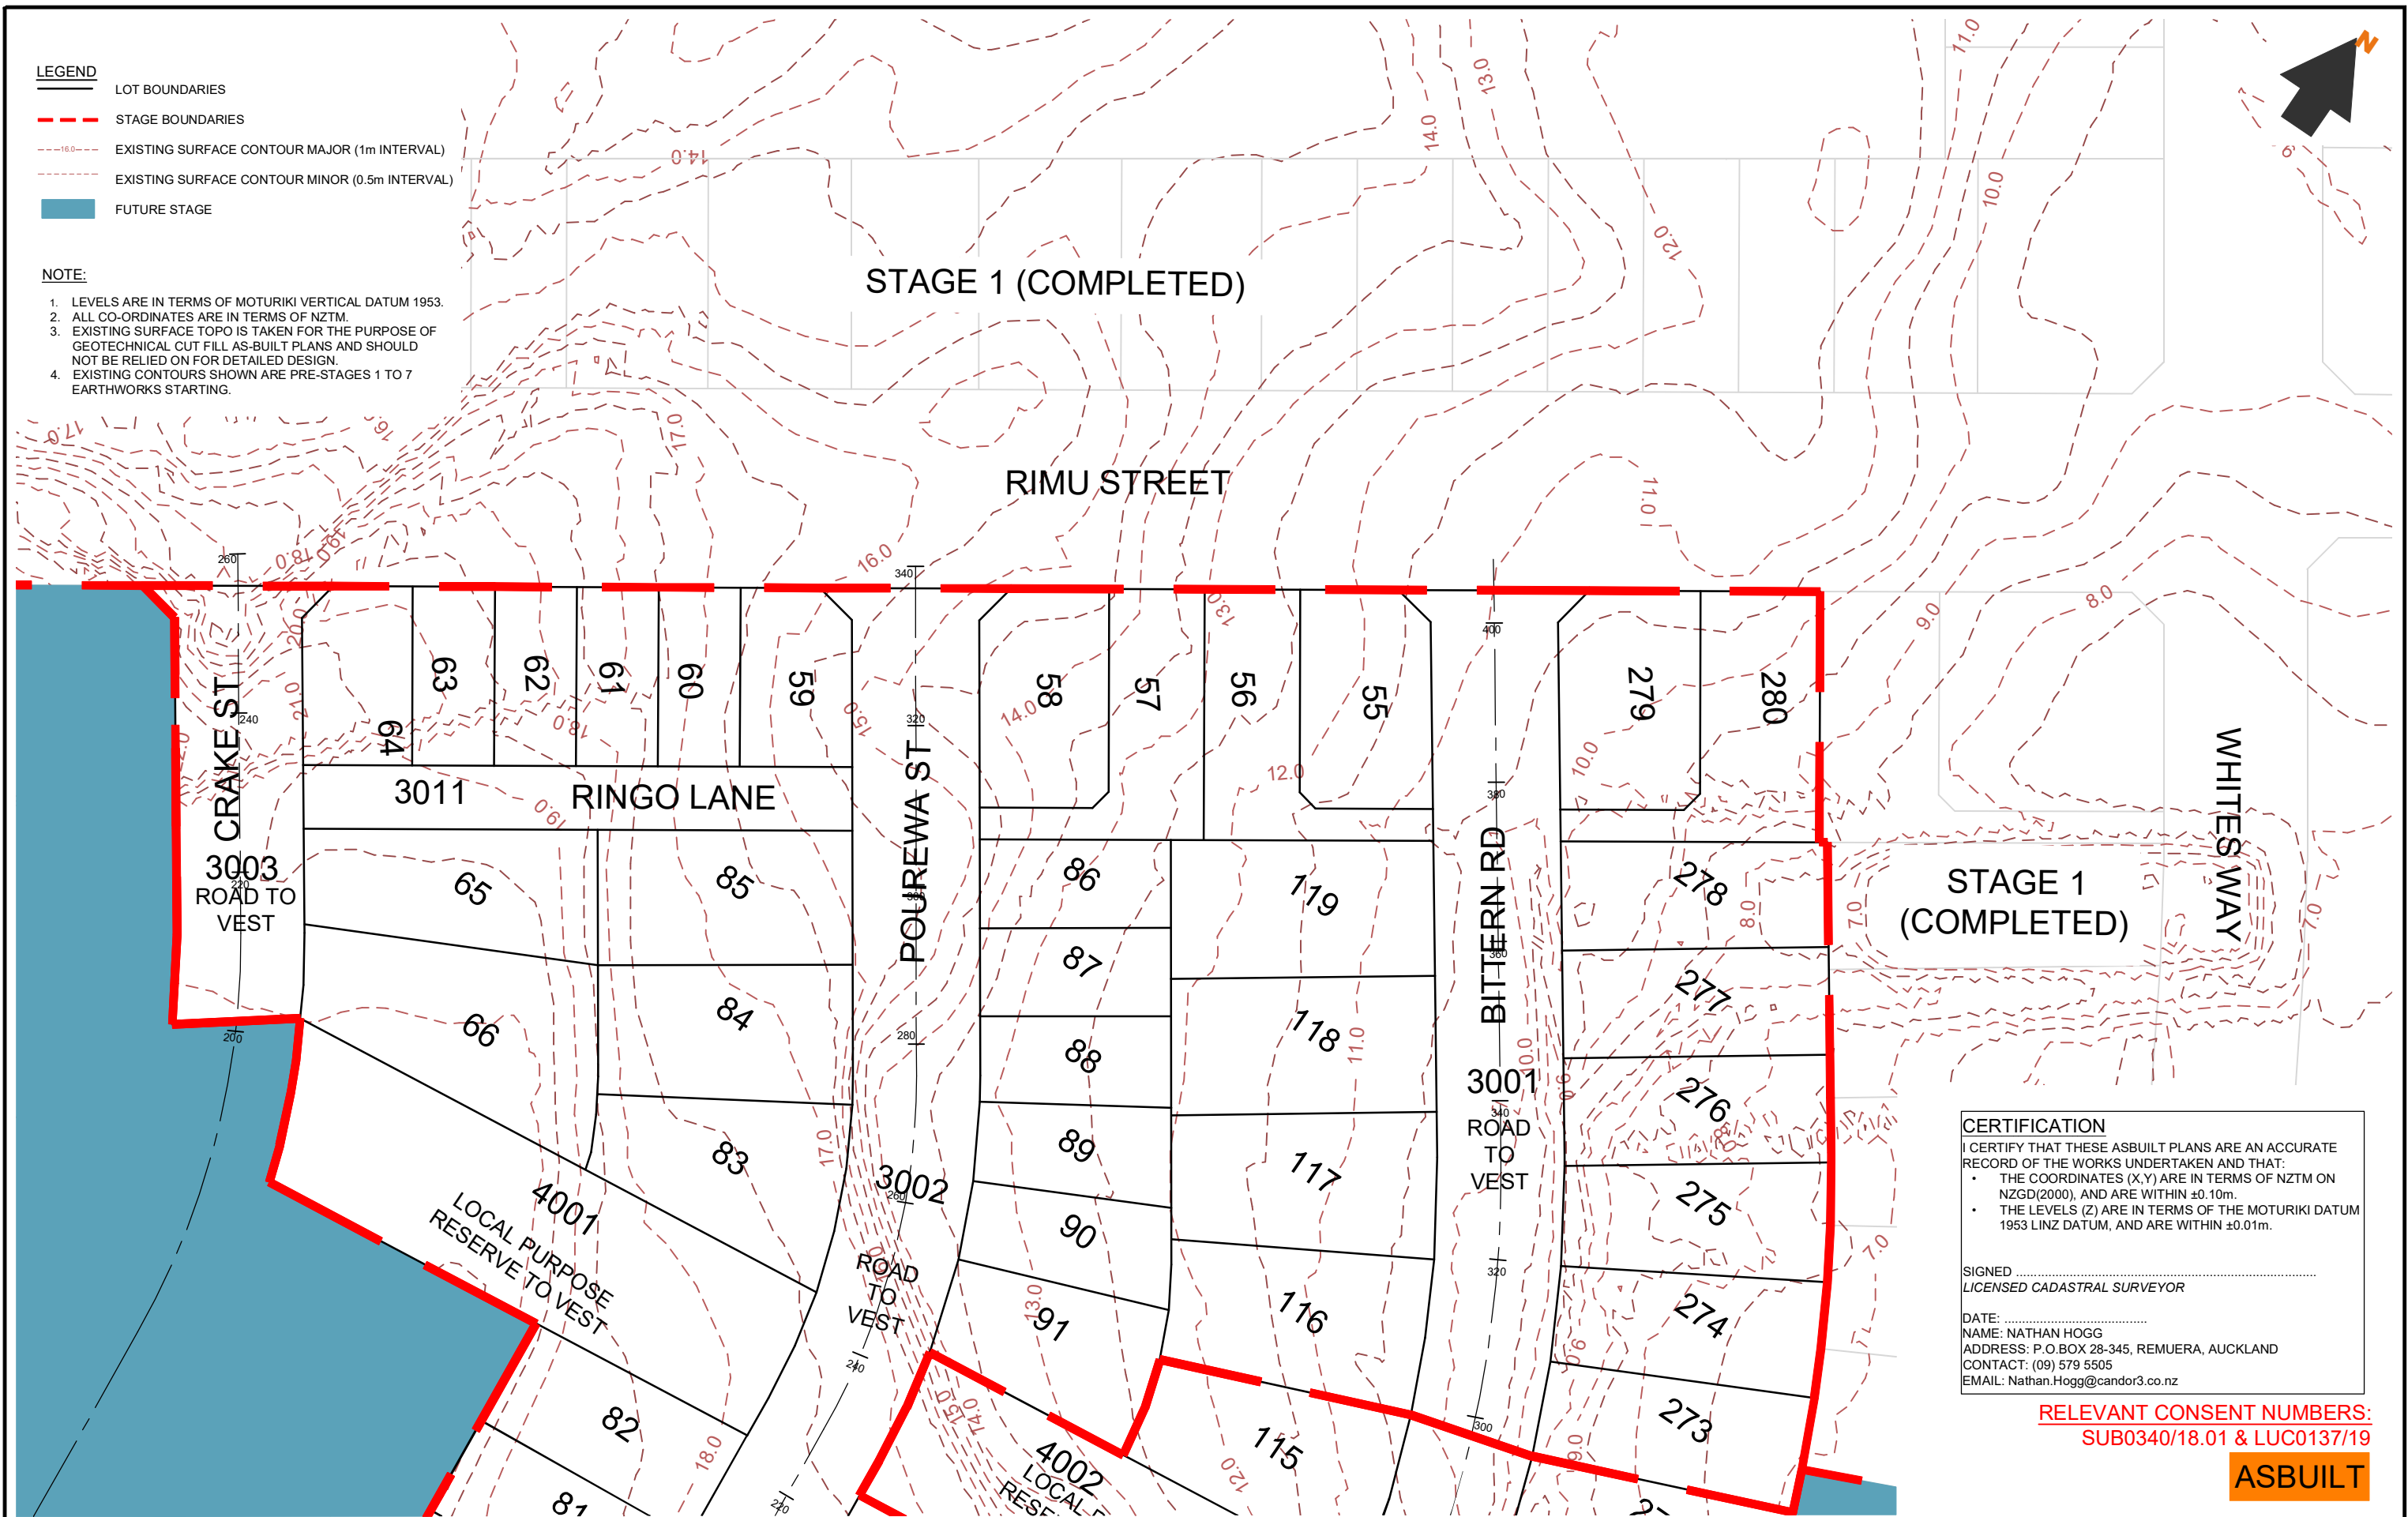

CERTIFICATION
I CERTIFY THAT THESE ASBUILT PLANS ARE AN ACCURATE RECORD OF THE WORKS UNDERTAKEN AND THAT:
• THE COORDINATES (X,Y) ARE IN TERMS OF NZTM ON NZGD(2000), AND ARE WITHIN ±0.10m.
• THE LEVELS (Z) ARE IN TERMS OF THE MOTURIKI DATUM 1953 LINZ DATUM, AND ARE WITHIN ±0.01m.


SIGNED
LICENSED CADASTRAL SURVEYOR

DATE:
NAME: NATHAN HOGG
ADDRESS: P.O.BOX 28-345, REMUERA, AUCKLAND
CONTACT: (09) 579 5505
EMAIL: Nathan.Hogg@candor3.co.nz

RELEVANT CONSENT NUMBERS:
SUB0340/18.01 & LUC0137/19

ASBUILT

REV DESCRIPTION		BY	APPVD	DATE	PROJECT		CLIENT		PURPOSE		
					LAKESIDE, TE KAUWHATA		LAKESIDE		AS-BUILT		
					EARTHWORKS EXISTING SURFACE		DEVELOPMENTS 2017		DESIGN JS	APPROVED BY NH	SCALE 1:750 @ A3
					SHEET 2 OF 3		LIMITED		CHECK RS	DATE MAY 2020	
									PROJECT NO.	DRAWING NO.	REV.
									1239	AB-2-101	-

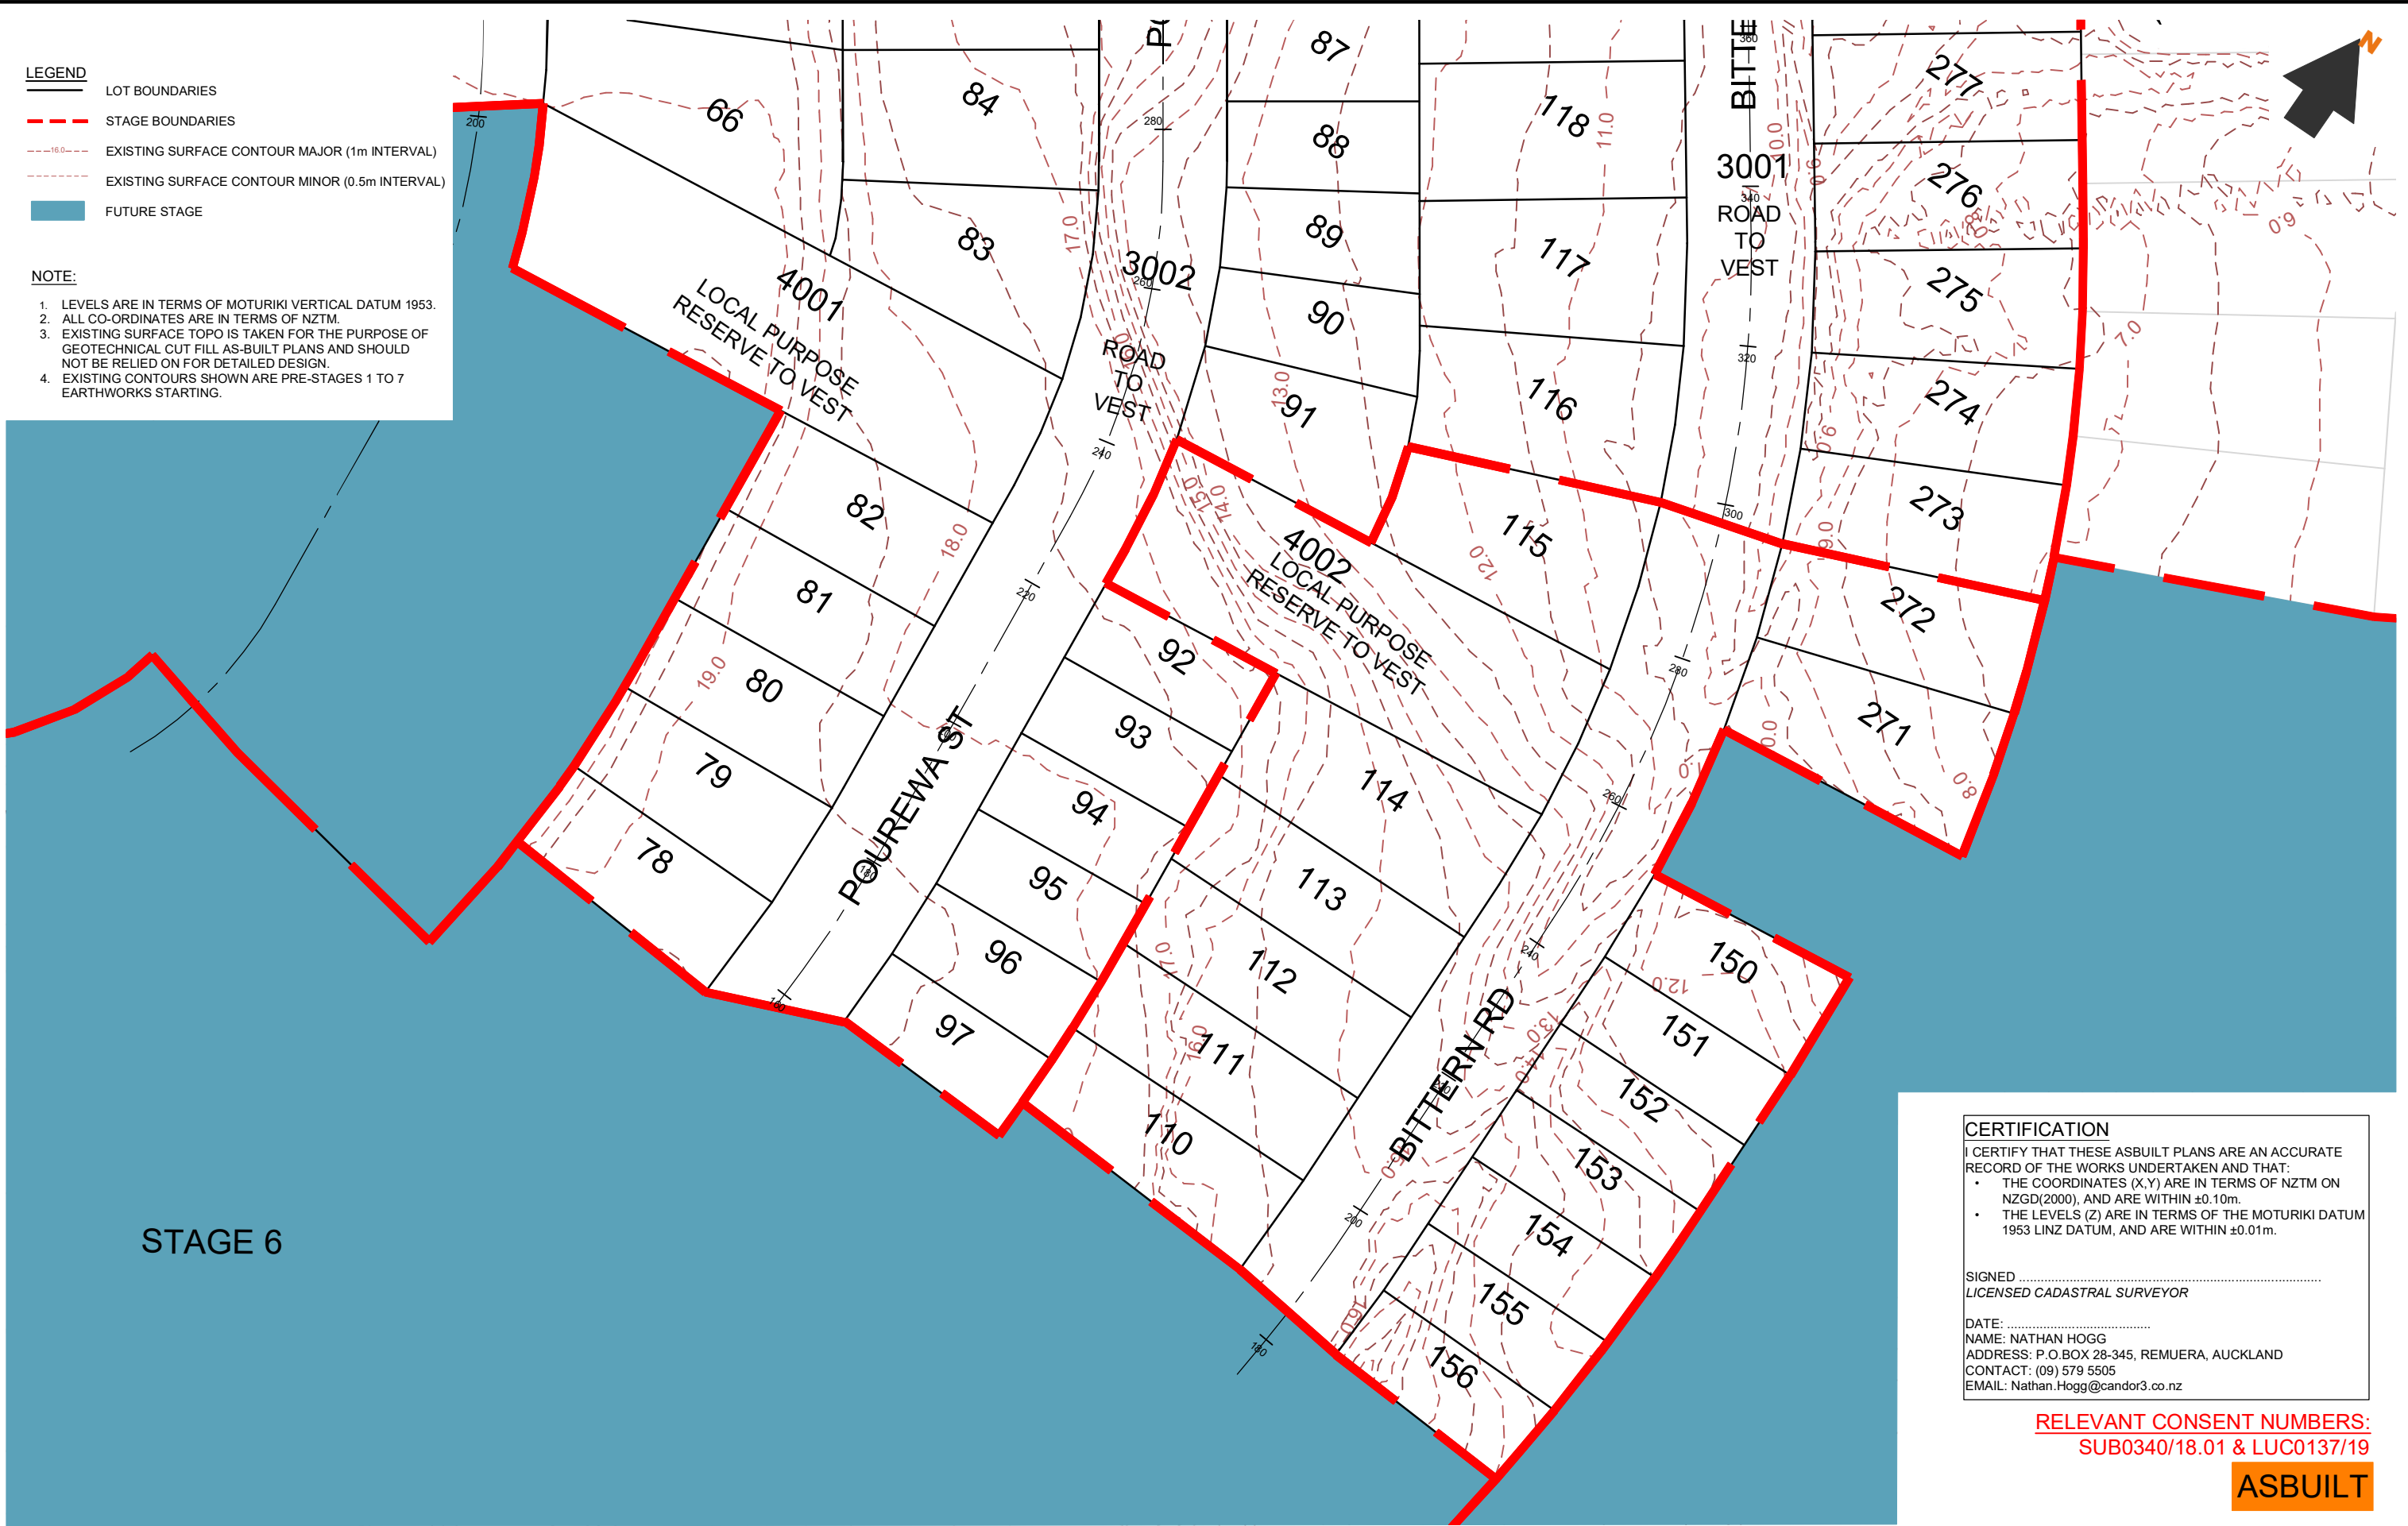

CERTIFICATION

I CERTIFY THAT THESE ASBUILT PLANS ARE AN ACCURATE RECORD OF THE WORKS UNDERTAKEN AND THAT:

- THE COORDINATES (X,Y) ARE IN TERMS OF NZTM ON NZGD(2000), AND ARE WITHIN ±0.10m.
- THE LEVELS (Z) ARE IN TERMS OF THE MOTURIKI DATUM 1953 LINZ DATUM, AND ARE WITHIN ±0.01m.


SIGNED
LICENSED CADASTRAL SURVEYOR

DATE:
NAME: NATHAN HOGG
ADDRESS: P.O.BOX 28-345, REMUERA, AUCKLAND
CONTACT: (09) 579 5505
EMAIL: Nathan.Hogg@candor3.co.nz

RELEVANT CONSENT NUMBERS:
SUB0340/18.01 & LUC0137/19

ASBUILT

REV DESCRIPTION		BY	APPVD	DATE	PROJECT		CLIENT		PURPOSE		
					LAKESIDE, TE KAUWHATA		LAKESIDE		AS-BUILT		
					EARTHWORKS EXISTING SURFACE STAGE 2		DEVELOPMENTS 2017		DESIGN JS	APPROVED BY NH	SCALE 1:750 @ A3
					3 OF 3		LIMITED		CHECK RS	DATE MAY 2020	
									PROJECT NO.	DRAWING NO.	REV.
									1239	AB-2-102	-

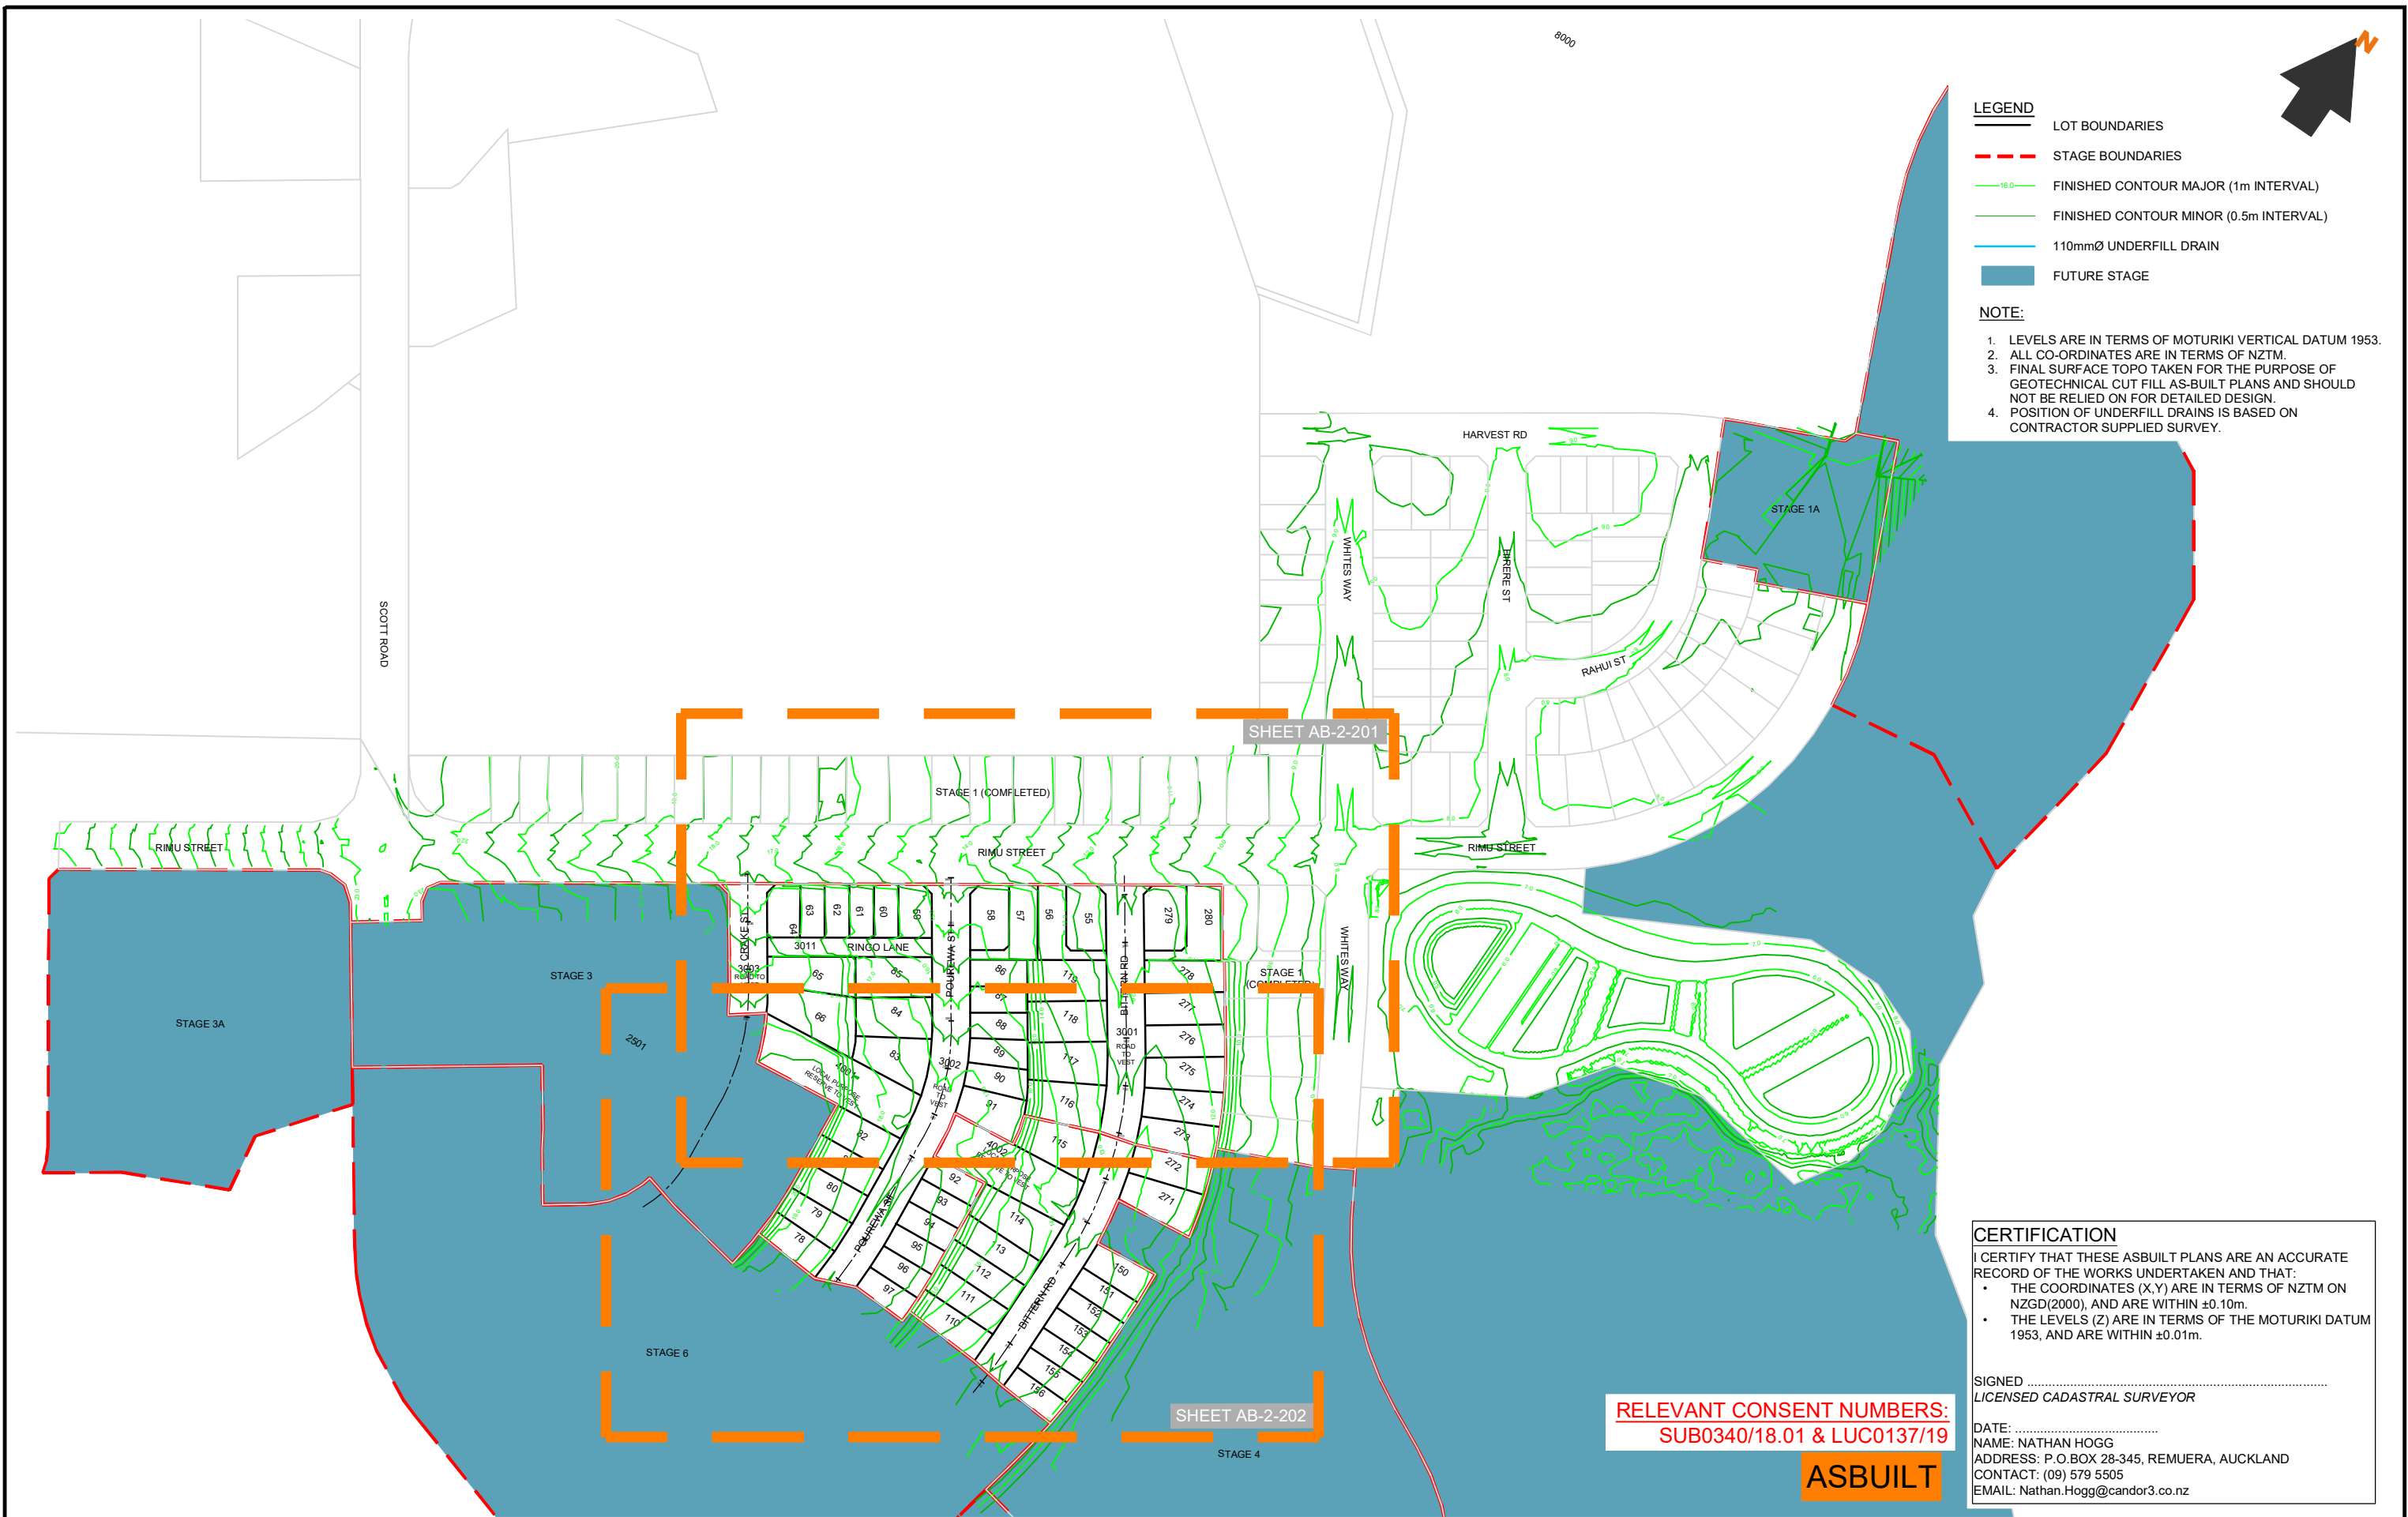

- LEGEND**
- LOT BOUNDARIES
 - STAGE BOUNDARIES
 - FINISHED CONTOUR MAJOR (1m INTERVAL)
 - FINISHED CONTOUR MINOR (0.5m INTERVAL)
 - 110mmØ UNDERFILL DRAIN
 - FUTURE STAGE
- NOTE:**
- LEVELS ARE IN TERMS OF MOTURIKI VERTICAL DATUM 1953.
 - ALL CO-ORDINATES ARE IN TERMS OF NZTM.
 - FINAL SURFACE TOPO TAKEN FOR THE PURPOSE OF GEOTECHNICAL CUT FILL AS-BUILT PLANS AND SHOULD NOT BE RELIED ON FOR DETAILED DESIGN.
 - POSITION OF UNDERFILL DRAINS IS BASED ON CONTRACTOR SUPPLIED SURVEY.

CERTIFICATION

I CERTIFY THAT THESE ASBUILT PLANS ARE AN ACCURATE RECORD OF THE WORKS UNDERTAKEN AND THAT:

- THE COORDINATES (X,Y) ARE IN TERMS OF NZTM ON NZGD(2000), AND ARE WITHIN ±0.10m.
- THE LEVELS (Z) ARE IN TERMS OF THE MOTURIKI DATUM 1953, AND ARE WITHIN ±0.01m.

SIGNED
LICENSED CADASTRAL SURVEYOR

DATE:
NAME: NATHAN HOGG
ADDRESS: P.O.BOX 28-345, REMUERA, AUCKLAND
CONTACT: (09) 579 5505
EMAIL: Nathan.Hogg@candor3.co.nz

RELEVANT CONSENT NUMBERS:
SUB0340/18.01 & LUC0137/19

ASBUILT


REV DESCRIPTION		BY	APPVD	DATE	PROJECT		CLIENT		PURPOSE		
<div>Candor³ ENGINEERING FOR LIFE</div>					LAKESIDE, TE KAUPHATA EARTHWORKS FINISHED SURFACE STAGE 2 SHEET 1 OF 3		LAKESIDE DEVELOPMENTS 2017 LIMITED		AS-BUILT		
DESIGN JS		APPROVED BY NH		SCALE		PROJECT NO.		DRAWING NO.		REV.	
DRAWN JS		DATE MAY 2020		1:2500 @ A3		1239		AB-2-200		-	
CHECK RS											

LEGEND

- LOT BOUNDARIES
- STAGE BOUNDARIES
- FINISHED CONTOUR MAJOR (1m INTERVAL)
- FINISHED CONTOUR MINOR (0.5m INTERVAL)
- 110mmØ UNDERFILL DRAIN
- FUTURE STAGE

NOTE:

- LEVELS ARE IN TERMS OF MOTURIKI VERTICAL DATUM 1953.
- ALL CO-ORDINATES ARE IN TERMS OF NZTM.
- FINAL SURFACE TOPO TAKEN FOR THE PURPOSE OF GEOTECHNICAL CUT FILL AS-BUILT PLANS AND SHOULD NOT BE RELIED ON FOR DETAILED DESIGN.
- POSITION OF UNDERFILL DRAINS IS BASED ON CONTRACTOR SUPPLIED SURVEY.

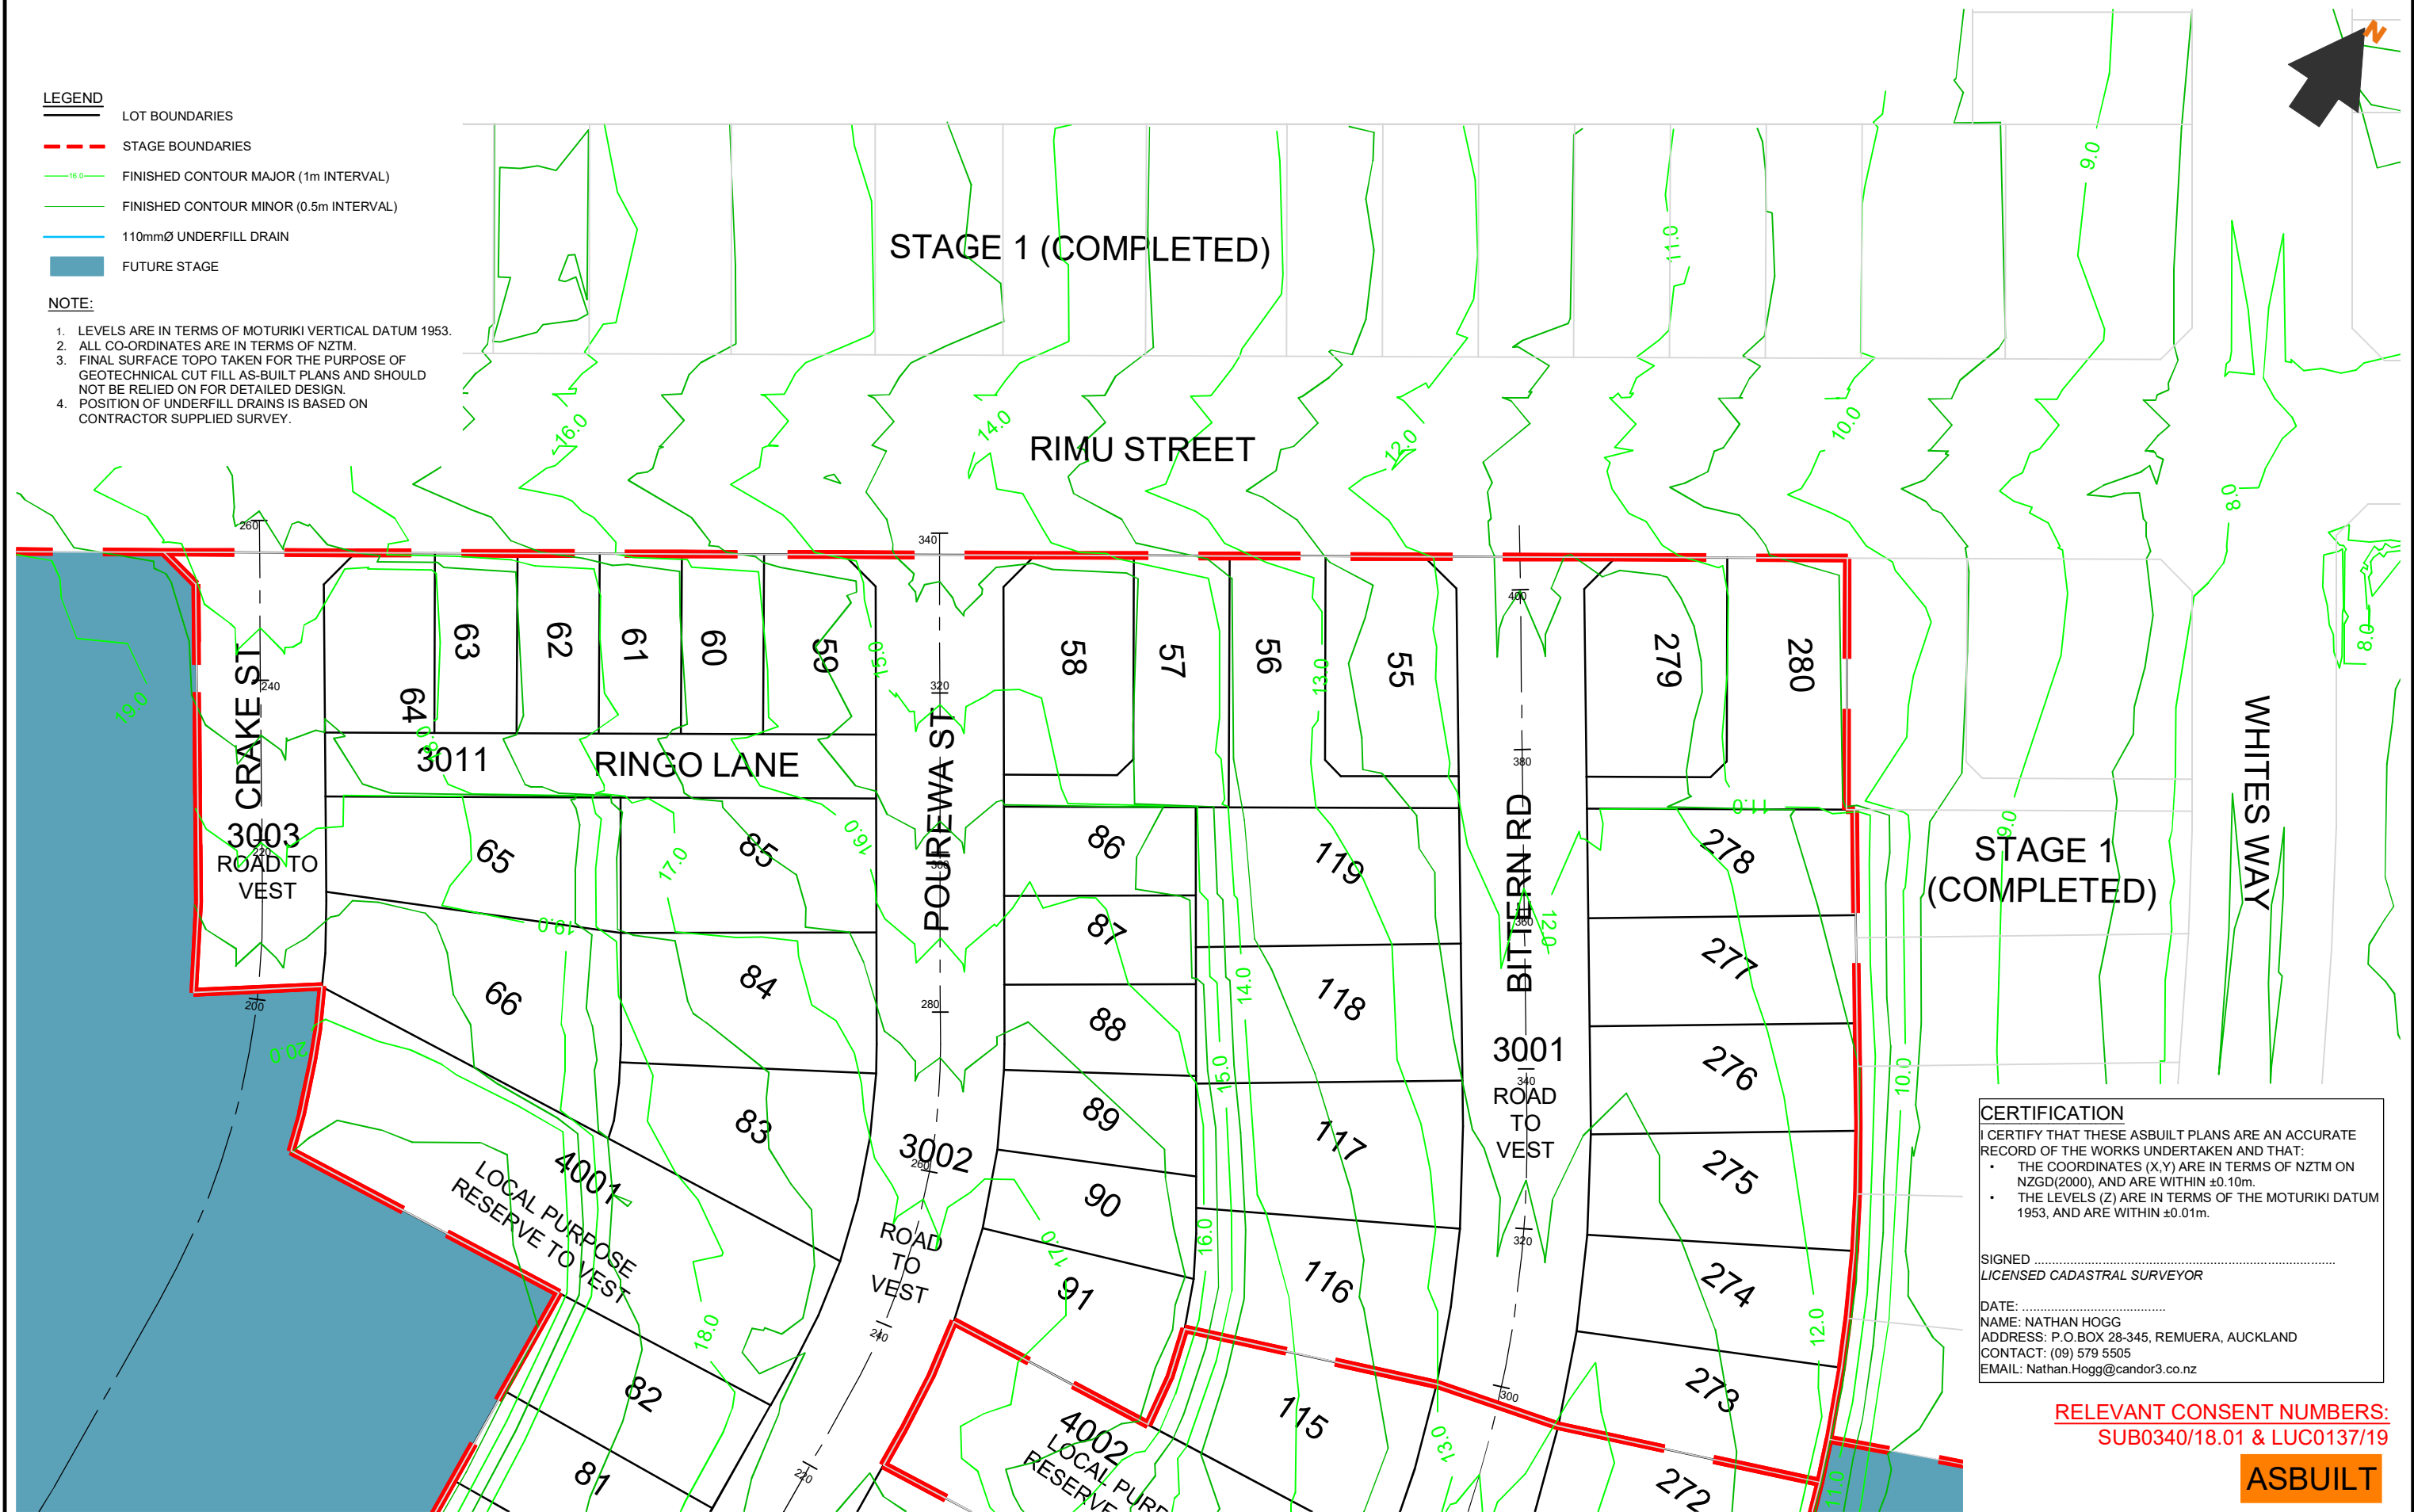

CERTIFICATION
I CERTIFY THAT THESE ASBUILT PLANS ARE AN ACCURATE RECORD OF THE WORKS UNDERTAKEN AND THAT:
• THE COORDINATES (X,Y) ARE IN TERMS OF NZTM ON NZGD(2000), AND ARE WITHIN ±0.10m.
• THE LEVELS (Z) ARE IN TERMS OF THE MOTURIKI DATUM 1953, AND ARE WITHIN ±0.01m.

SIGNED
LICENSED CADASTRAL SURVEYOR

DATE:
NAME: NATHAN HOGG
ADDRESS: P.O.BOX 28-345, REMUERA, AUCKLAND
CONTACT: (09) 579 5505
EMAIL: Nathan.Hogg@candor3.co.nz

RELEVANT CONSENT NUMBERS:
SUB0340/18.01 & LUC0137/19

ASBUILT

REV DESCRIPTION		BY	APPVD	DATE	PROJECT		CLIENT		PURPOSE		
					LAKESIDE, TE KAUWHATA		LAKESIDE		AS-BUILT		
					EARTHWORKS FINISHED SURFACE STAGE 2		DEVELOPMENTS 2017		DESIGN JS	APPROVED BY NH	SCALE 1:750 @ A3
					SHEET 2 OF 3		LIMITED		DRAWN RS	DATE MAY 2020	
									CHECK RS		REV.
									PROJECT NO.	DRAWING NO.	
									1239	AB-2-201	-

Candor³
ENGINEERING FOR LIFE



LEGEND

- LOT BOUNDARIES
- STAGE BOUNDARIES
- FINISHED CONTOUR MAJOR (1m INTERVAL)
- FINISHED CONTOUR MINOR (0.5m INTERVAL)
- 110mmØ UNDERFILL DRAIN
- FUTURE STAGE

NOTE:

- LEVELS ARE IN TERMS OF MOTURIKI VERTICAL DATUM 1953.
- ALL CO-ORDINATES ARE IN TERMS OF NZTM.
- FINAL SURFACE TOPO TAKEN FOR THE PURPOSE OF GEOTECHNICAL CUT FILL AS-BUILT PLANS AND SHOULD NOT BE RELIED ON FOR DETAILED DESIGN.
- POSITION OF UNDERFILL DRAINS IS BASED ON CONTRACTOR SUPPLIED SURVEY.

CERTIFICATION

I CERTIFY THAT THESE ASBUILT PLANS ARE AN ACCURATE RECORD OF THE WORKS UNDERTAKEN AND THAT:

- THE COORDINATES (X,Y) ARE IN TERMS OF NZTM ON NZGD(2000), AND ARE WITHIN $\pm 0.10\text{m}$.
- THE LEVELS (Z) ARE IN TERMS OF THE MOTURIKI DATUM 1953, AND ARE WITHIN $\pm 0.01\text{m}$.


SIGNED
LICENSED CADASTRAL SURVEYOR

DATE:
NAME: NATHAN HOGG
ADDRESS: P.O.BOX 28-345, REMUERA, AUCKLAND
CONTACT: (09) 579 5505
EMAIL: Nathan.Hogg@candor3.co.nz

RELEVANT CONSENT NUMBERS:
SUB0340/18.01 & LUC0137/19

ASBUILT

REV	DESCRIPTION	BY	APPVD	DATE	PROJECT	CLIENT	PURPOSE
					LAKESIDE, TE KAUWHATA EARTHWORKS FINISHED SURFACE STAGE 2 SHEET 3 OF 3	LAKESIDE DEVELOPMENTS 2017 LIMITED	AS-BUILT
							DESIGN JS DRAWN JS CHECK RS
							APPROVED BY NH DATE MAY 2020
							SCALE 1:750 @ A3
							PROJECT NO. 1239
							DRAWING NO. AB-2-202
							REV. -

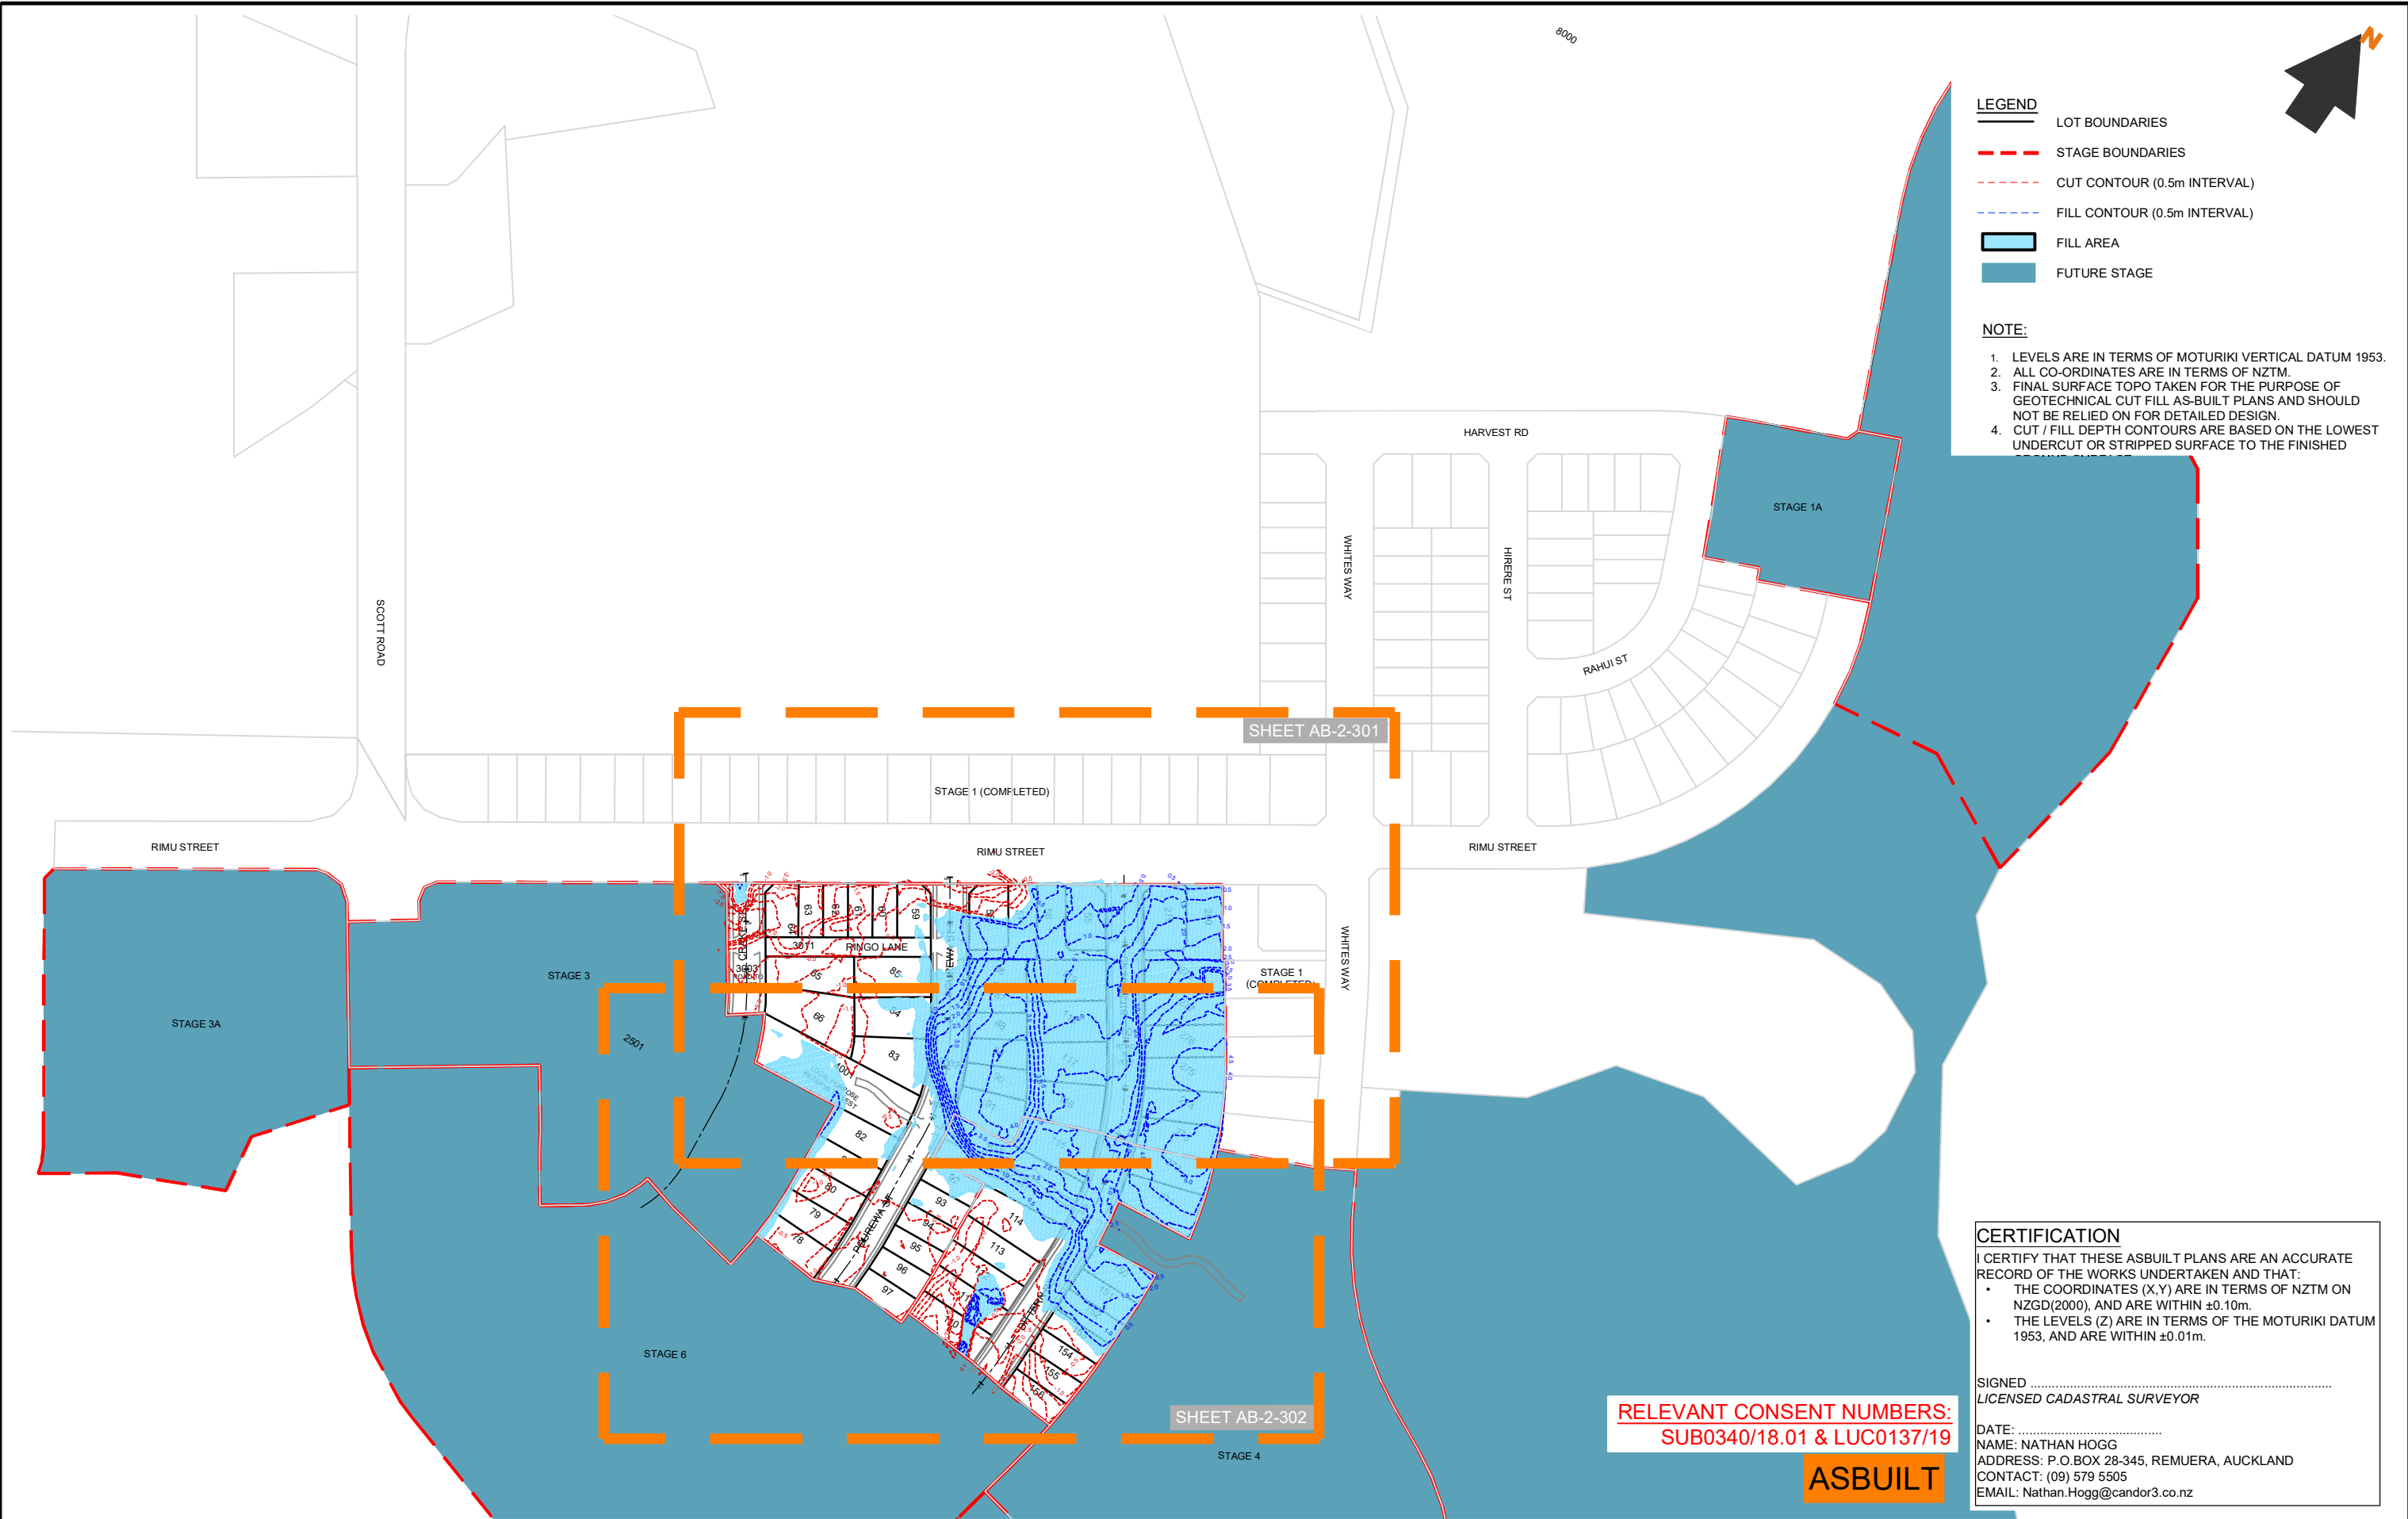

REV	DESCRIPTION	BY	APPVD	DATE



Candor³
ENGINEERING FOR LIFE

PROJECT

LAKESIDE, TE KAUWHATA
EARTHWORKS DEPTH CONTOURS STAGE 2
SHEET 1 OF 3

CLIENT

LAKESIDE
DEVELOPMENTS 2017
LIMITED

PURPOSE		
AS-BUILT		
DESIGN JS DRAWN JS CHECK RS	APPROVED BY NH DATE MAY 2020	SCALE 1:2500 @ A3
PROJECT NO.	DRAWING NO.	REV.
1239	AB-2-300	-

LEGEND


- LOT BOUNDARIES
- STAGE BOUNDARIES
- CUT CONTOUR (0.5m INTERVAL)
- FILL CONTOUR (0.5m INTERVAL)
- FILL AREA
- FUTURE STAGE

NOTE:

- LEVELS ARE IN TERMS OF MOTURIKI VERTICAL DATUM 1953.
- ALL CO-ORDINATES ARE IN TERMS OF NZTM.
- FINAL SURFACE TOPO TAKEN FOR THE PURPOSE OF GEOTECHNICAL CUT FILL AS-BUILT PLANS AND SHOULD NOT BE RELIED ON FOR DETAILED DESIGN.
- CUT / FILL DEPTH CONTOURS ARE BASED ON THE LOWEST UNDERCUT OR STRIPPED SURFACE TO THE FINISHED GROUND SURFACE.

STAGE 1 (COMPLETED)

RIMU STREET

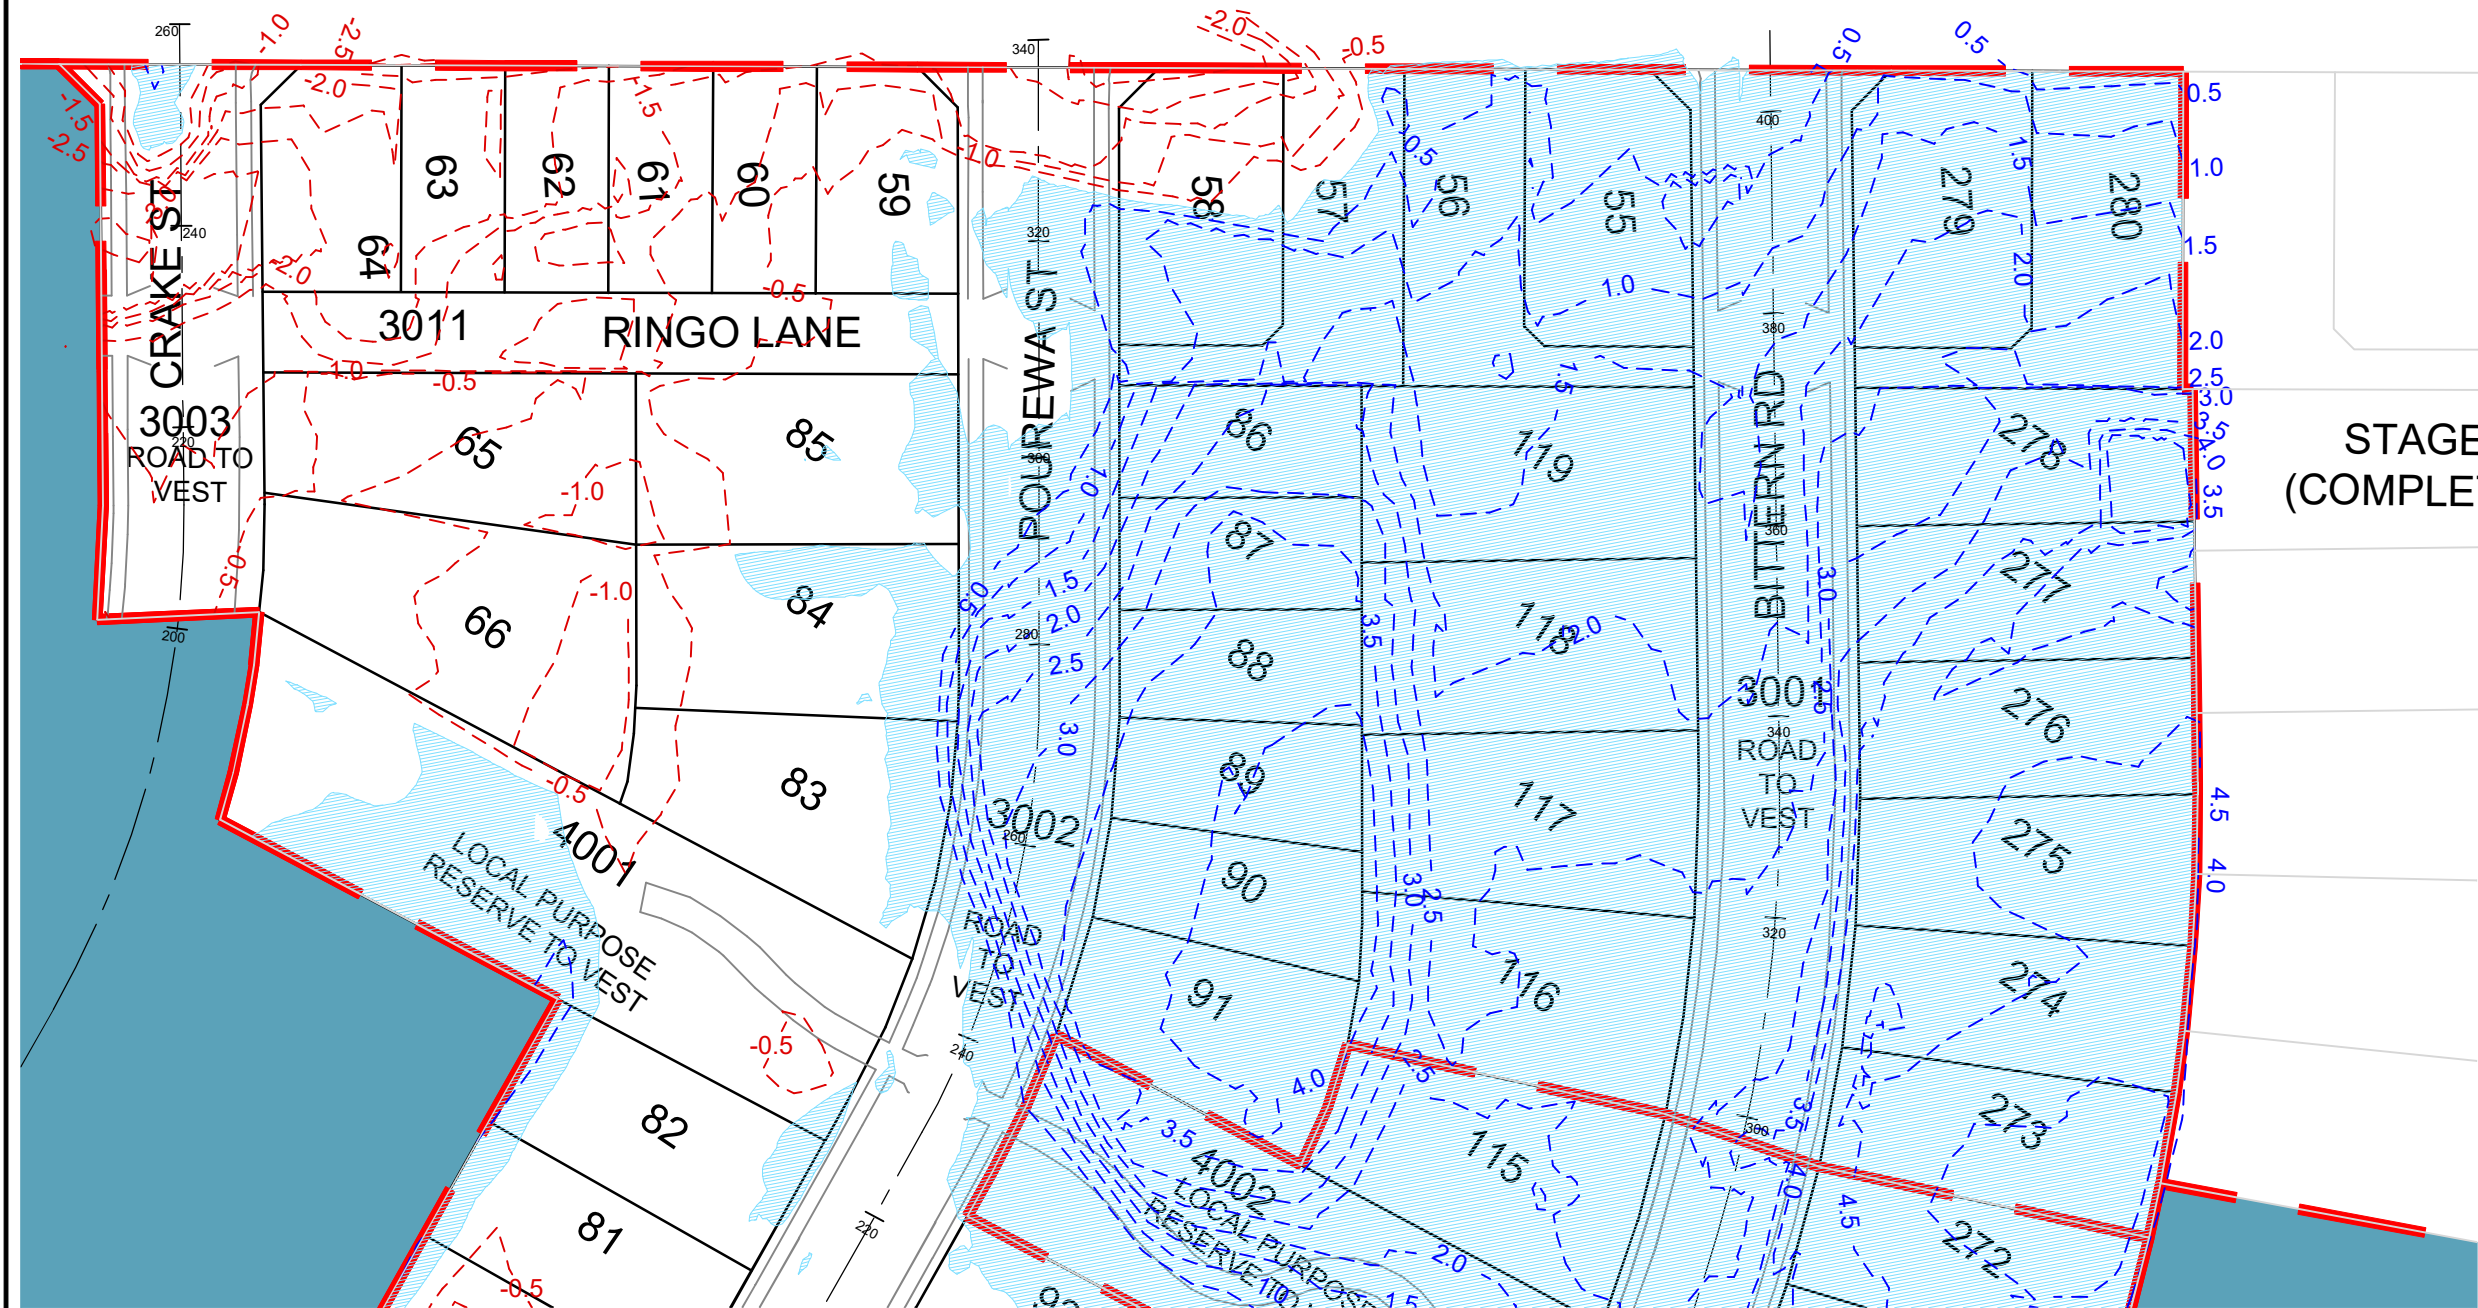

STAGE 1
(COMPLETED)

CERTIFICATION

I CERTIFY THAT THESE ASBUILT PLANS ARE AN ACCURATE RECORD OF THE WORKS UNDERTAKEN AND THAT:

- THE COORDINATES (X,Y) ARE IN TERMS OF NZTM ON NZGD(2000), AND ARE WITHIN $\pm 0.10\text{m}$.
- THE LEVELS (Z) ARE IN TERMS OF THE MOTURIKI DATUM 1953, AND ARE WITHIN $\pm 0.01\text{m}$.


SIGNED
LICENSED CADASTRAL SURVEYOR

DATE:
NAME: NATHAN HOGG
ADDRESS: P.O.BOX 28-345, REMUERA, AUCKLAND
CONTACT: (09) 579 5505
EMAIL: Nathan.Hogg@candor3.co.nz

RELEVANT CONSENT NUMBERS:
SUB0340/18.01 & LUC0137/19

ASBUILT

REV	DESCRIPTION	BY	APPVD	DATE	PROJECT	CLIENT	PURPOSE
					LAKESIDE, TE KAUWHATA EARTHWORKS DEPTH CONTOURS STAGE 2 SHEET 2 OF 3	LAKESIDE DEVELOPMENTS 2017 LIMITED	AS-BUILT
							DESIGN JS DRAWN JS CHECK RS
							APPROVED BY NH DATE MAY 2020
							SCALE 1:750 @ A3
							PROJECT NO. 1239
							DRAWING NO. AB-2-301
							REV. -

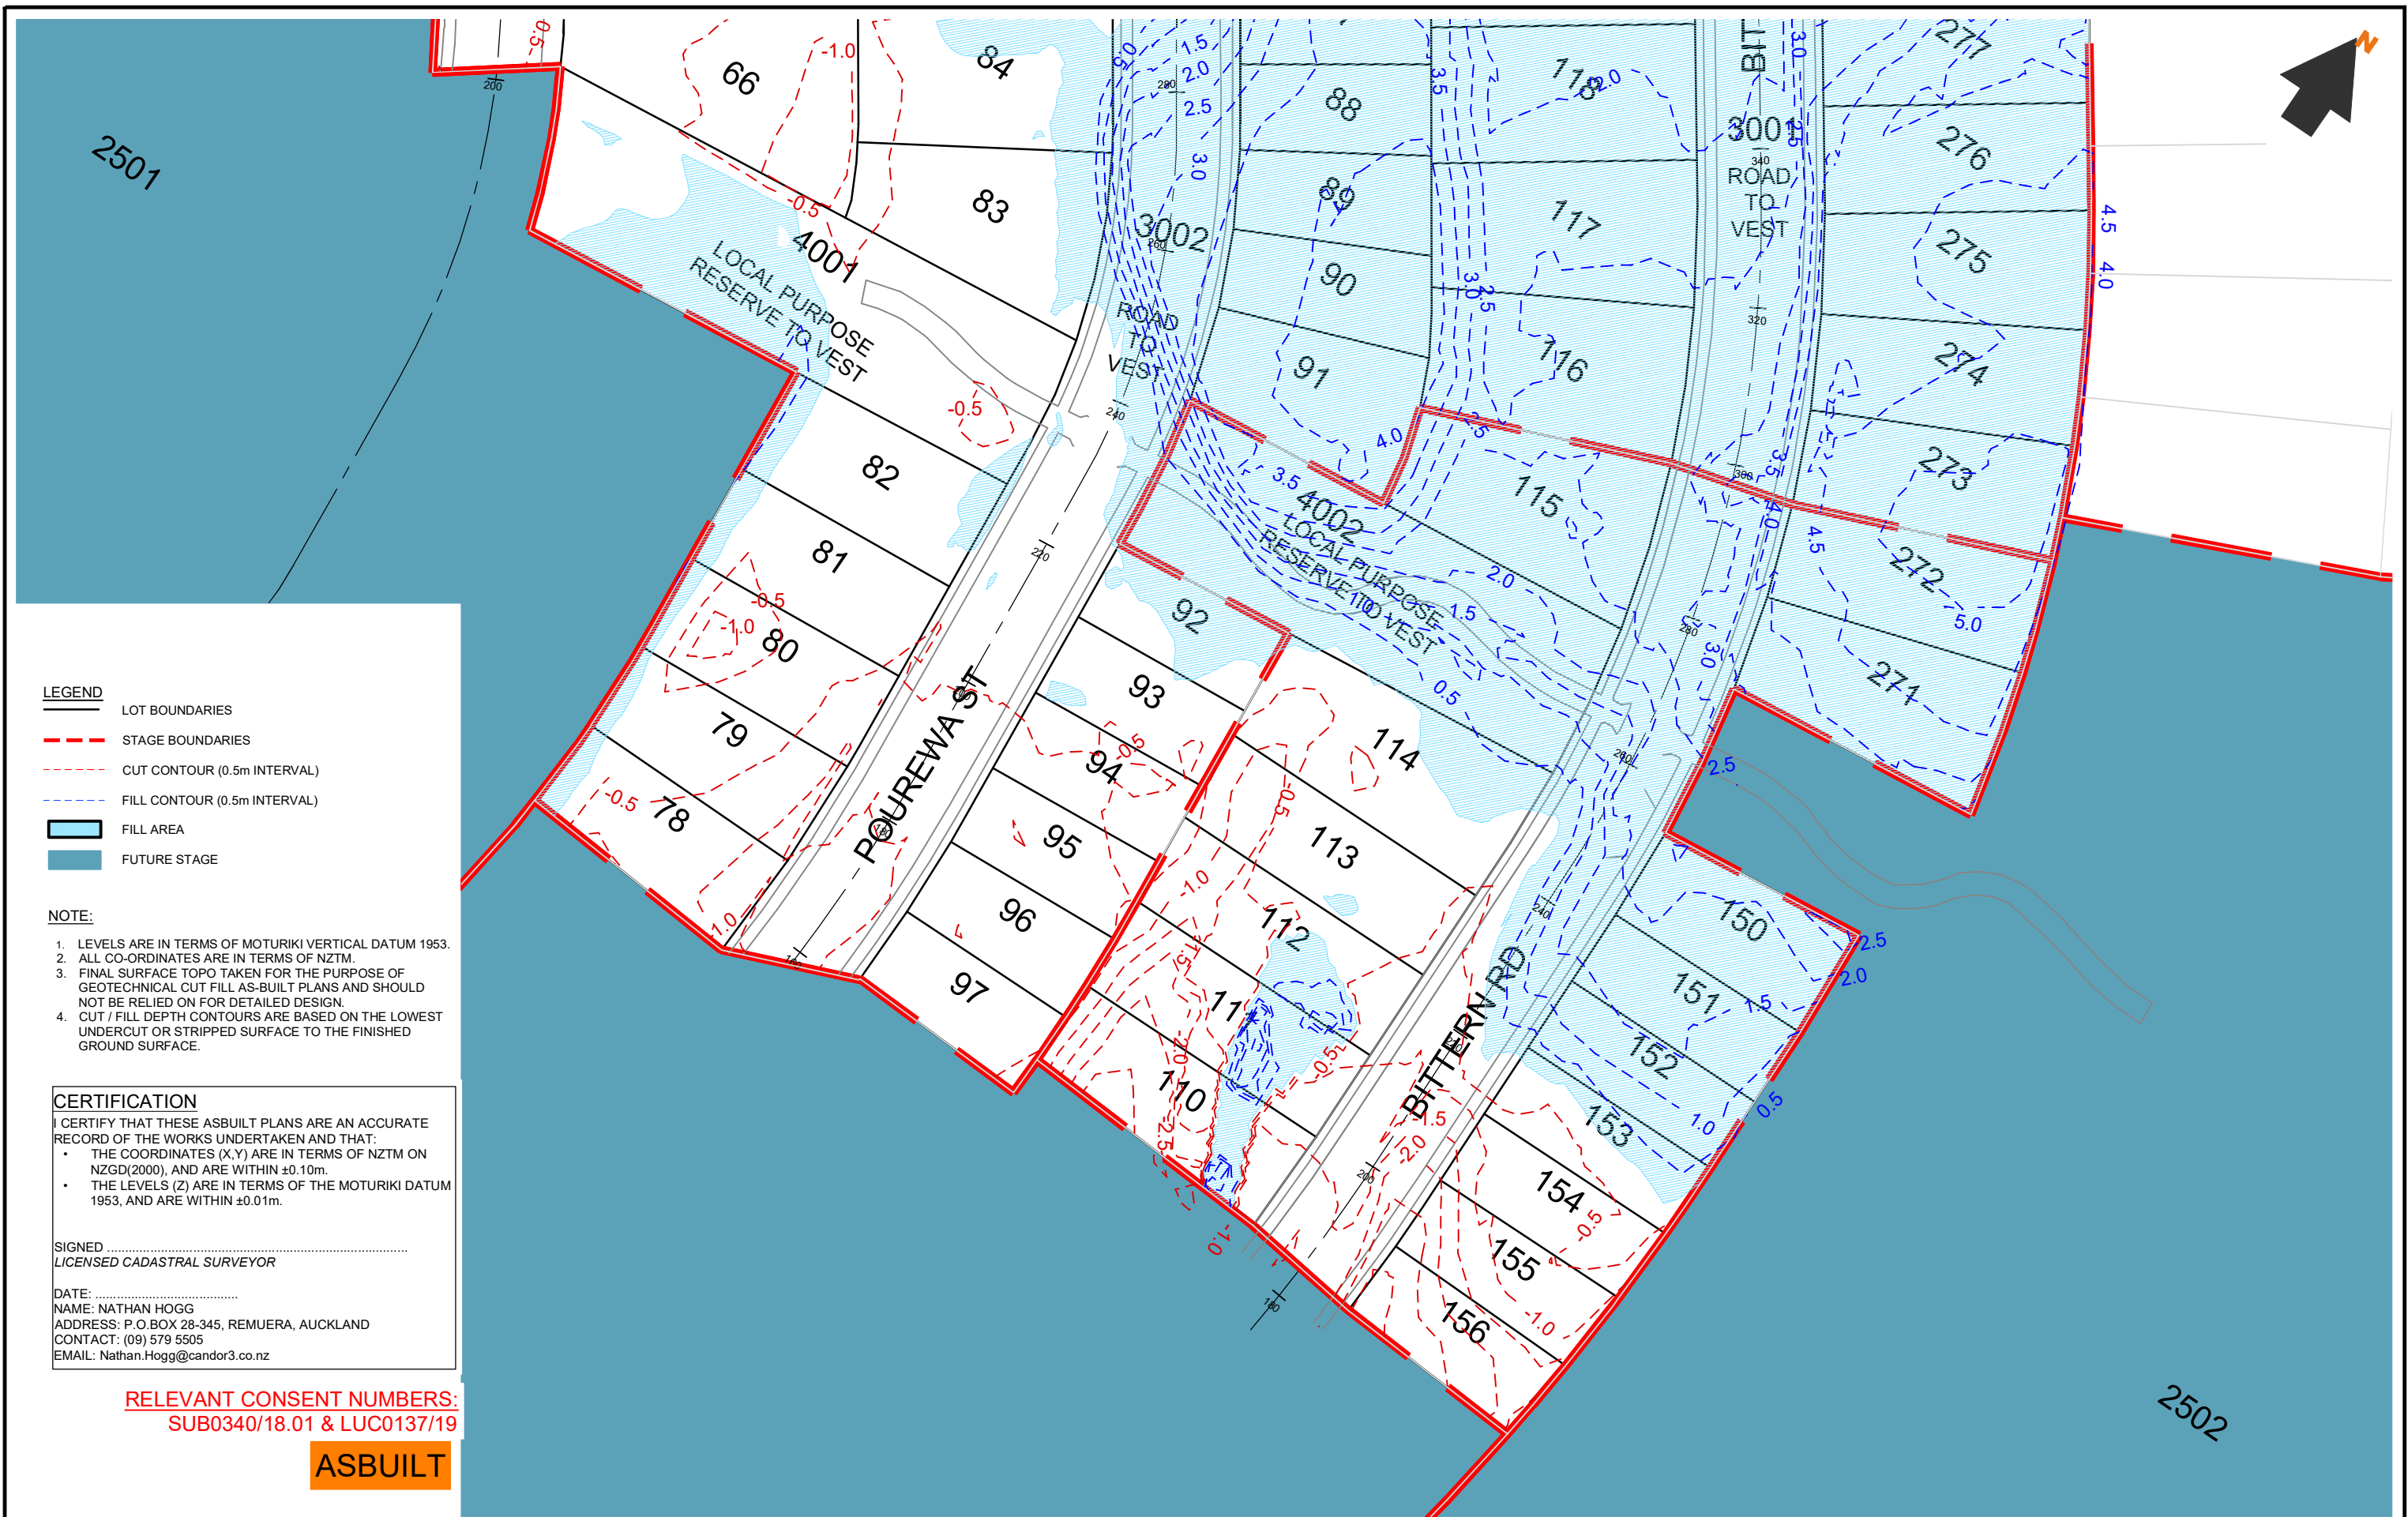

LEGEND

- LOT BOUNDARIES
- STAGE BOUNDARIES
- CUT CONTOUR (0.5m INTERVAL)
- FILL CONTOUR (0.5m INTERVAL)
- FILL AREA
- FUTURE STAGE

NOTE:

- LEVELS ARE IN TERMS OF MOTURIKI VERTICAL DATUM 1953.
- ALL CO-ORDINATES ARE IN TERMS OF NZTM.
- FINAL SURFACE TOPO TAKEN FOR THE PURPOSE OF GEOTECHNICAL CUT FILL AS-BUILT PLANS AND SHOULD NOT BE RELIED ON FOR DETAILED DESIGN.
- CUT / FILL DEPTH CONTOURS ARE BASED ON THE LOWEST UNDERCUT OR STRIPPED SURFACE TO THE FINISHED GROUND SURFACE.

CERTIFICATION

I CERTIFY THAT THESE ASBUILT PLANS ARE AN ACCURATE RECORD OF THE WORKS UNDERTAKEN AND THAT:

- THE COORDINATES (X,Y) ARE IN TERMS OF NZTM ON NZGD(2000), AND ARE WITHIN $\pm 0.10\text{m}$.
- THE LEVELS (Z) ARE IN TERMS OF THE MOTURIKI DATUM 1953, AND ARE WITHIN $\pm 0.01\text{m}$.

SIGNED
LICENSED CADASTRAL SURVEYOR

DATE:
NAME: NATHAN HOGG
ADDRESS: P.O.BOX 28-345, REMUERA, AUCKLAND
CONTACT: (09) 579 5505
EMAIL: Nathan.Hogg@candor3.co.nz

RELEVANT CONSENT NUMBERS:
SUB0340/18.01 & LUC0137/19

ASBUILT

REV	DESCRIPTION	BY	APPVD	DATE	PROJECT	CLIENT	PURPOSE
					LAKESIDE, TE KAUWHATA EARTHWORKS DEPTH CONTOURS STAGE 2 SHEET 3 OF 3	LAKESIDE DEVELOPMENTS 2017 LIMITED	AS-BUILT
							DESIGN JS DRAWN JS CHECK RS
							APPROVED BY NH DATE MAY 2020
							SCALE 1:750 @ A3
							PROJECT NO.
							DRAWING NO.
							REV.
							1239
							AB-2-302
							-