

LEGEND

LOT BOUNDARIES

STAGE BOUNDARIES

ROAD CENTRELINE

NEW WASTEWATER PIPE

NEW WASTEWATER LOT CONNECTION

EXISTING WASTEWATER PIPE

ABANDONED WASTEWATER PIPE

WASTEWATER MANHOLE  
EXISTING / NEW / ABANDONED

FUTURE STAGE

- NOTES
1. ALL WORKS AND MATERIALS COMPLY WITH THE WAIKATO LOCAL AUTHORITY SHARED SERVICES REGIONAL INFRASTRUCTURE TECHNICAL SPECIFICATIONS (RITS) (MAY 2018).

2. MANHOLES ARE 1050mm Ø CONCRETE MANHOLES UNLESS OTHERWISE NOTED.

3. PIPE CROSSINGS UNDER ROADS AND ACCESSWAYS HAVE BEEN HARDFILL BACKFILLED.

4. LEVELS ARE IN TERMS OF THE MOTURIKI DATUM 1953.

5. ALL CO-ORDINATES ARE IN TERMS OF NZTM.

6. ALL WASTEWATER (SS) PIPES ARE 150mm Ø u-PVC SN16, UNLESS STATED OTHERWISE.

CERTIFICATION

I CERTIFY THAT THESE ASBUILT PLANS ARE AN ACCURATE RECORD OF THE WORKS UNDERTAKEN AND THAT:

- THE COORDINATES (X,Y) ARE IN TERMS OF NZTM ON NZGD(2000), AND ARE WITHIN ±0.10m.
- THE LEVELS (Z) ARE IN TERMS OF THE MOTURIKI DATUM 1953, AND ARE WITHIN ±0.01m.

SIGNED  
LICENSED CADASTRAL SURVEYOR

DATE:  
NAME: NATHAN HOGG  
ADDRESS: P.O.BOX 28-345, REMUERA, AUCKLAND  
CONTACT: (09) 579 5505  
EMAIL: Nathan.Hogg@candor3.co.nz

RELEVANT CONSENT NUMBERS:  
SUB0340/18.01 & LUC0137/19

ASBUILT

REV DESCRIPTION		BY	APPVD	DATE	PROJECT		CLIENT		PURPOSE		
<div>Candor<sup>3</sup> ENGINEERING FOR LIFE</div>					LAKESIDE, TE KAUPHATA WASTEWATER LAYOUT STAGE 2 1 OF 3		LAKESIDE DEVELOPMENTS 2017 LIMITED		AS-BUILT		
DESIGN JS		APPROVED BY NH		SCALE		DRAWN JS		DATE MAY 2020		REV.	
CHECK RS											
PROJECT NO.		DRAWING NO.									
1239		AB-5-100									

- LEGEND
- LOT BOUNDARIES
  - STAGE BOUNDARIES
  - ROAD CENTRELINE
  - NEW WASTEWATER PIPE
  - NEW WASTEWATER LOT CONNECTION  
(11.8m) @ CH63.37
  - EXISTING WASTEWATER PIPE
  - ABANDONED WASTEWATER PIPE
  - WASTEWATER MANHOLE  
EXISTING / NEW / ABANDONED
  - FUTURE STAGE

NOTES

- ALL WORKS AND MATERIALS COMPLY WITH THE WAIKATO LOCAL AUTHORITY SHARED SERVICES REGIONAL INFRASTRUCTURE TECHNICAL SPECIFICATIONS (RITS) (MAY 2018).
- MANHOLES ARE 1050mm Ø CONCRETE MANHOLES UNLESS OTHERWISE NOTED.
- PIPE CROSSINGS UNDER ROADS AND ACCESSWAYS HAVE BEEN HARDFILL BACKFILLED.
- LEVELS ARE IN TERMS OF THE MOTURIKI DATUM 1953.
- ALL CO-ORDINATES ARE IN TERMS OF NZTM.
- ALL WASTEWATER (SS) PIPES ARE 150mm Ø u-PVC SN16, UNLESS STATED OTHERWISE.

CERTIFICATION

I CERTIFY THAT THESE ASBUILT PLANS ARE AN ACCURATE RECORD OF THE WORKS UNDERTAKEN AND THAT:

- THE COORDINATES (X,Y) ARE IN TERMS OF NZTM ON NZGD(2000), AND ARE WITHIN ±0.10m.
- THE LEVELS (Z) ARE IN TERMS OF THE MOTURIKI DATUM 1953, AND ARE WITHIN ±0.01m.


SIGNED .....  
LICENSED CADASTRAL SURVEYOR

DATE: .....  
NAME: NATHAN HOGG  
ADDRESS: P.O.BOX 28-345, REMUERA, AUCKLAND  
CONTACT: (09) 579 5505  
EMAIL: Nathan.Hogg@candor3.co.nz


RELEVANT CONSENT NUMBERS:  
SUB0340/18.01 & LUC0137/19

ASBUILT

STAGE 1 (COMPLETED)

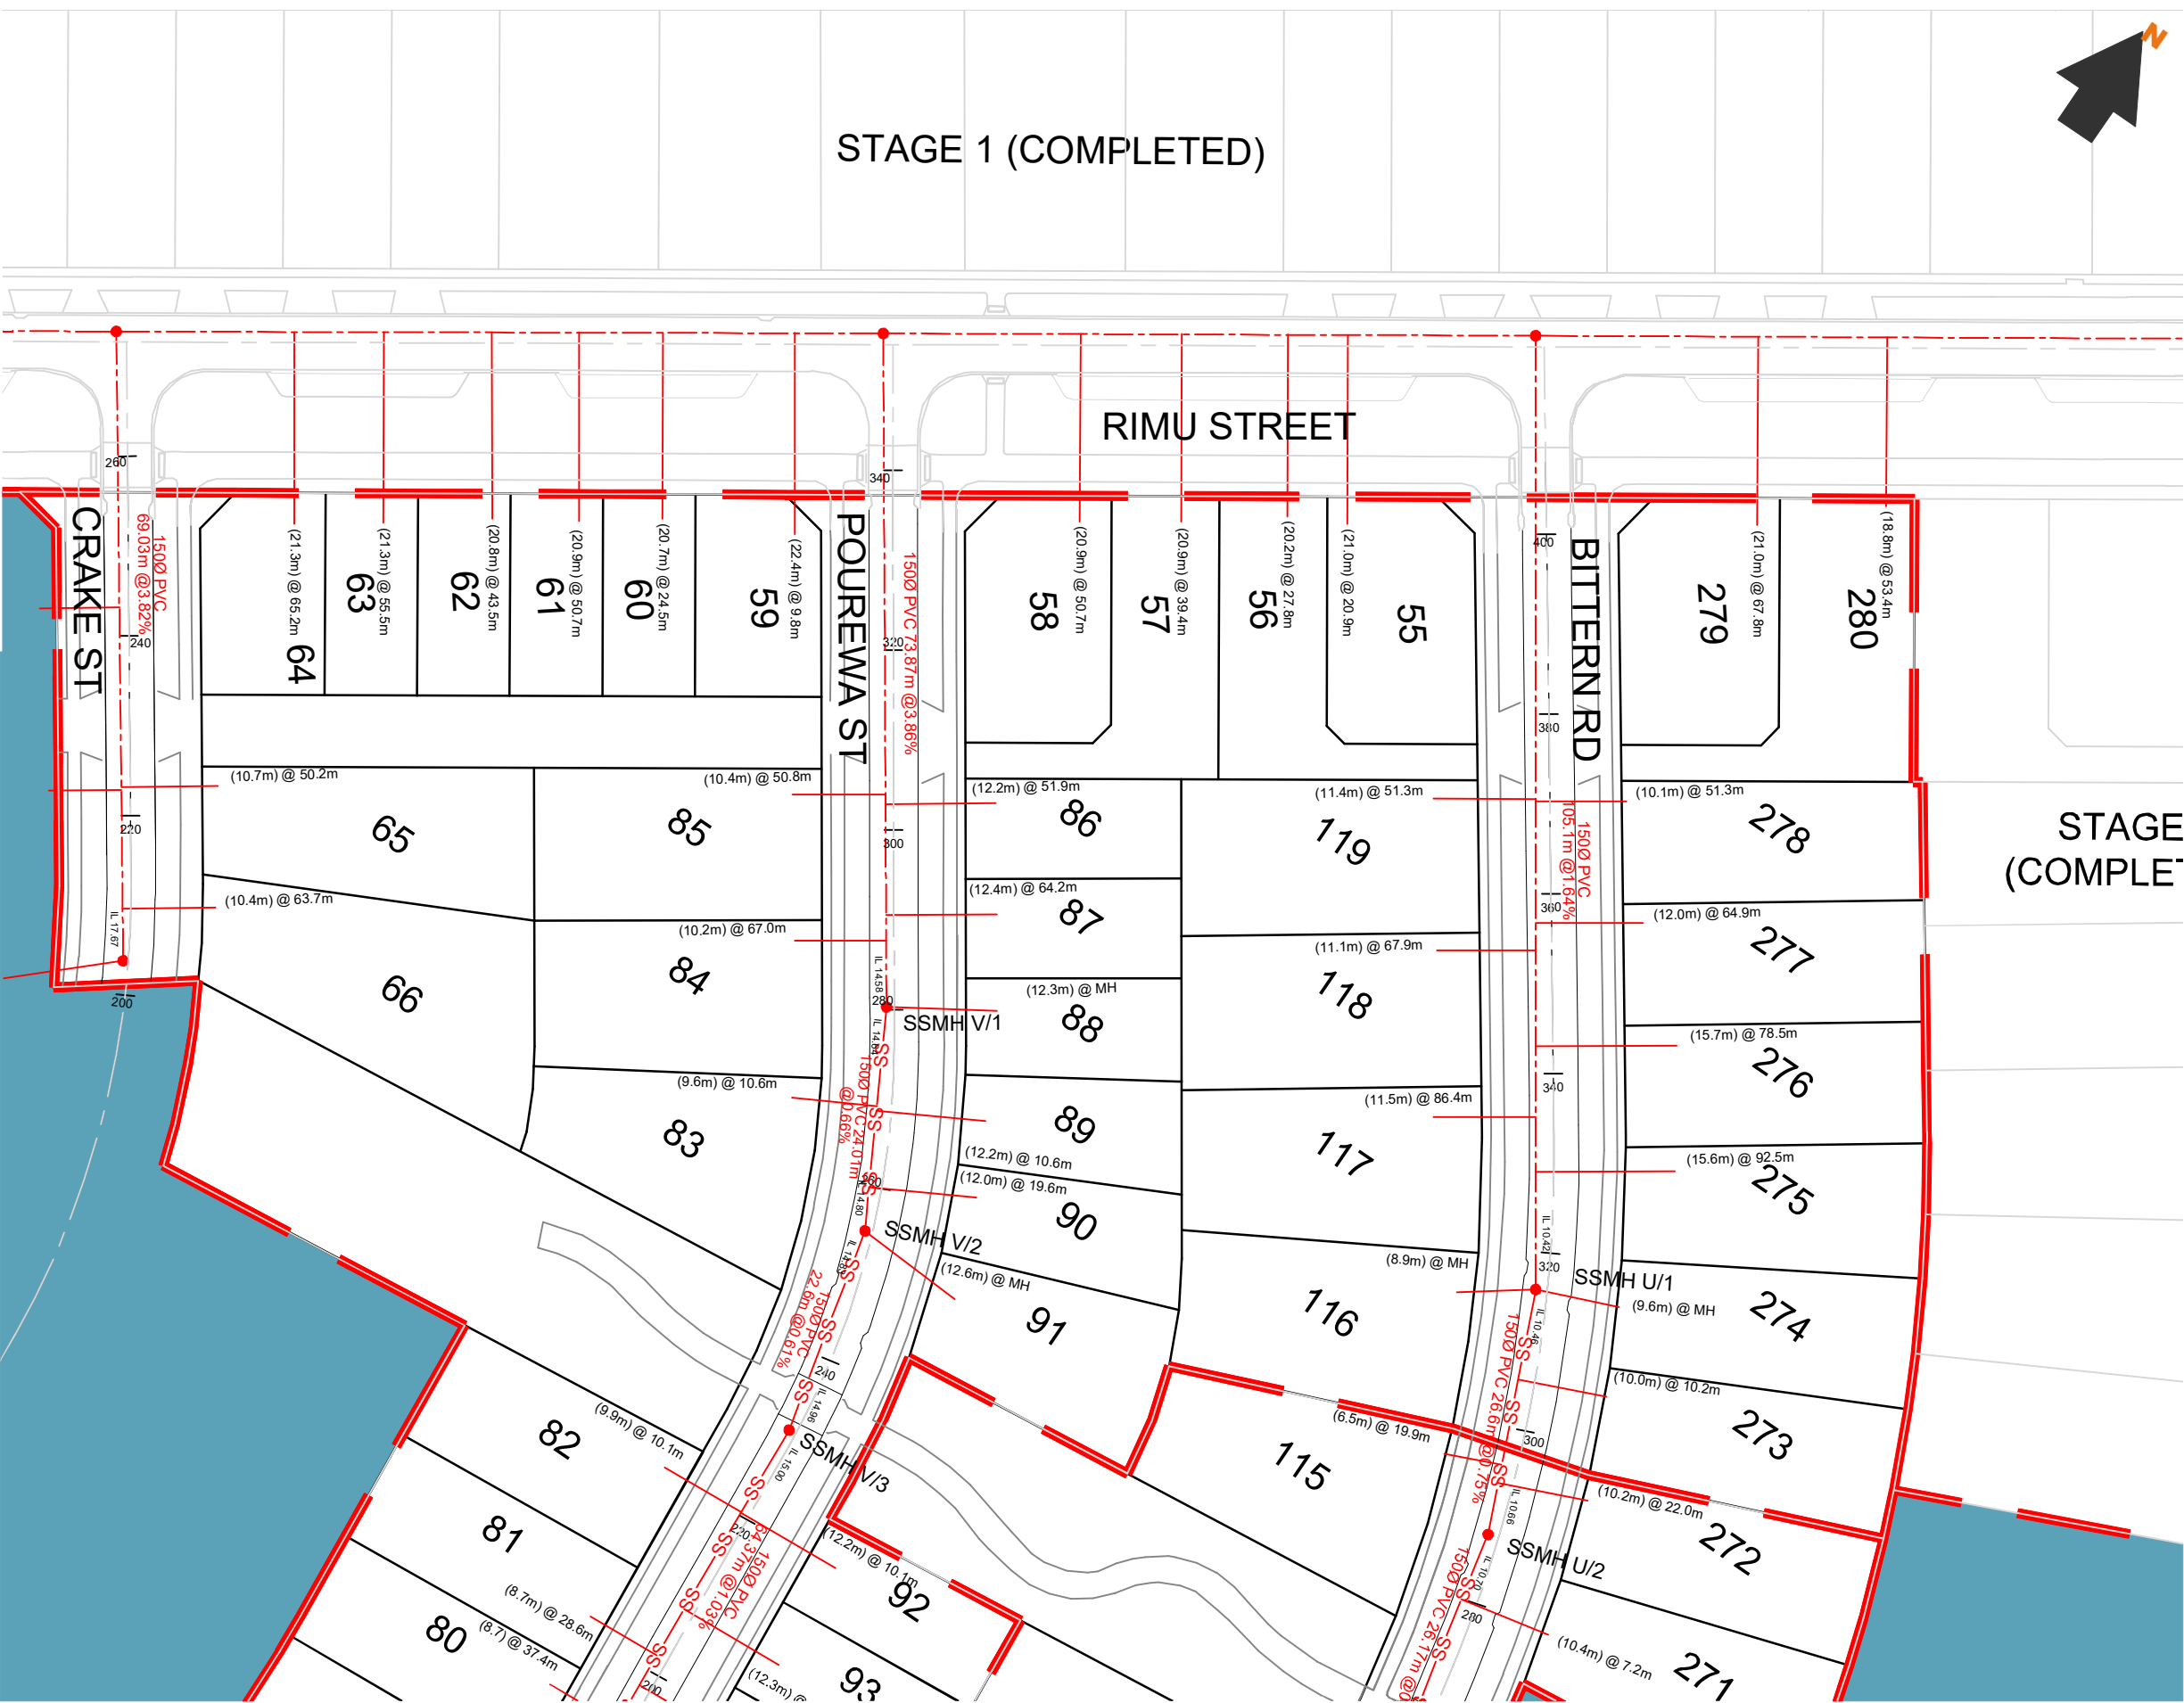

REV DESCRIPTION				BY		APPVD DATE		PROJECT		CLIENT		PURPOSE		
								LAKESIDE, TE KAUPHATA WASTEWATER LAYOUT STAGE 2 2 OF 3		LAKESIDE DEVELOPMENTS 2017 LIMITED		AS-BUILT		
												DESIGN JS	APPROVED NH	SCALE 1:750 @ A3
												DRAWN JS	DATE MAY 2020	
												CHECK RS		
												PROJECT NO.	DRAWING NO.	REV.
												1239	AB-5-101	-

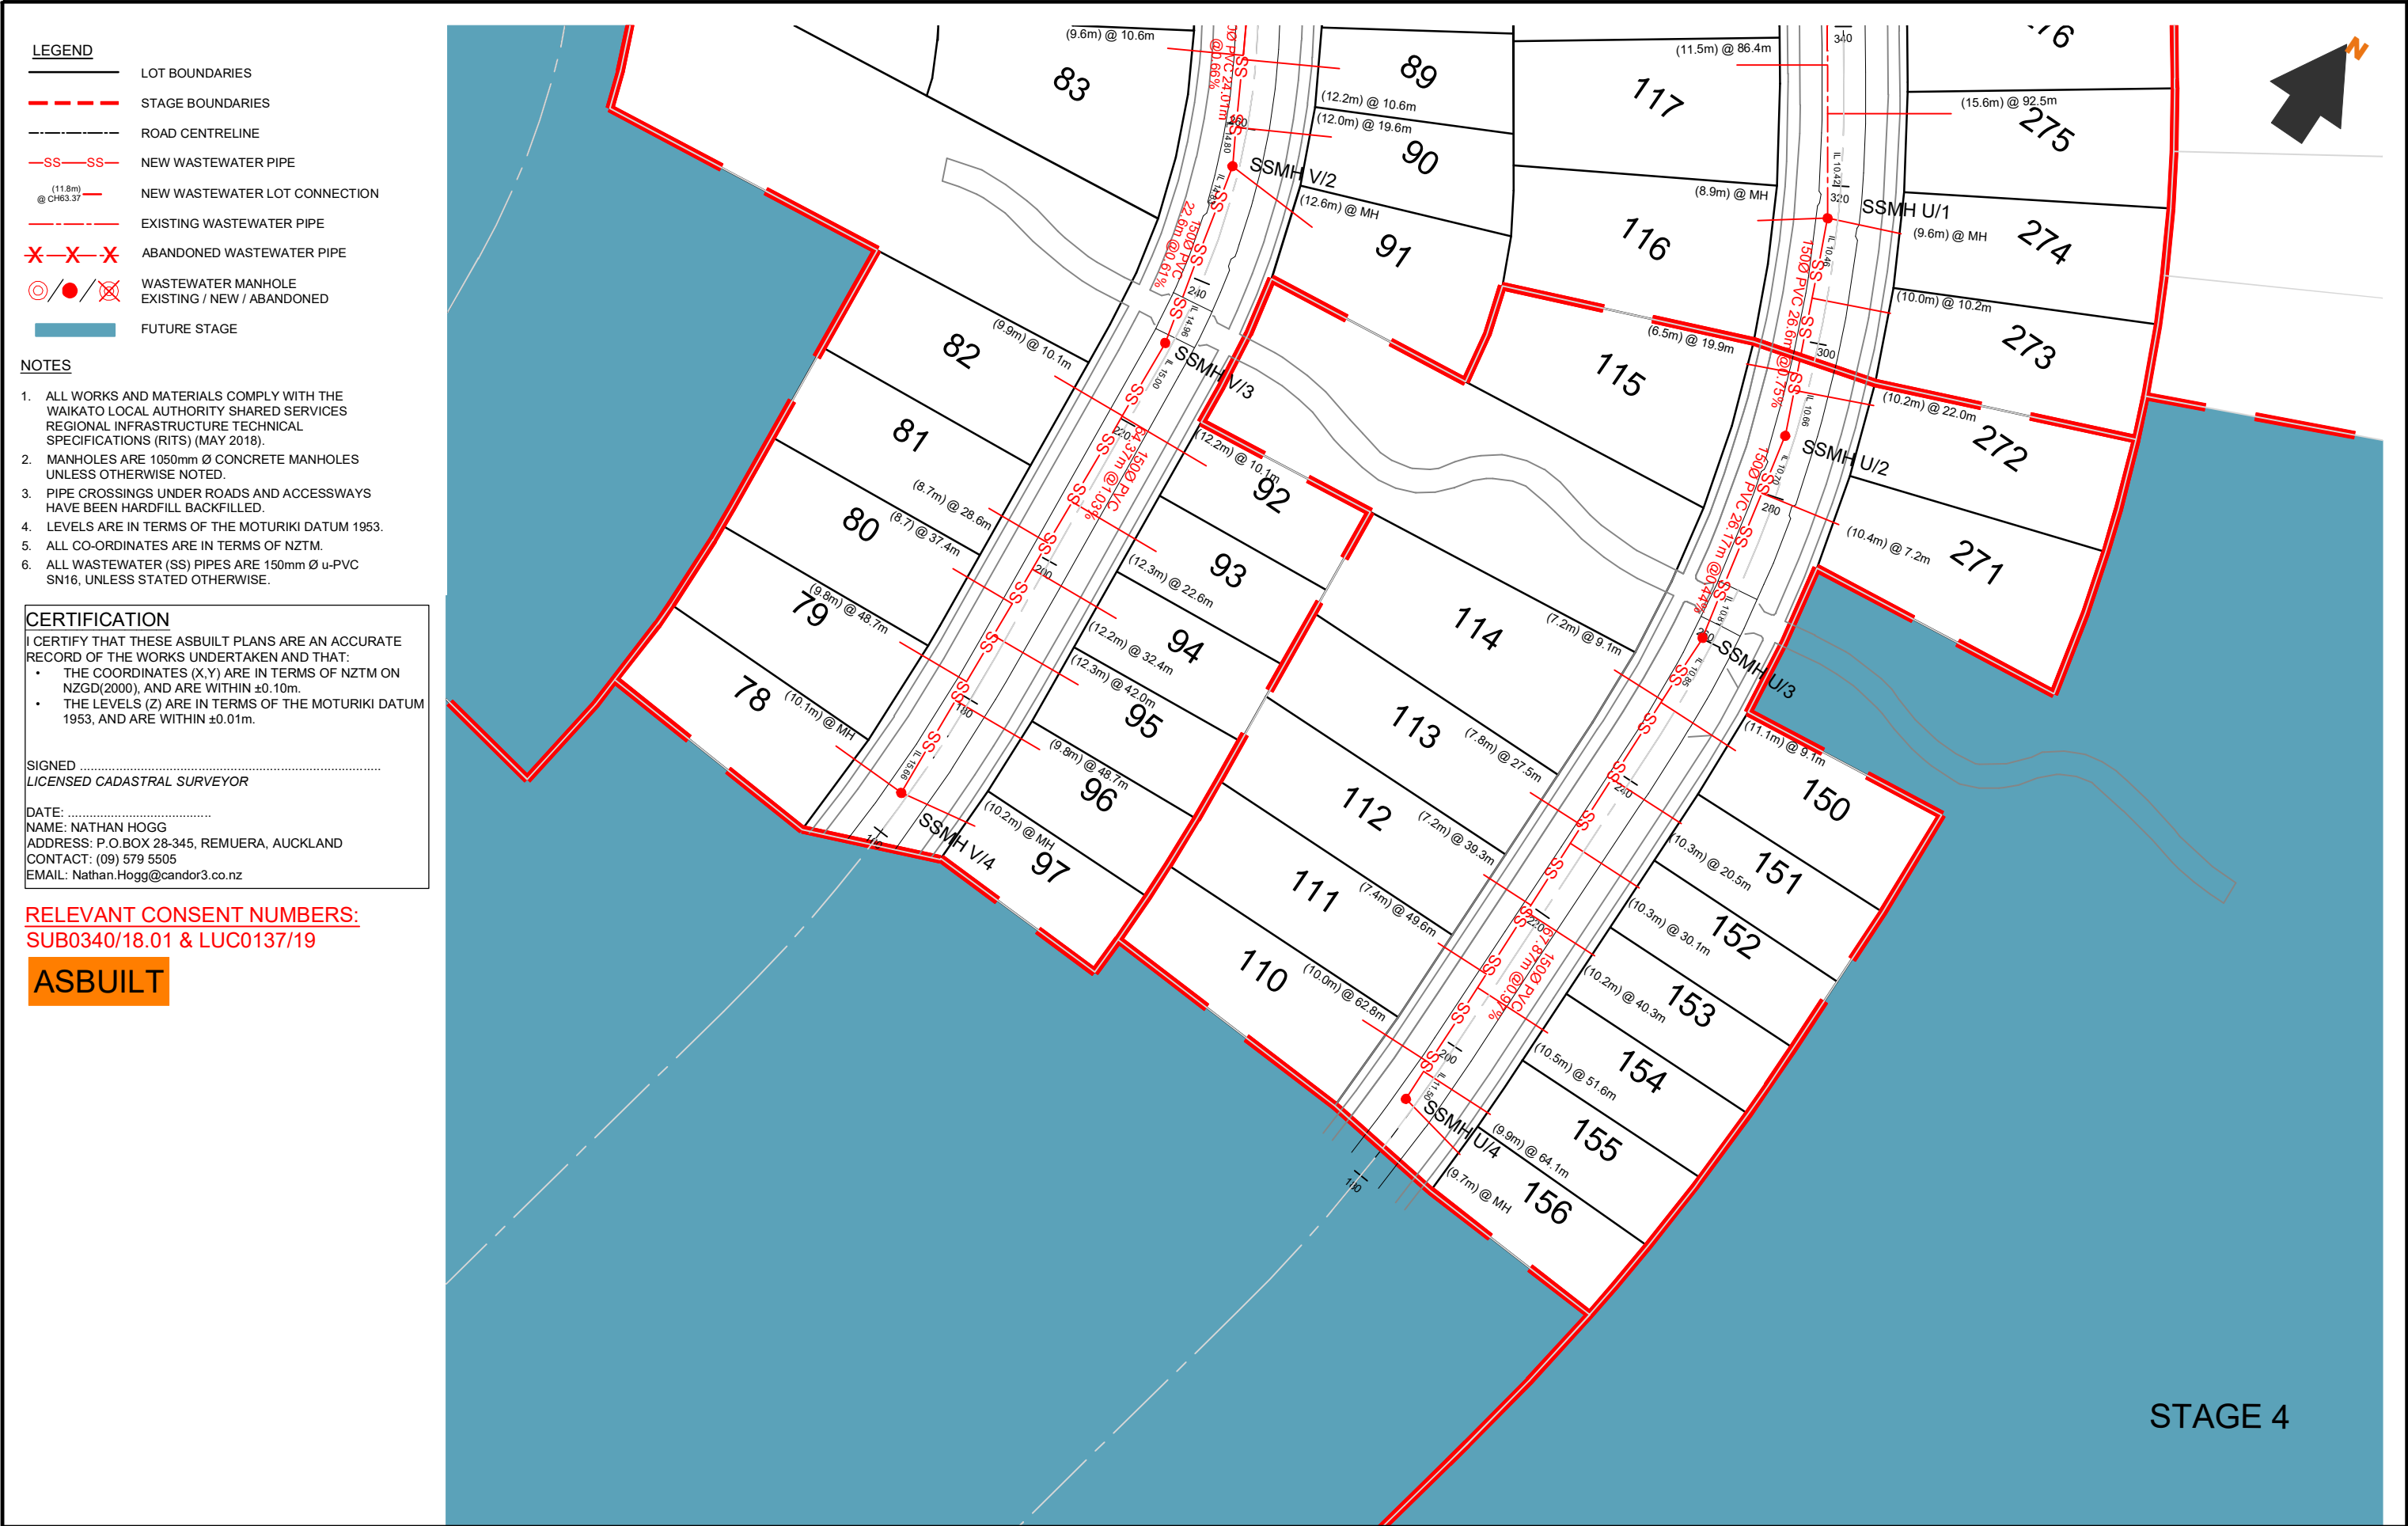

[illegible]

## CERTIFICATION

I CERTIFY THAT THESE ASBUILT PLANS ARE AN ACCURATE  
RECORD OF THE WORKS UNDERTAKEN AND THAT:

- THE COORDINATES (X,Y) ARE IN TERMS OF NZTM ON NZGD(2000), AND ARE WITHIN  $\pm 0.10\text{m}$ .
- THE LEVELS (Z) ARE IN TERMS OF THE MOTURIKI DATUM 1953, AND ARE WITHIN  $\pm 0.01\text{m}$ .

SIGNED .....  
LICENSED CADASTRAL SURVEYOR

DATE: .....  
NAME: NATHAN HOGG  
ADDRESS: P.O.BOX 28-345, REMUERA, AUCKLAND  
CONTACT: (09) 579 5505  
EMAIL: Nathan.Hogg@candor3.co.nz

RELEVANT CONSENT NUMBERS:  
SUB0340/18.01 & LUC0137/19

ASBUILT

REV    DESCRIPTION					BY	APPVD	DATE	<div>Candor<sup>3</sup></div> <div>ENGINEERING FOR LIFE</div>	PROJECT	LAKESIDE, TE KAUWHATA WASTEWATER LAYOUT STAGE 2 COORDINATE TABLE	CLIENT	LAKESIDE DEVELOPMENTS 2017 LIMITED	PURPOSE		
													AS-BUILT		
DESIGN	JS	APPROVED BY    NH DATE    MAY 2020	SCALE N/A												
DRAWN	JS														
CHECK	RS														
PROJECT NO.					DRAWING NO.			REV.							
1239					AB-5-103			-							